


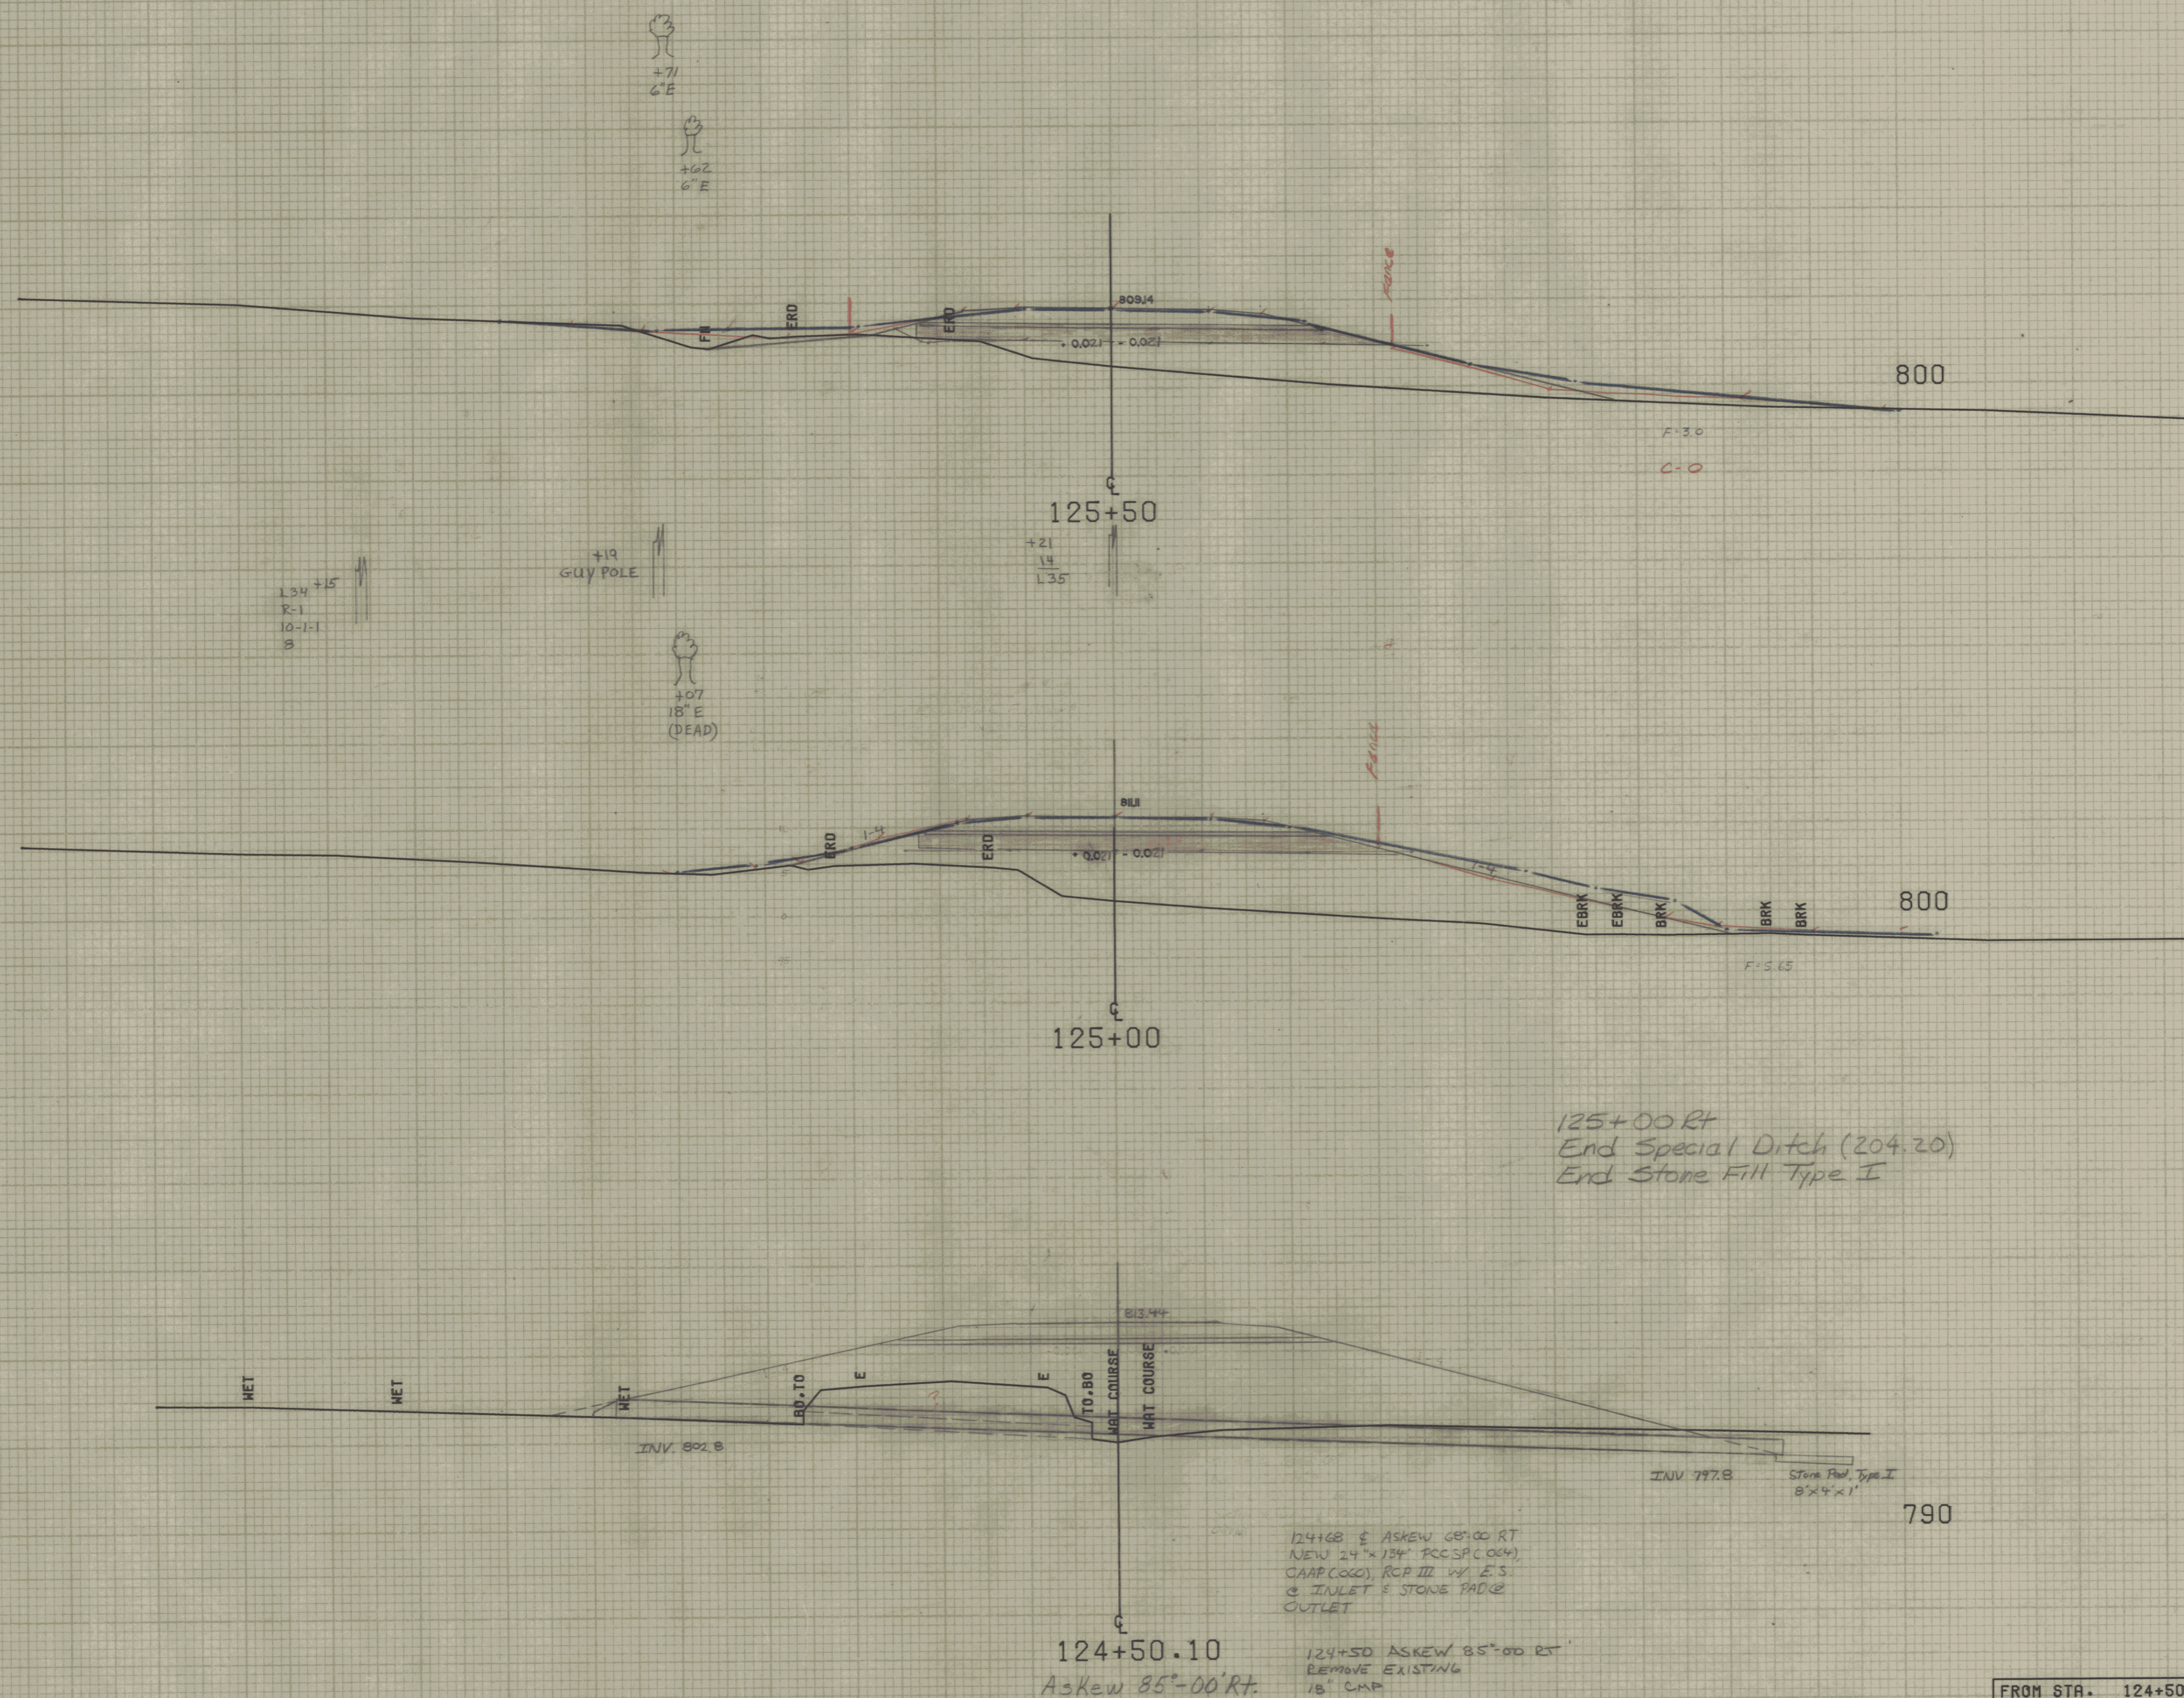

FROM STA.	124+50.10	TO STA.	125+50
PROJECT NAME	EAST MONTPELIER MAIN		
NO.	RS0246(1)	PLOTTED 02/24/83	
SURVEYED BY	LAVALLÉE		JAN82
SHEET 45	OF 128	SHEETS	

SCALE 10 FEET