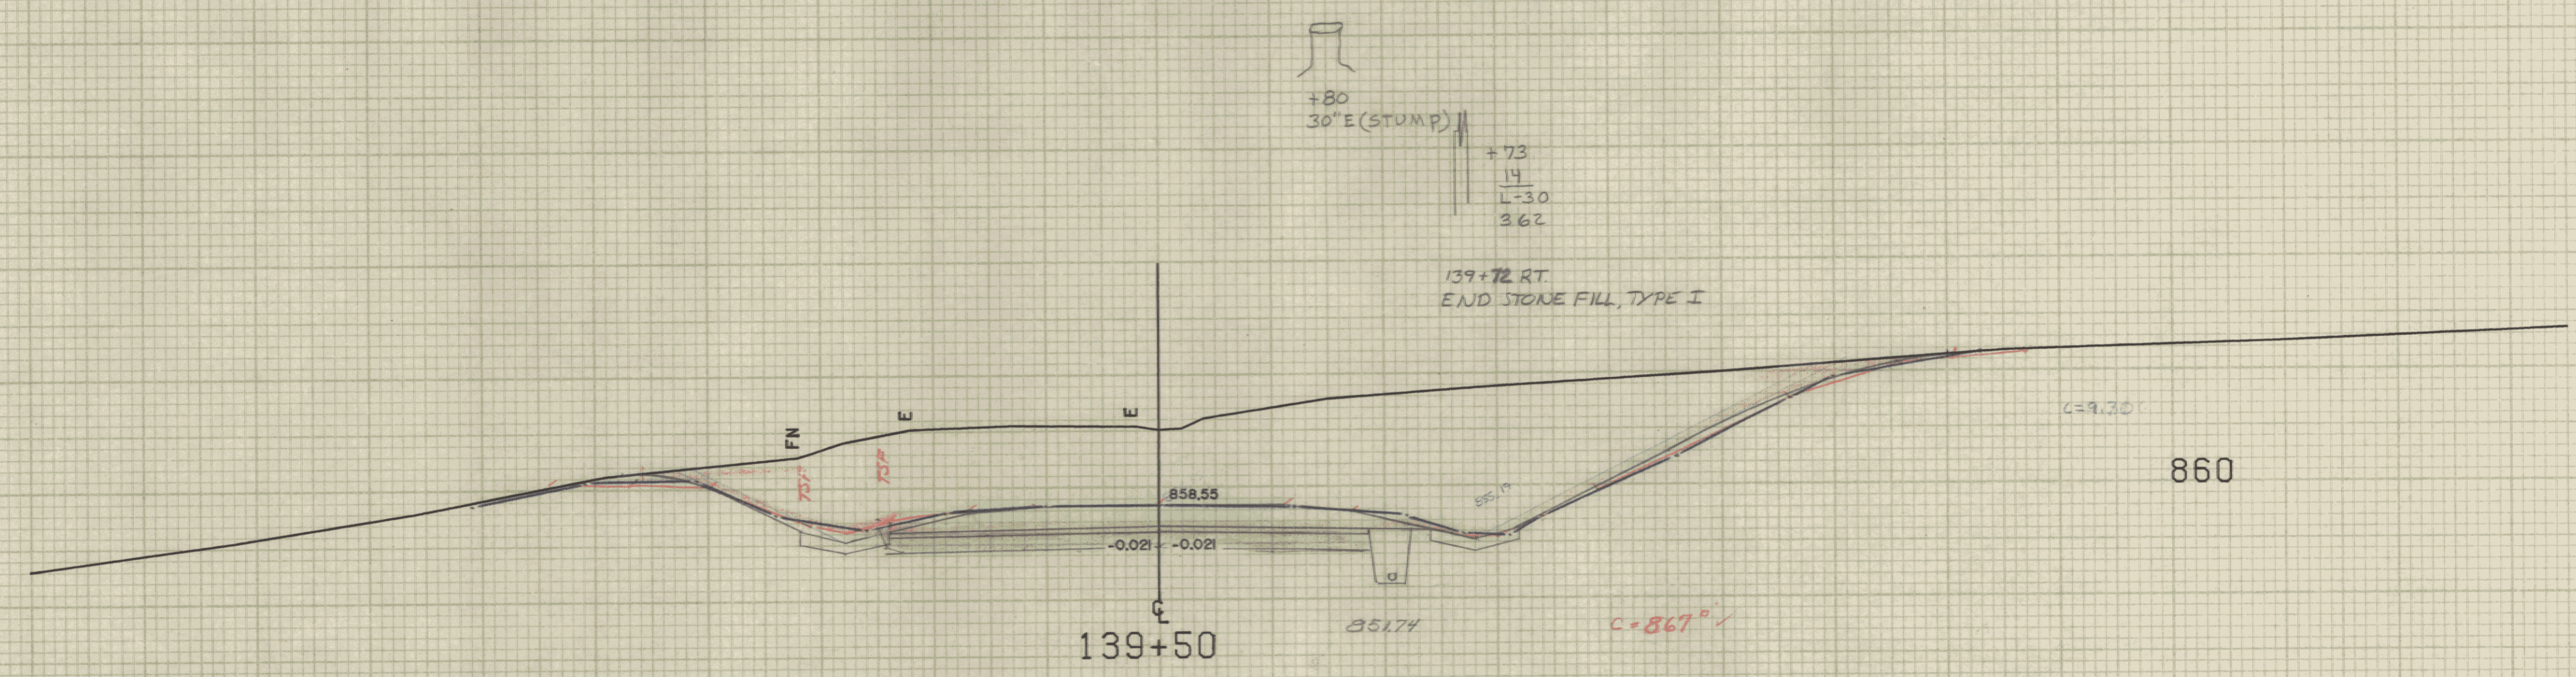
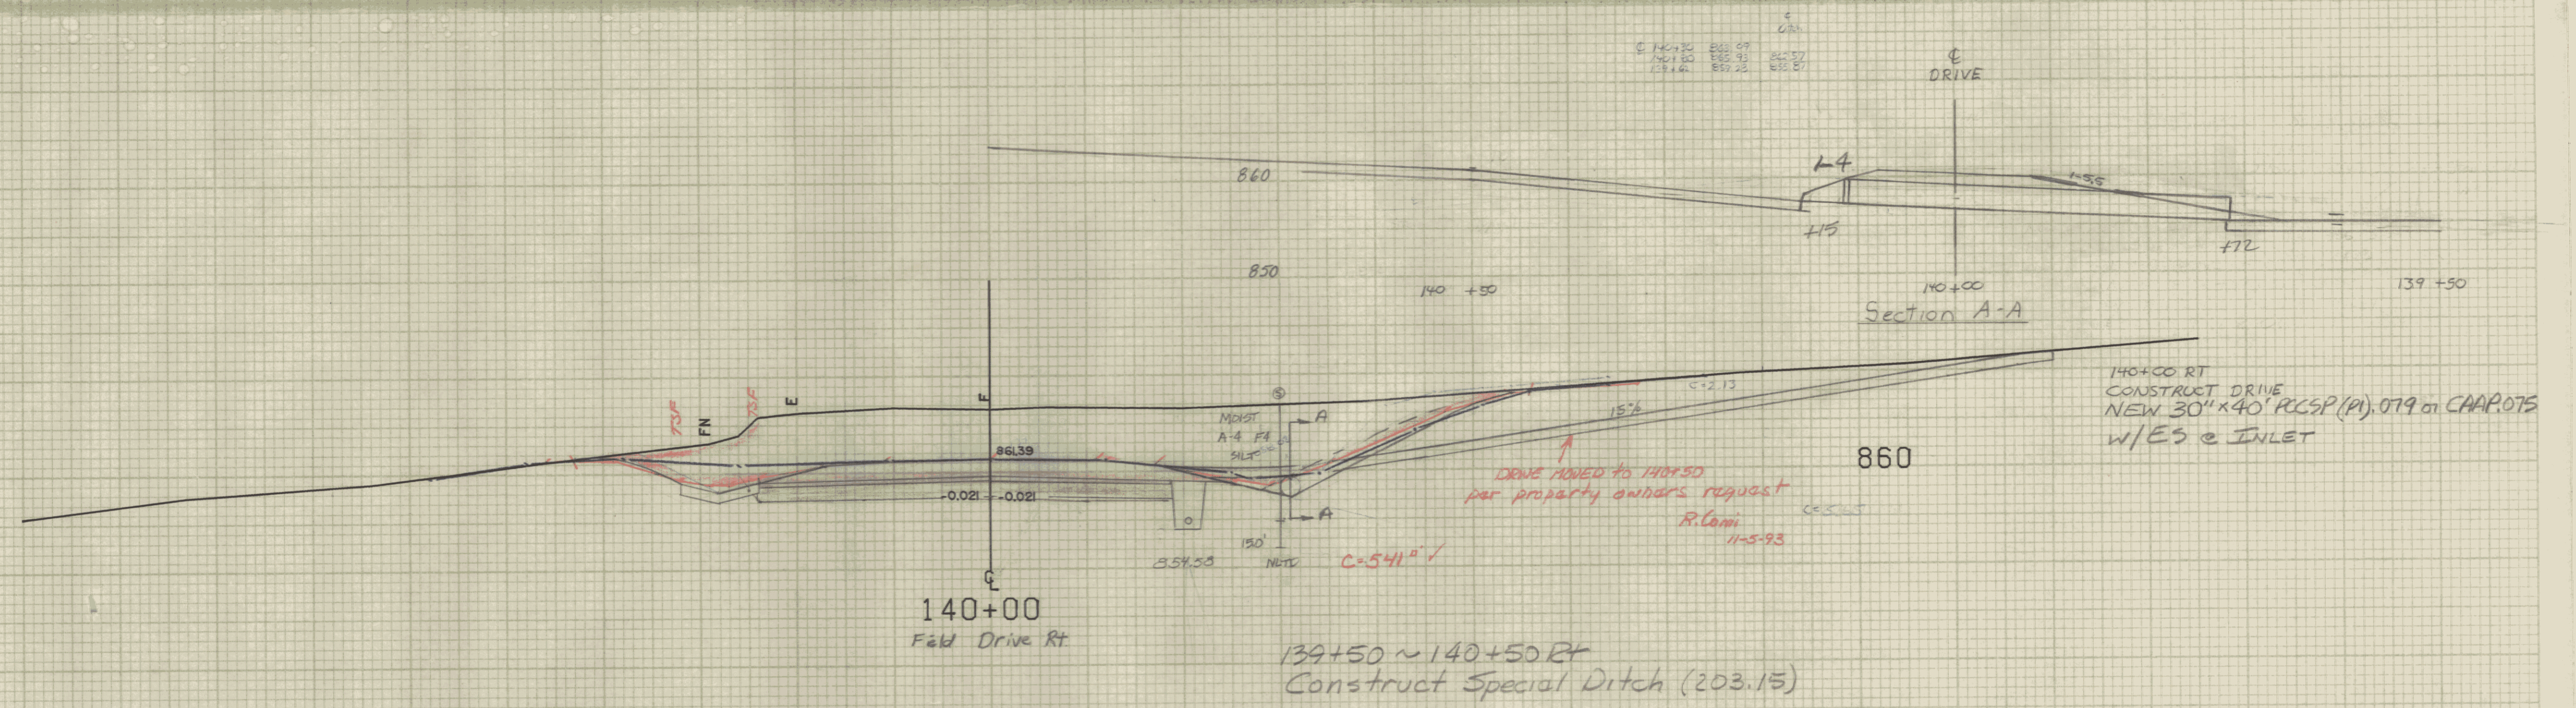


BLUE PLAT BY 14 SURVEY - SECTIONED MAY 1978 - BEFORE BUILT & CURE

FINALS PLOTTED BY R.L. Conn. 11-5-93
 UNDERCUT " " 11-17-93
 PLANNED " " 12-21-93
 ORD. PLAN. BY C.E. KOHR 1-31-94

FROM STA.	139+00	TO STA.	140+00
PROJECT NAME	EAST MONTPELIER MAIN		
NO.	RS0246(1)		
SURVEYED BY	LAVALLEE	JAN82	
SHEET	58	OF 128	SHEETS

SCALE 10 FEET