Keuffel & Esser Co. PLATED CROSS SECTION PAPER Made in U.S.A.

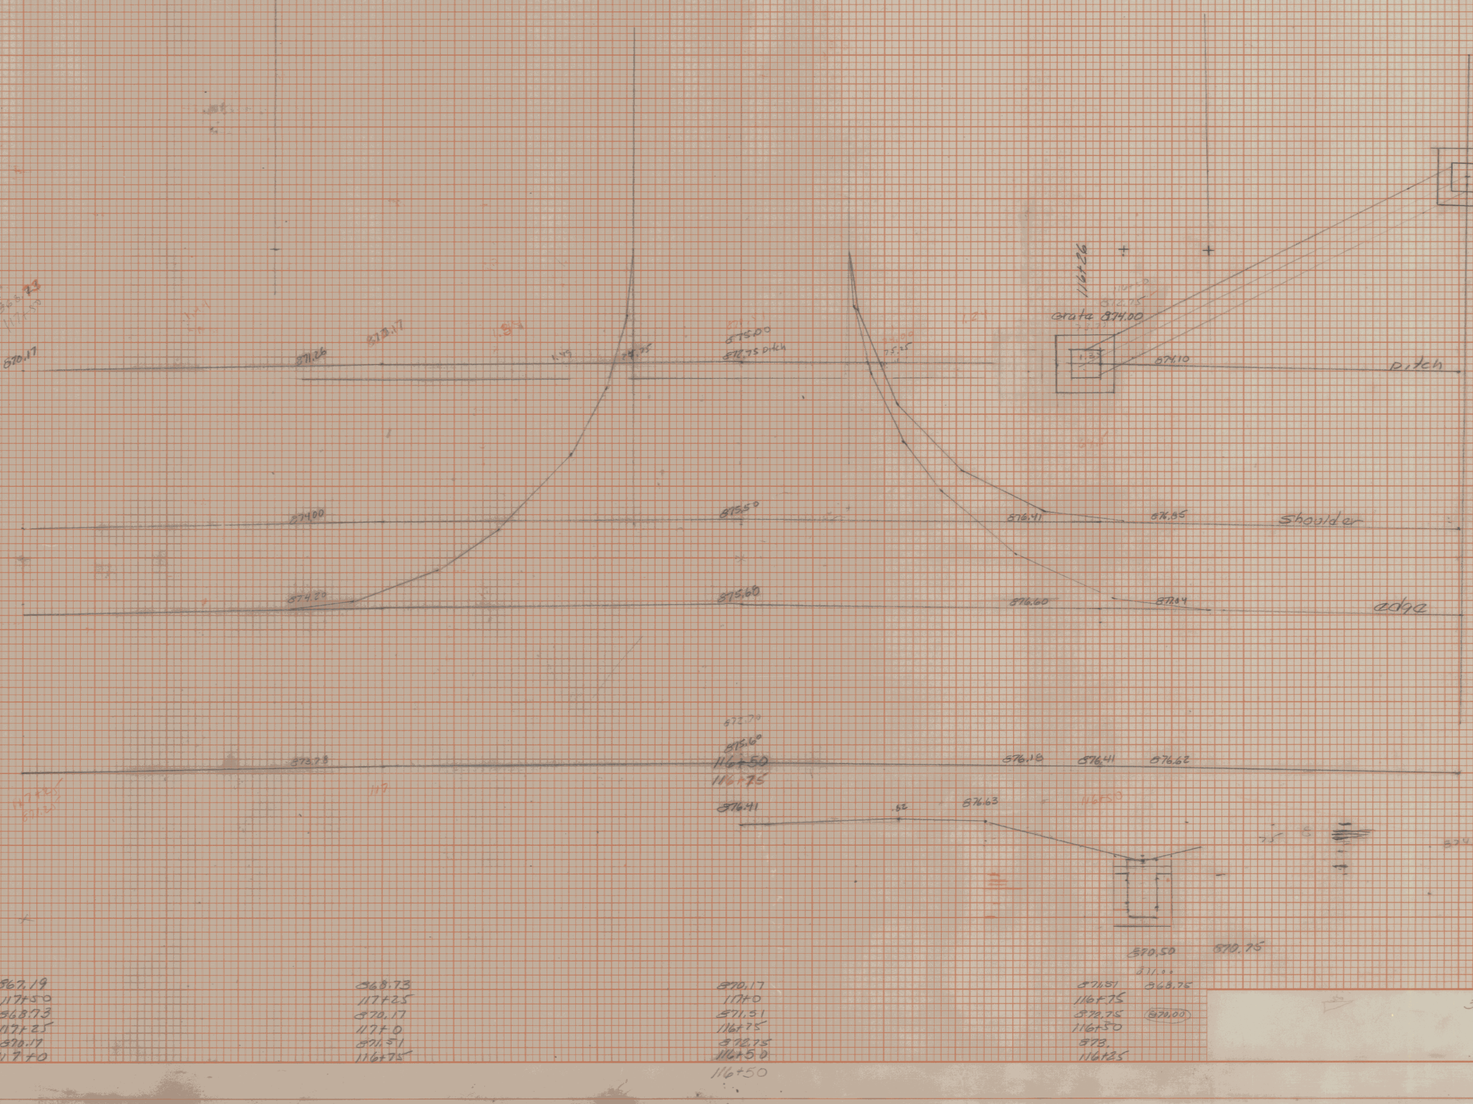

867.19	868.73	870.17


3.0841°

146 FDS