

CONSTRUCT DRIVES

LEFT RIGHT

REV 27+82 15' WIDE (PAVED)
 REV 28+67 12' WIDE (GRAVEL) (PAVED)
 REV 29+54 12' WIDE (GRAVEL) (PAVED)
 REV 29+64 12' WIDE (PAVED)
 REV 31+95 14' WIDE (PAVED)
 REV 32+75 24' WIDE (PAVED)
 REV 33+00 12' WIDE (GRAVEL) (PAVED)
 REV 27+71 13' WIDE (GRAVEL) (PAVED)
 REV 28+79 15' WIDE (CONCRETE)
 REV 31+08 12' WIDE (PAVED) MOVED TO WILSON ST. 16+00 LT
 REV 31+77 14' WIDE (PAVED)
 SURV. PI 30+43.29 =
 30+43.24

STONE FILL TYPE 1 FOR SLOPE STABILIZATION

30+50 30+80 RT


PORTLAND CEMENT CONC. SIDEWALK - 5' X 5' WIDE

REV 27+00 LT ~ REV 33+00 LT

EXCAVATION OF SURFACES AND PAVEMENTS

REV. STA 32+04 LT ~ 32+62 LT REMOVE EXISTING PAVEMENT FOR 4' BEHIND NEW SIDEWALK AREA TO BE TOPSOILED AND SEED, AS DIRECTED BY THE ENGINEER.

NOTE: THE CONCRETE DRIVE @ 28+79 RT. SHALL BE PAID AS PORTLAND CEMENT CONCRETE SIDEWALK, 5'.

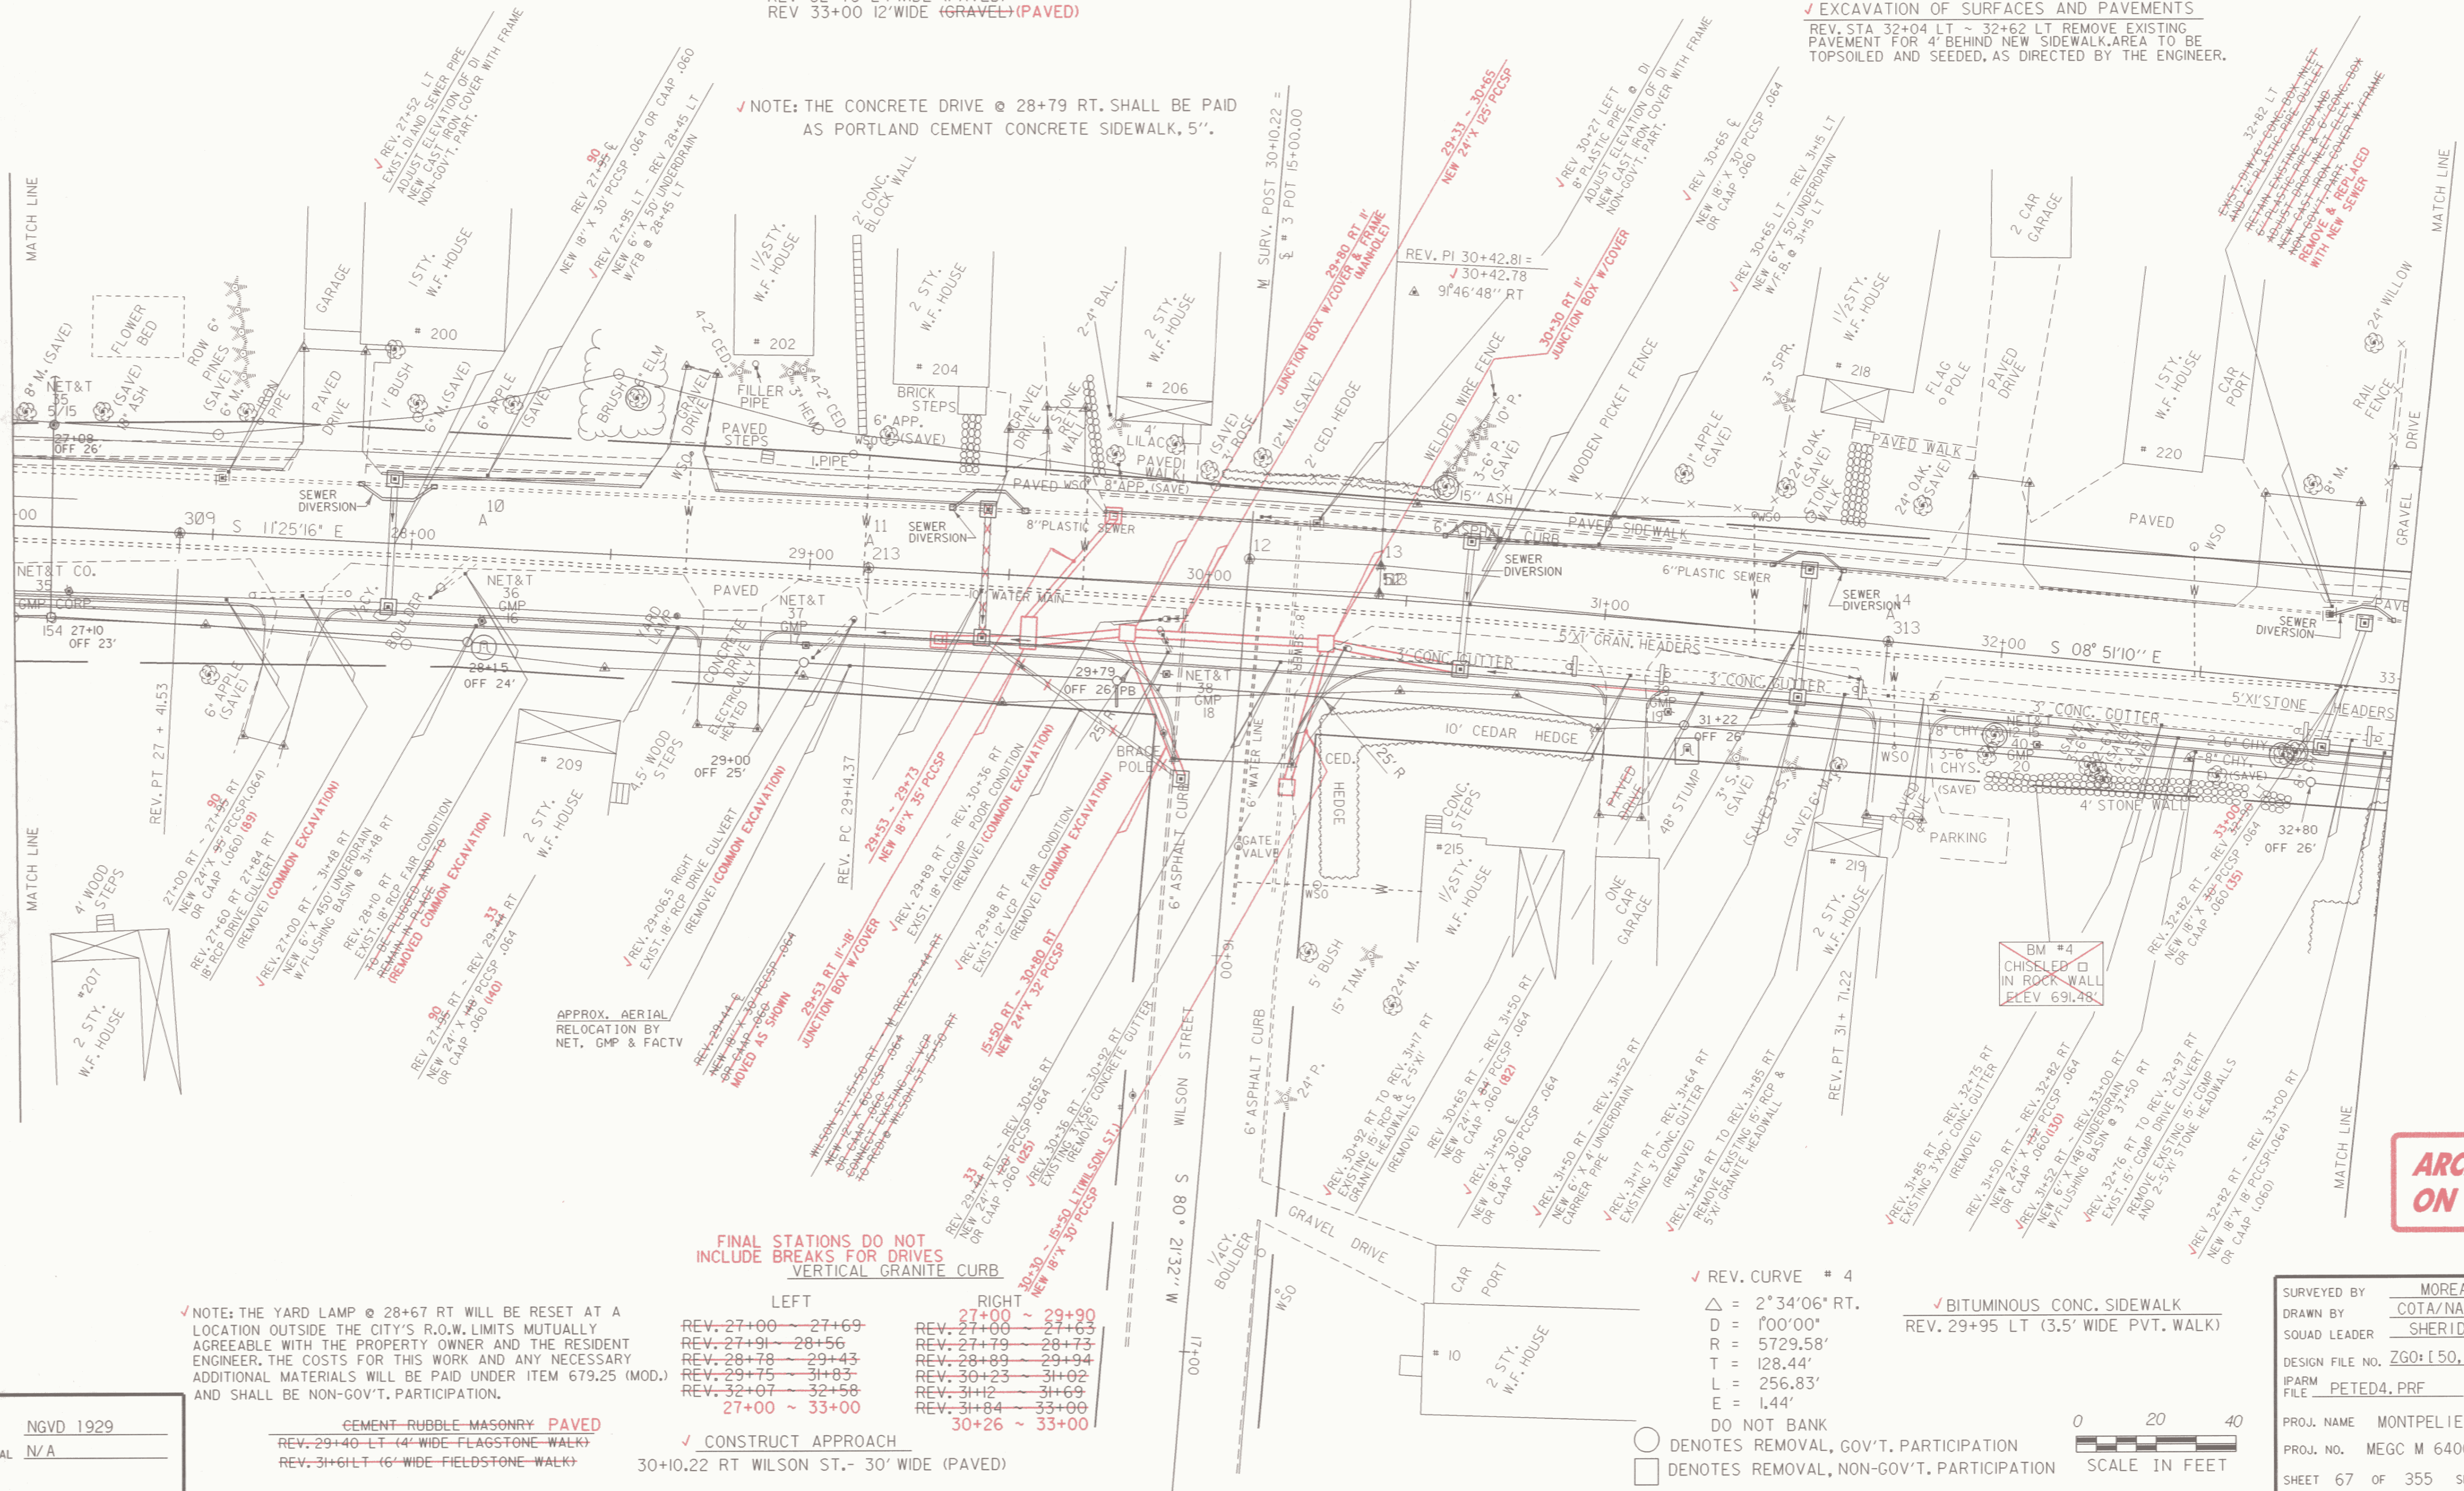

ARCHIVED
ON CADD

NOTE: THE YARD LAMP @ 28+67 RT WILL BE RESET AT A LOCATION OUTSIDE THE CITY'S R.O.W. LIMITS MUTUALLY AGREEABLE WITH THE PROPERTY OWNER AND THE RESIDENT ENGINEER. THE COSTS FOR THIS WORK AND ANY NECESSARY ADDITIONAL MATERIALS WILL BE PAID UNDER ITEM 679.25 (MOD.) AND SHALL BE NON-GOV'T. PARTICIPATION.

LEFT
 REV. 27+00 ~ 27+69
 REV. 27+91 ~ 28+56
 REV. 28+78 ~ 29+43
 REV. 29+75 ~ 31+83
 REV. 32+07 ~ 32+58
 27+00 ~ 33+00
 RIGHT
 REV. 27+00 ~ 27+69
 REV. 27+79 ~ 28+73
 REV. 28+89 ~ 29+94
 REV. 30+23 ~ 31+02
 REV. 31+12 ~ 31+69
 REV. 31+84 ~ 33+00
 30+26 ~ 33+00

CEMENT RUBBLE MASONRY PAVED
 REV. 29+40 LT (4' WIDE FLAGSTONE WALK)
 REV. 31+61 LT (6' WIDE FIELDSTONE WALK)

CONSTRUCT APPROACH
 30+10.22 RT WILSON ST. - 30' WIDE (PAVED)

REV. CURVE # 4
 Δ = 2° 34' 06" RT.
 D = 1'00' 00"
 R = 5729.58'
 L = 128.44'
 T = 256.83'
 E = 1.44'

BITUMINOUS CONC. SIDEWALK
 REV. 29+95 LT (3.5' WIDE PVT. WALK)

DO NOT BANK
 DENOTES REMOVAL, GOV'T. PARTICIPATION
 DENOTES REMOVAL, NON-GOV'T. PARTICIPATION

0 20 40
 SCALE IN FEET

SURVEYED BY MOREAU DATE 7-85
 DRAWN BY COTA/NAI/LO DATE 4-88
 SQUAD LEADER SHERIDAN
 DESIGN FILE NO. ZGO: [50, 116] PETED. DGN: 1
 IPARM FILE PETED4.PRF DATE PLOTTED 13-FEB-1996
 PROJ. NAME MONTPELIER
 PROJ. NO. MEGC M 6400 (7)
 SHEET 67 OF 355 SHEETS