


2	ADDITIONAL SERVICES	LBL	10/12/90
1	WORD NEW/UPD. LOCATION	LBL	8/19/90
Rev.	Description	By	Date

CITY OF MONTPELIER
BERLIN STREET RESTORATION
WATER MAIN INSTALLATION PLAN
STA. 62+00 TO STA. 68+00

MONTPELIER, VERMONT

Client No. 618040
Proj. Manager TDNEBITT
Proj. Designer LBLACKLEY
Drawn By K.G. FLANDERS
Checked By TDNEBITT
Scale 1" = 20'
Approved *[Signature]*
Date APRIL 14, 1989

Sheet 10 of 19
D 618040-10

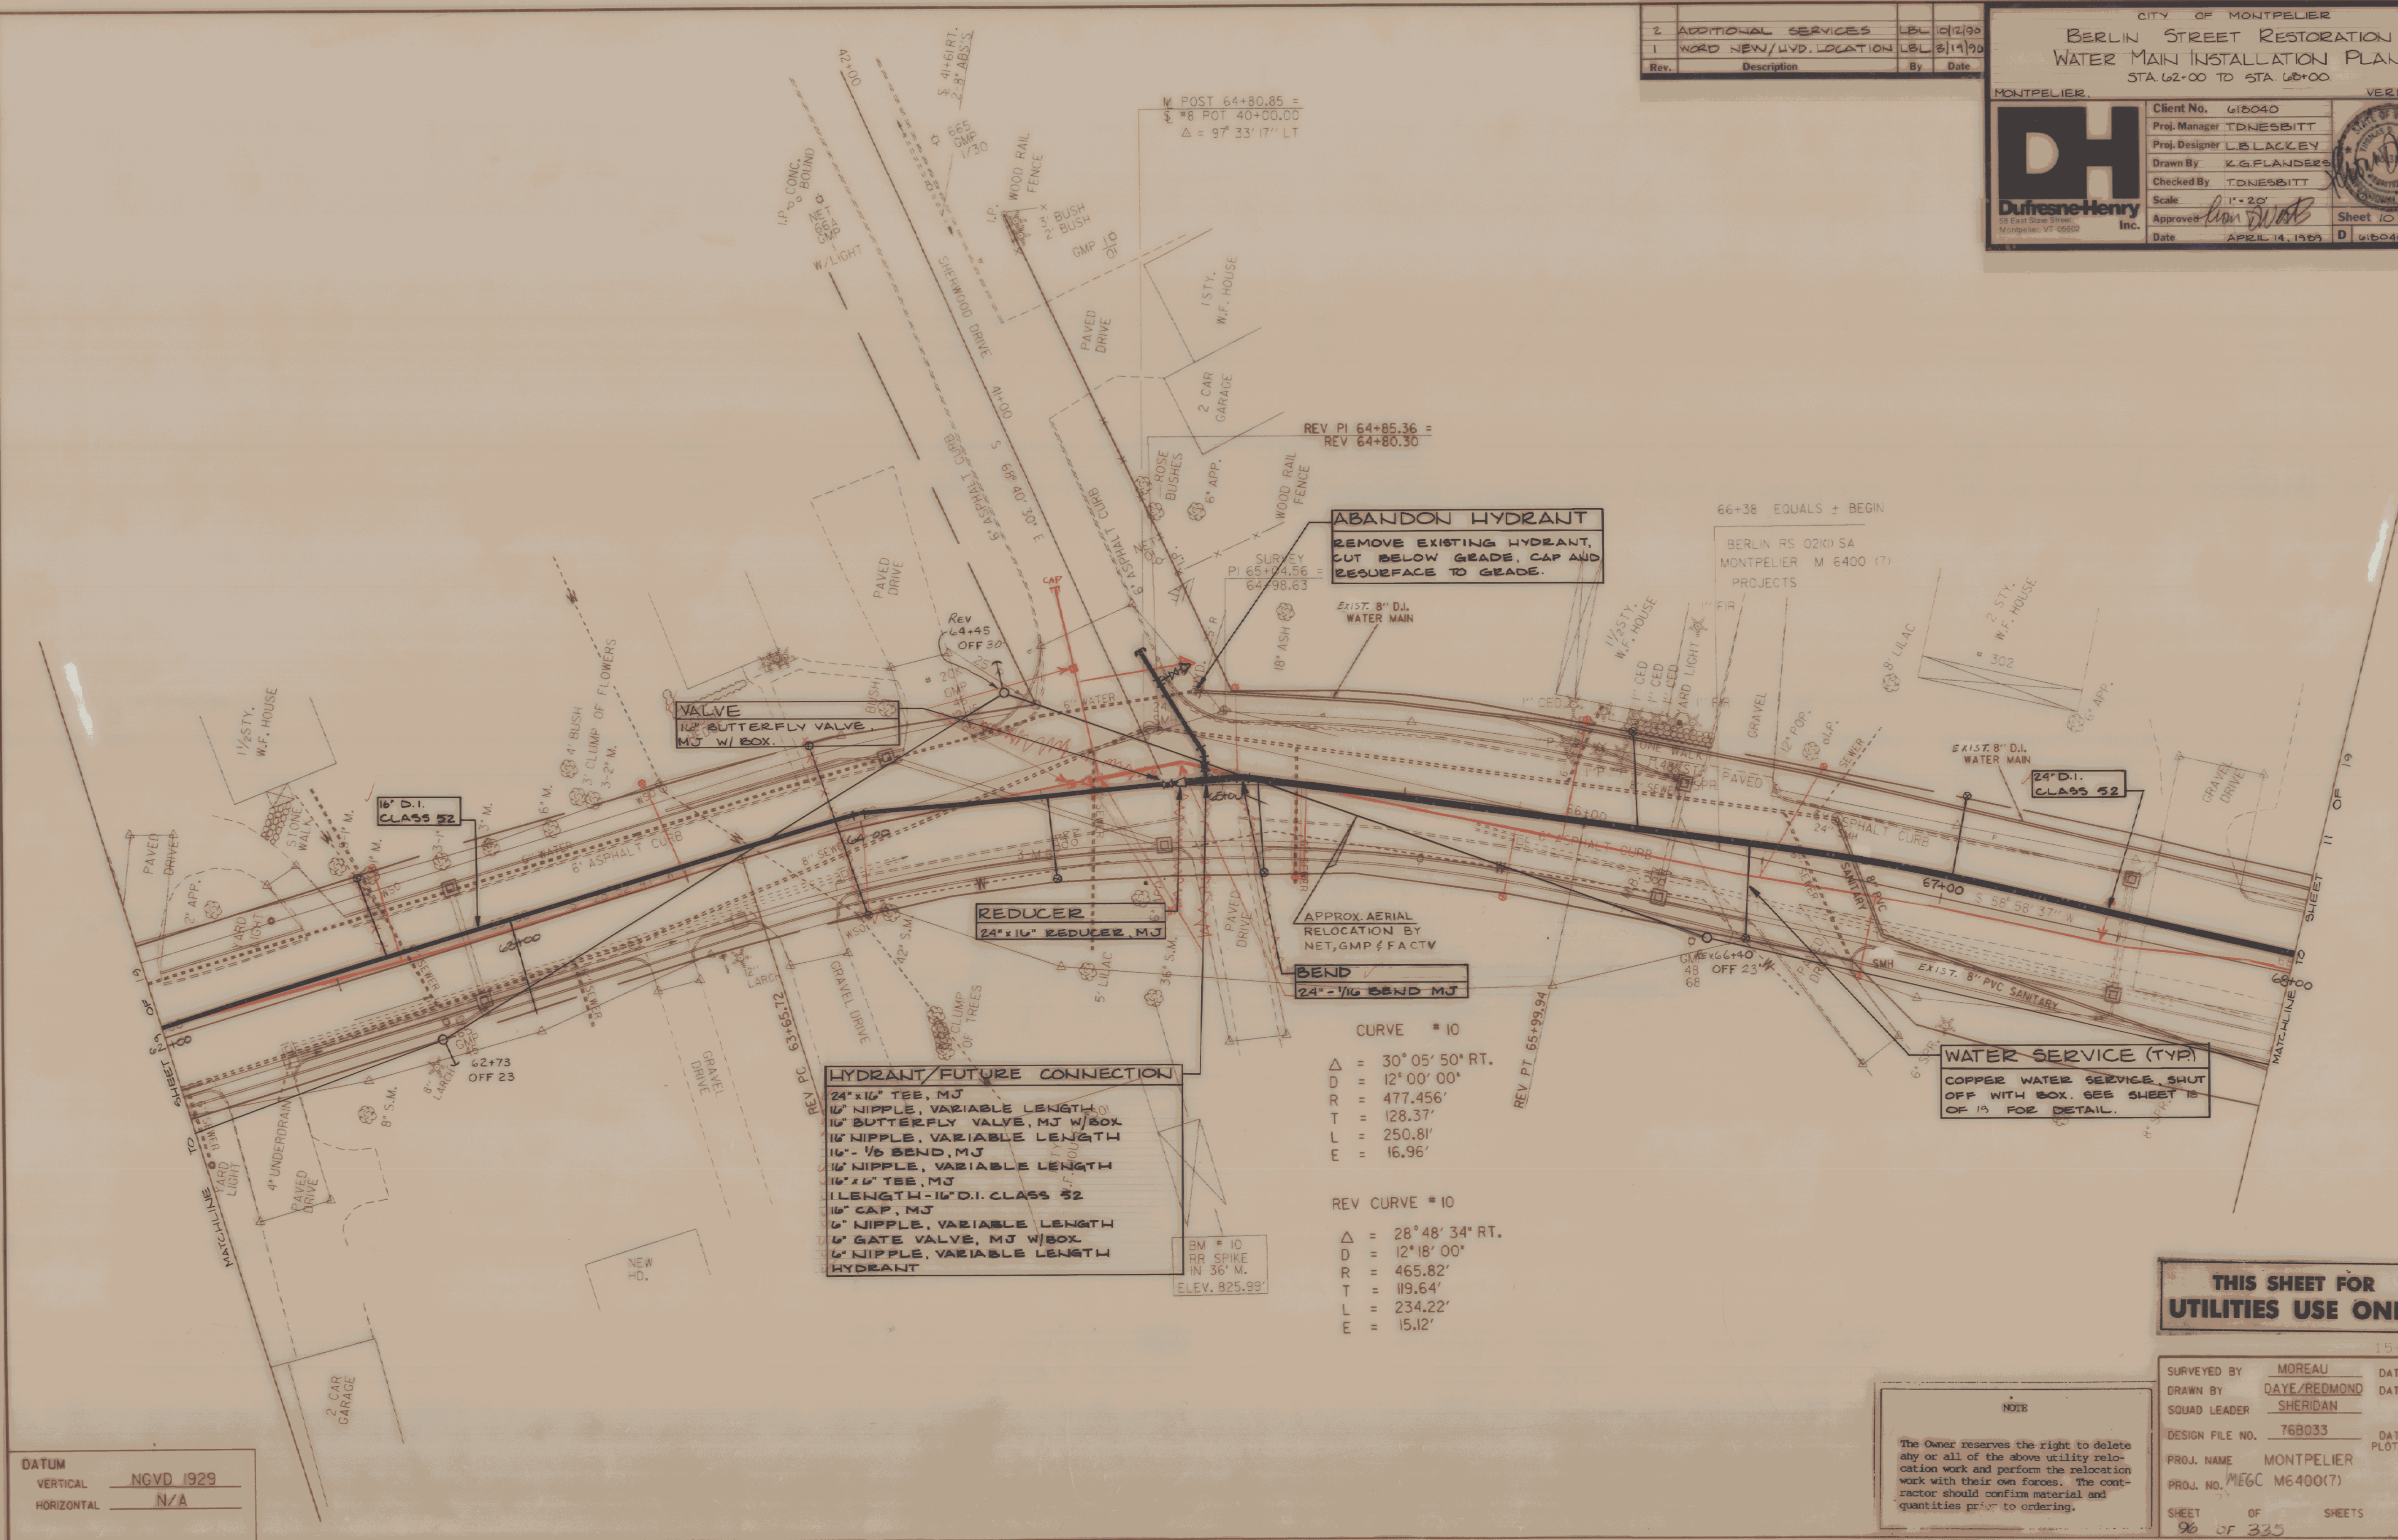

DATUM
VERTICAL NGVD 1929
HORIZONTAL N/A

NOTE
The Owner reserves the right to delete any or all of the above utility relocation work and perform the relocation work with their own forces. The contractor should confirm material and quantities prior to ordering.

THIS SHEET FOR
UTILITIES USE ONLY

15-FEB-1989

SURVEYED BY	MOREAU	DATE	7-85
DRAWN BY	DAYE/REDMOND	DATE	4-88
SQUAD LEADER	SHERIDAN		
DESIGN FILE NO.	76B033	DATE PLOTTED	
PROJ. NAME	MONTPELIER		
PROJ. NO.	MEGC M6400(7)		
SHEET	OF	SHEETS	
96	OF	335	