


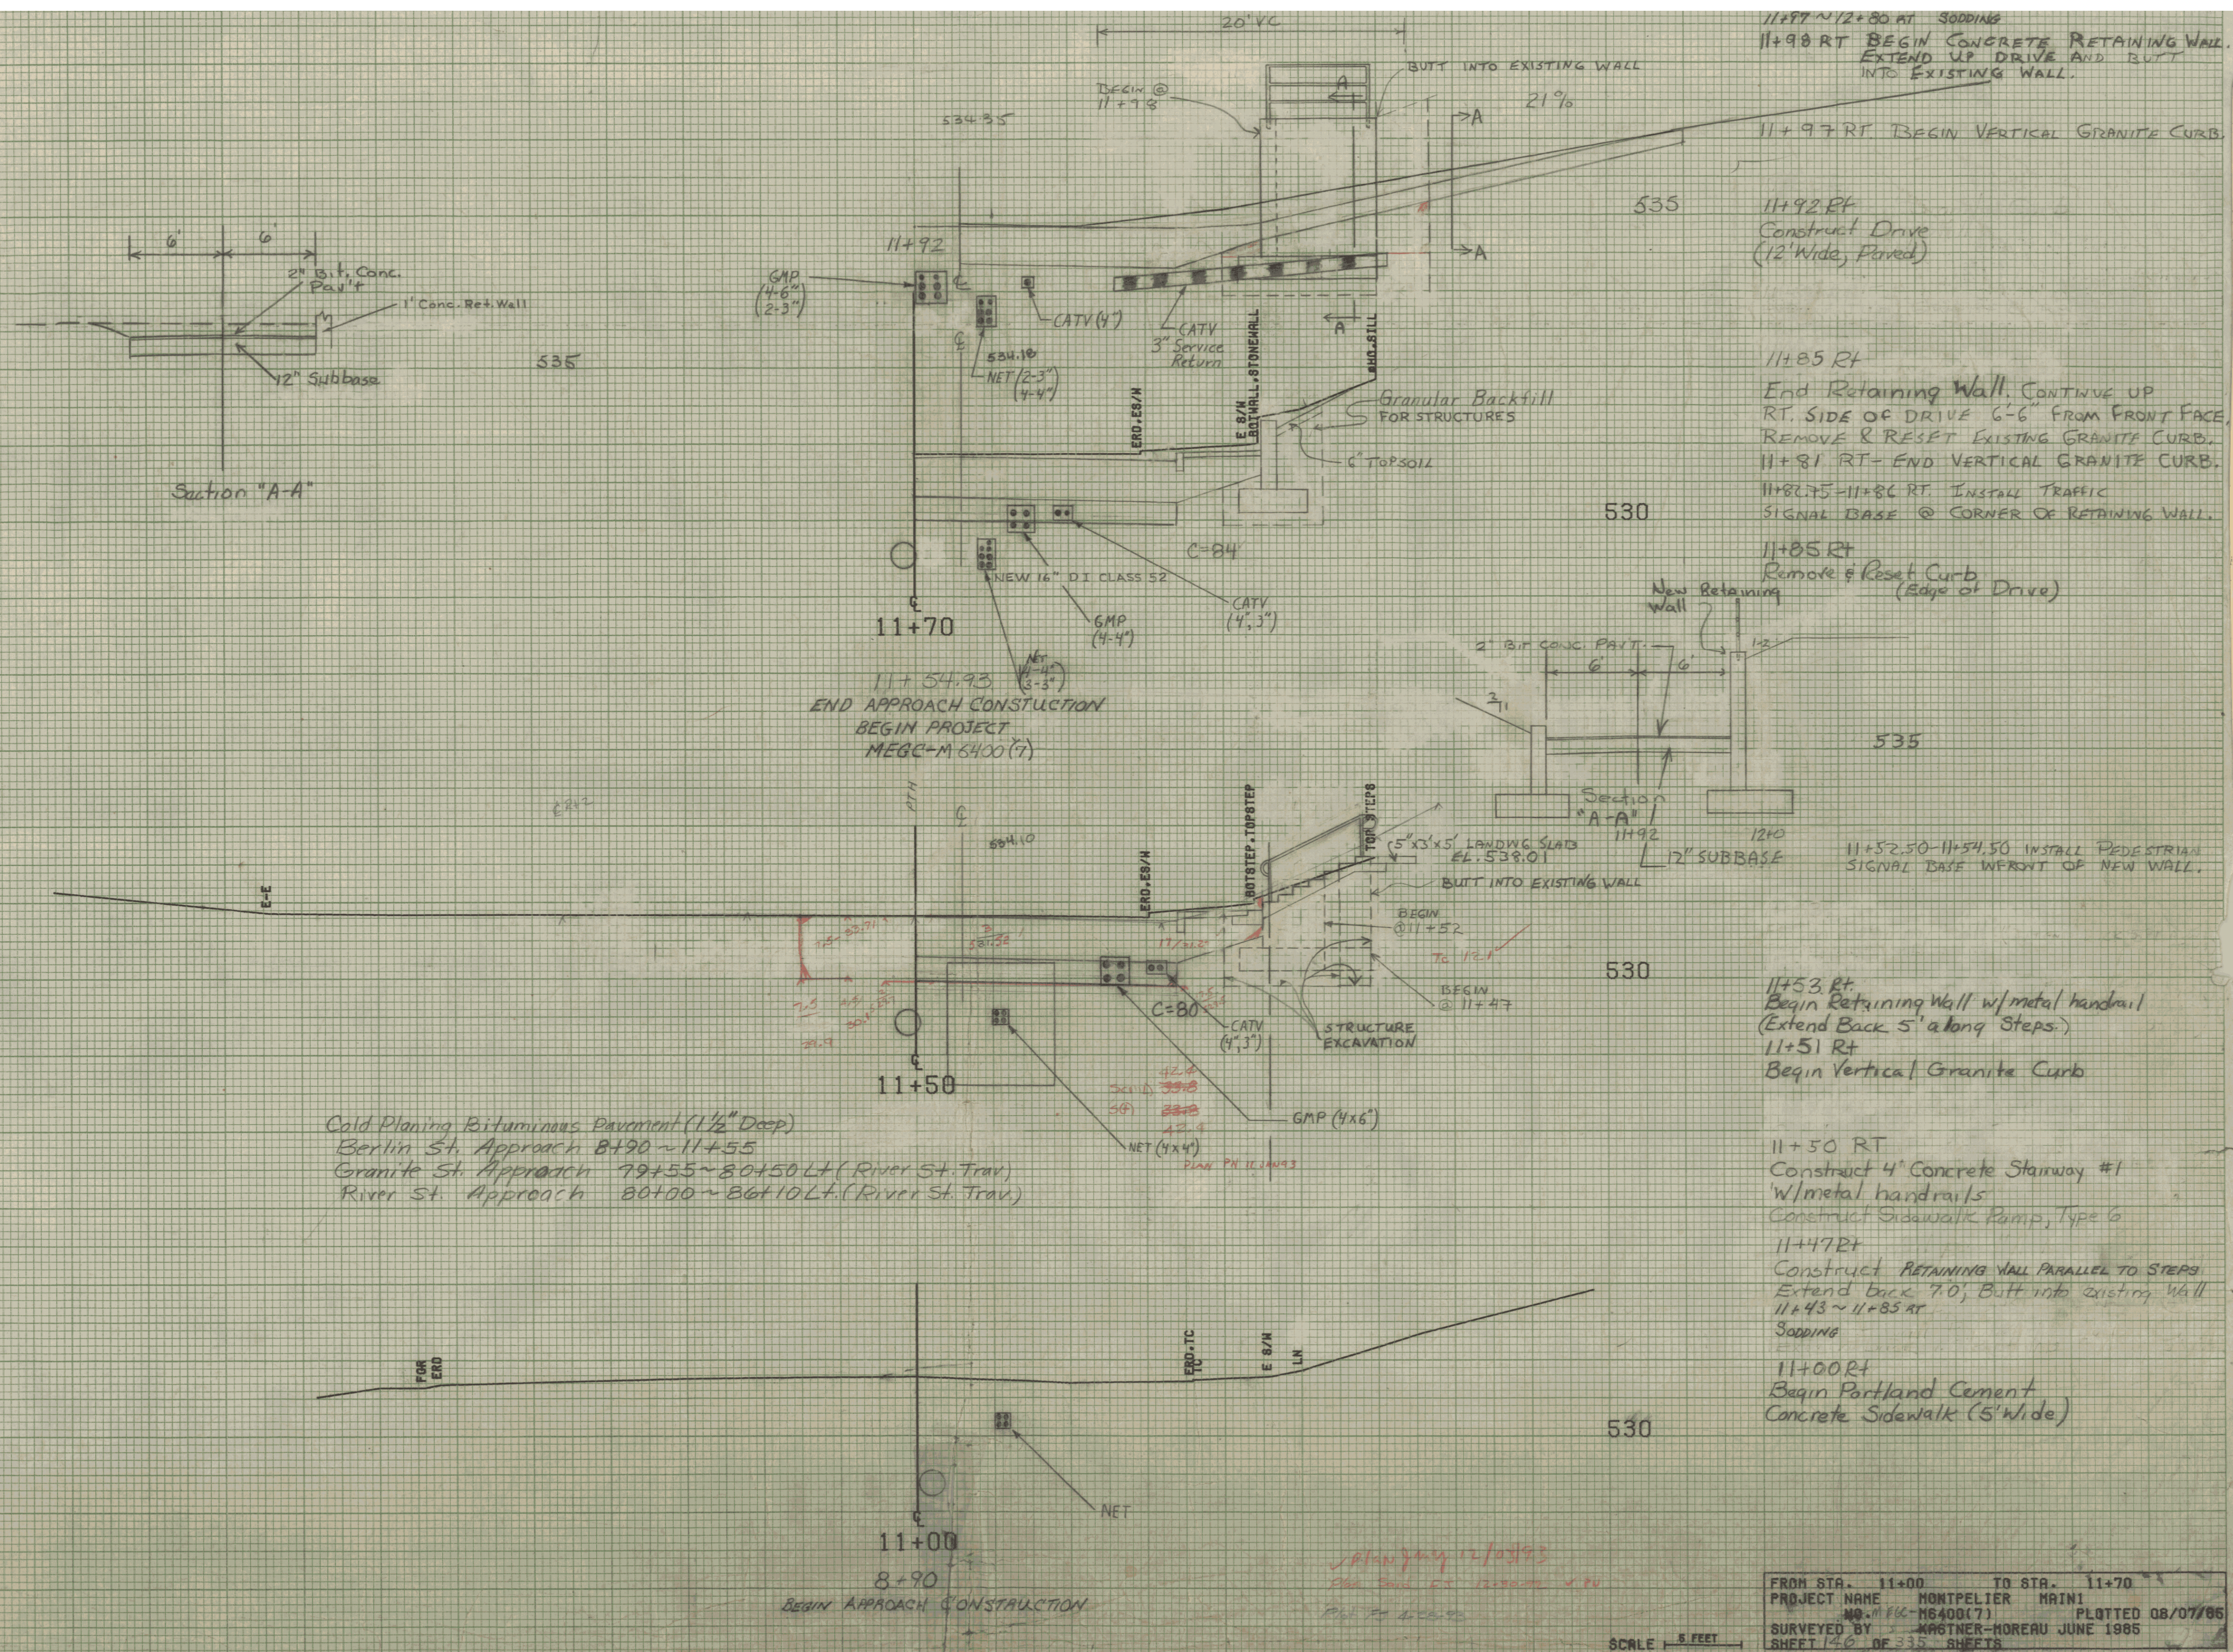

FROM STA. 11+00 TO STA. 11+70  
PROJECT NAME MONTPELIER MAIN  
NO. 1866 M6400(7) PLOTTED 08/07/80  
SURVEYED BY KASTNER-MOREAU JUNE 1985  
SHEET 146 OF 335 SHEETS