


22.7

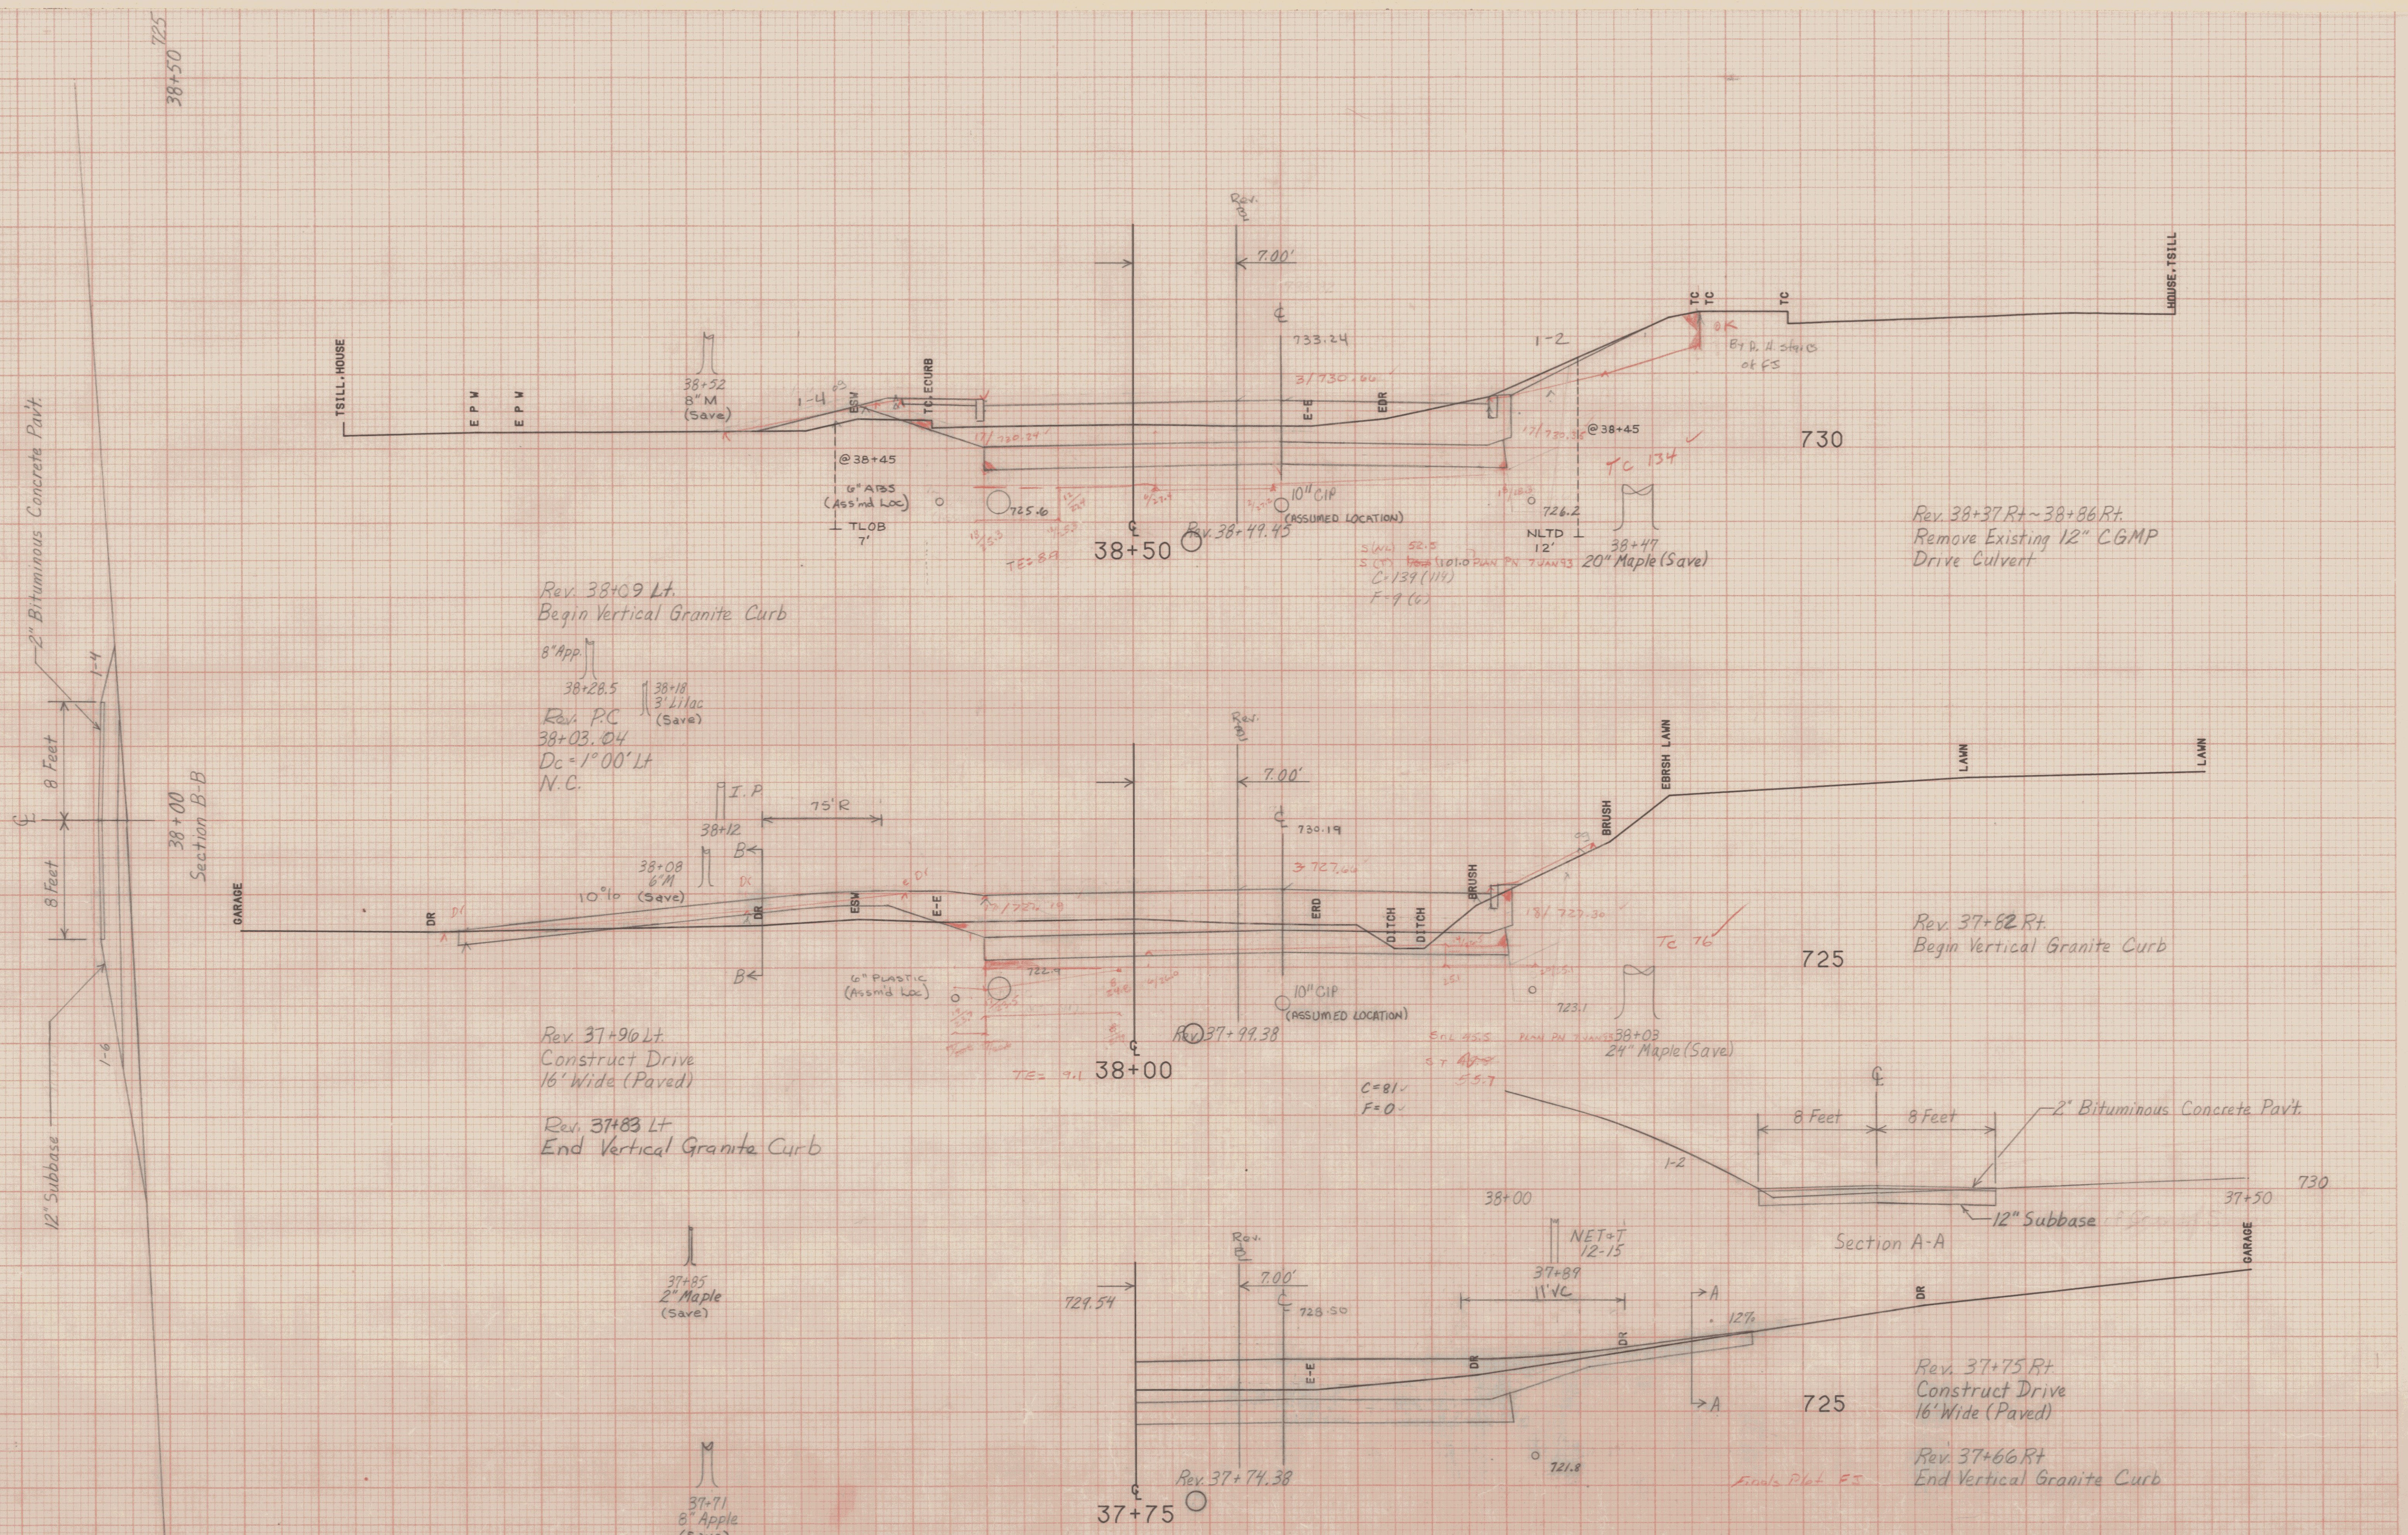

FROM STA.	37+75	TO STA.	38+50
PROJECT NAME	MONTPELIER		
NO.	ME6-M6400 (7)	PLOTTED	05/04/87
SURVEYED BY	KASTNER-MOREAU 06/85		
SHEET	107	OF	335