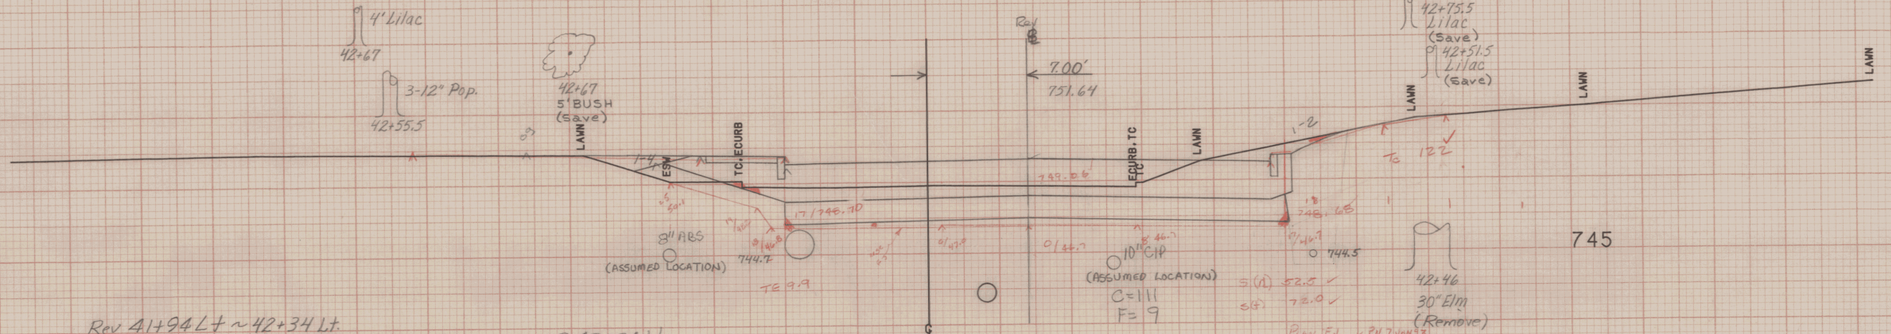

Rev 41+94 Lt ~ 42+34 Lt.
New 6"x 50' Underdrain w/ F.B @ 42+34 Lt.

42+50
Rev. 42+49.81

Rev 41+94 Lt.
End New 6" X 10' Underdrain
Carrier Pipe

Rev 41+95 Rt
Begin New 6"x 500' Underdrain
w/ Flushing Basin @ 46+95 Rt

Rev 41+84 Rt ~ 41+95 Rt
New 6"x 10' Underdrain Carrier Pipe

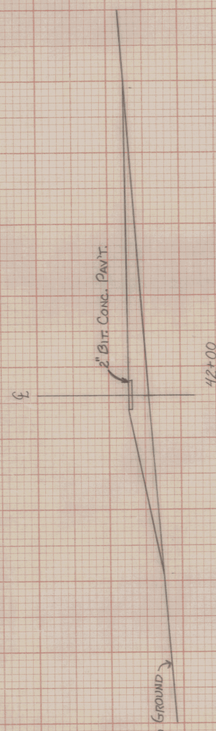

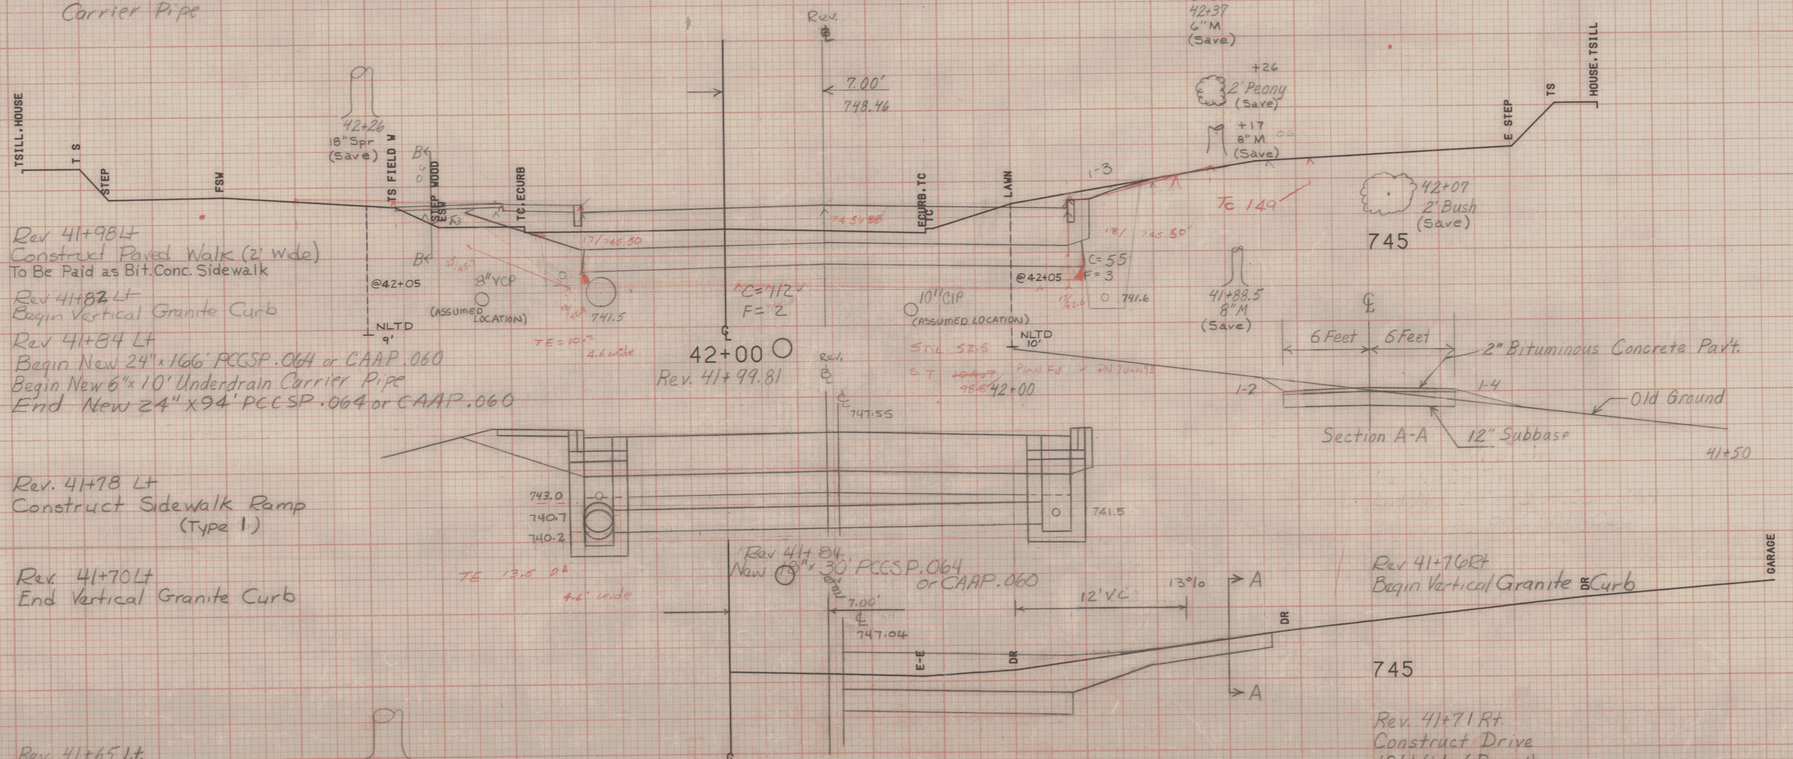

Rev 41+98 Lt
Construct Paved Walk (2' Wide)
To Be Paid as Bit. Conc. Sidewalk
Rev 41+82 Lt
Begin Vertical Granite Curb
Rev 41+84 Lt
Begin New 24"x 166' PCCSP. 064 or CAAP. 060
Begin New 6"x 10' Underdrain Carrier Pipe
End New 24" x 94' PCCSP. 064 or CAAP. 060

Rev. 41+78 Lt
Construct Sidewalk Ramp
(Type 1)

Rev. 41+70 Lt
End Vertical Granite Curb

Rev. 41+84
New 6"x 30' PCCSP. 064
or CAAP. 060

Rev 41+76 Rt
Begin Vertical Granite Curb

Rev. 41+65 Lt.
Begin Portland Cement Conc.
Sidewalk - 5"
5' Wide

41+76
24" Spr.
(Save)

Rev 41+71 Rt
Construct Drive
12' Wide (Paved)

Plot FJ
Plan proof 12/20/87

SCALE 5 FEET

FROM STA.	41+75	TO STA.	42+50
PROJECT NAME	MONTPELIER		
NO. MEGC-	M6400(7)	PLOTTED	05/04/87
SURVEYED BY	KASTNER-MOREAU 06/85		
SHEET 205	OF 335 SHEETS		