


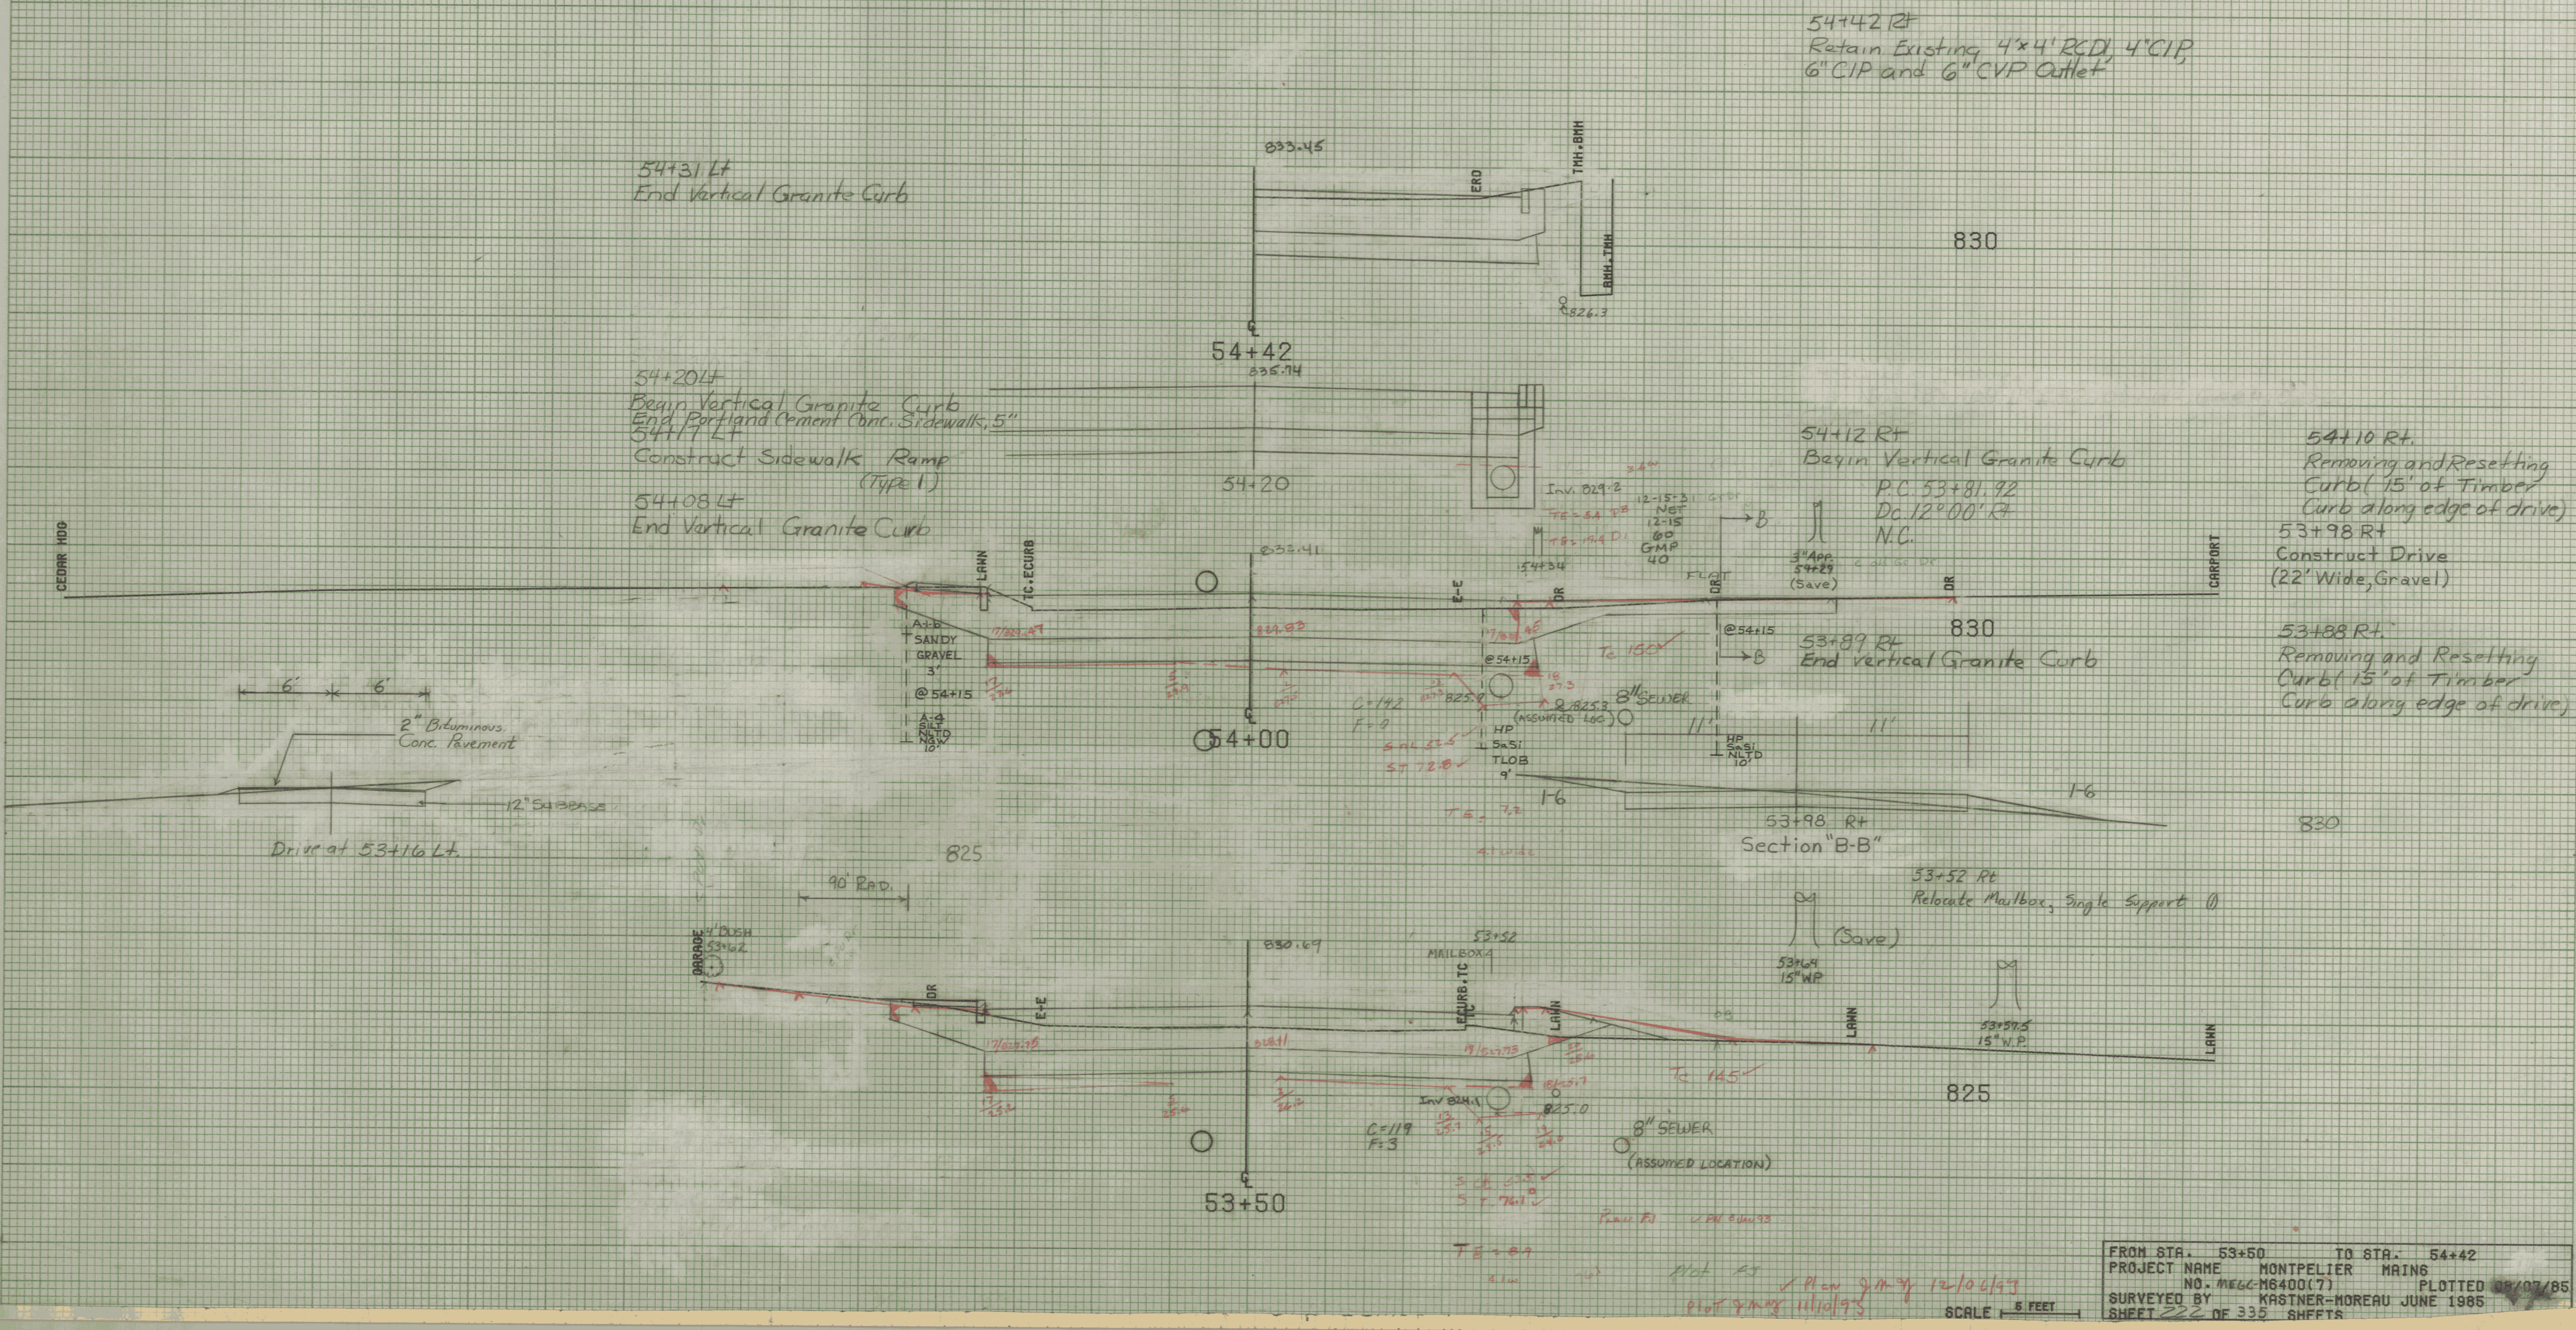

FROM STA.	53+50	TO STA.	54+42
PROJECT NAME	MONTPELIER MAINS		
NO.	ME6-M6400(7)		
SURVEYED BY	KASTNER-MOREAU JUNE 1985		
SHEET	222	OF	335 SHEETS

SCALE 5 FEET
 PLOT 9 MAY 11/10/93
 Plan 9 MAY 12/10/93