



22+25 Rt
Begin Vertical Granite Curb

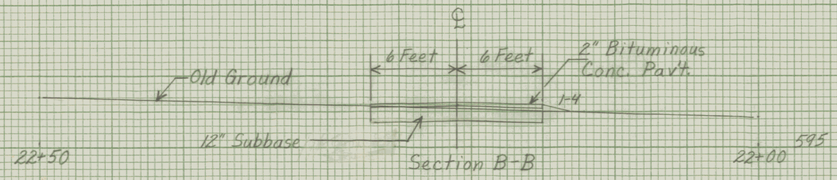


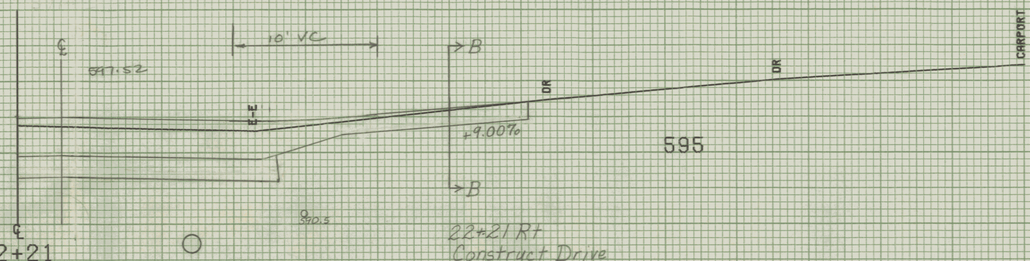

22+21 Rt
Construct Drive
12' Wide (Paved)

22+12 Rt
End Vertical Granite Curb

22+03 Lt. Transplanting Shrub
Mock Orange
Shrub to be transplanted outside of the R.O.W. in a location which is mutually agreeable with the property owner and the resident engineer.

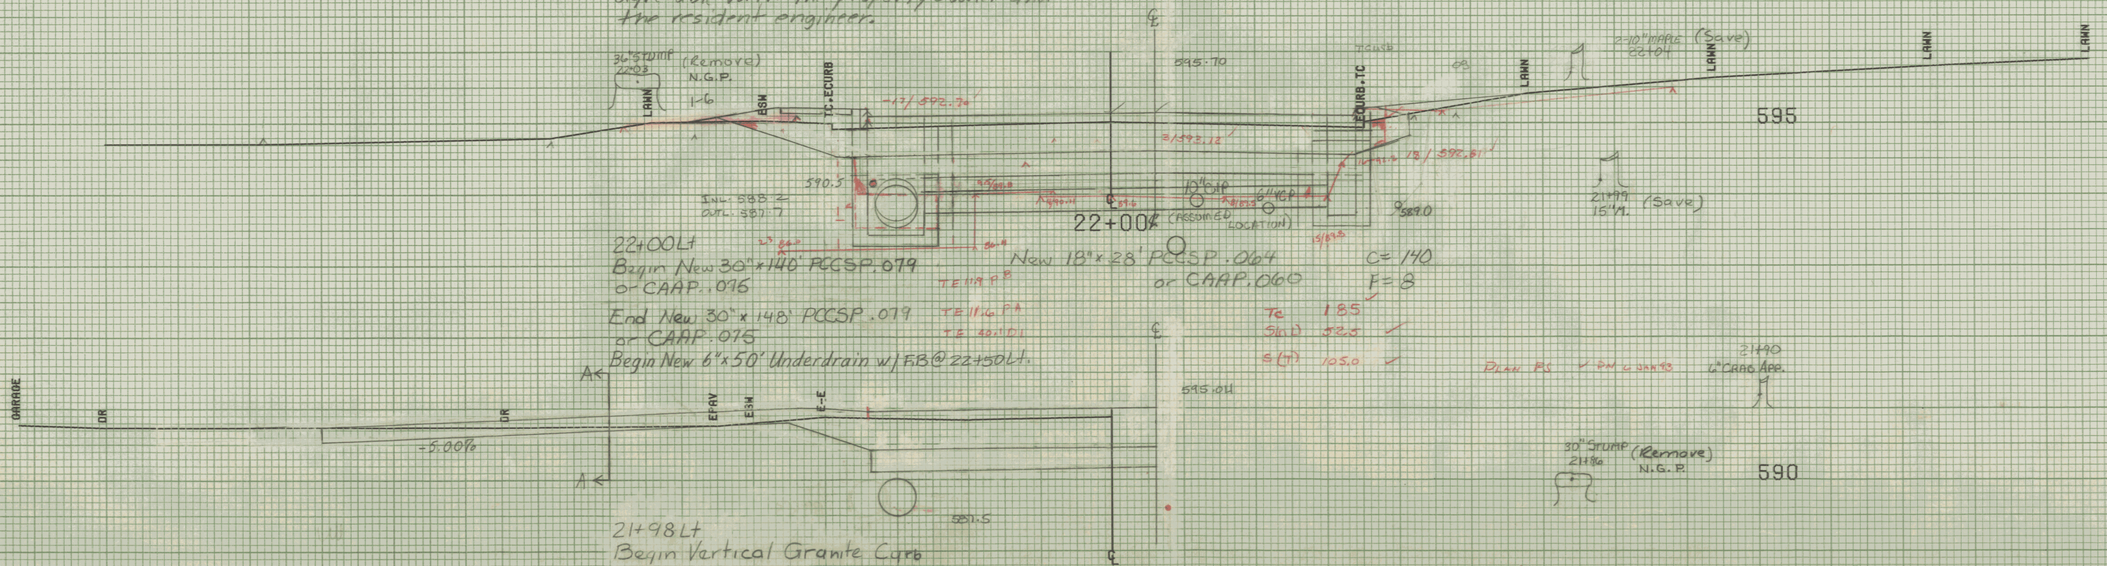

FROM STA.	21+92 TO STA. 22+21
PROJECT NAME	MONTPELIER MAIN2
NO.	M E&L-M6400(7) PLOTTED 08/07/85
SURVEYED BY	KASTNER-MOREAU JUNE 1985
SHEET 71	OF 335 SHEETS

SCALE 5 FEET

23+42 Rt.
Begin 6" x 268' Underdrain w/
Flushing Basin @ 26+10 Rt.

23+42 ℄
New 18"x 28' RCCSP.064
or CAAP.060

23+42 Lt
Begin 30"x 156' RCCSP.079 or
CAAP.075

End New 30"x 140' RCCSP.079 or
CAAP.075

23+42 Rt.
End 6" x 282' Underdrain w/
Flushing Basin @ 23+42 Rt.

23+27 Rt. Remove & Reset Yard Light
The light will be relocated outside the City's R.O.W. limits at a location mutually agreeable with the resident engineer and the property owner. The cost of work and necessary materials shall be paid as Item 67925 (Mod), Removing and Resetting Light Pole, and shall be Non-Gov't. Participating.

23+14 Rt
Construct Drive
16' Wide (Paved)

23+06 Rt
End Vertical Granite Curb

23+21 Lt
Begin Vertical Granite Curb

23+05 Lt
Construct Drive
22' Wide (Gravel)

22+89 Lt
End Vertical Granite Curb

22+50 Lt
End New 6"x 50' Underdrain w/ F.B. @ 22+50 Lt.

Section A-A

Section B-B

12" BALSAM
23+11.5

2.6" CEDAR
23+13

+53.5
2-24" BUTTER NUT
(Save)


15" STUMP (Remove)
22+76 N.G.P.

+64
12" ASH
(Save)

12" STUMP (Remove)
22+58 N.G.P.

FROM STA.	22+50 TO STA. 23+14
PROJECT NAME	MONTPELIER MAIN2
NO.	ME66-M6400(7) PLOTTED 08/07/85
SURVEYED BY	KASTNER-MOREAU JUNE 1985
SHEET	72 OF 335 SHEETS

SCALE 5 FEET

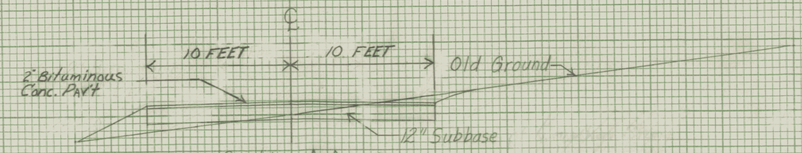


Section A-A

23+80 Lt
Begin Vertical Granite Curb


23+50

24+00


605

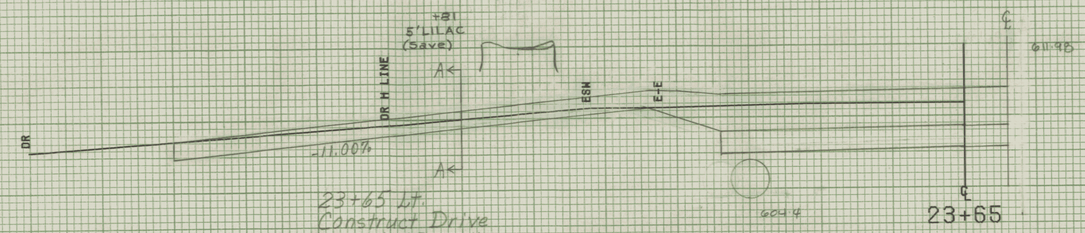


23+65 Lt.
Construct Drive
20' Wide (Paved)

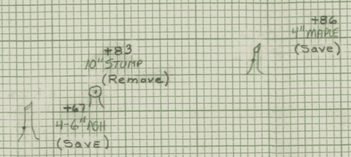

610

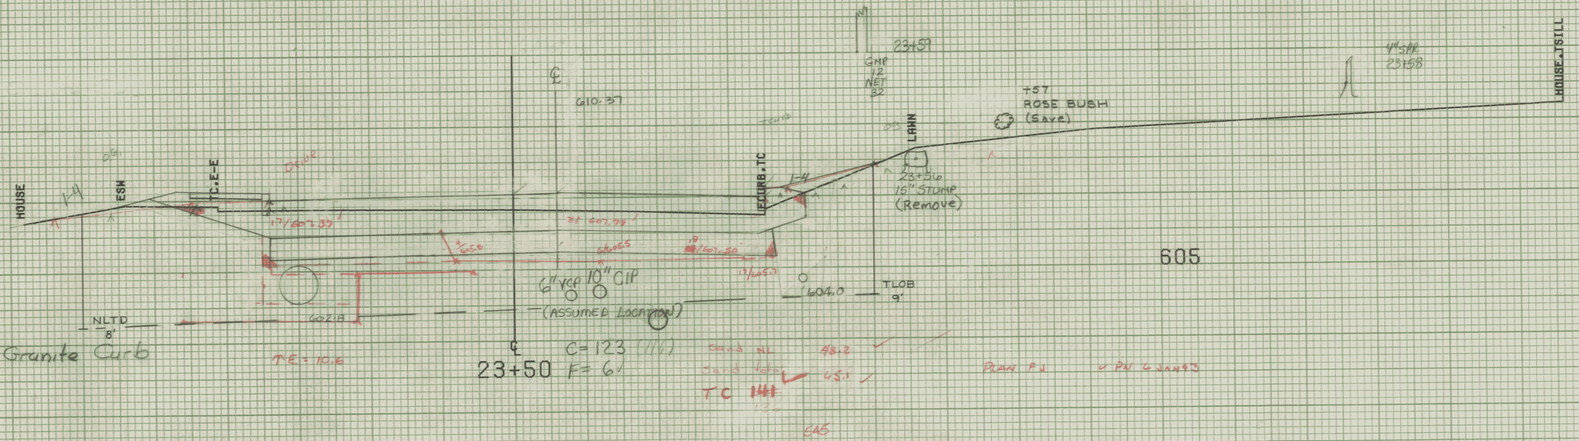

23+50 Lt
End Vertical Granite Curb

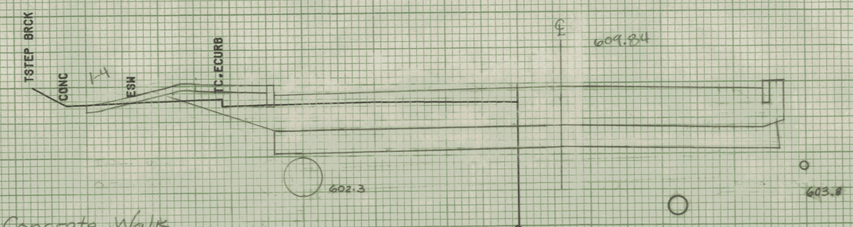

23+45 Lt
Construct Concrete Walk
(5' Wide)
To Be Included w/ Port. Cement Conc. Sidewalk, 5"

605

23+22 Rt
Begin Vertical Granite Curb

FROM STA. 23+45	TO STA. 23+65
PROJECT NAME MONTPELIER	MAIN2
NO. M6400(7)	PLOTTED 08/07/85
SURVEYED BY KASTNER-MOREAU	JUNE 1985
SHEET 112 OF 335 SHEETS	

SCALE 5 FEET

3"P 24+31

4"P 24+37

3"P 24+30.5

3"P 24+30.5

4"P 24+30.5

℄ 24+32

619.18

612.0

LEDGE.TC

LAWN

T. BANK

4" MAPLE 24+32

15" ST. 24+31

2-6" MAPLE 24+30 (Save)

615

2" Bituminous Conc. Pav't.

8 Feet

8 Feet

12" Subbase

1:2

620

24+32

Section A-A

24+00

24+19 Rt
Begin Vertical Granite Curb

℄ 24+15

611.35

12' VC

+15.00%

610.5

DR

DR

DR

H L

E P

A

A

615

24+10 Rt.
Construct Drive
16' Wide (Paved)

24+08
12" M
(Save)

LAWN

1+4

E.S.H.

TC.-ECURB

@23+90

23+95
1" APR.
(Save)

SaSi
A-4
SILT
5'

Si
A-4
SILT
NLTD
NGW
10'

Tc = 17.3

608.2

609.1

℄ 24+00

615.74

612.35

609.0

1"VCP
(ASSUMED LOCATION)

10"CIP

C = 153 (134)
F = 22 (15)

S (mh) 52.5'

S (s) 68.5'

TC 151'

ECURB.TC

LAWN

1+5.5

SaGl
A-1-a
SANDY GRAVEL
3'

SiCl
A-6
SILT
CLAY
2'

HP
A-4
SILT
NLTD
NGW
10'

LAWN

LH LINE


610


24+01 Rt
End Vertical Granite Curb

Plan F2 v PN 6 CAN 73
Plan Jimmy 12/02/93

SCALE 5 FEET


FROM STA. 24+00 TO STA. 24+32
PROJECT NAME MONTPELIER MAIN2
NO. M6400(7) PLOTTED 08/07/85
SURVEYED BY KASTNER-MOREAU JUNE 1985
SHEET 174 OF 335 SHEETS

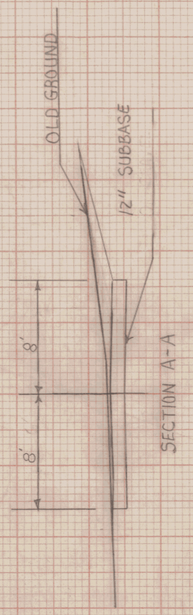


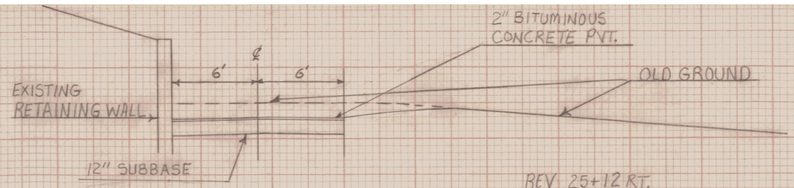

SECTION B-B

REV 25+12 RT.
BEGIN VERTICAL GRANITE CURB

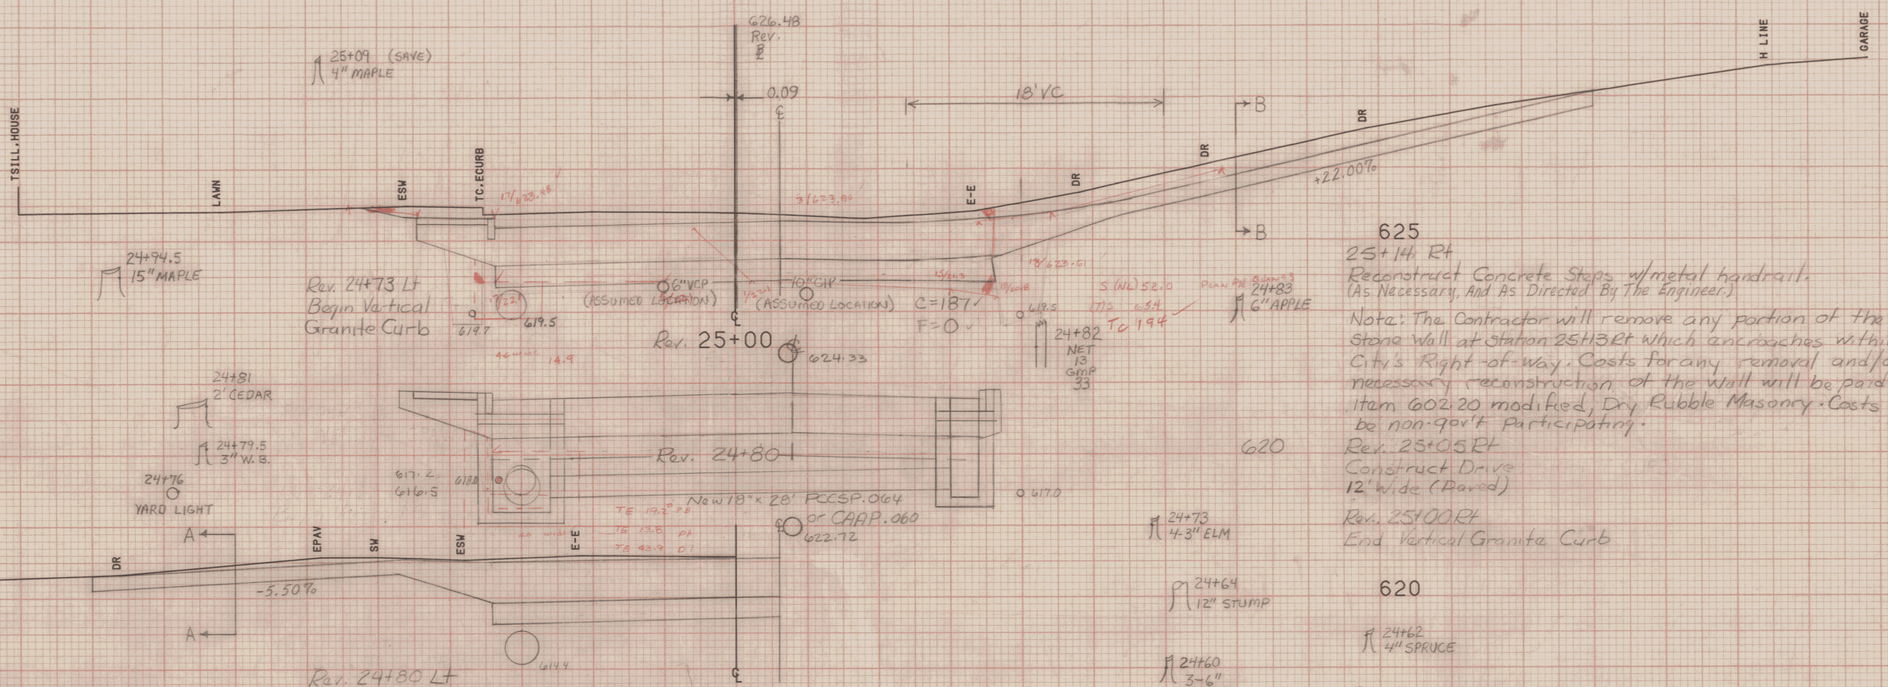

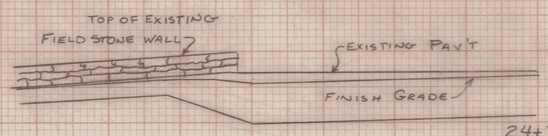

24+70
(Interpolated Section)

Detail showing relative Positions of Existing Pavement & Retaining Wall Vs Improvement.

625
25+14 Rt
Reconstruct Concrete Steps w/metal handrail.
(As Necessary, And As Directed By The Engineer.)

Note: The Contractor will remove any portion of the existing stone wall at station 25+13 Rt which encroaches within the City's Right-of-Way. Costs for any removal and/or necessary reconstruction of the wall will be paid under Item 602.20 modified, Dry Rubble Masonry. Costs will be non-gov't participating.

Rev. 25+05 Rt
Construct Drive
12' Wide (Paved)

620

Rev. 25+00 Rt
End Vertical Granite Curb

620

Rev. P.C. 24+77.92 Rt
Dc 2°00'
N.C.

620


EJ Plot 4-29-93
Plan proj 12/03/93

SCALE 5 FEET

FROM STA. 24+50		TO STA. 25+00	
PROJECT NAME	MONTPELIER		
NO.	M6400(7)		PLOTTED 05/04/87
SURVEYED BY	KASTNER-MOREAU 06/85		
SHEET 175 OF 335 SHEETS			

Rev. 25+37 Lt
End Vertical Granite Curb


Rev. 25+30 Lt.
End New 6"x50' Underdrain
w/ F.B @ 25+30 Lt.

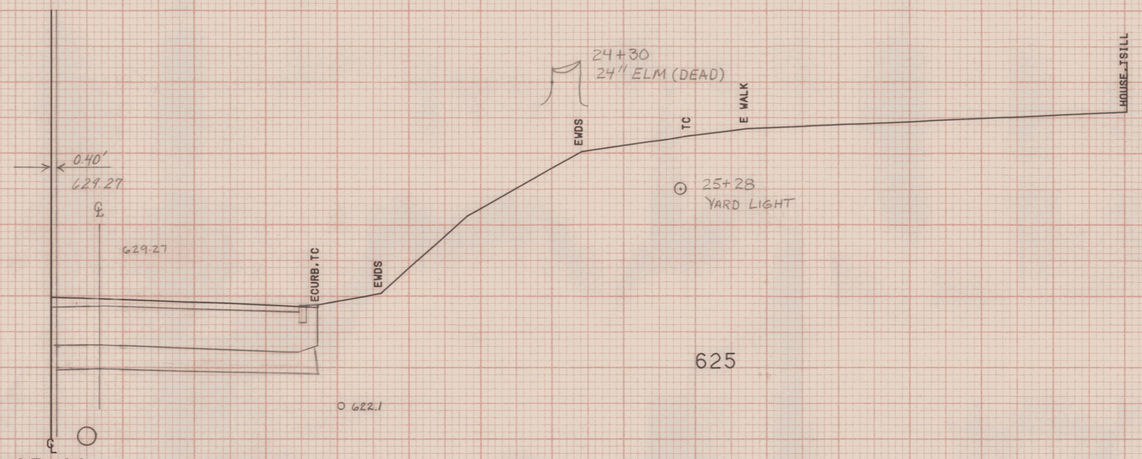


Rev. 25+26

25+23
4" MAPLE
(Save)


Rev. 25+17 Lt
Construct Paved Walk
(3' Wide)
To Be Paid as Bit. Conc. Sidewalk

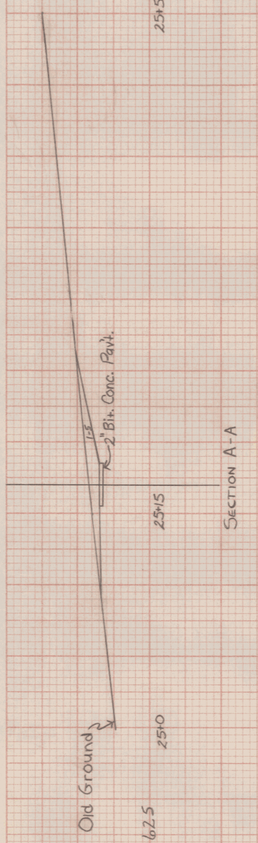

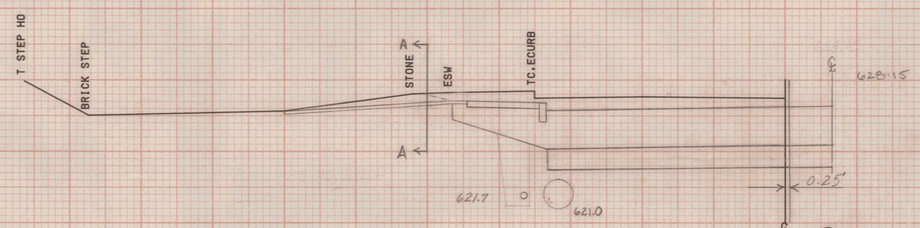

Rev. 25+15.50

625

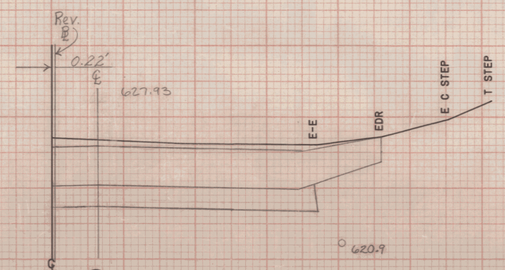



Rev. 25+13.50

625

SCALE 5 FEET


FROM STA. 25+13.50 TO STA. 25+26
PROJECT NAME MONTPELIER
NO. M-EGC-M6400(7) PLOTTED 05/04/87
SURVEYED BY KASTNER-MOREAU 06/85
SHEET 176 OF 335 SHEETS

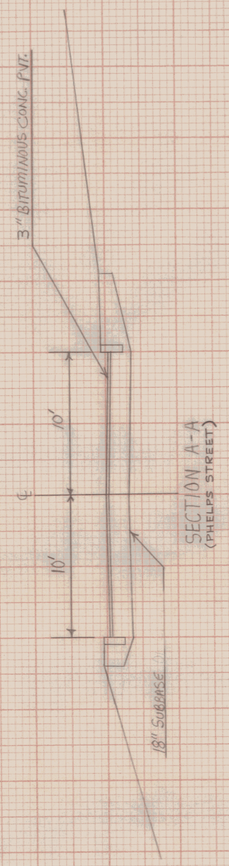

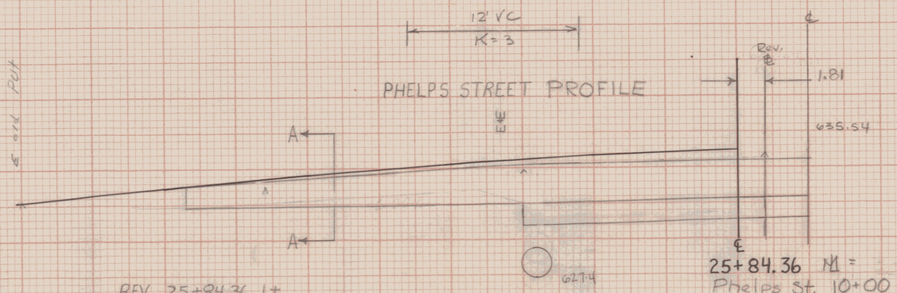

REV 25+84.36 Lt
CONSTRUCT APPROACH
20' WIDE (PHELPS ST.)


Rev 25+80 Lt
Begin Vertical Granite Curb

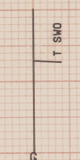

Rev. 25+75 Lt ~ Rev. 26+01 Lt
Remove Existing RCDI
See Water & Sewer Plans for Pipe Relocation
Rev. 25+74 Lt
Adjust elev. of manhole (Non-Gov't. Part.)

635

Rev. 25+82 Rt ~ 25+97 Rt
Remove Existing 18" CMP & Headwall

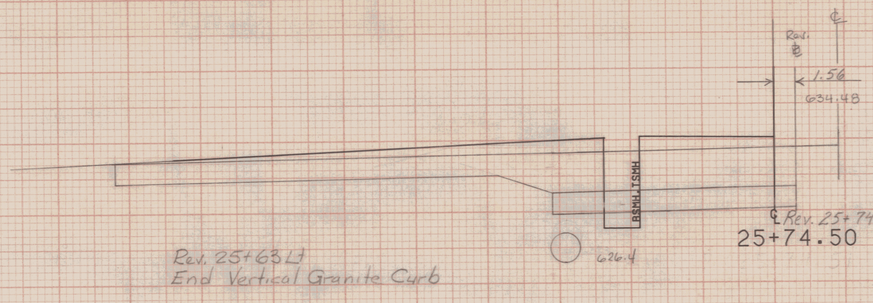


635

Rev. 25+63 Lt
End Vertical Granite Curb

Rev. 25+58 Lt
End Portland Cement Concrete Sidewalk-5" (5' wide)

Rev. 25+54 Lt
Construct Sidewalk Ramp (Type 6)


Rev. 25+52 Lt
Begin Vertical Granite Curb

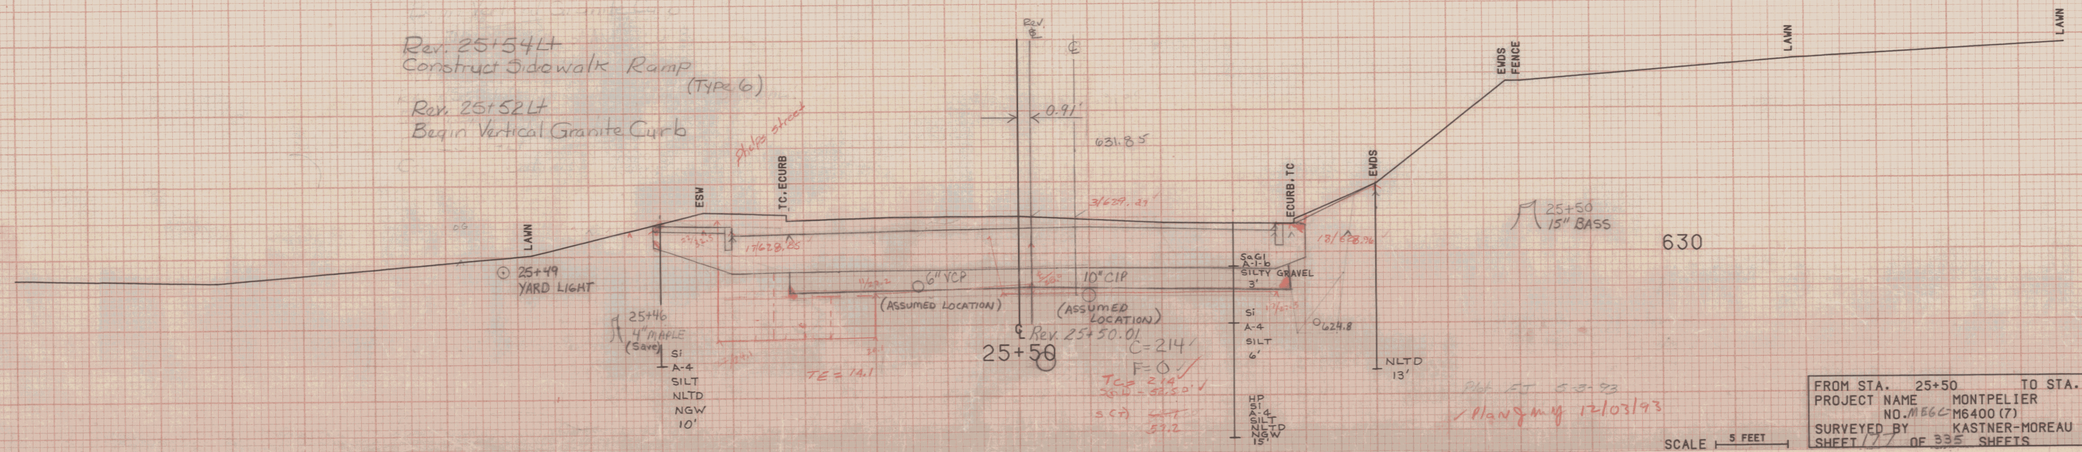

FROM STA. 25+50	TO STA. 25+90
PROJECT NAME MONTPELIER	
NO. M6GC-M6400(7)	PLOTTED 05/04/87
SURVEYED BY KASTNER-MOREAU 06/85	
SHEET 11 OF 335 SHEETS	

SCALE 5 FEET

Rev. 26+06 Lt
End New 24"x 126' PCCSP.064
or CAA P.060

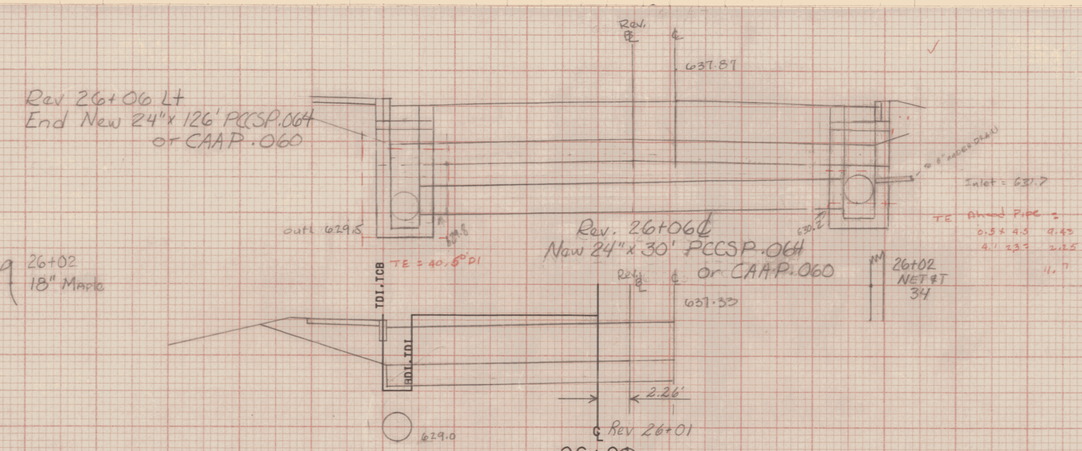

26+02
18" Maple


Rev. 26+15 Rt
Begin New 6"x 535' Underdrain
w/ Flushing Basin @ 31+48 Rt

Rev. 26+06 Rt
Begin New 24"x 188' PCCSP.064
or CAA P.060

635

Rev. 26+06 - 26+15 Rt
New 6"x 10' Underdrain Carrier Pipe

Rev. 26+10 Rt
End New 6"x 268' Underdrain
w/ Flushing Basin @ 26+10 Rt

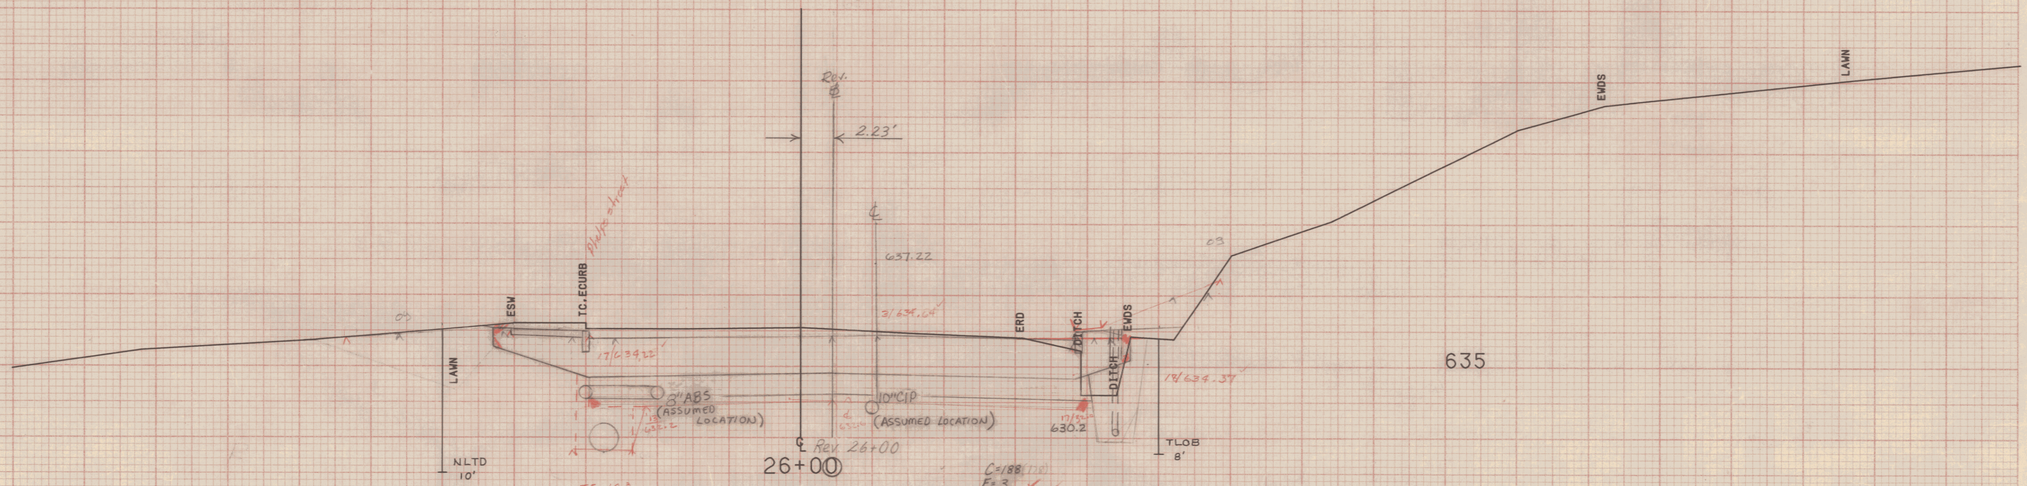


Rev. 25+95 Lt
Construct Sidewalk Ramp
(Type 6)

Rev. 25+94 Lt
End Vertical Granite Curb

Rev. 25+92 Lt (Phelps St. 10+60 Rt)
Begin Portland Cement Concrete Sidewalk - 5"
(5' Wide)

25+96
SIGN

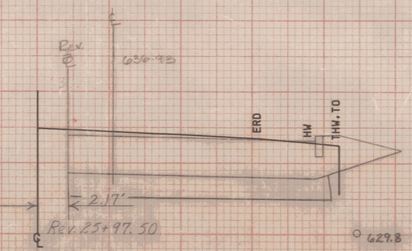

635

635

Plan FJ PN 6 Jan 93
Plot FJ 5:03:83
Plan 9 proj 12/03/93

SCALE 5 FEET

FROM STA.	25+97.50 TO STA. 26+01
PROJECT NAME	MONTPELIER
NO. M866	M6400(7) PLOTTED 05/04/87
SURVEYED BY	KASTNER-MOREAU 06/85
SHEET 178	OF 335 SHEETS

645

8 Feet ℄ 8 Feet — 2" Bituminous Concrete Pavit

26+75
36" Stump
(Remove)

Section A-A — 12" Subbase

8' ℄ 8' — 2" BITUMINOUS CONCRETE PAVEMENT

12" SUBBASE

640

SECTION B-B
26+50

Rev. 26+74.94
Rev.
℄ 4.23'
645.28
26+75
638.2
637.3

Rev. 26+53.96
Rev.
℄ 3.67'
643.02
E-E
PW
PW
PW
EPW FSTONE
636.0
636.0

℄
26+54
REV. 26+53.96

REV 26+70 Rt
Begin Vertical Granite Curb

Rev 26+50 Rt ~ Rev 26+68 Rt
Remove Existing 18" Drive Culvert

640

Rev. 26+52
End Vertical Granite Curb

Rev. 26+60 Rt
Construct Drive 16' Wide (Paved)
Removing and Resetting Fence

LAWN
H LINE
H LINE
H LINE
LAWN
8S
ESW
TC.ECURB
Rev.
℄ 3.56'
642.59
3/640.01'
E-E
EPW
EPW
PW
PW
DRIVE
A
A
B
B
EPW
HOUSE
640

8" ABS
(ASSUMED LOCATION)
686.0
10" CIP
(ASSUMED LOCATION)
636.0
26+46
48" STUMP
(Remove)
℄ Rev. 26+49.96
26+50

C=139
F=1
Tc 182
s (NL) ~ 5.0
s (T) ~ 6.4
Tc = 4.6 x 2.1 = 9.66

Rev. 26+28 LT
Construct Conc. Walk (3' wide)
To Be Included w/ Port. Cement Conc.
Sidewalk, 5"

26+34
2' BUSH
26+31
2' CEDAR
26+24
2' CEDAR
26+20
2' BUSH
HOUSE
TS.ESTEP
EW STEP
ESW
C W
TC.ECURB
Rev.
℄ 2.96'
640.17
26+20
8" MAPLE
(SAVE)
633.0
℄ Rev. 26+27.48
26+27.50

Rev. 26+02 LT
Begin Vertical Granite Curb

640

640

Plan grade 12/03/93
Plot FJ 12-3-93
Plot grade 11/15/93


SCALE 5 FEET


FROM STA.	26+27.50	TO STA.	26+54
PROJECT NAME	MONTPELIER		
NO. M E66	M6400 (7)		PLOTTED 05/04/87
SURVEYED BY	KASTNER-MOREAU 06/85		
SHEET 179	OF 335 SHEETS		

Rev 27+60 ~ 27+84 Rt
Remove Existing 18" RCP Drive Culvert

650

Rev 27+52 Lt
Adjust Elev. of DI
New C.I. Cover w/frame
Non-Gov't. Part.

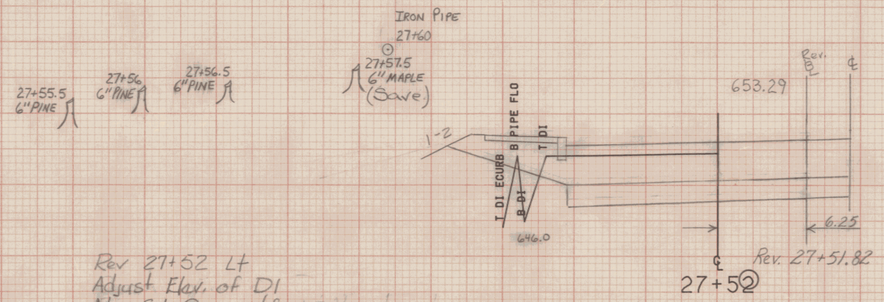

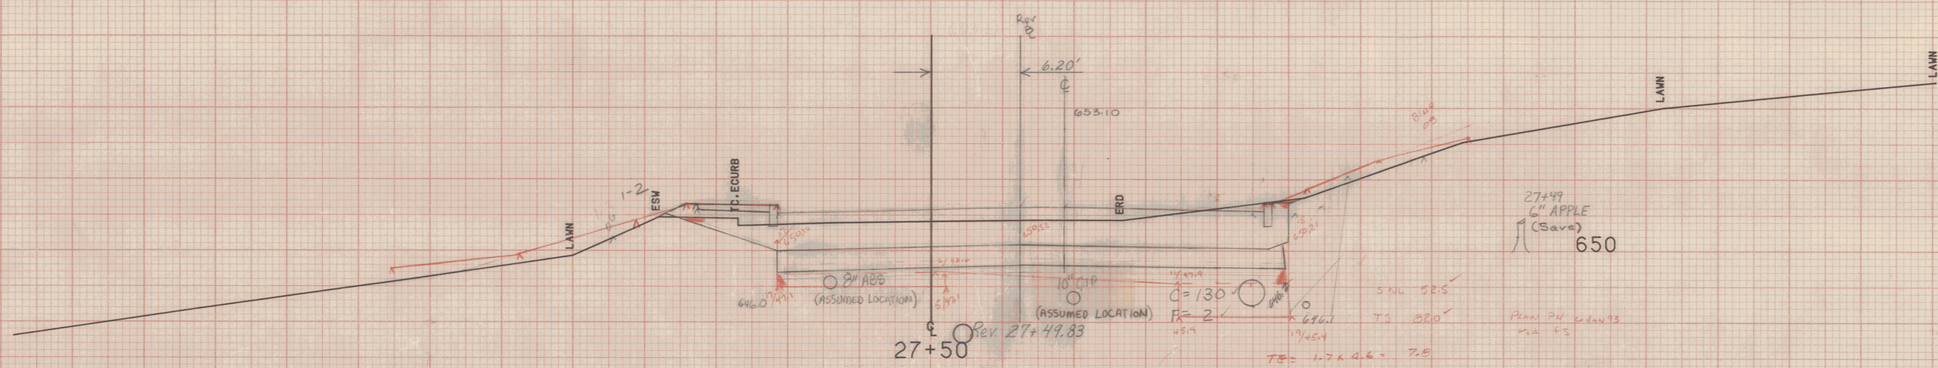

Plot grading 11/15/93

FROM STA.	27+00	TO STA.	27+52
PROJECT NAME	MONTPELIER		
NO.	M6400(7)	PLOTTED	05/04/87
SURVEYED BY	KASTNER-MOREAU 06/85		
SHEET 120	OF 335 SHEETS		

SCALE 5 FEET

Rev. 28+45 Lt.
End New 6"x 50' Underdrain
w/ F.B @ 28+45 Lt.

Rev 28+10 Rt
Exist. 18" RCP to be plugged & to remain in place

28+23.5
6" APPLE
(Save)

28+80
6" MAPLE
(Save)

TSILL-HOUSE
LAWN
TO. ECURB
ESW
ERD
DITCH
DITCH
E.LAWN

28+18
NET & T
36
GMP
1-5

28+18
36" W.P. Stump
Remove

6.95'
657.81
655.23
655.72
8" ABS
(ASSUMED LOCATION)
10" CIP
(ASSUMED LOCATION)
28+00
Rev. 27+99.72
C=91
F=10
650.8
½ CY
BOULDER
27+93
TE=12.0
PLAN F.S. x PVC DIAM 93
TE = 1.4 x 4.4 = 8.7

655
6.5'
6.5'
1-2
1-2
12" SUBBASE
Section "A-A"

27+95 Lt.
Begin New 6"x 50' Underdrain
w/ F.B. @ 28+45 Lt.
27+91 LT.
BEGIN VERTICAL GRANITE CURB

SaSi
A-4
SILT
NLTD
10'

SaSi
A-4
SANDY SILT
NLTD
11'

Rev 27+95
652
650.5
650.2
New 18"x 30' PCCSP.064
or CAAP.060
6.78'
656.17
660.11
Inlet: 650.4
Outlet: 649.6

Rev 27+95 Rt.
End New 24"x 188' PCCSP.064
or CAAP.060
Begin New 24"x 148' PCCSP.064
or CAAP.060

TE 10.0 P.E
TE 26.0 01
TE 7.3 P.R

Rev. 27+79 Rt
Begin Vertical Granite Curb

650

GARAGE
DR
DR
ESW
E-I-E
-1.50%
C
C
648.1
Rev. 27+81.76
27+82

5'
5'
℄
12" SUBBASE
655
Section "B-B"

Rev. 27+82 Lt
Construct Drive
(15' Wide, Paved)

℄
7.5'
7.5'
2" Bituminous
Conc. Pavt.
12" SUBBASE
SCALE: 1"=5'
650
Section "C-C"
28+00
27+82
27+50

Rev 27+68.29
6.58'
654.89
E-I-E
EPAY
DR
DR
+18.00%
"A"
"A"
"B"
"B"
EDR
650
697.9
697.8
27+68.50

Rev. 27+69 Lt
End Vertical Granite Curb

Rev 27+71 Rt.
Construct Drive
(13' Wide, Gravel)

Rev 27+63 Rt
End Vertical Granite
Curb


Plot EJ 1 03 93
Plot 9 Proj 10/15/93
Plan Proj 12/03/93


SCALE 5 FEET

FROM STA. 27+68.50 TO STA. 28+00
PROJECT NAME MONTPELIER
NO. M EGC M6400(7) PLOTTED 05/04/87
SURVEYED BY KASTNER-MOREAU 06/85
SHEET 187 OF 335 SHEETS

Rev. 28+78 Lt
Begin Vertical Granite Curb

28+78.5
4-2" Ced.

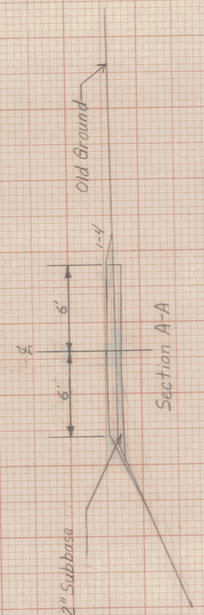

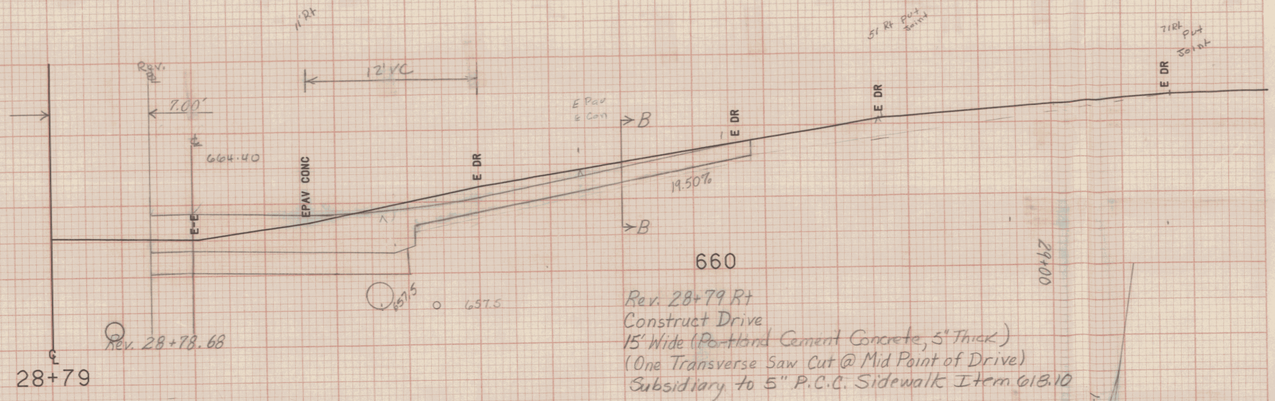


660

Rev. 28+79 Rt
Construct Drive
15' Wide (Portland Cement Concrete, 5" Thick)
(One Transverse Saw Cut @ Mid Point of Drive)
Subsidiary to 5" P.C.C. Sidewalk Item 618.10

Rev. 28+73 Rt
End Vertical Granite Curb


660

Rev. 28+67 Rt
Remove & Reset Yard Light
The light will be relocated outside the City's R.O.W. Limits at a location mutually agreeable with the resident engineer and the property owner. The cost of work and necessary materials shall be paid under Item 679.25 (Mod), removing and resetting light pole and shall be Non-Gov't. Participating.

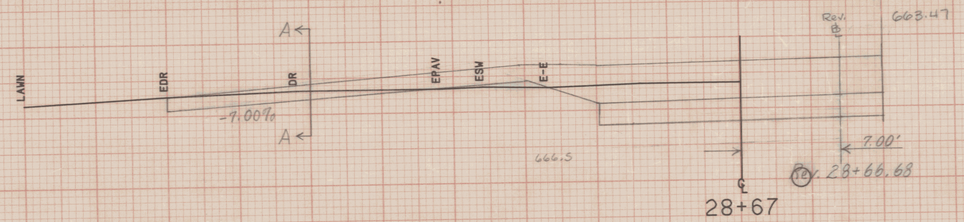


Rev. 28+67 Lt
Construct Drive
12' Wide (Gravel)

Rev. 28+56 Lt
End Vertical Granite Curb

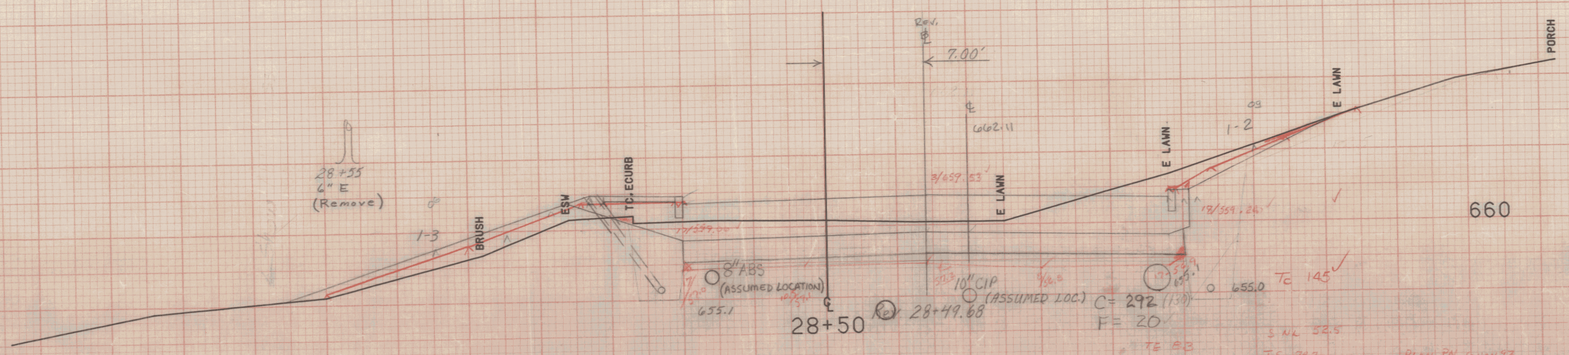

660

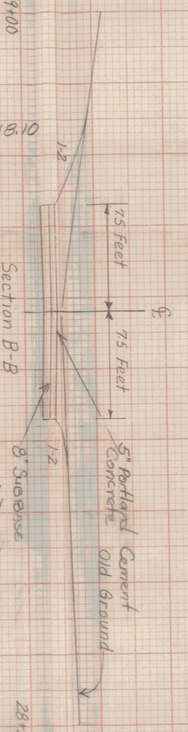


FROM STA.	28+50 TO STA. 28+79
PROJECT NAME	MONTPELIER
NO.	MEGC-M6400(7) PLOTTED 05/04/87
SURVEYED BY	KASTNER-MOREAU 06/85
SHEET 182	OF 335 SHEETS

SCALE 5 FEET

Rev. 29+44 RT
Begin New 24" x 120' PCCSP .064 or CAAP .060
End New 24" x 148' PCCSP .064 or CAAP .060

See Wilson St. X-Section 15+50
Sheet 156


29+44 Rt. ~ Wilson St. 15+50 Rt.
New 12" x 60' CSP (.064) or CAAP(.060)

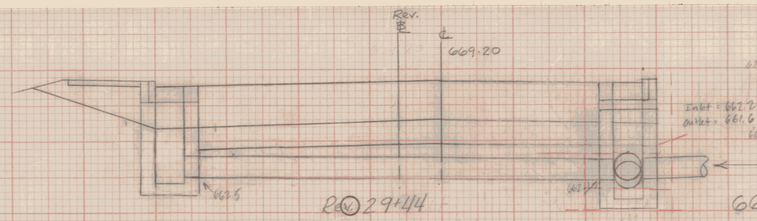

New 18"x30' PCCSP .064 Or CAAP .060

Rev. 29+48 LT
End Vertical Granite Curb

Rev. 29+40 LT
Remove & Reset Flagstone Walk (3' wide)
To Be Paid as Cement Rubble Masonry

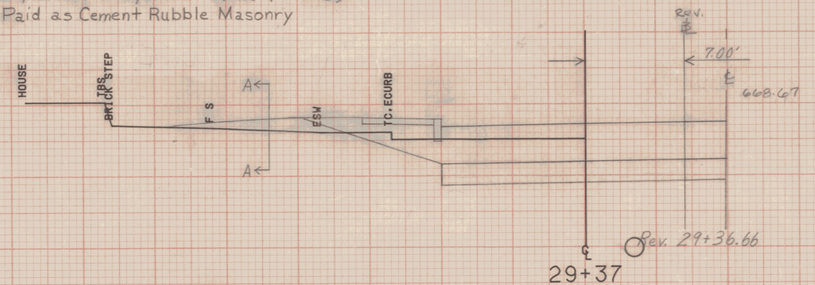


665

Surv. 29+06.5 Rt
Exist. 18" RCP Drive Culvert, Remove



Rev PC 29+14.37
Dc = 1°00' Rt
N.C.

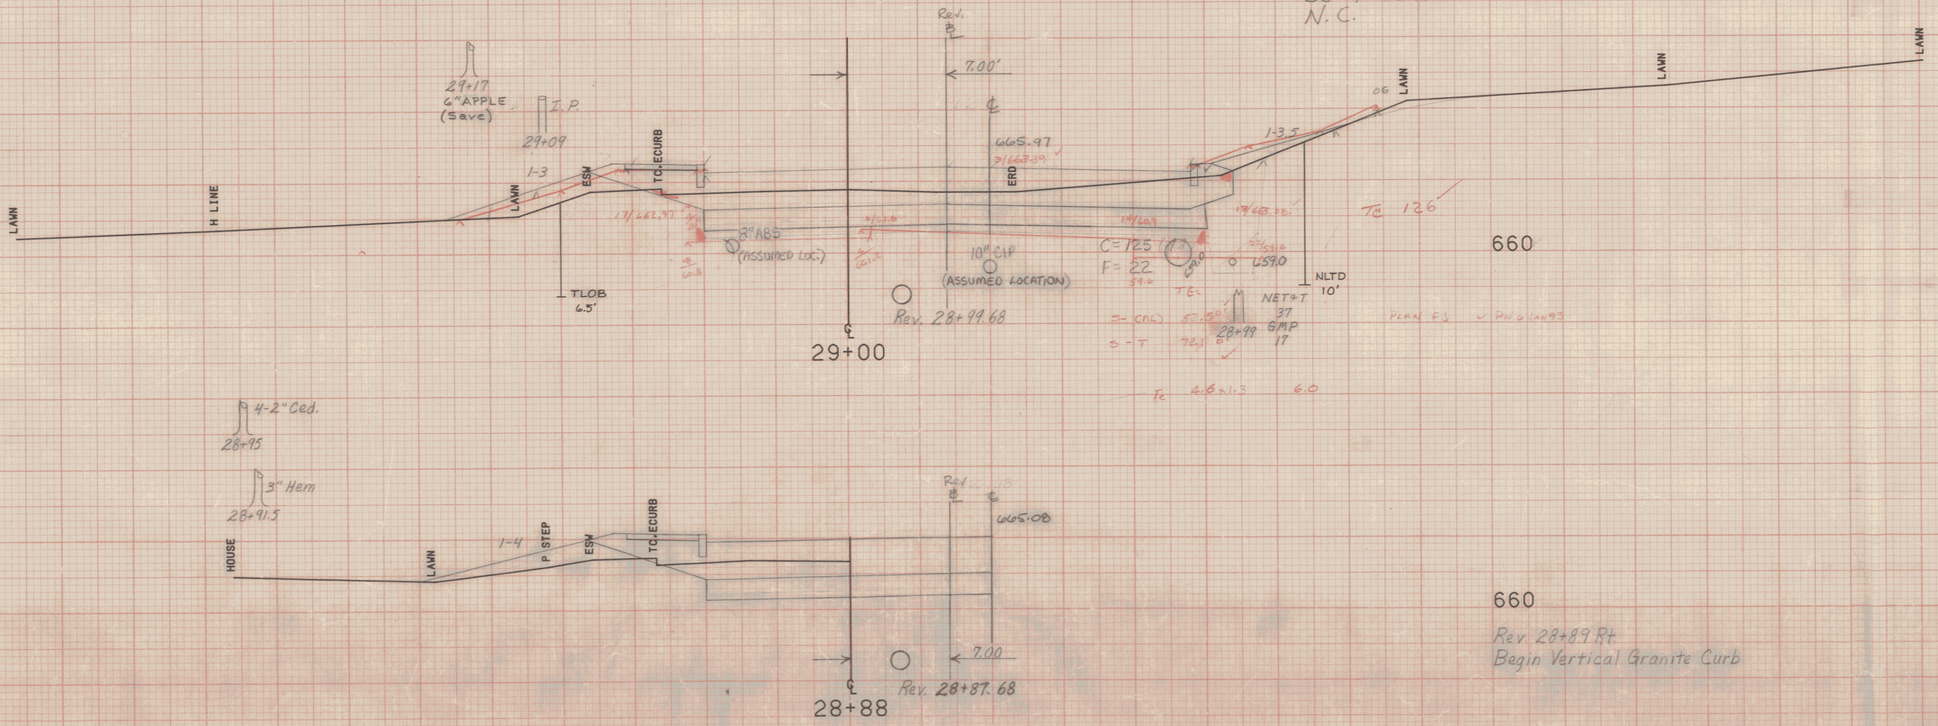


660

Rev. 28+89 Rt
Begin Vertical Granite Curb


Plot EJ 5-393
Pl. 7 jmg 10/11/93
Plan jmg 12/03/93

FROM STA.	28+88 TO STA. 29+37
PROJECT NAME	MONTPELIER
NO. M6400(7)	PLOTTED 05/04/87
SURVEYED BY	KASTNER-MOREAU 06/85
SHEET 185	OF 335 SHEETS

SCALE 5 FEET

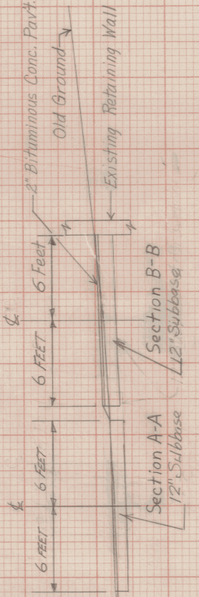

+98.5
3' ROSE BUSH
(Save)

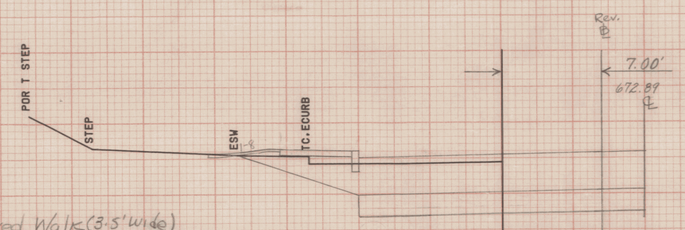

Rev. 29+95 Lt
Construct Paved Walk (3.5' wide)
To Be Paid as Bit. Conc. Sidewalk

Rev. 29+75 Lt
Begin Vertical Granite Curb

29+95

Rev. 29+94 Rt
End Vertical Granite Curb

Street Signs
29+92.5

Rev. 29+89 Rt ~ 30+36 Rt
Remove Existing 18" ACCGMP


670

NET+T
38
GMP
18
29+90

Brace Pole
29+90

2-4" Bal.
29+74.5

29+79.5
8" APPLE
(Save)

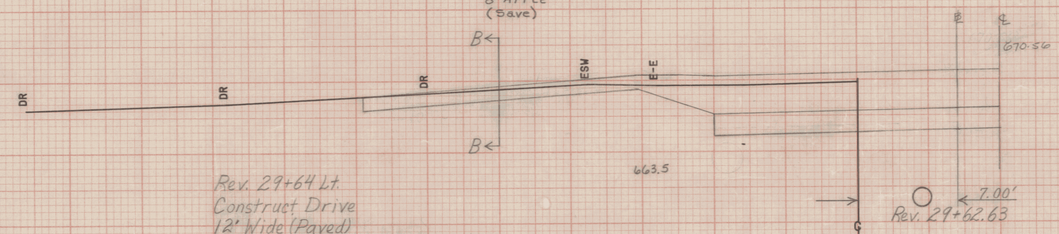

29+63


Rev. 29+64 Lt.
Construct Drive
12' Wide (Paved)
(Do not disturb existing
Retaining Wall)

Rev. 29+44 Lt ~ 29+65 Rt
Naw 18" x 36' PCCSP.064
or CAAP.060

665

Rev. 29+88 Rt.
Remove Existing 12" VCP (Wilson St.)

Rev. 29+54 Lt.
Construct Drive
12' Wide (Gravel)

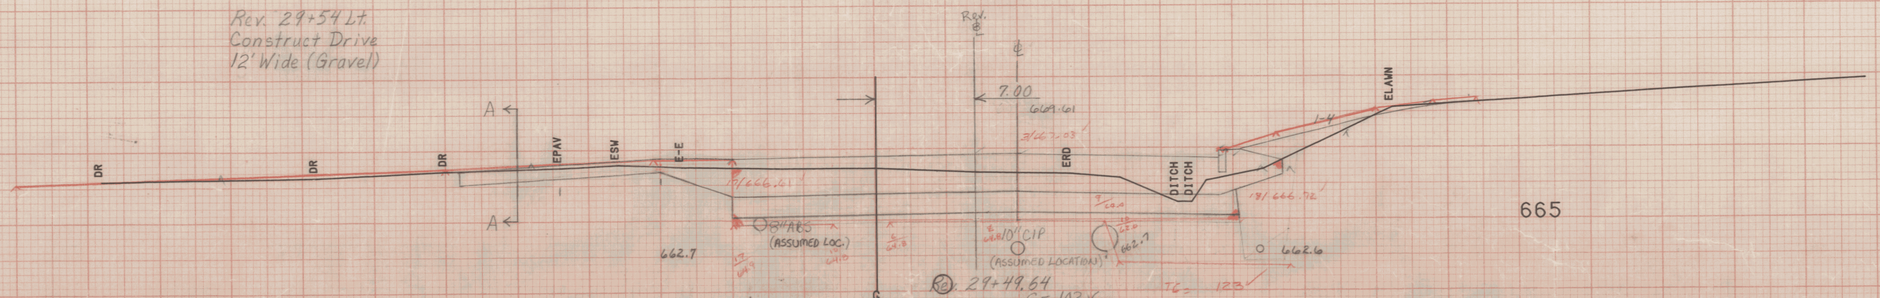

665

29+50

Rev. 29+49.64
C = 102 V
F = 417

FROM STA. 29+50 TO STA. 29+95
PROJECT NAME MONTPELIER
NO. M E 6 C M6400(7) PLOTTED 05/04/87
SURVEYED BY KASTNER-MOREAU 06/85
SHEET 184 OF 335 SHEETS

SCALE 5 FEET

Rev. 30+65 Lt

Begin New 6"x50' Underdrain w/ F.B. @ 31+15 Lt.

10"P 30+66
6"P 30+64
6"P 30+62
6"P 30+59
15" Ash (Remove) 30+57.5

Rev. 30+65
New 18" x 30' PCCSP.064 or CAAP.060

Rev. 30+47.52
30+50 ℄ C=99 (142)

Rev. 30+65 Rt
Begin New 24"x84' PCCSP.064 or CAAP.060
End New 24"x120' PCCSP.064 or CAAP.060

30+50 Rt ~ 30+80 Rt ±
Stone Fill, Type I for Slope Stabilization

30+36 Rt ~ 30+92 Rt
Remove Existing 3'x56' Conc. Gutter

Rev. 30+23 Rt
Begin Vertical Granite Curb

Rev. 30+10 Rt.
Construct Approach 30' Wide (Wilson St)

30+27 Lt
Adjust Elev. of DI
New Cast Iron Cover w/frame (Non-Govt. Part.)

Rev. 30+26.55
30+27

30+11
12" M (Save)

Rev. 29+99.58
C=169
F=0
30+00

Section A-A (WILSON STREET)

FROM STA.	30+00 TO STA. 30+50
PROJECT NAME	MONTPELIER
NO.	M6400(7) PLOTTED 05/04/87
SURVEYED BY	KASTNER-MOREAU 06/85
SHEET	185 OF 335 SHEETS

SCALE 5 FEET

+16.5
1" APPLE
(Save)

Rev. 31+15 Lt
End New 6" x 50' Underdrain
w/ F.B. @ 31+15 Lt.

6' 6'

2" BITUMINOUS CONCRETE PAVEMENT

12" SUB BASE

SECTION A-A

680

REV 31+12 RT.
BEGIN VERTICAL GRANITE Curb

48" STUMP
31+23 (Remove)
N.G.P.

16' VC

Rev. 31+17.39
7.00'
680.95
E-E
DR
DR
DR
+16.50%
GARAGE
A
A
680

Rev. 31+07.45
31+08
674.0 o 674.0

REV 31+08 Rt
CONSTRUCT DRIVE 12' WIDE (PAVED)

Rev.
7.00'
680.41
LAWN
LAWN
LAWN
LAWN
LAWN
FN
E S W
1.4%
TC. ECURB
E-E
EDR
17/677.91
3/677.83
13/677.52
6" PLASTIC
(Ass'md Log)
674.0
10" CIP
(ASSUMED LOCATION)
673.5
TC 179
S 5.6 52.6
S 4 66.4
TE 2.5 x 4.6 = 11.5
Rev. 30+99.46
C= 179
F=0
31+00

675

REV 31+02 RT.
END VERTICAL
GRANITE CURB

30+92 Rt ~ 31+17 Rt
Remove Existing 15" RCP
And 2-5'x1' Granite Headwalls


Rev
7.00'
678.69
ERD
DITCH
DITCH
E C H
E C H
HOUSE, TSILL
671.6 o 671.5
Rev. 30+74.49
30+75

675

Plot grnd 11/15/93
Plan grnd 12/03/93

FROM STA.	30+75	TO STA.	31+08
PROJECT NAME	MONTPELIER		
NO. M6GC	M6400(7)	PLOTTED	05/04/87
SURVEYED BY	KASTNER-MOREAU	06/85	
SHEET 15B	OF 335 SHEETS		


SCALE 5 FEET

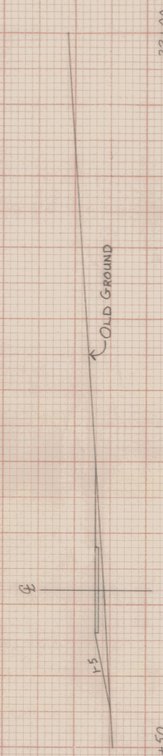

31+77
24" OAK
(Save)

Rev. 31+83 Lt
End Vertical Granite Curb

Rev. 31+61 Lt
Construct Field Stone Walk (6' Wide)
To Be Paid as Cement Rubble Masonry

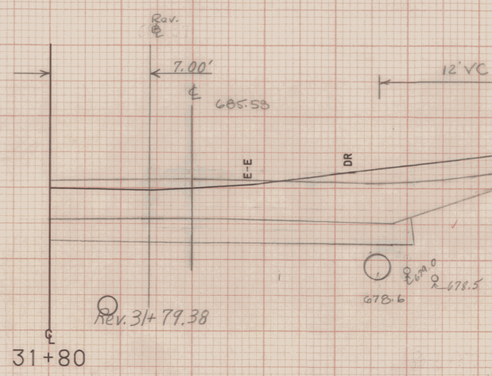

Rev. 31+84 Rt
Begin Vertical Granite Curb


Rev. 31+77 Rt
Construct Drive
14' Wide (Paved)


680

Rev. PT 31+71.22
Dc = 1°00' Rt - N.C.

Rev. 31+69 Rt
End Vertical Granite Curb

Rev. 31+64 Rt ~ 31+85 Rt
Remove Existing 15" RCP Drive Culv.
& 5'x1' Headwall

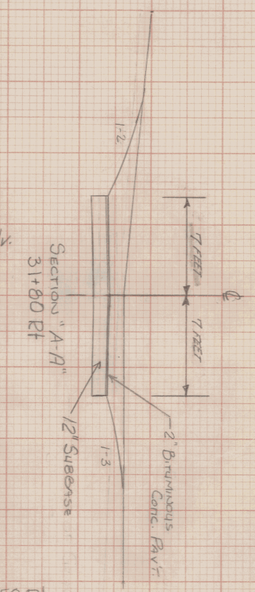

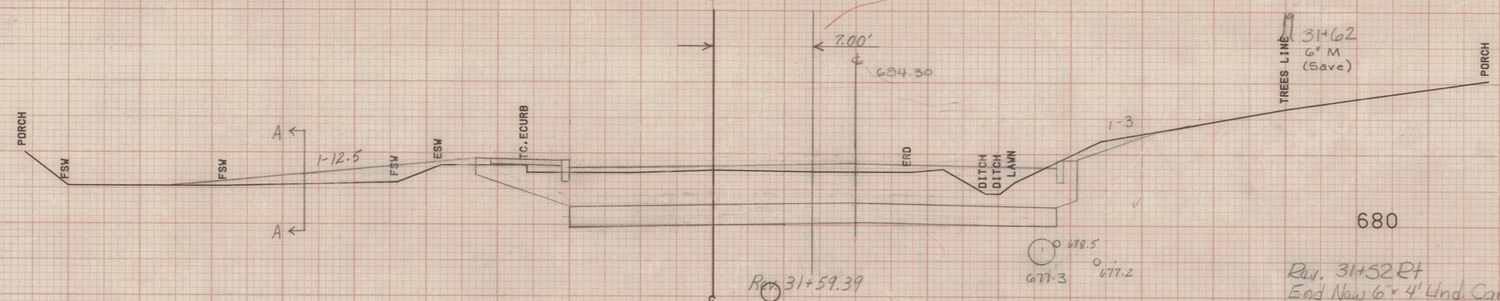

31+62
6" M
(Save)

680


685

Rev. 31+52 Rt
End New 6"x 4' Und. Carrier Pipe
Begin New 6"x 598' Und. w/ F.B. @ 37+50 Rt.

Rev 31+50 Rt ~ 31+52 Rt
New 6"x 4' Und. Carrier Pipe

Rev. 31+50 Rt
Begin New 24"x 132' PCCSP. 064
or CAAP. 060
End New 24"x 84' PCCSP. 064
or CAAP. 060

31+50
3" Spr.

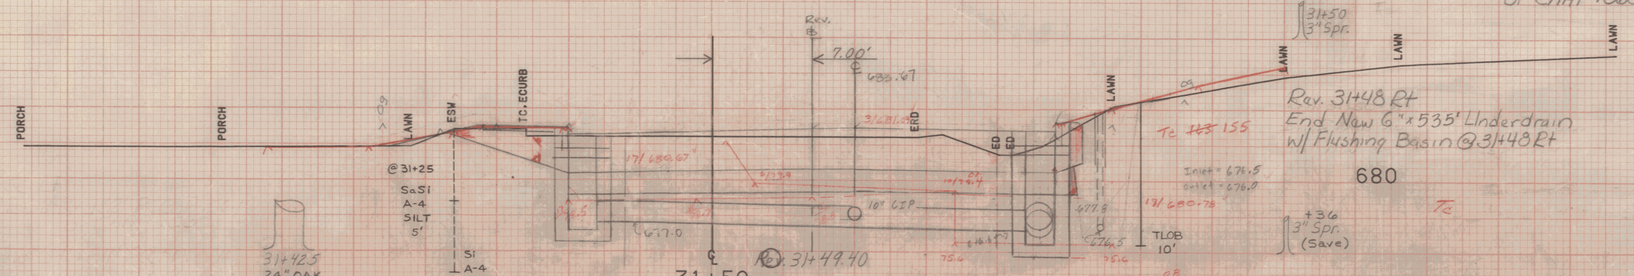

Rev. 31+48 Rt
End New 6"x 535' Underdrain
w/ Flushing Basin @ 31+48 Rt

680

+36
3" Spr.
(Save)

31+17 Rt ~ 31+64 Rt
Remove Existing 3'x 47'
Concrete Gutter


New 18"x 30' PCCSP. 064
or CAAP. 060


C = 88 (.40)
F = 1

SCALE 1" = 5 FEET

FROM STA. 31+50 TO STA. 31+80
PROJECT NAME MONTPELIER
NO. M66C-M6400(7) PLOTTED 05/04/87
SURVEYED BY KASTNER-MOREAU 06/85
SHEET 187 OF 335 SHEETS


Section 'B-B'
Sta. 32+75 Lt.

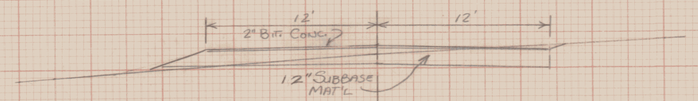

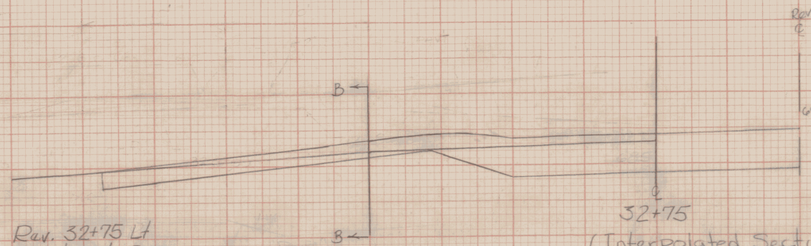



Rev. 32+75 Lt
Construct Drive
(24' Wide, Paved)
Rev 32+62 Lt
End Excavation of Surfaces and Pavement


32+75
(Interpolated Section)

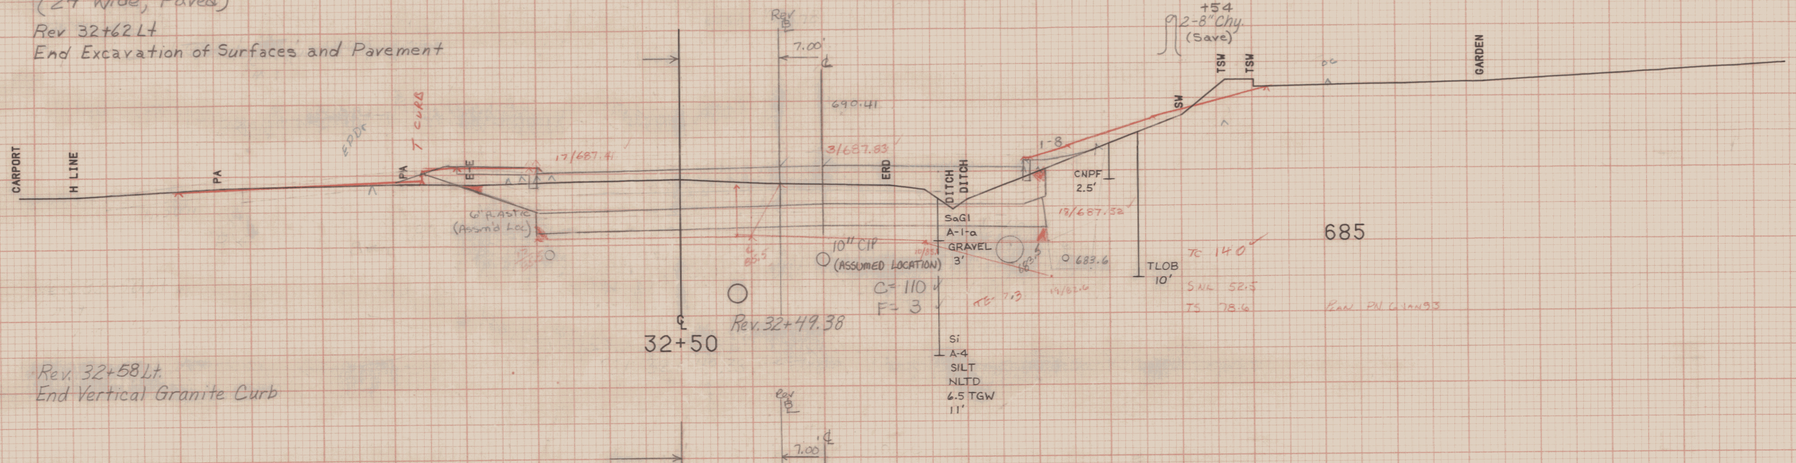

Rev. 32+58 Lt.
End Vertical Granite Curb

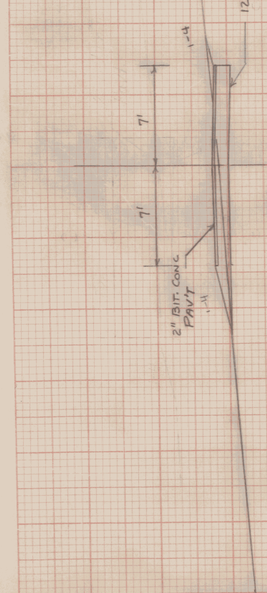


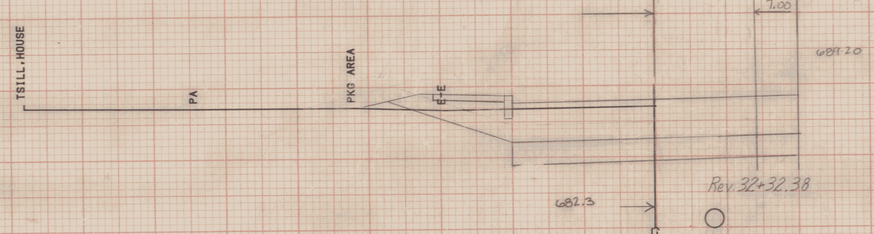

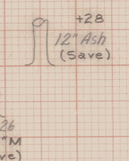

Rev. 31+85 Rt ~ 32+75 Rt
Remove Existing 3' x 90' Conc. Gutter

Rev. 32+07 Lt
Begin Vertical Granite Curb
Begin Excavation of Surfaces and Pavement

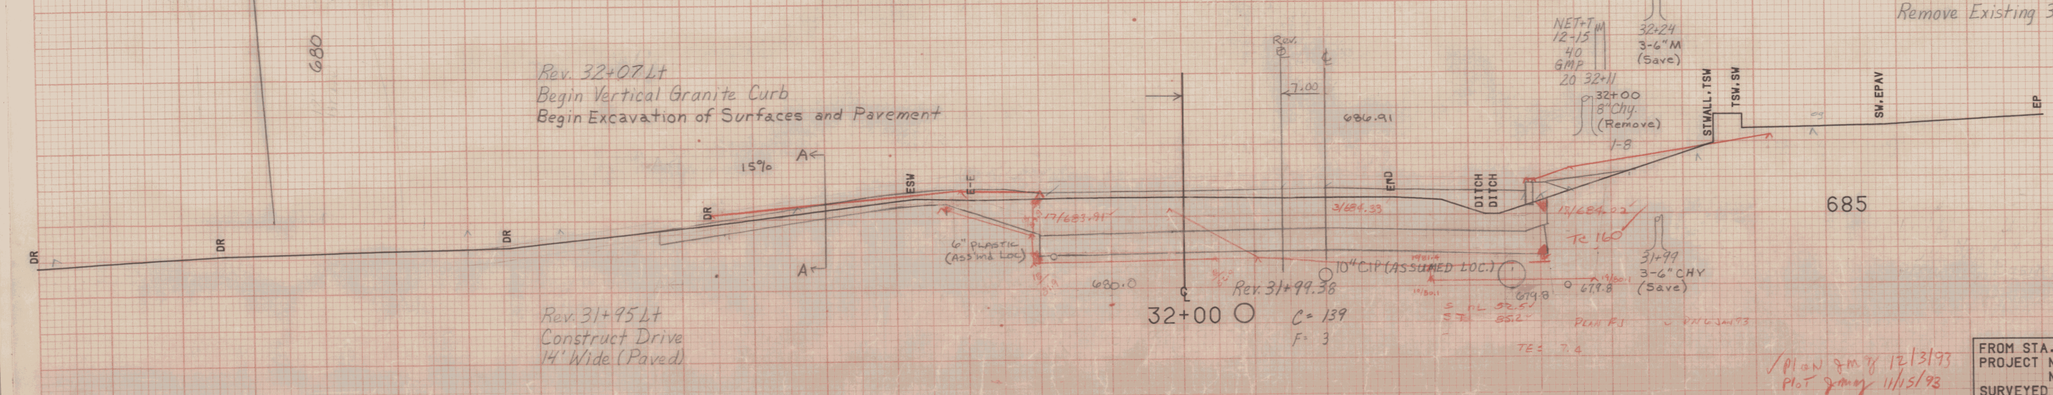


Rev. 31+95 Lt
Construct Drive
14' Wide (Paved)

Plan JMG 12/3/93
Plot JMG 11/15/93


SCALE 5 FEET

FROM STA. 32+00	TO STA. 32+50
PROJECT NAME	MONTPELIER
NO.	M6400(7)
SURVEYED BY	KASTNER-MOREAU 06/85
SHEET 128 OF 335 SHEETS	PLOTTED 05/04/87

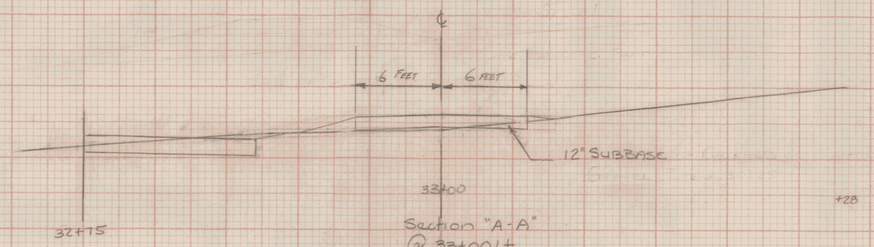


Rev. 33+11 Lt
Begin Vertical Granite Curb

Rev. 33+00 Lt
Construct Drive
12' Wide (Gravel)

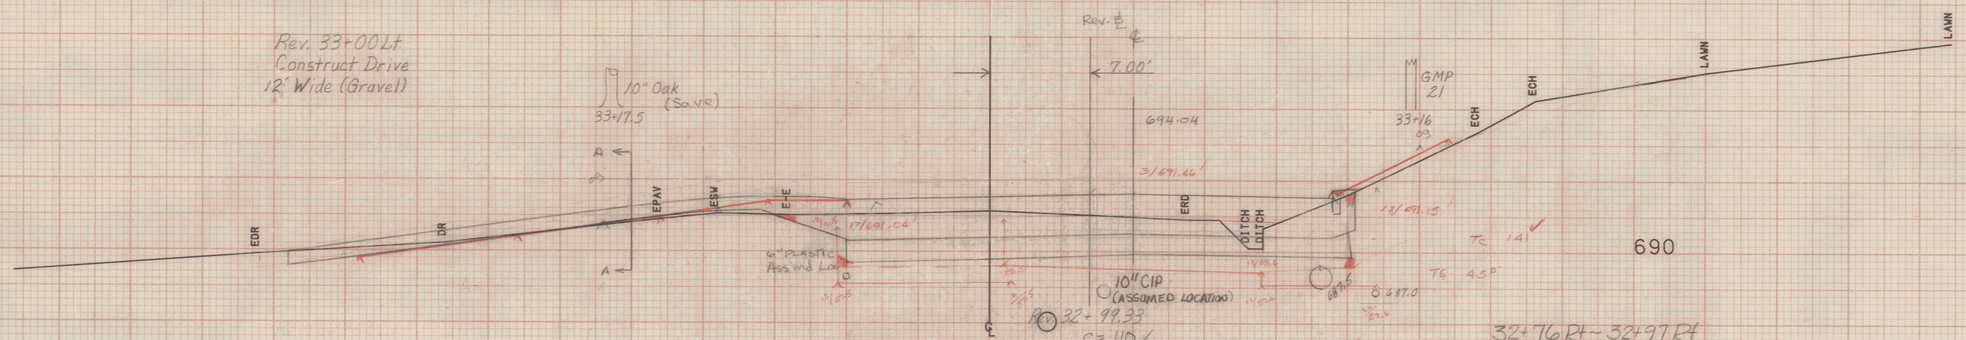

32+76 Rt ~ 32+97 Rt
Remove Existing 15" CGMP Drive Culv.
& 2 Stone Headwalls

Rev 32+82 Lt
Retain Existing RCDI ~ 6" Plastic Pipe
& 6" Conc. Adjust Elevation of DI
New Cast Iron Cover w/ Frame
Non-Gov't. Part.

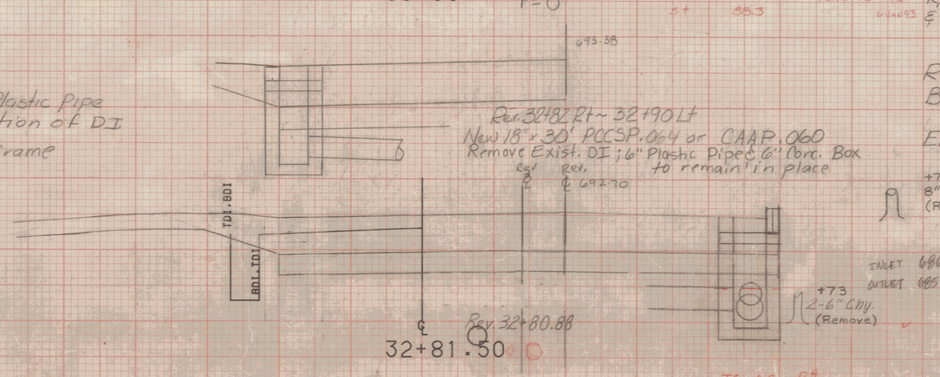

Rev. 32+82 Rt.
Begin New 18"x64' PCCSP.064
or CAAP.060
End New 24"x132' PCCSP.064
or CAAP.060

+76
8" CHY
(Remove)

32+74
8" M

Plot Survey 11/15/93
Plot Survey 12/03/93

FROM STA.	32+81.50 TO STA. 33+00
PROJECT NAME	MONTPELIER
NO. M66C	M6400(7) PLOTTED 05/04/87
SURVEYED BY	KASTNER-MOREAU 06/85
SHEET 169	OF 335 SHEETS

SCALE 5 FEET

Rev 33+23 Rt ~ 34+09 Rt,
Remove Existing 12" RCP & 2 CRM Headwalls (Drive Culv.)

33+50
Section B-B

33+30
Section A-A

33+00

Rev. 33+50 Lt
Construct Paved Walk (2' Wide)
To Be Paid as Bit. Conc. Sidewalk

Rev 33+46 Lt.
Begin New 6"x 54' Underdrain w/ F.8@34.00 Lt.
Rev. 33+29 Lt
Construct Paved Walk (3' wide)
To Be Paid as Bit. Conc. Sidewalk

Rev 33+46 Rt.
Begin New 18"x 152' PCCSP.064
or CAAP.060
End New 18"x 64' PCCSP.064
or CAAP.060

Rev 33+46
New 18"x 30' PCCSP.064
or CAAP.060

Rev. 33+49.38
Rev. 33+27.38

33+50
33+28


695
690


EPW
PW
EBW
TCL ECURB
ERD
LAWN
HOUSE
WALK
CEDAR HDGE
ECH LAWN
HOUSE-TSILL
8' App (Save)
33+41
@33+45
NLTD 9'
6" Plastic (ASSUMED LOC)
18" CIP (ASSUMED LOCATION)
C=110 F=4
@33+45
690.6
TLOB 8.5'
Yard Lamp
33+29
7.00'
697.67
697.5
692.6
697.43
692.5
690.7
690.3
696.07
688.3
688.1
TE 7.8
TE 24.5
TE 7.6
PB
PA
PC
PLAN FD
PW @ LAWN 93

Plot 9 in 11/15/83
Planning 12/03/83

SCALE 5 FEET

FROM STA.	33+28	TO STA.	33+50
PROJECT NAME	MONTPELIER		
NO.	MEGC-M6400(7)	PLOTTED	05/04/87
SURVEYED BY	KASTNER-MOREAU 06/85		
SHEET 190	OF 335 SHEETS		

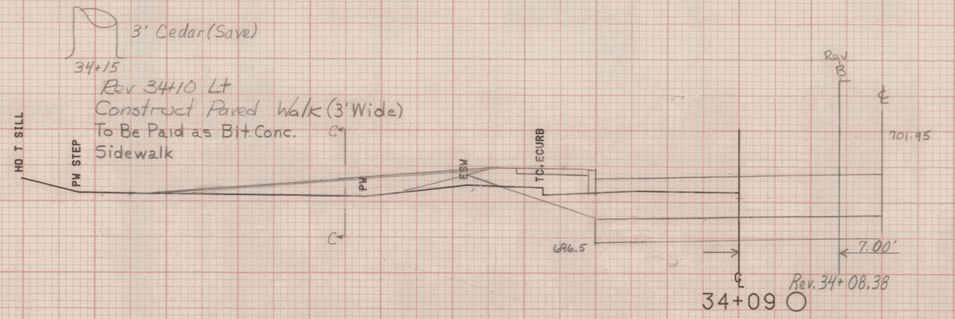


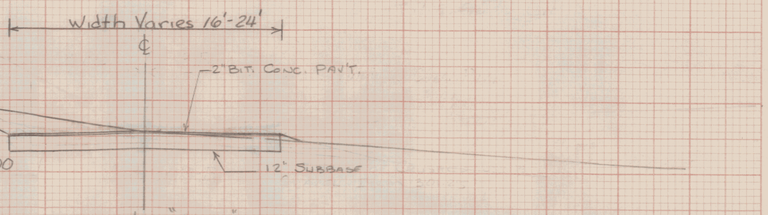


700


Note: The Contract is to install a 4' picket fence along the top of the front yard bank from 34+00 Rt ~ 34+82 Rt. Costs for this work and associated materials will be paid under Item 620.11 (M.O.D.)


34+11 Rt
Begin Vertical Granite Curb

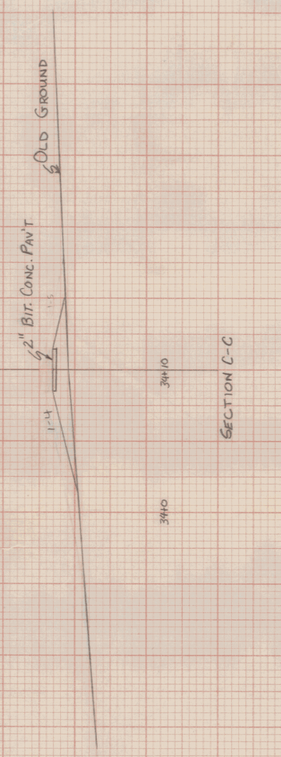

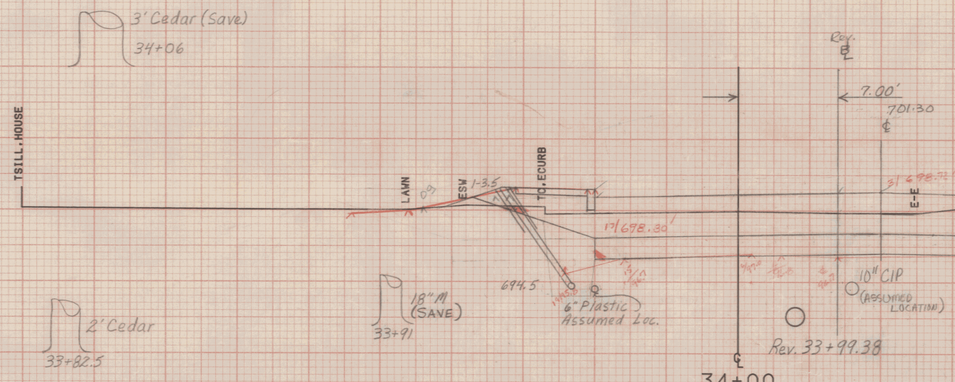


Rev. 34+00 Lt.
End New 6"x54' Underdrain
w/ F.B @ 34+00 Lt.

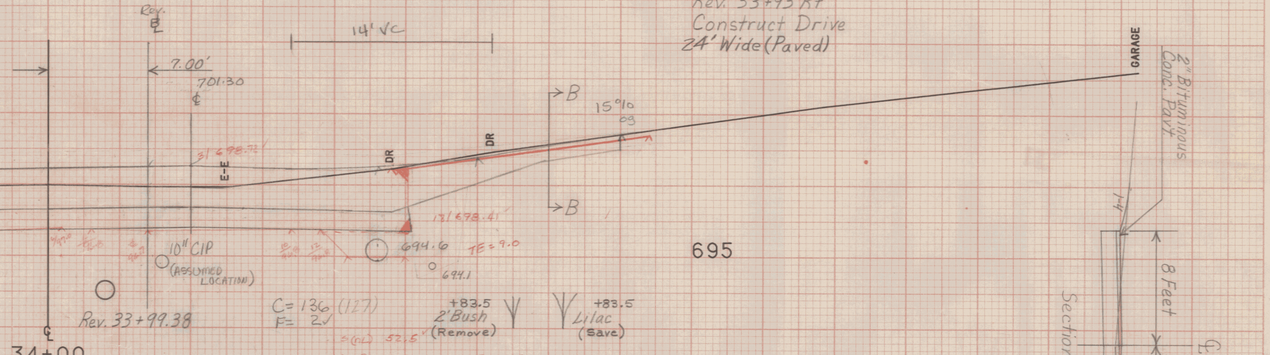

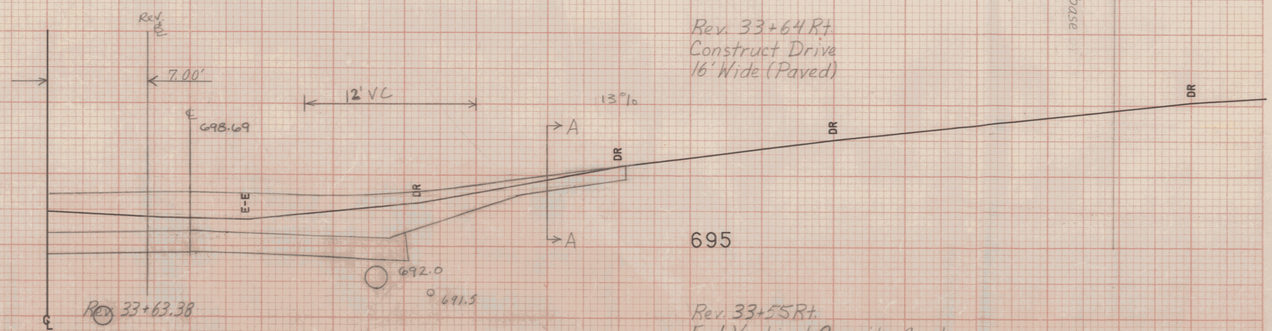

Rev. 33+64 Rt
Construct Drive
16' Wide (Paved)

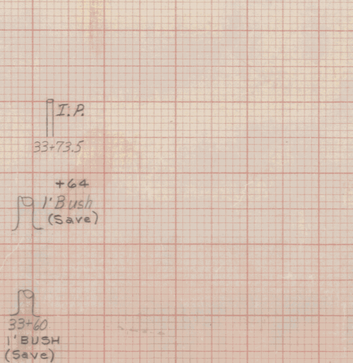


Rev. 33+55 Rt.
End Vertical Granite Curb

Plan dtd 12/03/93
Plat dtd 11/15/93

SCALE 1" = 5 FEET

FROM STA. 33+64 TO STA. 34+09
PROJECT NAME MONTPELIER
NO. M6400 (7) PLOTTED 05/04/87
SURVEYED BY KASTNER-MOREAU 06/85
SHEET 191 OF 335 SHEETS

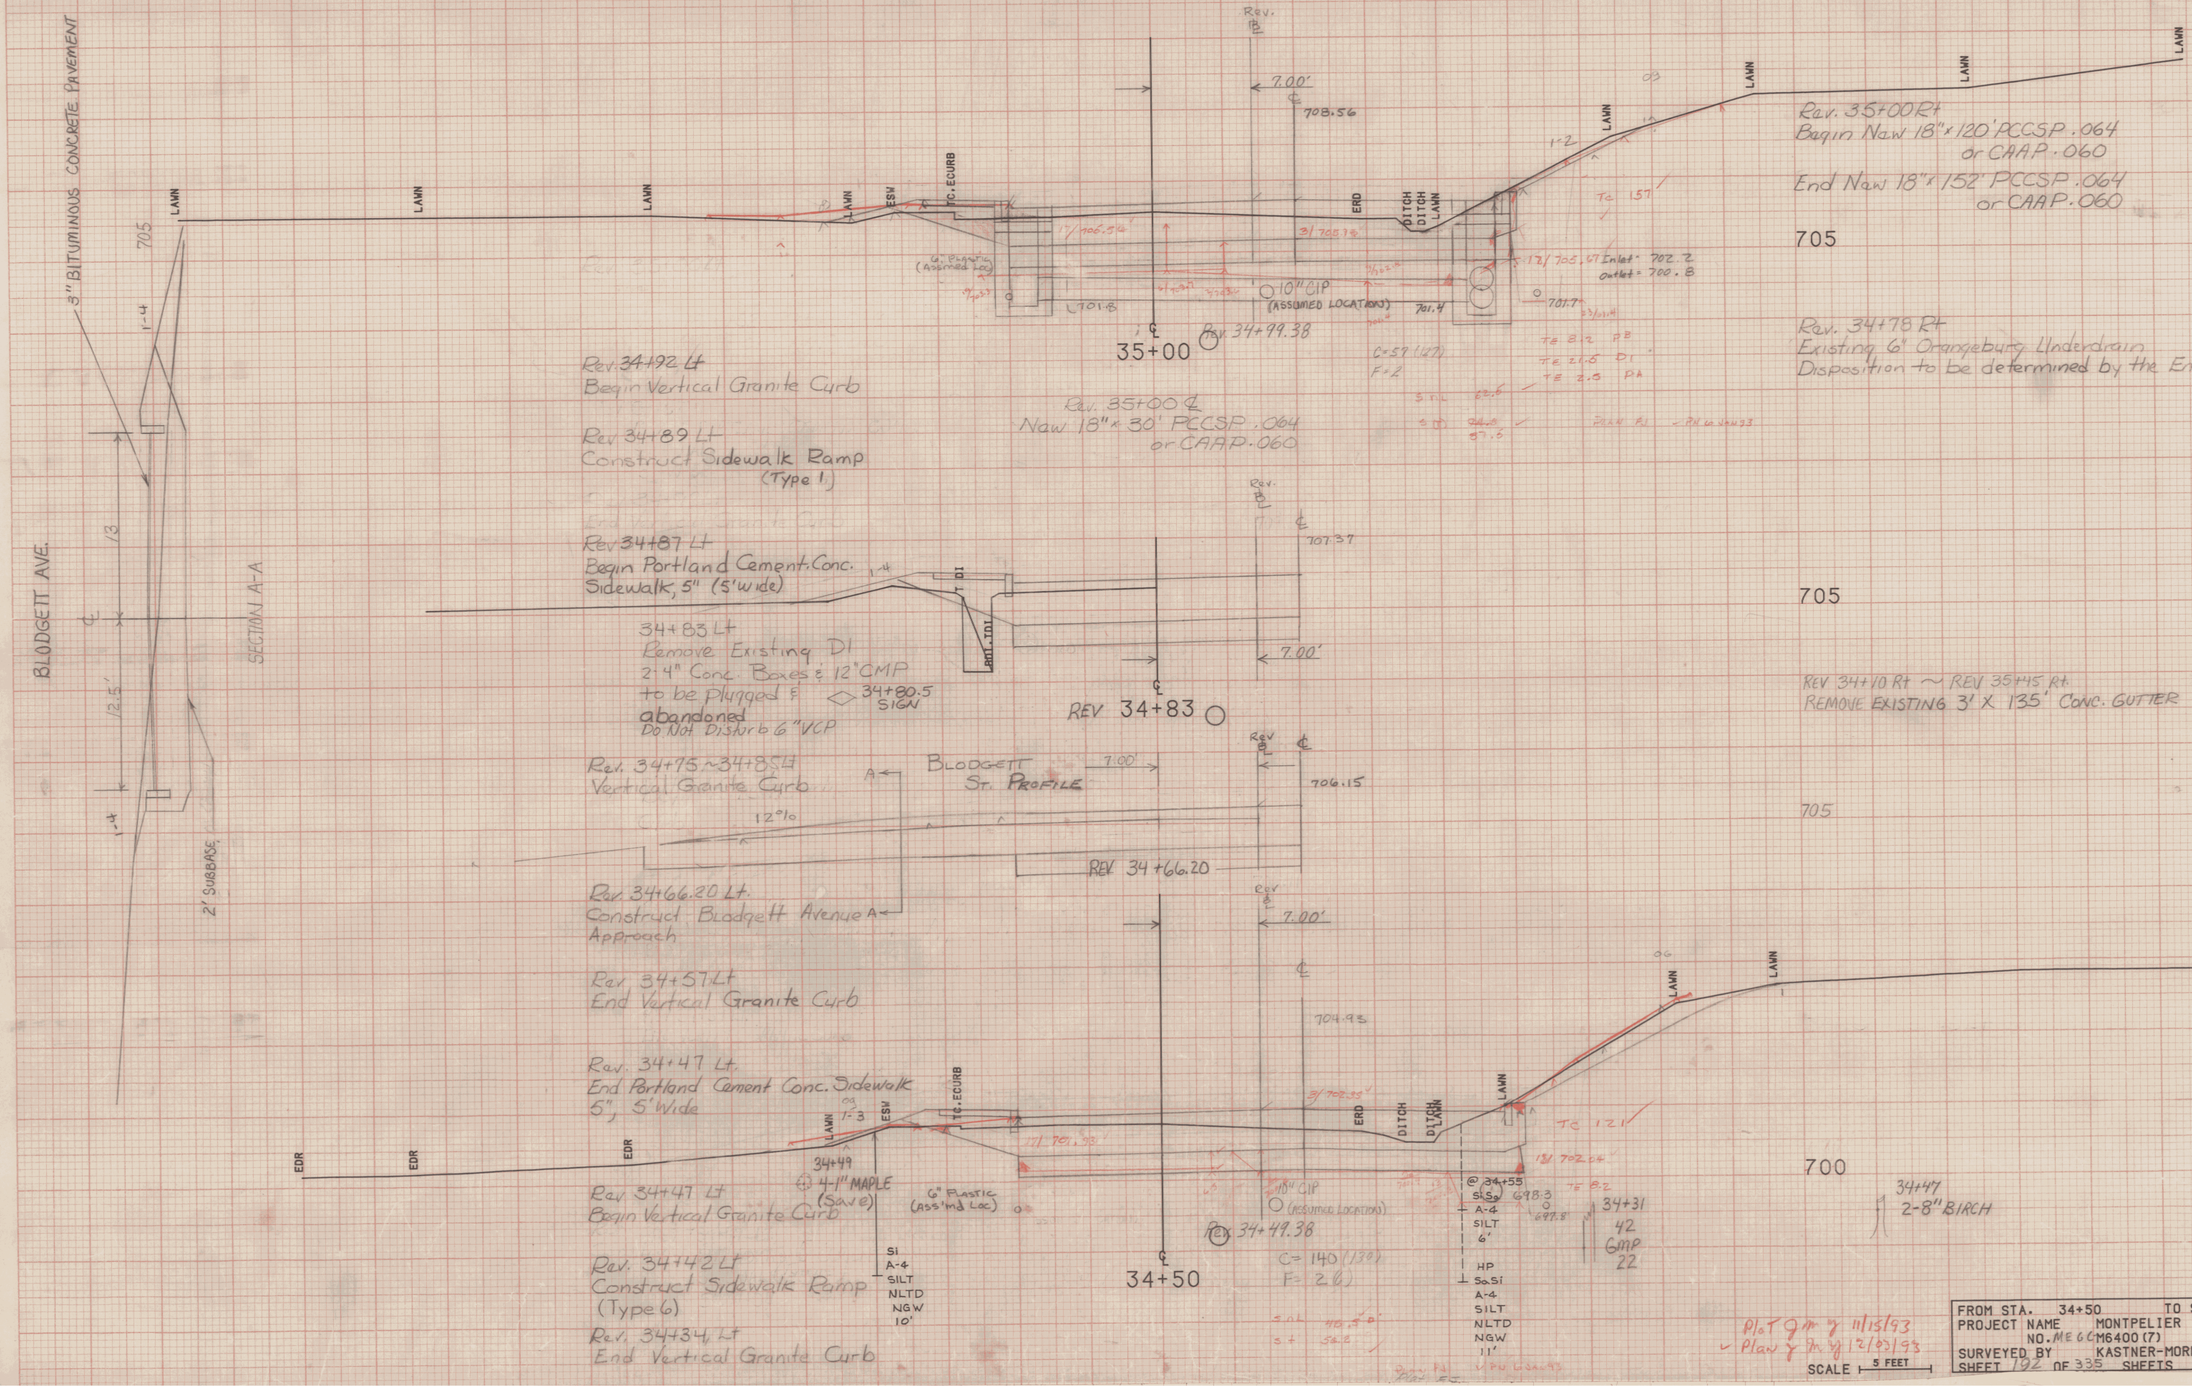

Plot Chg'd 11/15/93
Plan Chg'd 12/03/93


SCALE 5 FEET

FROM STA. 34+50	TO STA. 35+00		
PROJECT NAME	MONTPELIER		
NO. ME 66	M6400(7)	PLOTTED	05/04/87
SURVEYED BY	KASTNER-MOREAU 06/85		
SHEET 192 OF 335 SHEETS			


35+47 Rt ~ 35+72 Rt
Remove Existing 15" RCP Drive Culv.
& 2 - 5'x1' Headwalls

+69
30" M
(Save)

Rev. 35+60 Lt
Construct Drive (12' wide, Paved)

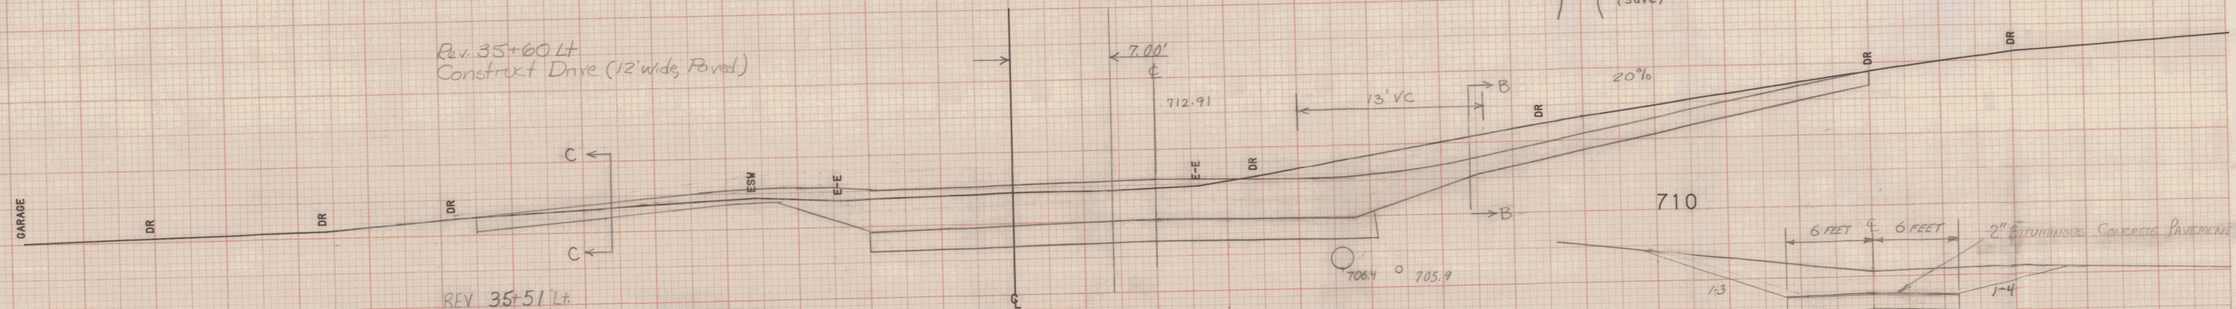

REV 35+51 Lt.
END VERTICAL GRANITE CURB

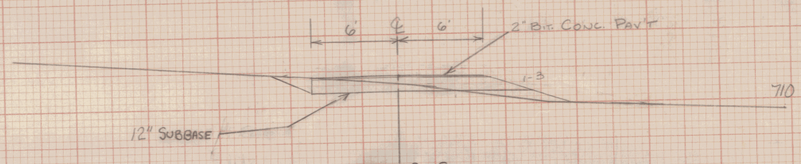


SECTION C-C
@ Rev 35+60 Lt


SECTION B-B


Rev. 35+60 Rt.
Construct Drive
(12' Wide, Paved)

REV 35+52 Rt.
END VERTICAL GRANITE CURB

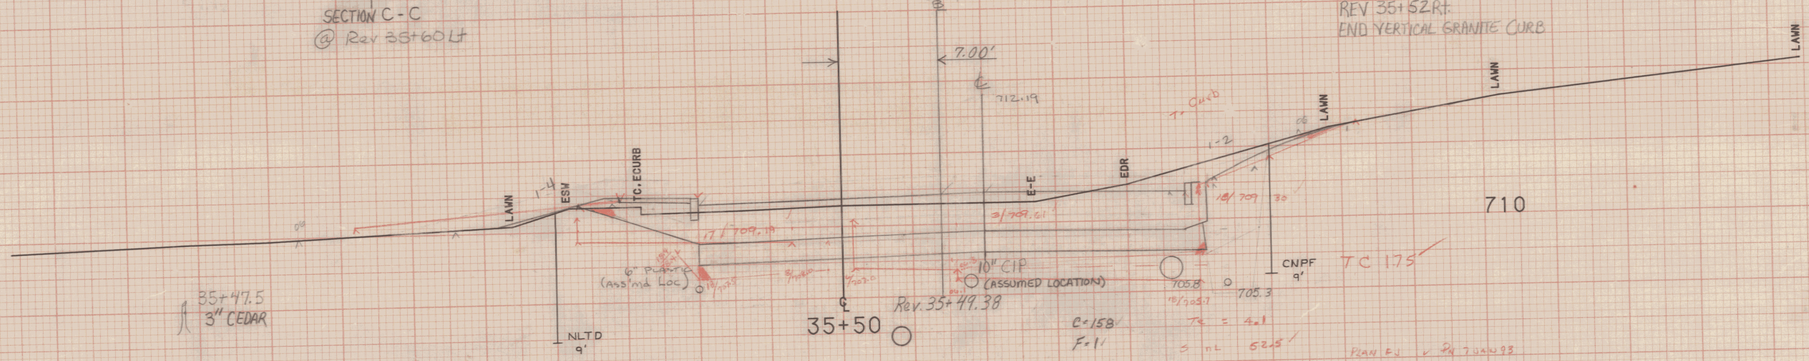

Rev. 35+34 Lt
Construct Paved Walk (3' wide)
To Be Paid as Bit. Conc. Sidewalk

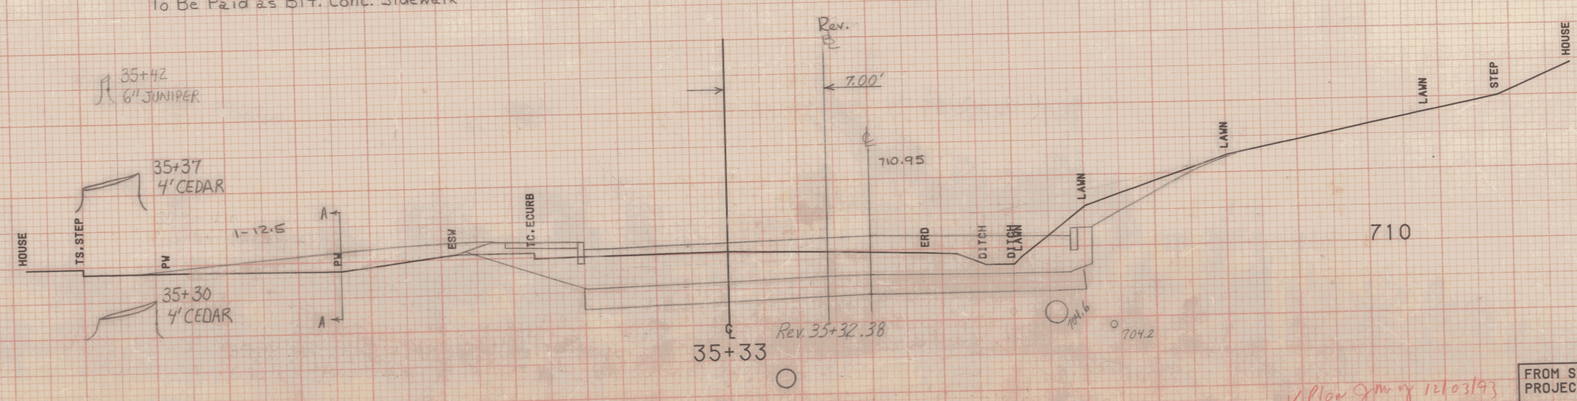

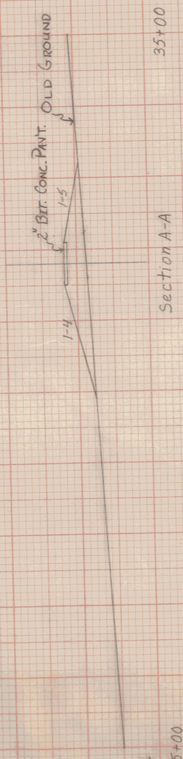

Plan Chg of 12/03/93
Plot EJ

FROM STA.	35+33 TO STA. 35+60
PROJECT NAME	MONTPELIER
NO.	M6400(7) PLOTTED 05/04/87
SURVEYED BY	KASTNER-MOREAU 06/85
SHEET	193 OF 335 SHEETS

SCALE 5 FEET

Rev. 36+53 Lt.
Begin Vertical Granite Curb.

+52
5" LILAC
(Save)

+62
2' BUSH
(Save)

Rev B

℄

7.00'

719.44

36+57.5
NETBT
44
GMP 03
24

BRUSH LINE

LAWN

HOUSE, TSILL

LAWN

LAWN

ESW

E-E

ERD

1-2

1-3

1-1

3/716.88

3/715.7

3/715.44

3/715.6

FF/716.44

18/716.55

@36+60

@36+60

713.0

6" Plastic
(Assumed Loc.)

10" CIP
(ASSUMED LOCATION)

712.8

712.4

NLTD
9'

NLTD
12'

℄
36+50

Rev. 36+49.38

715

C-98.
F-1

Plan Fs v PW 7 JAN 93

Rev B

75'R

7%

A

A

DR

DR

GARAGE

ESW

E-E

718.72

712.8

7.00'

℄
36+40

Rev. 36+39.38

Rev. 36+40 Lt
Construct Drive
(16' wide, Paved)

36+27 Lt
End Vertical Granite Curb

2" BITUMINOUS CONCRETE PAVEMENT

8'

8'

715

12" SUBBASE

Section "A-A"
@ 36+40 Lt SCALE: 1" = 5'

Rev. 36+20 Rt.
Begin New 18" x 128' PCCSP.064
or CAAP.060
End New 18" x 120' PCCSP.064
or CAAP.060

717.31

712.5

Rev 36+20
New 18" x 30' PCCSP.064
or CAAP.060

Inlet = 710.7
Outlet = 709.6

710.5

℄

Rev.

7.00'

715.82

12.5° RT

27.9° Rt

6.6° RT

Rev 36+20 Lt
Begin New 6" x 50' Underdrain w/F.B @ 36+70 Lt.

36+24
2' Cedar

36+20
2' CEDAR

36+17
2' CEDAR

36+12
3' CEDAR

35+63
3' CEDAR

35+99
2' CEDAR

35+99
2' CEDAR

TSILL, HOUSE

HOUSE

HOUSE

LAWN

ESW

1-3

TO. EDURB

ERD

DITCH

DITCH

1-17

717.72

717.82

3/713.24

710.5

6" Plastic
(Ass'md Loc.)

18" CIP
(ASSUMED LOCATION)

709.4

709.0

C= 137
F= 1

Rev. 35+99.38

℄
36+00

Rev. 35+71 Lt
Begin Vertical Granite Curb.

36+21.5
24" MAPLE
(Save)

LAWN

LAWN

LAWN

LAWN

LAWN

710

REV
36+00
18" ASH
(Save) 710

36+89
I.P.


REV 35+63 RT.
BEGIN VERTICAL GRANITE CURB


Plot FS


Plan 12/3/93

SCALE 5 FEET


FROM STA.	36+00	TO STA.	36+50
PROJECT NAME	MONTPELIER		
NO.	M6400 (7)	PLOTTED	05/04/87
SURVEYED BY	KASTNER-MOREAU	06/85	
SHEET 194	OF 335 SHEETS		

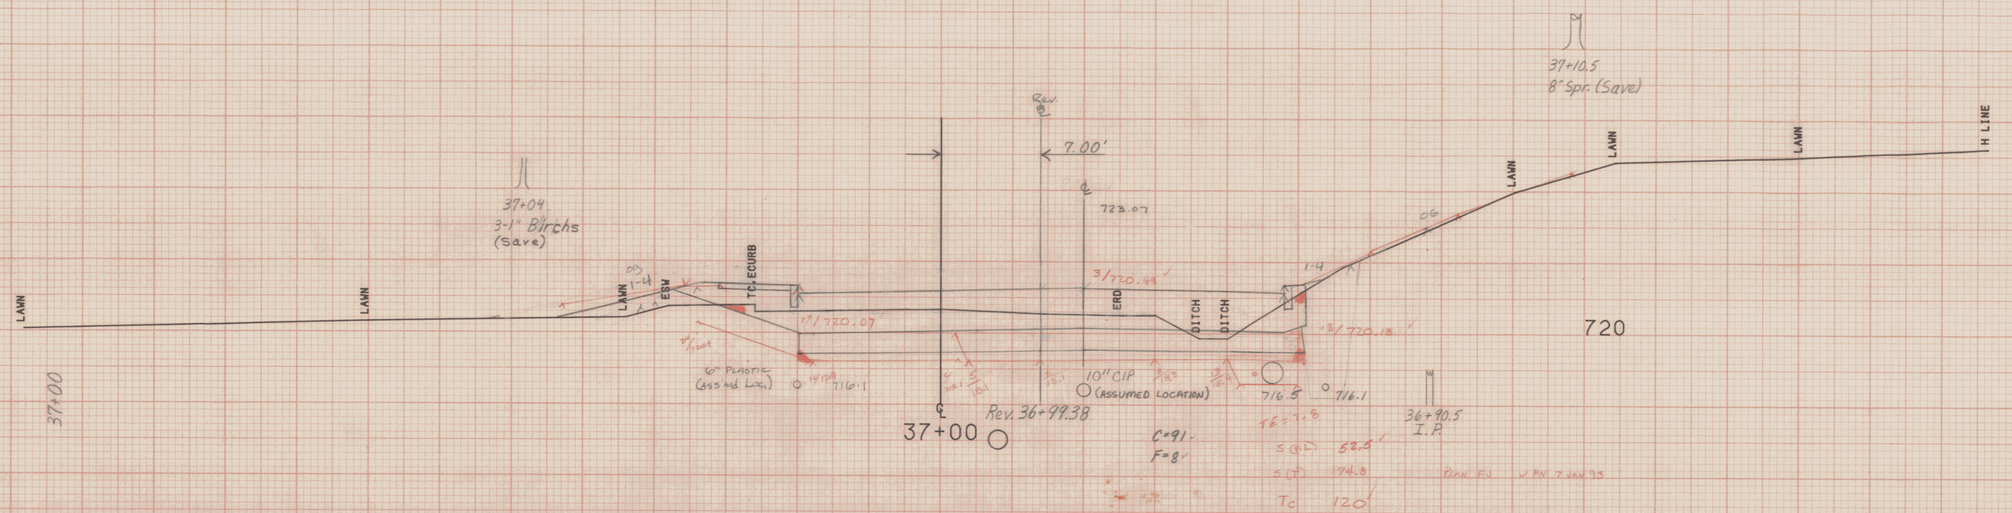

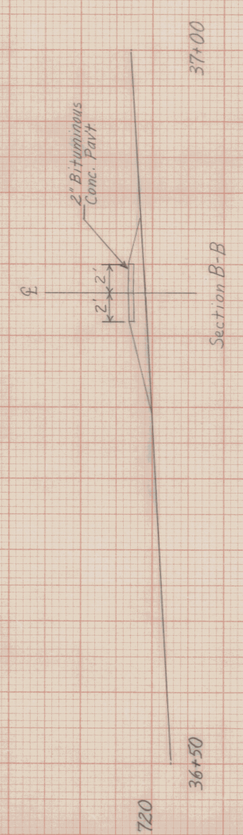


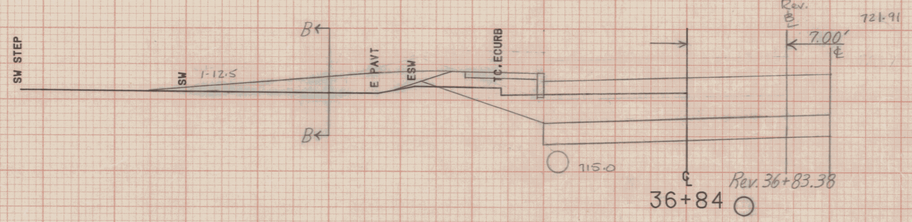

Rev. 36+83 Lt
Construct Paved Walk (4' Wide)
To Be Paid as Bit. Conc. Sidewalk

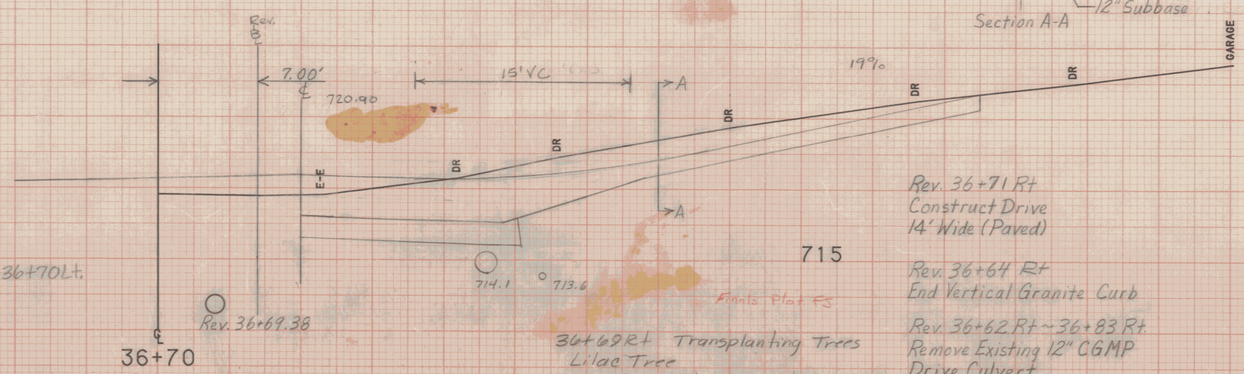


Rev. 36+70 Lt
End New 6" x 50' Underdrain w/ F.B. @ 36+70 Lt.

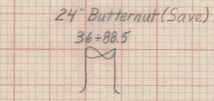


Rev. 36+79 Rt
Begin Vertical Granite Curb

720

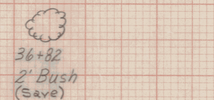

37+00

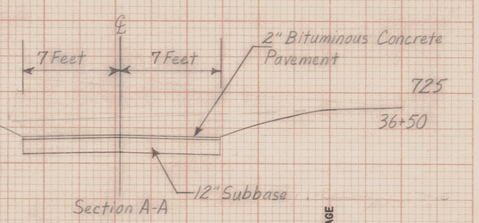

715

Rev. 36+71 Rt
Construct Drive
14' Wide (Paved)

Rev. 36+64 Rt
End Vertical Granite Curb


Rev. 36+62 Rt ~ 36+83 Rt
Remove Existing 12" CGMP
Drive Culvert


Finals Plot EJ

36+69 Rt Transplanting Trees
Lilac Tree
Lilac to be transplanted outside of the R.O.W. Limit in a location which is mutually agreeable with the property owner and resident engr.

Plan J Mng 12/03/93

FROM STA.	36+70	TO STA.	37+00
PROJECT NAME	MONTPELIER		
NO. M666	M6400(7)	PLOTTED	05/04/87
SURVEYED BY	KASTNER-MOREAU	06/85	

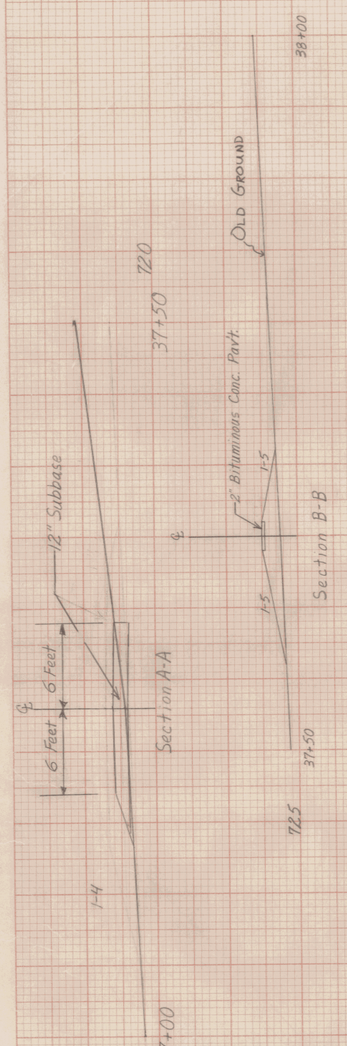

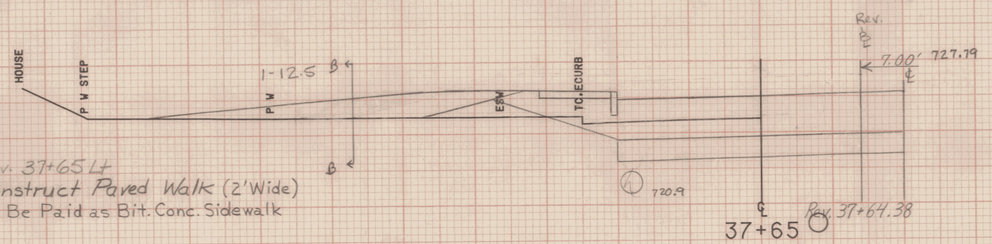


Rev. 37+65 Lt
Construct Paved Walk (2' Wide)
To Be Paid as Bit. Conc. Sidewalk

725

Rev. 37+60 Rt
End 6" Underdrain Carrier Pipe
Begin New 6" x 330' Underdrain
w/ Flushing Basin @ 40+90 Rt

Rev. 37+60 Rt ~ 37+89 Rt
Remove Existing 12" CGMP
Drive Culvert

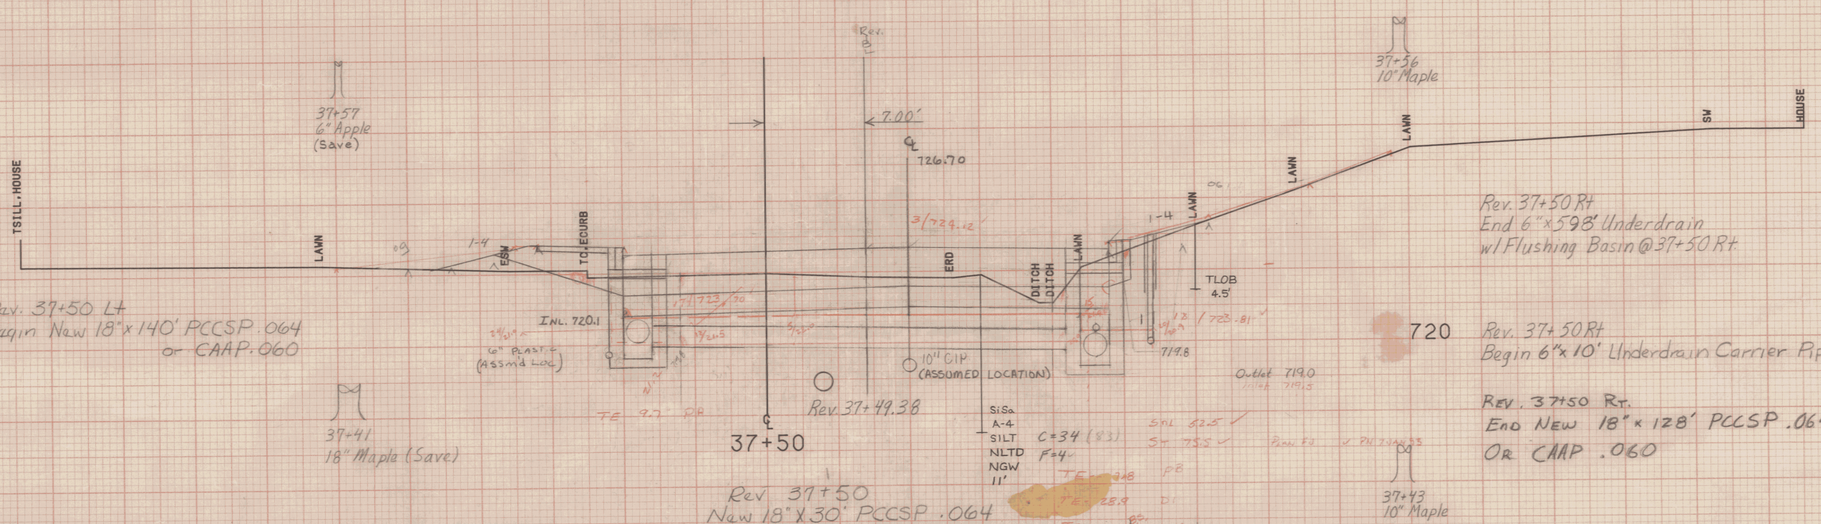

Rev. 37+50 Lt
Begin New 18" x 140' PCCSP .064
or CAAP .060

Rev. 37+50 Rt
End 6" x 598' Underdrain
w/ Flushing Basin @ 37+50 Rt


720

Rev. 37+50 Rt
Begin 6" x 10' Underdrain Carrier Pipe

Rev. 37+50 Rt.
End New 18" x 128' PCCSP .064
Or CAAP .060

Rev 37+50
New 18" x 30' PCCSP .064
or CAAP .060

Tc = 89

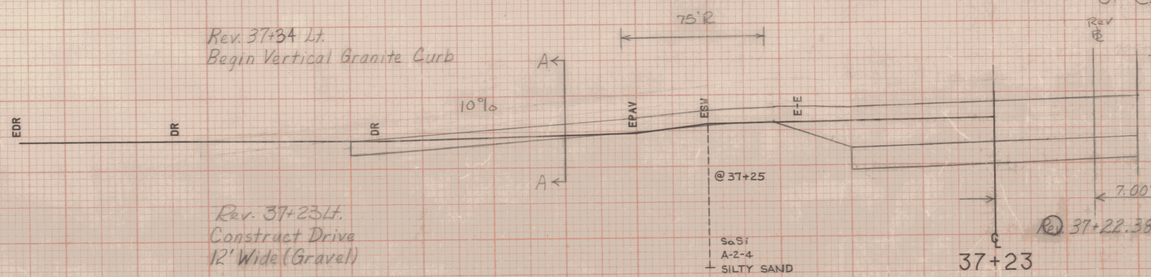

Rev. 37+34 Lt.
Begin Vertical Granite Curb

Rev. 37+23 Lt.
Construct Drive
12' Wide (Gravel)

Rev. 37+12 Lt.
End Vertical Granite Curb

720

Plot FJ
✓ Plan Chk'd 12/06/93

SCALE 5 FEET

FROM STA. 37+23	TO STA. 37+65
PROJECT NAME MONTPELIER	
NO. M6400(7)	PLOTTED 05/04/87
SURVEYED BY KASTNER-MOREAU 06/85	
SHEET 196 OF 335 SHEETS	

38+50 725

2" Bituminous Concrete Pav't.

8 Feet | 8 Feet

1-4

1-6

12" Subbase

38+00 Section B-B

37+50

TSILL. HOUSE

E P W

E P W

38+52
8" M
(Save)

1-4

ESW

TC LEDGE CURB

@ 38+45

6" ABS
(Ass'md Loc)

TLOB
7'

725.46

TE= 8.9

Rev.

7.00'

℄

733.24

3/730.66

12/730.24

E-E

EDR

℄
38+50

Rev. 38+49.45

10" CIP
(ASSUMED LOCATION)

1-2

12/730.36

@ 38+45

TC 134

726.2

NLTD
12'

38+47
20" Maple (Save)

TC

TC

TC

8K
8 ft. 11 steps
at 6%

730

HOUSE. TSILL

Rev. 38+37 Rt ~ 38+86 Rt.
Remove Existing 12" CGMP
Drive Culvent

Rev. 38+09 Lt.
Begin Vertical Granite Curb

8" App.

38+28.5

38+18
3' Lilac
(Save)

Rev. PC
38+03.04
Dc = 1° 00' Lt
N.C.

I. P

75' R

38+12

38+08
6" M
10° to
(Save)

B

B

GARAGE

DR

DR

ESW

E-E

6" PLASTIC
(Ass'md Loc)

722.19

TE= 9.1

Rev.

7.00'

℄

739.19

3/727.66

ERD

DITCH

DITCH

BRUSH

BRUSH

EBRSH

LAWN

LAWN

13/727.30

Tc 76

723.1

38+03
24" Maple (Save)

℄
38+00

Rev. 37+99.38

10" CIP
(ASSUMED LOCATION)

725

Rev. 37+82 Rt
Begin Vertical Granite Curb

Rev. 37+90 Lt
Construct Drive
16' Wide (Paved)

Rev. 37+83 Lt
End Vertical Granite Curb

37+85
2" Maple
(Save)

37+71
8" Apple
(Save)

C=81
F=0

℄

8 Feet | 8 Feet

2" Bituminous Concrete Pav't.

1-2

12" Subbase

38+00

37+50

730

Section A-A

Rev.

7.00'

℄

729.54

728.50

NET+T
12-15

37+89
11' VC

A

A

12%

DR

DR

E-E

GARAGE

721.8

℄
37+75

Rev. 37+74.38

725

Rev. 37+75 Rt
Construct Drive
16' Wide (Paved)

Rev. 37+66 Rt
End Vertical Granite Curb

Plot EJ
Plan dmg 12/06/87

FROM STA.	37+75	TO STA.	38+50
PROJECT NAME	MONTPELIER		
NO.	M E&C-M6400(7)	PLOTTED	05/04/87
SURVEYED BY	KASTNER-MOREAU	06/85	
SHEET 192	OF 335 SHEETS		

SCALE 5 FEET

2" Bituminous Concrete Pavt.
12" Subbase
Section A-A
Feet
11 Feet
1-4

HEDGE HEDGE HEDGE HEDGE

Rev. 38+92
Begin Vertical Granite Curb

Rev. 38+90 Lt
Begin 18"x 160' PCCSP.064 or CAAP.060
End 18"x 140' PCCSP.064 or CAAP.060
Begin New 6"x60' Underdrain W/F.B @ 39+50 Lt.

38+91.5 I.P.

75' R


Rev. 38+76 Lt
Construct Drive
22' Wide (Paved)


Rev. 38+60 Lt.
End Vertical Granite Curb

38+99.5
2-6" W.B (Save)
NLTD 9'

6" ABS (Assmd Loc)
T.C. CURB
ESW



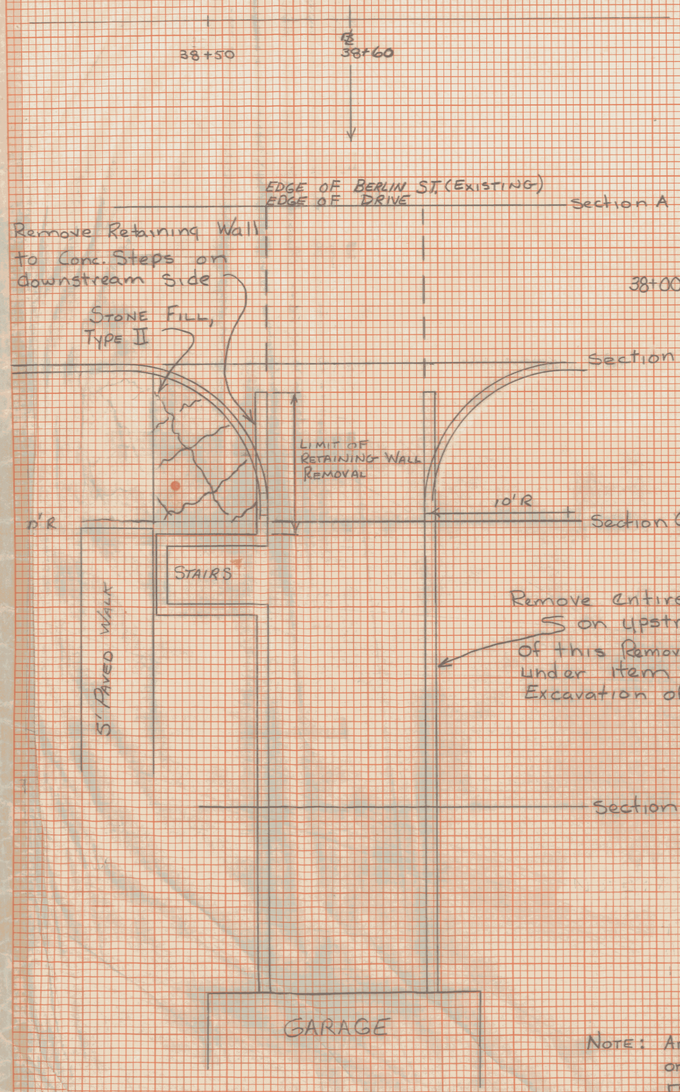


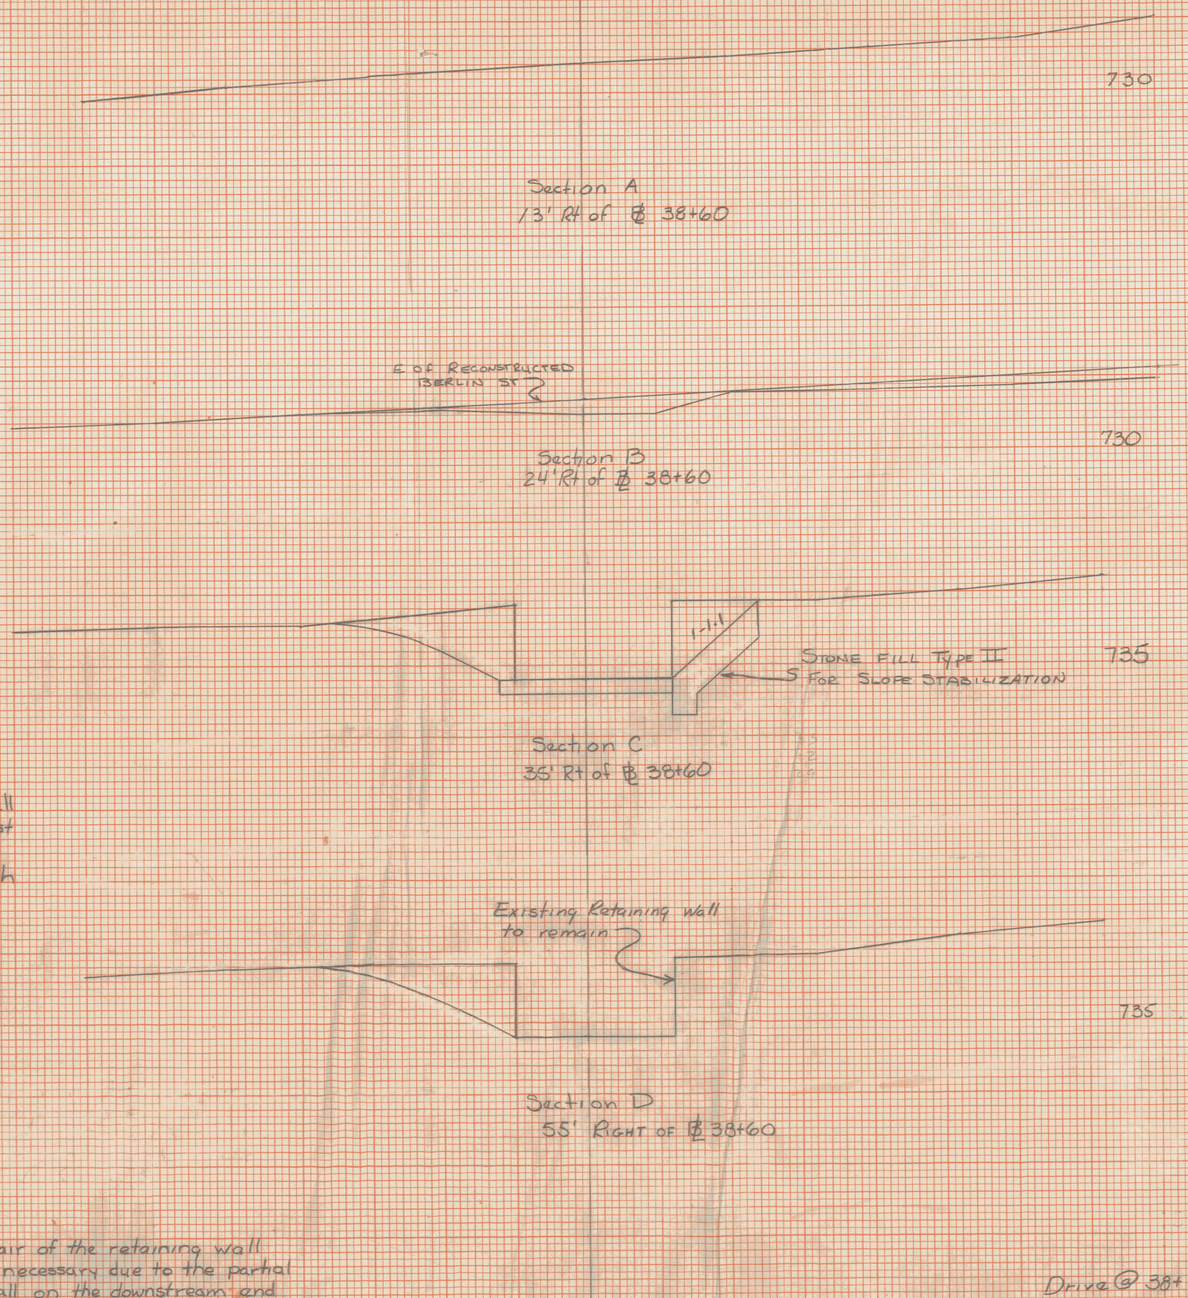


NOTE: Any costs for repair of the retaining wall or concrete steps necessary due to the partial removal of the wall on the downstream end will be paid under item 501.25, Conc. Class B

Drive @ 38+60 Rt MONTPELIER
Construction Details MEG-M 6400(7)
Scale: 1"=5'

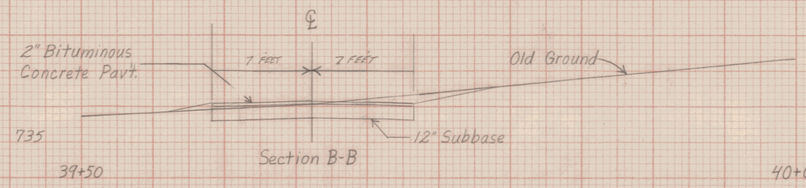


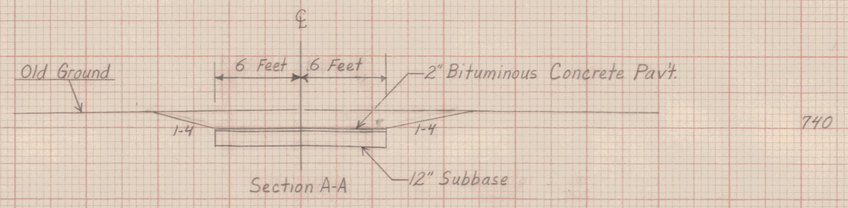

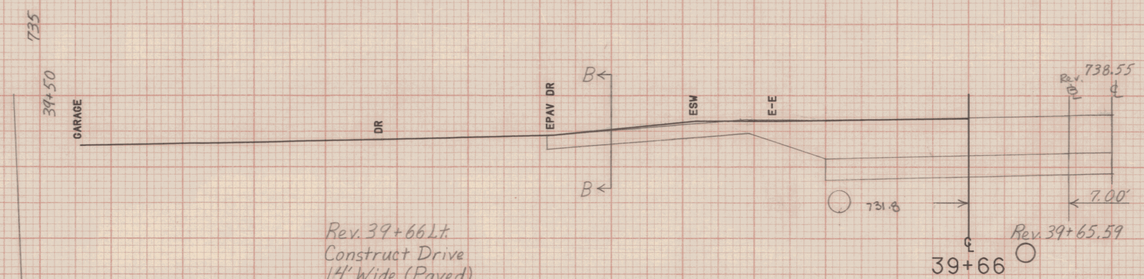


Rev. 39+66 Lt.
Construct Drive
14' Wide (Paved)


Rev. 39+53 Lt
End Vertical Granite Curb

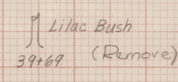

735

Rev. 39+56 Rt
Begin Vertical Granite Curb

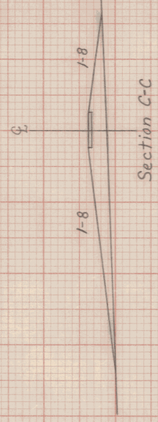

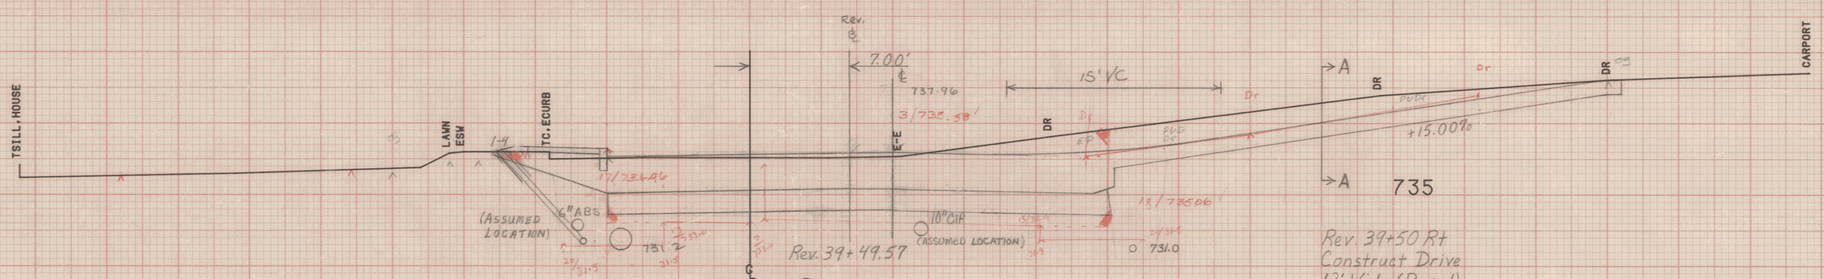


Rev. 39+50 Rt
Construct Drive
12' Wide (Paved)

Rev. 39+46 Rt.
End Vertical Granite Curb

Rev. 39+50 Lt.
End New 6"×60' Underdrain w/ F.B. @ 39+50 Lt.

Rev. 39+30 Lt
Begin Excavation of Surfaces & Pavements

Rev. 39+20 Lt.
Construct Flagstone Walk (2.5' Wide)
To Be Paid as Cement Rubble Masonry

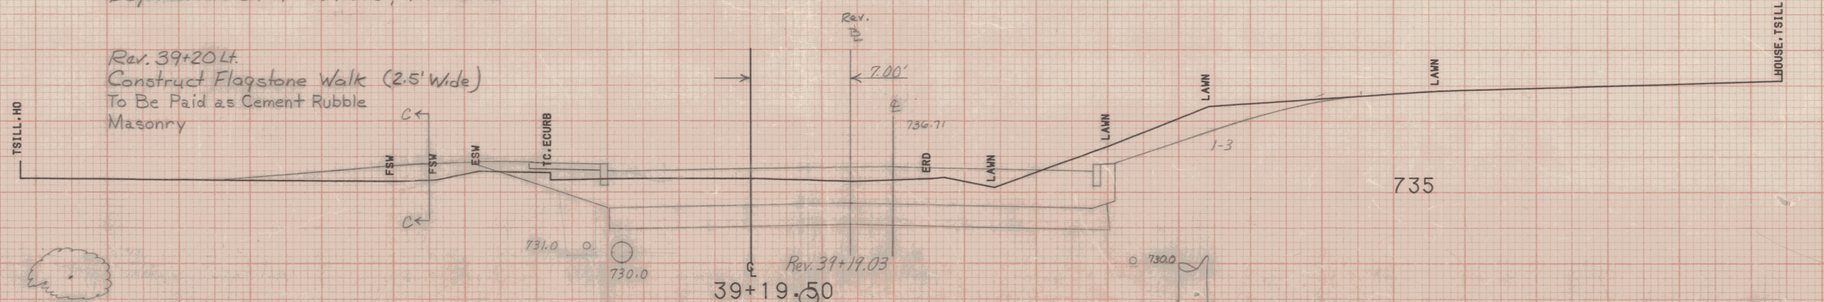

39+16
3' Bush

SCALE 5 FEET

FROM STA. 39+19.50	TO STA. 39+66
PROJECT NAME	MONTPELIER
NO. M6400(7)	PLOTTED 05/04/87
SURVEYED BY	KASTNER-MOREAU 06/85
SHEET 200	OF 335 SHEETS

Rev. 40+20 Lt
End Excavation of Surfaces & Pavements

Rev. 40+13 Lt
Construct Paved Walk (5' Wide)
To Be Paid as Bit. Conc. Sidewalk


40+30 Rt. Deciduous Tree
1½" Crab Apple
Tree to be planted outside of R.O.W. in a location of mutual agreement with the property owner and the resident engineer


40+29 Rt
8" Crabapple (Remove)

40+14 Rt
1" Chy. (Remove)

40+14 Rt. Transplant
1" Chy. (See note for tree @ 40+30 Rt)

40+00
8" Spr.

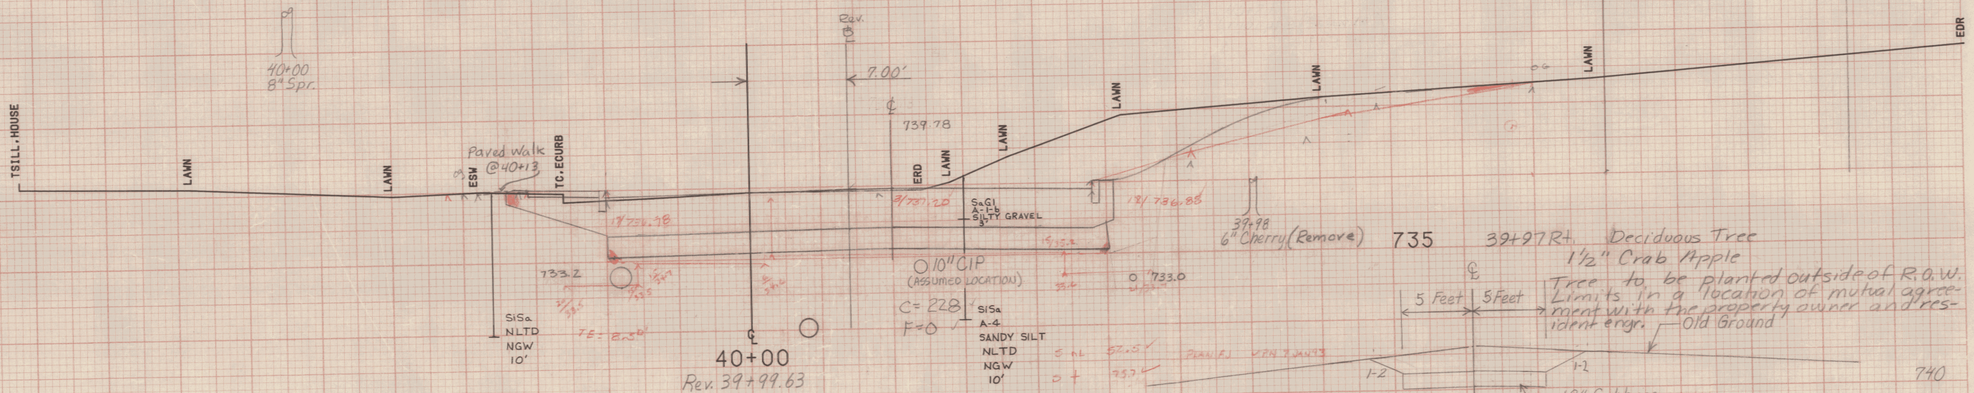

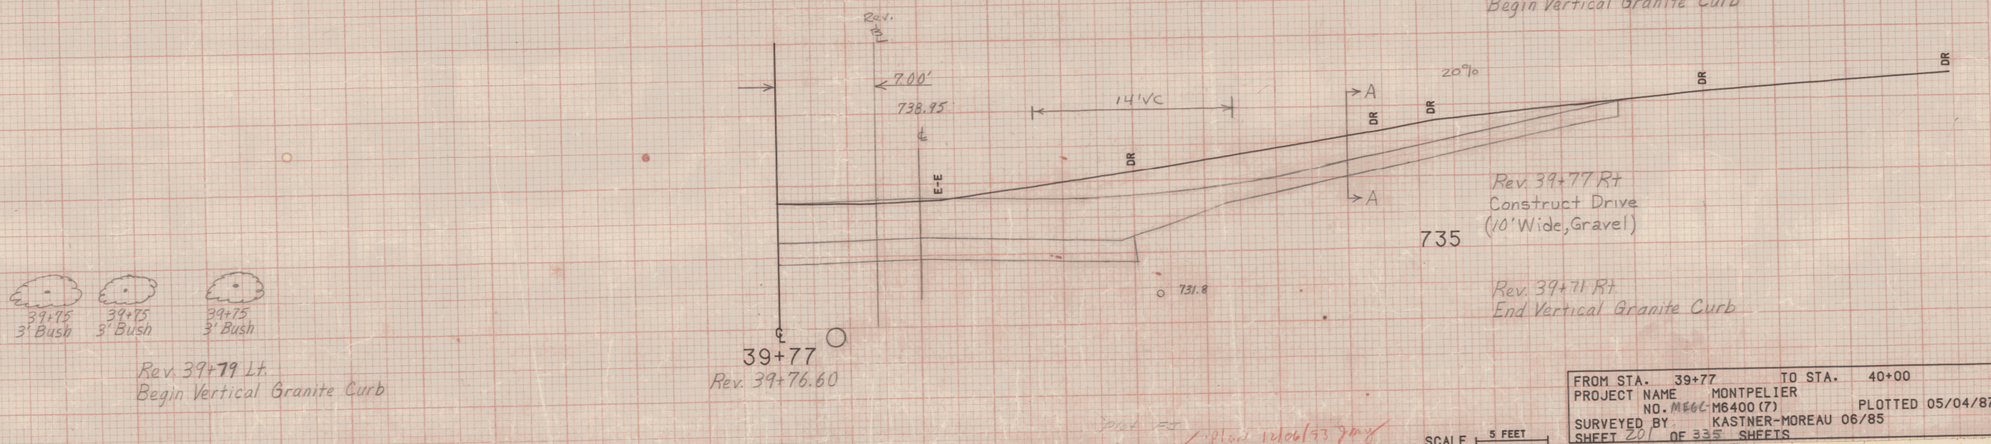

39+75 3' Bush
39+75 3' Bush
39+75 3' Bush

Rev. 39+79 Lt.
Begin Vertical Granite Curb

FROM STA.	39+77	TO STA.	40+00
PROJECT NAME	MONTPELIER		
NO. M66(7)	M6400(7)	PLOTTED	05/04/87
SURVEYED BY	KASTNER-MOREAU 06/85		
SHEET 20	OF 335 SHEETS		

SCALE 5 FEET

Note: Cross Section Information for 40+94.5 Lt has been extrapolated from Wheelock St. Cross Sections

Note: The tree @ 40+93 Lt. and the Bush @ 40+95 Lt. are to be transplanted outside of the R.O.W. limits in a location of mutual agreement with the property owner and the resident engineer.

40+95 Lt. Transplant Shrub (3' Bush) See Note

40+93 Lt. Transplant Tree (4" Appl.) See Note

Rev. 40+98 Lt
End Portland Cement Concrete Sidewalk, 5" 5' Wide

Rev. 40+95 Lt. ~ Wheelock St. 25+59 Lt.
Exist. 12" CSP and DI - Retain Change Elev. of D.I.

Rev. 40+95 Lt ~ 41+84 Lt
New 24" x 94' RCCSP .064 or CAAP .060

Rev. 40+95 Lt
New 24" x 4' CSP .064

Rev. 40+97 Lt
Construct Sidewalk Ramp (Type I)

+95 3' BUSH (Remove)

Assumed required elevation to connect to existing 12" CSP from Wheelock St. 25+59 Lt.

4" App. 40+92.5 (Remove)

LOCATION OF Existing 24" CSP Is Assumed

Rev. 40+90 Lt
End Vertical Granite Curb

3" Tam 40+77

3" Tam 40+53.5

2-4" Pine 40+47

Rev. 40+50 Lt
End New 18" x 160' RCCSP .064 or CAAP .060

Rev. 40+48 Lt
Begin Vertical Granite Curb

Rev. 40+39 Lt
Construct Drive 16' Wide (Paved)

Rev. 40+26 Lt
End Vertical Granite Curb

40+95 Lt ~ 41+45 Rt
New 36" x 106' RCCSP (PI) .079 OR CAAP .075 w/ Stone Fill, Type I @ Inlet
(See details on Sheet 203)

8 Feet 8 Feet 1:4
12" Subbase
Section B-B

743.24 TOI. BDI THOW. TO BDI. BDR

40+94.50
Rev. 40+94.24
40+95 Lt Remove Existing 24" CMP, RCDI and Stone Headwall

Rev. 40+90 Rt
End New 6" x 330' Underdrain w/ Flushing Basin @ 40+90 Rt

Rev. 40+62 Rt
Begin Vertical Granite Curb

740

Rev. 40+55 Rt
Construct Drive 16' Wide (Gravel)

Rev. 40+46 Rt
End Vertical Granite Curb

740

740
40+83.5
10" Maple
(Save)

Rev. 40+67 Rt
New 18" x 34' RCCSP .064 or CAAP .060


LAWN ESW EDR CO. EDURB EEE EP.AV 10' VC 7.00' 741.60 +10.00% 10" CIP (ASSUMED LOCATION) C = 137 F = 1' INV 734.1 734.7 40+50 Rev. 40+49.67

CARPORT DR ESW E-E A A 7.00' 741.20 738.18 40+39 Rev. 40+38.62

2" Bituminous Concrete Pavt. 12" Subbase 8 Feet 8 Feet
Section A-A

FROM STA. 40+39	TO STA. 40+94.50
PROJECT NAME MONTPELIER	
NO. M686-M6400(7)	PLOTTED 05/04/87
SURVEYED BY KASTNER-MOREAU 06/85	
SHEET 202 OF 335 SHEETS	


SCALE 5 FEET

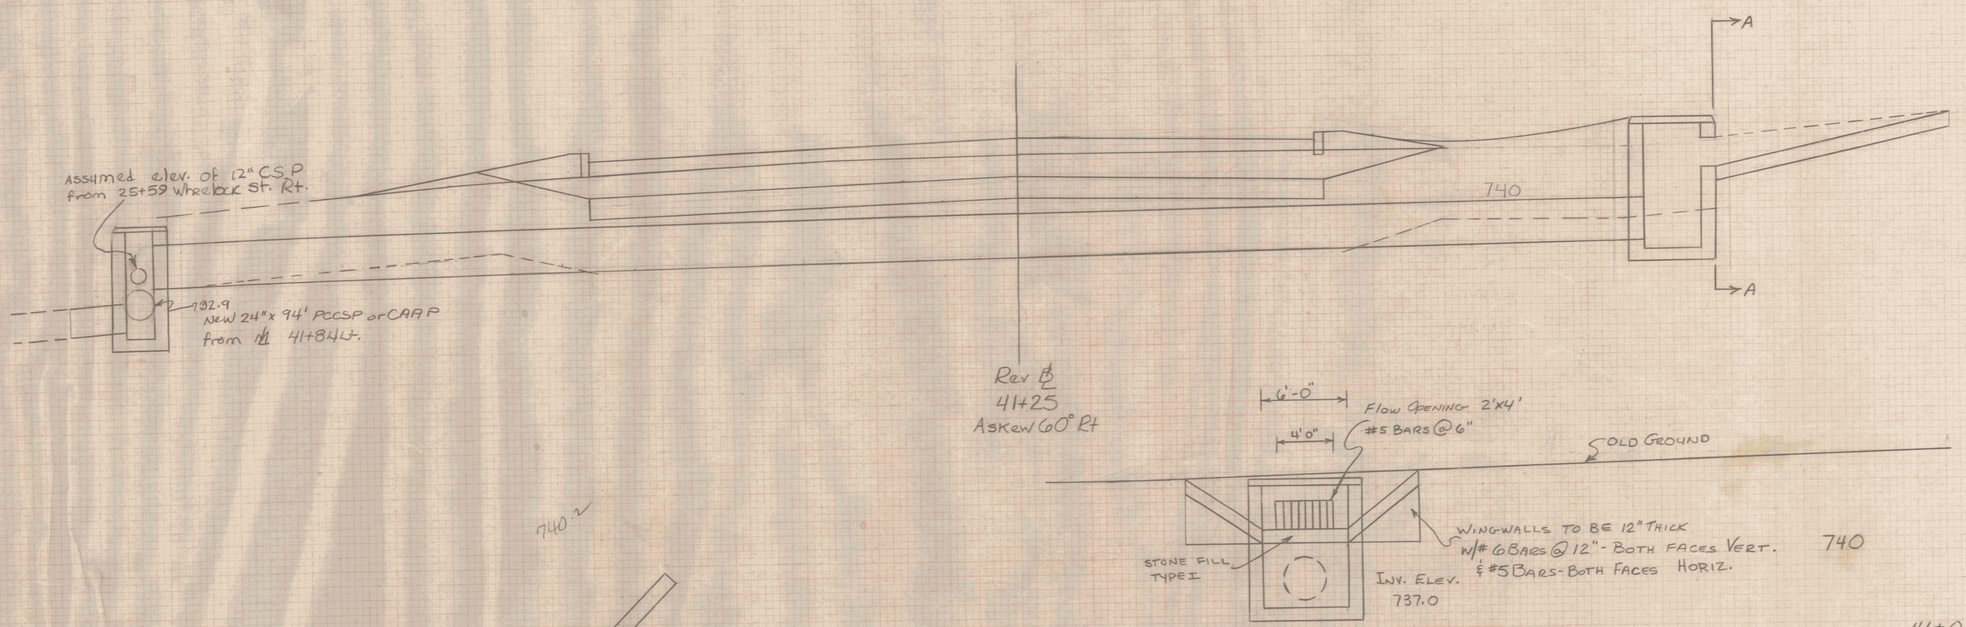

Catch Basin with Wingwalls

Section "A-A"

Scale: 1" = 5'

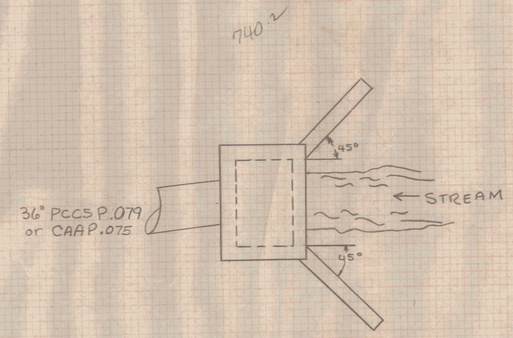

Plan View

40+95 Lt ~ 41+45 Rt
New 36"x 104' PCCSP.064
or CAAP.060 Details

Montpelier

MEGC - M6400(7)

Rev. 41+57 Lt
Construct Wheelock St.
Approach

-7.4%
-12%

Wheelock St. Profile

Rev. 41+57.15
Rev. 41+56.96

7.00
746.10

Rev. 41+67 Rt
End Vertical Granite Curb

740

6" App.
41+61

Iron Pipe
41+48.5

Berlin St.

ERD

3" Bituminous Concrete Pavement

℄ Section A-A
Wheelock St.

24" Subbase

16

740

EDR

ELEC. EMST

ST

E.I.E

PTH LINE

Rev. 41+39 Lt
Begin Vertical Granite Curb

8" VCP
(ASSUMED LOCATION)

41+51
GMP
29
NET
49

7.00'
745.73

EDRIB. TC

10" CIP
(ASSUMED LOCATION)
C= 163 (109)
F= 14 (1)

Rev. PI 744.93
Used Es

T. Head wall
E. Head wall

740

41+50
Rev. 41+49.81

42+00

+75

+50

+25

41+0

Original ℄ Rev. ℄

Rev. PT
41+43.25
Dc = 1°00' Lt
N.C.

Rev. 41+03 - 41+15
Vertical Granite Curb

Rev. ℄

7.00'
745.49

EDRIB. TC

40+95 Rt - 43+88 Rt
Remove Existing 2'x2' DI
& 15"x 290' CMP

EDITCH

DITCH

Stone Fill

740

41+45
Rev. 41+44.81

12" M (SAVE)
41+30

12" M (SAVE)
41+05

Rev. ℄

7.00'
743.47

END. TC

LAWN

1-4

ESW

TC. ECURB

1-48

E LAWN

DITCH

DITCH

10" CIP
(ASSUMED LOCATION)
736.5

C= 79 (87)
F= 36 (40)

NLTD
8'

NLTD
7'

C-45


740

41+00
Rev. 40+99.75

Centerline Transition Detail
Scale: 1" = 10'

SCALE 5 FEET

FROM STA. 41+00	TO STA. 41+50
PROJECT NAME MONTPELIER	
NO. ME66-M6400(7)	PLOTTED 05/04/87
SURVEYED BY KASTNER-MOREAU 06/85	
SHEET 204 OF 335 SHEETS	

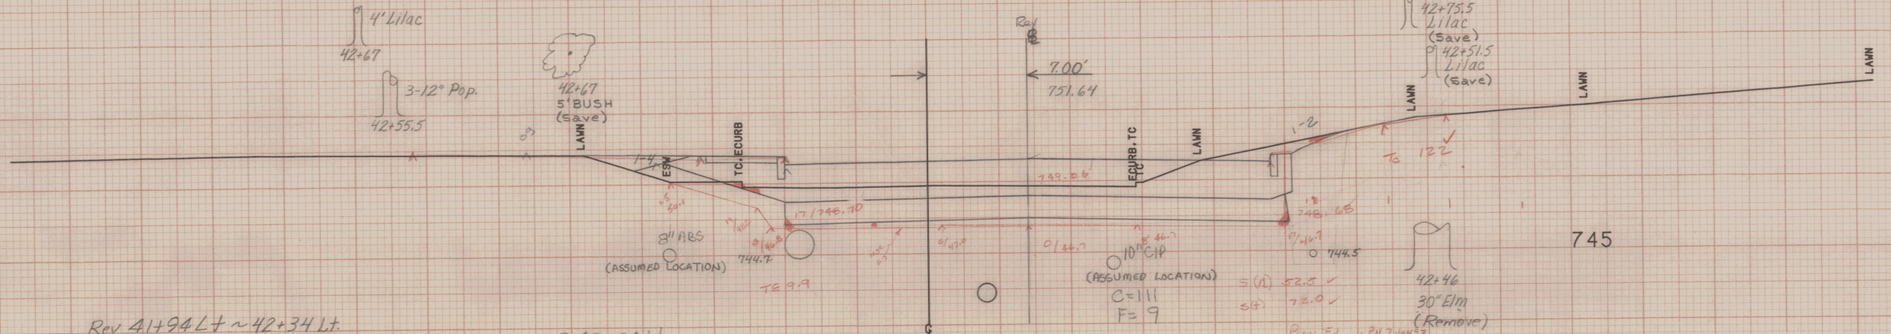


Rev 41+94 Lt ~ 42+34 Lt.
New 6"x 50' Underdrain w/ F.B @ 42+34 Lt.


42+50
Rev. 42+49.81

Rev 41+94 Lt.
End New 6" X 10' Underdrain
Carrier Pipe

Rev 41+95 Rt
Begin New 6"x 500' Underdrain
w/ Flushing Basin @ 46+95 Rt

Rev 41+84 Rt ~ 41+95 Rt
New 6"x 10' Underdrain Carrier Pipe

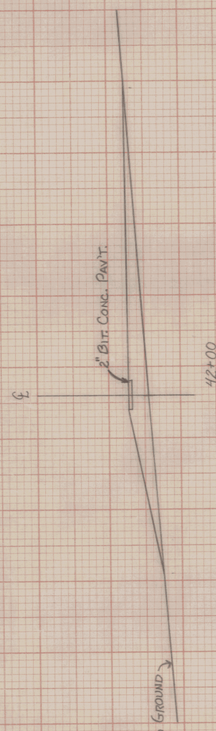

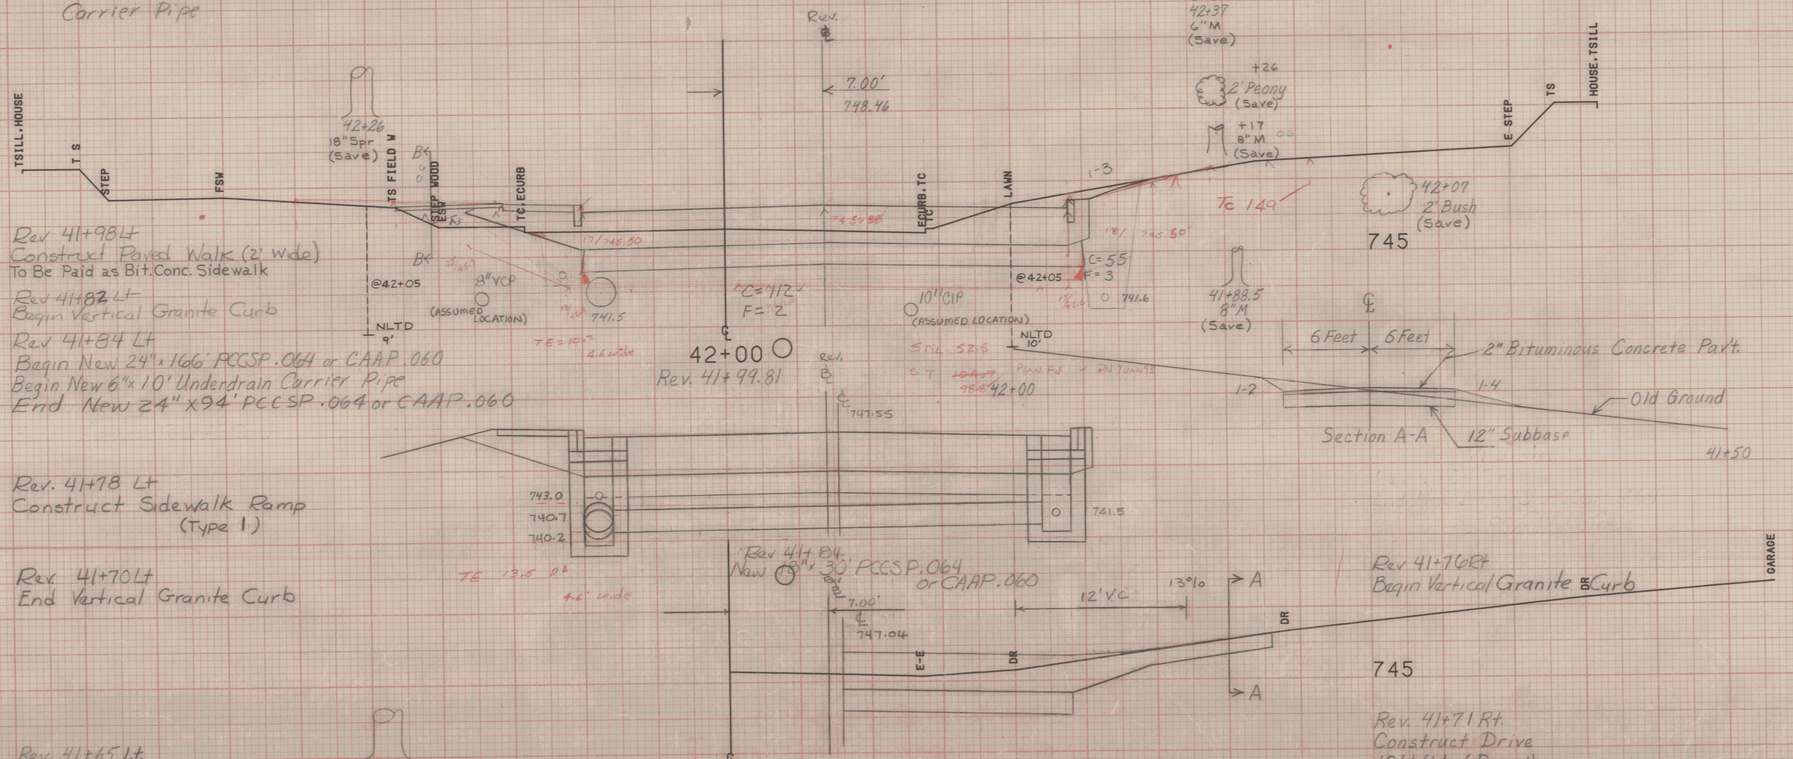

Rev 41+98 Lt
Construct Paved Walk (2' Wide)
To Be Paid as Bit. Conc. Sidewalk
Rev 41+82 Lt
Begin Vertical Granite Curb
Rev 41+84 Lt
Begin New 24"x 166' PCCSP. 064 or CAAP. 060
Begin New 6"x 10' Underdrain Carrier Pipe
End New 24" x 94' PCCSP. 064 or CAAP. 060

Rev. 41+78 Lt
Construct Sidewalk Ramp
(Type 1)

Rev. 41+70 Lt
End Vertical Granite Curb

Rev. 41+84
New 6"x 30' PCCSP. 064
or CAAP. 060

Rev 41+76 Rt
Begin Vertical Granite Curb

Rev. 41+65 Lt.
Begin Portland Cement Conc.
Sidewalk - 5"
5' Wide

41+76
24" Spr.
(Save)

Rev 41+71 Rt
Construct Drive
12' Wide (Paved)

Plot FJ
Plan proof 12/20/87


SCALE 5 FEET

FROM STA.	41+75	TO STA.	42+50
PROJECT NAME	MONTPELIER		
NO. MEGC-	M6400(7)	PLOTTED	05/04/87
SURVEYED BY	KASTNER-MOREAU 06/85		
SHEET 205	OF 335 SHEETS		

Rev. 43+50 ℄
New 18"x 30' PCCSP.064 Or CAAP.060


Rev. 43+50Rt. Begin New 18"x 40' PCCSP.064 Or CAAP.060

Rev 43+50 Rt ~ Rev 43+66Rt
New 6" x 20' Underdrain Carrier Pipe

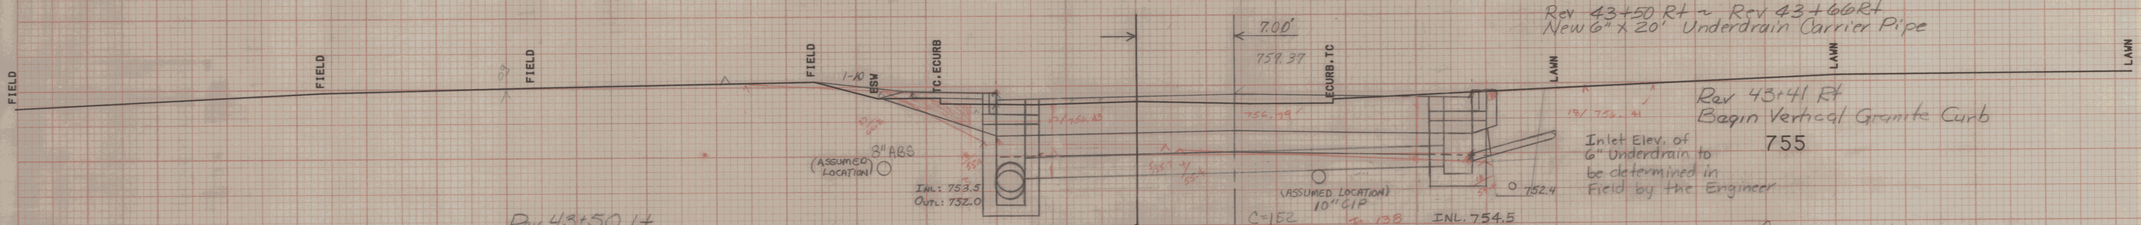


Rev. 43+41 Rt
Begin Vertical Granite Curb

Rev. 43+50 Lt
Begin New 24"x 148' PCCSP.064
or CAAP.060
End New 24"x 166' PCCSP.064
or CAAP.060

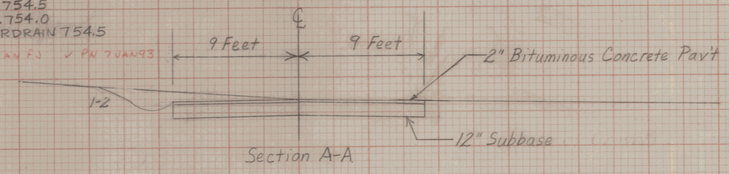


Section A-A

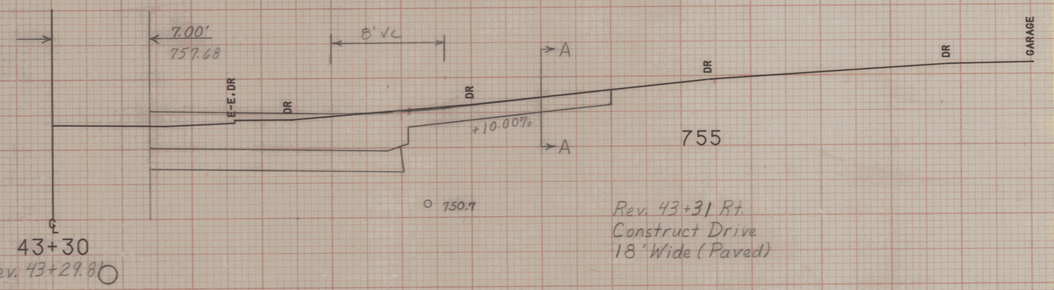

Rev. 43+31 Rt.
Construct Drive
18' Wide (Paved)


Rev. 43+22 Rt.
End Vertical Granite Curb

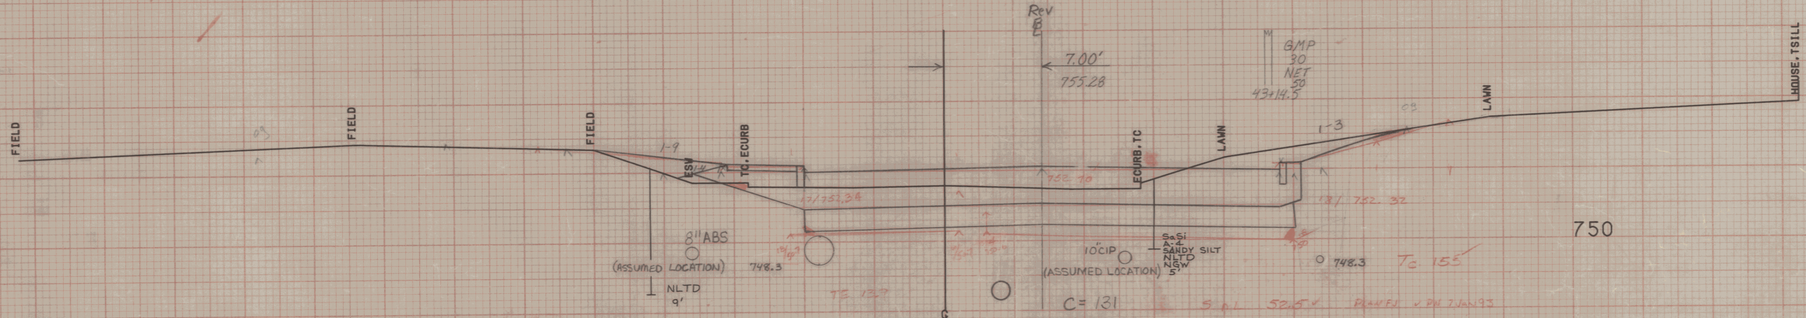

FROM STA.	43+00 TO STA. 43+50
PROJECT NAME	MONTPELIER
NO.	M6400(7) PLOTTED 05/04/87
SURVEYED BY	KASTNER-MOREAU 06/85
SHEET	206 OF 335 SHEETS

SCALE 5 FEET

Rev. 44+10 Lt
Remove Existing 2'x2' DI
& 12"x 32' CMP

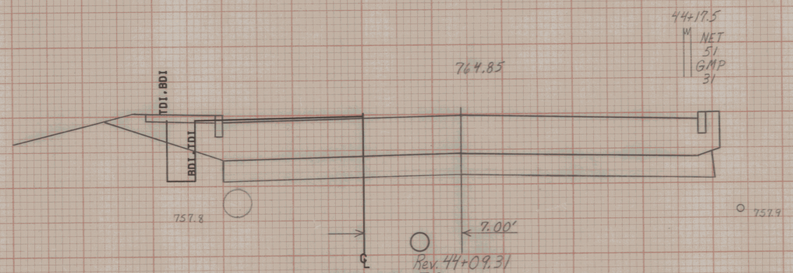


+39
12" Spr
(Save)

44+21
LILAC
(Save)

44+17.5
W
NET
51
GMP
31

I.P.
44+16.5

760

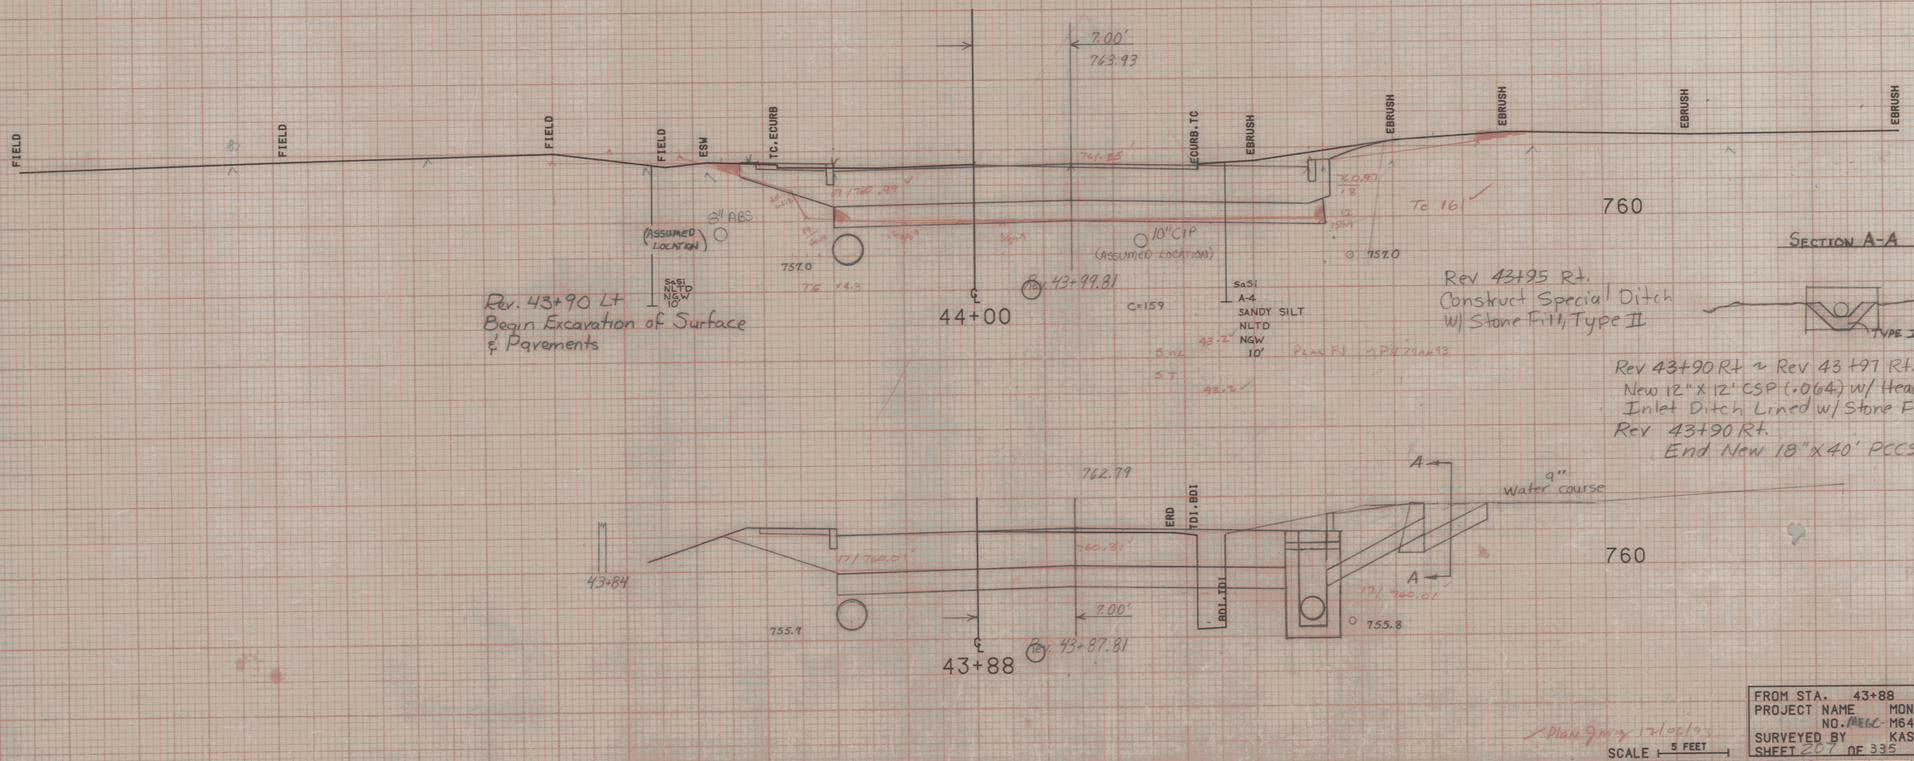

Rev. 43+90 Lt
Begin Excavation of Surface
& Pavements

Rev 43+95 Rt.
Construct Special Ditch
W/ Stone Fill, Type II

SECTION A-A

Rev 43+90 Rt ~ Rev 43+97 Rt.
New 12"X 12' CSP (.064) w/ Headwall and
Inlet Ditch Lined w/ Stone Fill, Type I
Rev 43+90 Rt.
End New 18"X 40' PCCSP (.064) or CAAP (.060)

FROM STA. 43+88	TO STA. 44+09.50
PROJECT NAME MONTPELIER	
NO. MEGC M6400 (7)	PLOTTED 05/04/87
SURVEYED BY KASTNER-MOREAU 06/85	
SHEET 207 OF 335 SHEETS	

SCALE 5 FEET

45+17.5
6" M
(Save)

EFIELD | EFIELD | EFIELD | LAWN | EBW | TC. EDGRB | EDGRB. TC | LAWN | LAWN | EDR | DR

773.90

Rev 45+00 Lt
Begin New 24"x170' PCCSP .064
or CAAP .060
End New 24"x148' PCCSP .064
or CAAP .060
Begin New 6"x50' Underdrain w/ F.B @ 45+50 Lt.

SaSI 5'

8" ABS
(ASSUMED LOC.)
Inv.: 766.9
Out: 766.8

10" C1P

6.97 (ASSUMED LOCATION)

SaSI 4'

766.8

Tc 174

Rev. 44+92 Rt
Begin Vertical Granite Curb

770

Rev. 44+99.81

45+00

Rev 45+00
New 18"x30' PCCSP.064
or CAAP.060

C=164
F=0

HP
SaSI
MLTD
15'

10' VC

Feet | Feet | 2" Bituminous Conc. Pav't

1:2

Section A-A

12" Subbase

772.89

A

+8.00%

A

770

Rev. PC 44+91.97
Dc 6°00' Lt
NC

4' Spr.
44+88.5

7.00'

766.0

Rev. 44+89.81

44+90

Rev. 44+86 Rt
Construct Drive
12' Wide (Paved)

Rev. 44+80 Rt
End Vertical Granite Curb

18" Spr. (Save)
44+67.5

FIELD | FIELD | FIELD | EBW | TC. EDGRB | EDGRB. TC | LAWN | LAWN | LAWN | HOUSE

7.00'
768.88

8" ABS
(ASSUMED LOCATION)
Tc 12.0
Tc 22.5

10" C1P
(ASSUMED LOCATION)

762.0

Rev. 44+49.81

C=172
F=0

Tc 183

12" Spr. (Save)
44+50


765


43+88 Rt ~ 45+82 Rt
Remove 2' Dia 15"x188' CMP

44+50

Finish Plot PS
Underscore all sections on PS & PROFILES
Plotting 12/16/87 AND MAB


FROM STA.	44+50 TO STA. 45+00
PROJECT NAME	MONTPELIER
NO.	M6400(7) PLOTTED 05/04/87
SURVEYED BY	KASTNER-MOREAU 06/85
SHEET	208 OF 355 SHEETS
SCALE	5 FEET

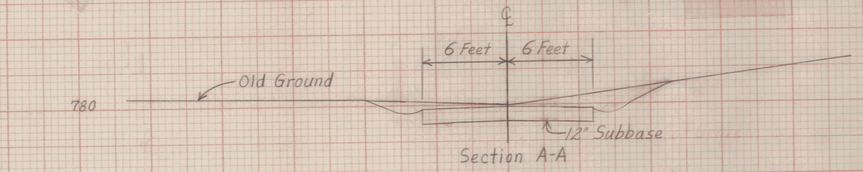

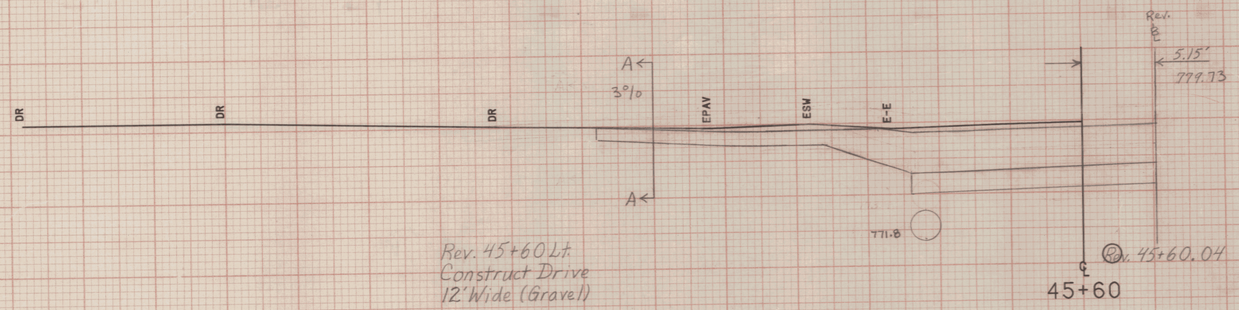



Rev. 45+60 Lt.
Construct Drive
12' Wide (Gravel)

Rev. 45+60.04

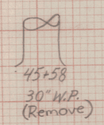

775

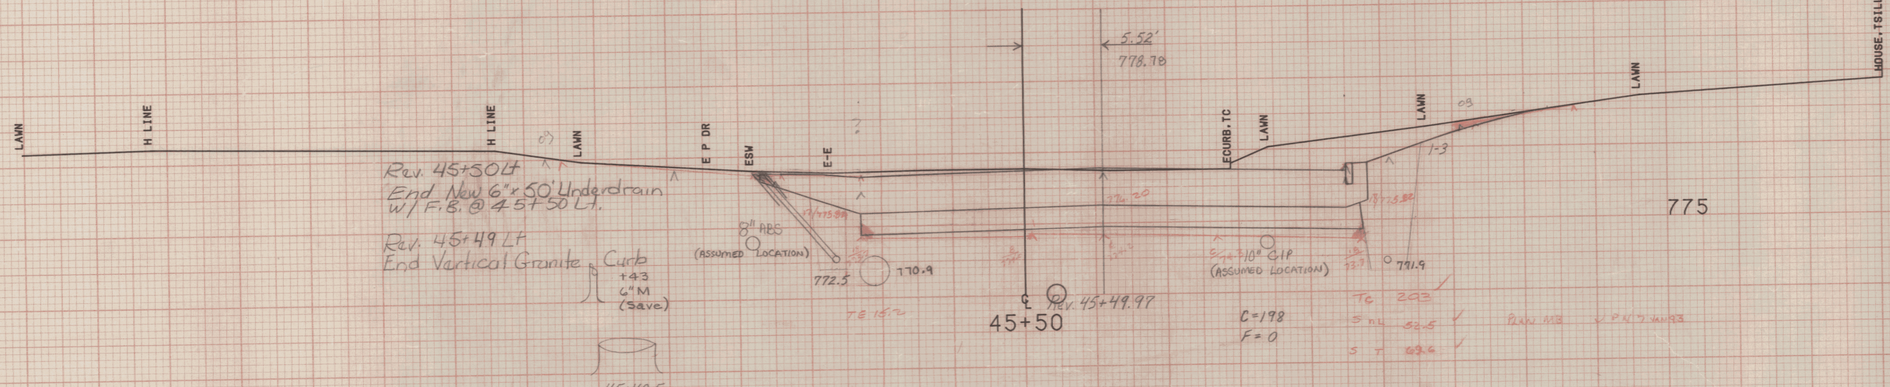

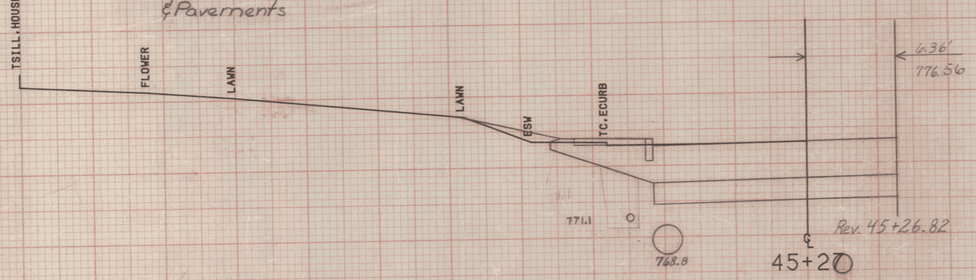

Plot EJ
✓ Plan Jimmy 12/06/85

FROM STA.	45+27	TO STA.	45+60
PROJECT NAME	MONTPELIER		
NO.	M6400(7)	PLOTTED	05/04/87
SURVEYED BY	KASTNER-MOREAU 06/85		
SHEET	209 OF 335 SHEETS		

SCALE 5 FEET

Rev. 46+54 Lt
Construct Drive
16' Wide (Paved)

EDR DR DR DR E-E ESW FLAT E CURB LAWN LAWN STEP HOUSE-TSILL

46+58 18" Spr. (Save)

1.82 787.73

785

6" Granite Marker

46+47 8" ABS (ASSUMED LOCATION)

10" CIP (ASSUMED LOC.)

780.2 TE: 11.6

780.6

Rev. 46+50.43

46+50

C=19.2
F=0

S(NE) 52.5
S(T) 79.3 Plan PN 8 JAN 93

46+28.5 15" Spr. (Save)

Rev. 46+41 Lt.
End Vertical Granite Curb

I.P. 46+43.5

46+27 5' LILAC (Remove)

46+20 3' Lilac (Remove)

46+15 3' LILAC (Remove)

+10 3' LILAC (Remove)

NET 52 GMP 32

46+03

ELAWN ELAWN ROW BUSH ESW TC, ECURB ECURB.TC LAWN LAWN LAWN LAWN

783.41

+02 3' LILAC (Save)

18" ARC (ASSUMED LOCATION)

+98 2' Lilacs (Save)

775.5

10" CIP (ASSUMED LOCATION)

776.3

780

3.68'

Rev. 46+00.25

46+00

TE 15.3

C-200
F-0

Rev. 46+00 (Approx.)
New 6"x 60' Sleeve for Utilities (Waterline)
(For Future Use)

2' Lilacs

45+94 2' LILAC (Save)

SaSi NLTD NGW 15'

SaSi NLTD NGW 10'

Old Ground

12" Subbase

8 Feet

8 Feet

Section C-C

2" Bituminous Conc. Pavt.

Section "B-B"

2" Bituminous Conc. Pavt.

+5% 12" SUBBASE MAT'L

781.82

TOI-BOI

BOI-TOI

4.32'

45+88.5 2' LILAC (Save)

Rev. 45+82.66

45+82.50

Existing Drive

780

Rev. 45+76 Rt.
Begin Vertical Granite Curb

Rev. 45+70 Rt
Construct Drive
12' Wide (Paved)

6 Feet 6 Feet

12" Subbase

Section A-A

2" Bituminous Concrete Pavt.

12' VC

4.60'

781.13

E-E DR DR

+14.4% GARAGE

780

774.7

45+70 30" M

Rev. 45+71 Lt
Begin Vertical Granite Curb

Rev. 45+75.12

45+75

Rev. 45+65 Rt.
End Vertical Granite Curb

Plan JMG 12/04/93


SCALE 5 FEET

FROM STA. 45+75 TO STA. 46+50
PROJECT NAME MONTPELIER
NO. M66 M6400(7) PLOTTED 05/04/87
SURVEYED BY KASTNER-MOREAU 06/85
SHEET 210 OF 335 SHEETS

47+45 Lt
Begin Vertical Granite Curb

47+42 Lt
Construct Sidewalk Ramp
(Type 1)


47+31 Lt
End Vertical Granite Curb

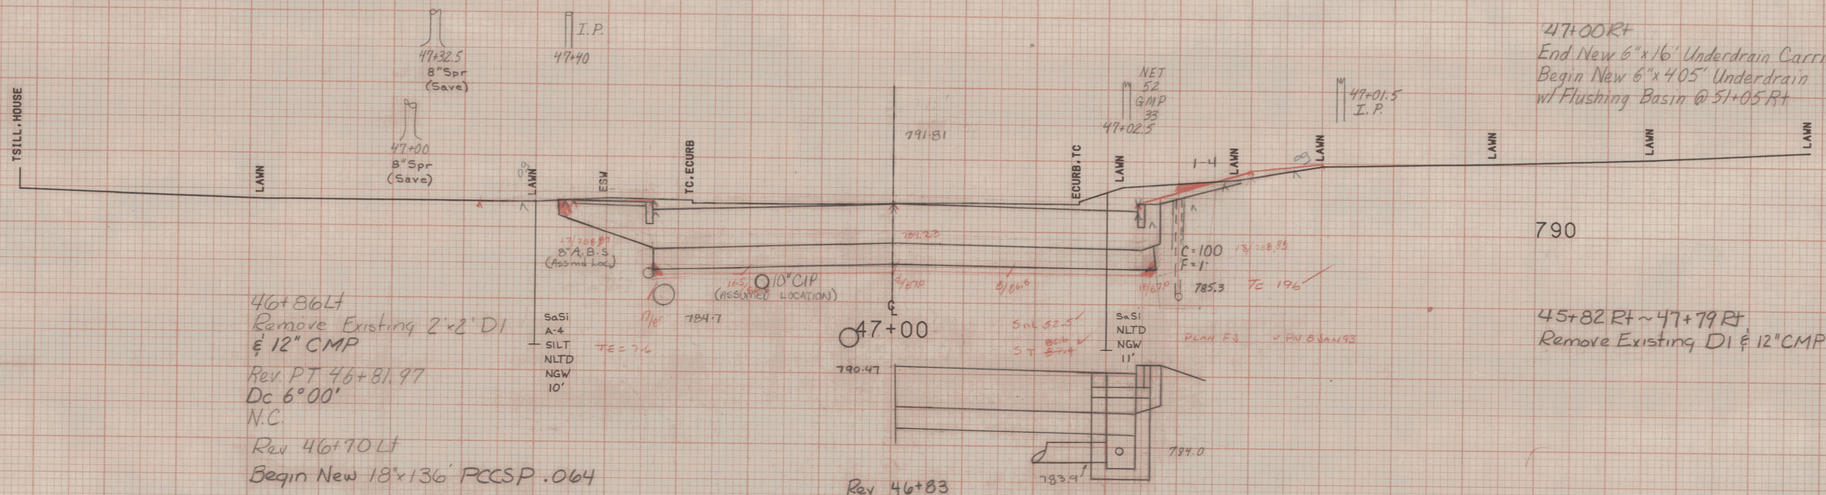


46+86 Lt
Remove Existing 2'-2' DI
& 12" CMP


Rev. PT 46+81.97
Dc 6°00'
N.C.

Rev 46+70 Lt
Begin New 18"x136' PCCSP .064
or CAAP .060
End New 24"x170' PCCSP .064
or CAAP .060

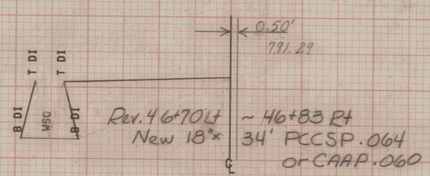

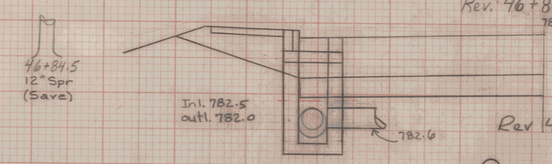

Rev. 46+81.97 =
Surv. 46+81.47
E_D = +0.5'

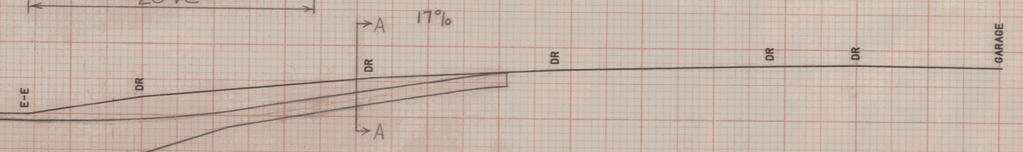

Rev. 46+60 Lt
Begin Vertical Granite Curb


46+63
6" Granite
Marker

Rev. 46+73.48
46+73

47+00 Rt
End New 6"x16' Underdrain Carrier Pipe
Begin New 6"x405' Underdrain
w/ Flushing Basin @ 51+05 Rt

790

45+82 Rt ~ 47+79 Rt
Remove Existing DI & 12" CMP

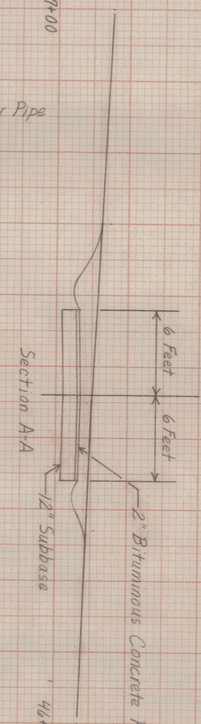

46+95 Rt
End New 6"x 500' Underdrain
w/ Flushing Basin @ 46+95 Rt

790

46+83 Rt
Begin New 6"x16' Underdrain
Carrier Pipe

Rev. 46+75 Rt.
Begin Vertical Granite Curb

Rev. 46+68 Rt.
Construct Drive
12' Wide (Paved)

785


Rev. 46+63 Rt
End Vertical Granite Curb


Plan Dwg. 12/86

SCALE 5 FEET

FROM STA.	46+73	TO STA.	47+00
PROJECT NAME	MONTPELIER		
NO.	MR6C-M6400(7)		PLOTTED 05/04/87
SURVEYED BY	KASTNER-MOREAU 06/85		
SHEET	211 OF 335 SHEETS		


47+78Lt ~ 47+89Lt
Vertical Granite Curb

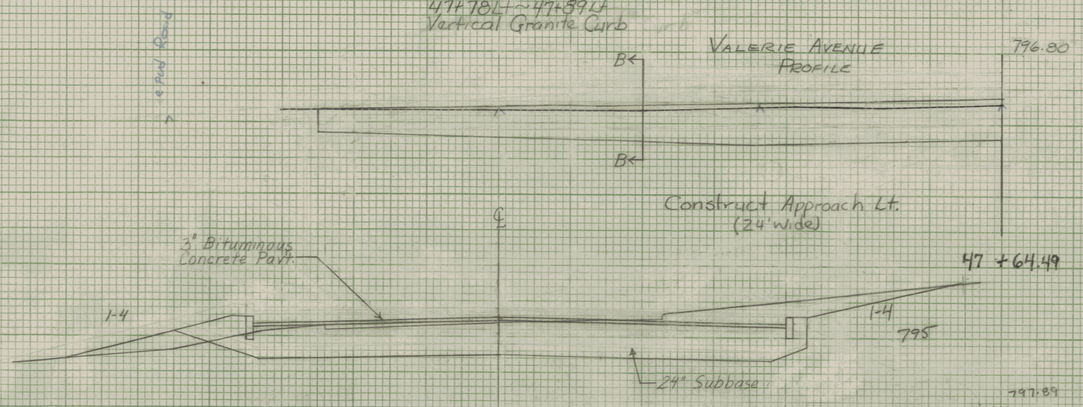

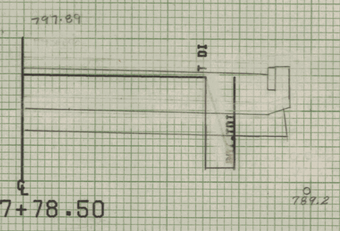


795

47+66 Rt
Begin Vertical Granite Curb

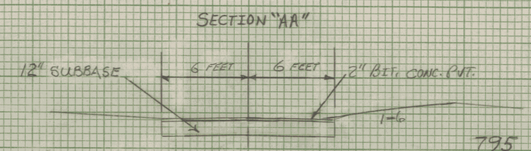

795

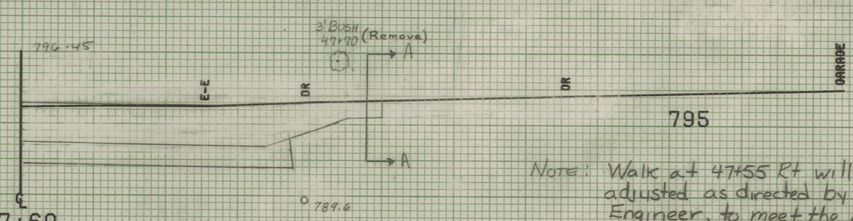


795

47+60 Rt
Construct Drive
12' Wide (Paved)

Note: Walk at 47+55 Rt will be adjusted as directed by the Engineer, to meet the new driveway elevation.

47+54 Rt
End Vertical Granite Curb


47+53 Lt
End Vertical Granite Curb

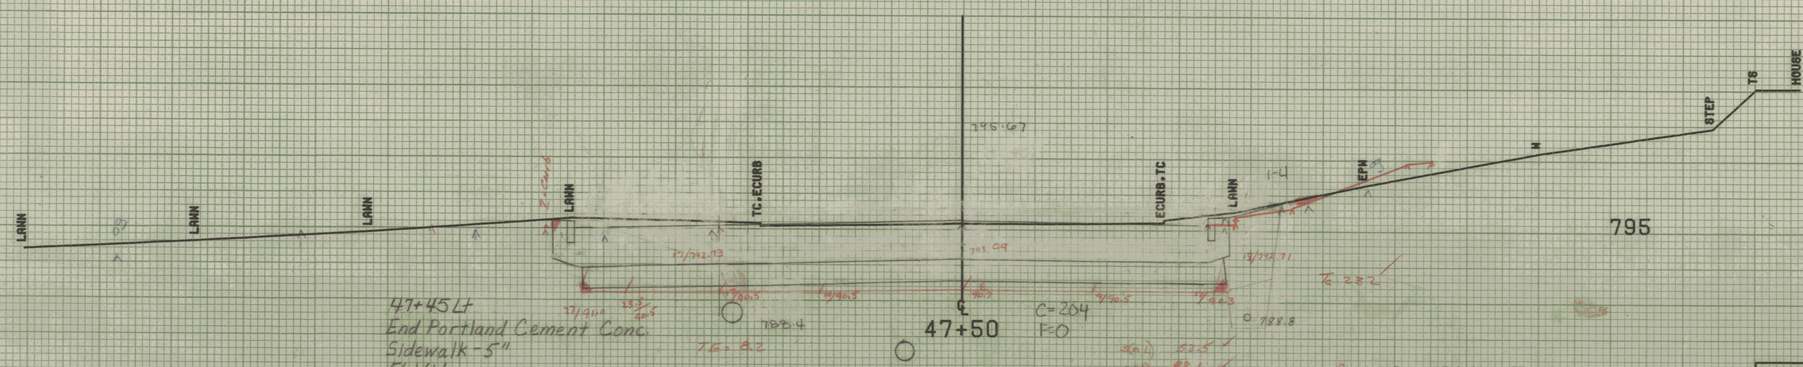


47+45 Lt
End Portland Cement Conc.
Sidewalk - 5"
5' Wide

SCALE 5 FEET


FROM STA. 47+50	TO STA. 47+78.50
PROJECT NAME	MONTPELIER MAIN5
NO.	M6400(7) PLOTTED 08/07/86
SURVEYED BY	KASTNER-MOREAU JUNE 1985
SHEET 212 OF 335	SHEETS

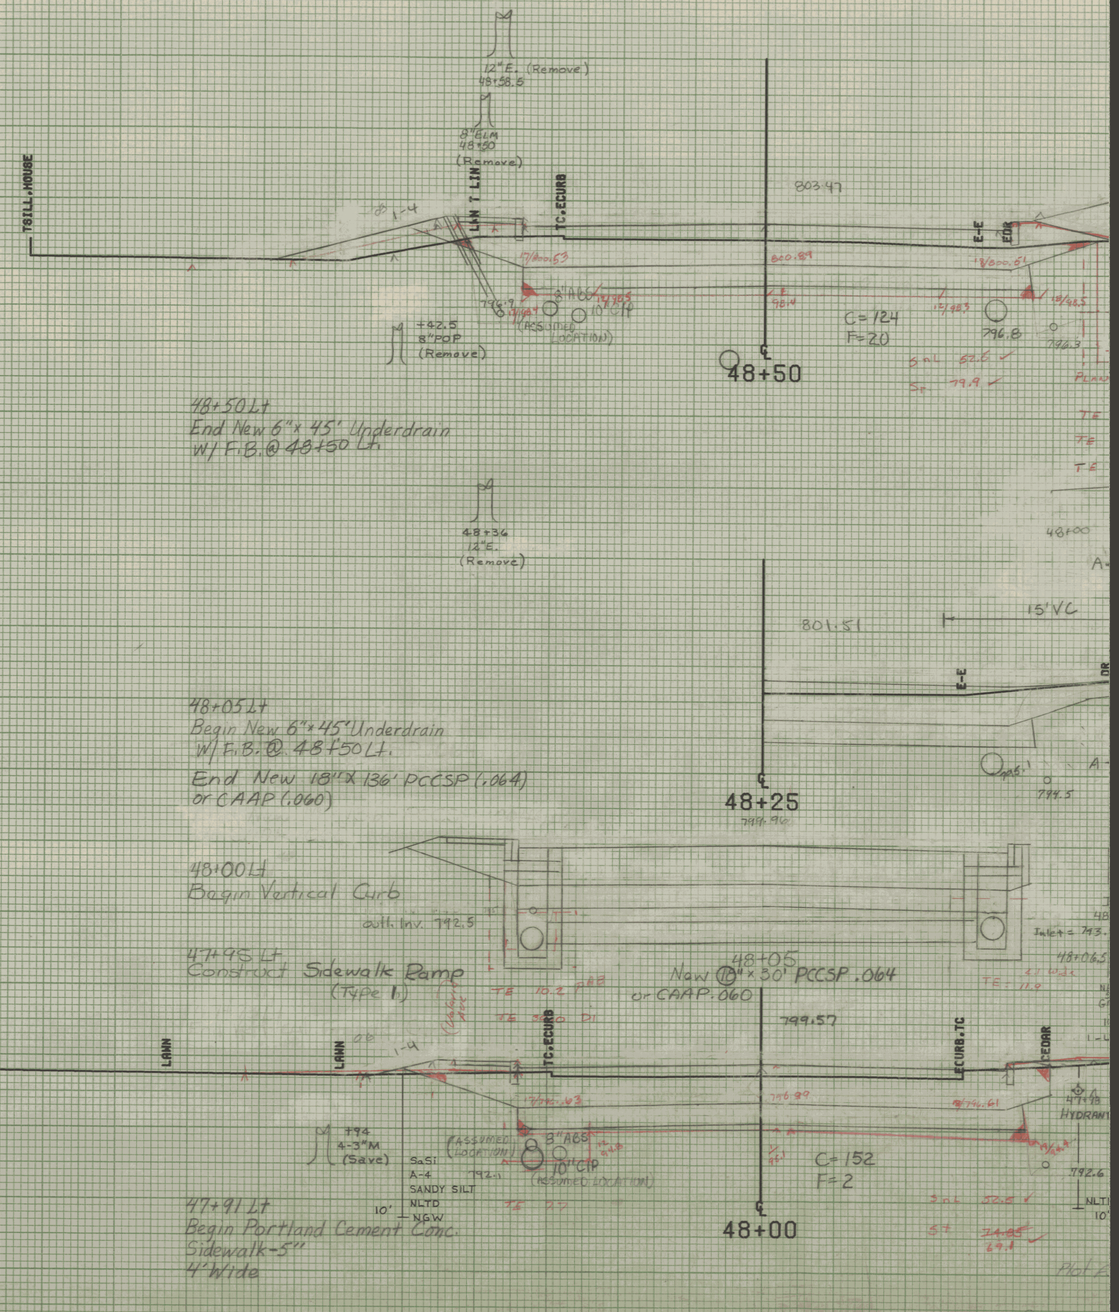
T&ILL HOUSE
LANN
T.C.
E-E
DR
12" E. (Remove)
48+58.5
8" CLM
48+50
(Remove)
803.47
800.89
796.9
796.8
48+50
+82.5
8" POP
(Remove)
C=124
F=20
48+50 Lt
End New 6"x 45" Underdrain
W/ F.B. @ 48+50 Lt.
48+36
12" E.
(Remove)
801.51
15" VC
48+25
799.96
48+05 Lt
Begin New 6"x 45" Underdrain
W/ F.B. @ 48+50 Lt.
End New 18" X 136' PCCSP (.064)
or CAAP (.060)
48+00 Lt
Begin Vertical Curb
outl. inv. 792.5
47+95 Lt
Construct Sidewalk Ramp
(Type I)
48+05
New 18"x 30' PCCSP .064
or CAAP .060
799.57
LANN
T.C.
CURB
CEDAR
794
4-3"M
(Save)
SaSi
A-4
SANDY SILT
NLTD
NGW
10'
C=152
F=2
48+00
47+91 Lt
Begin Portland Cement Conc.
Sidewalk-5"
4' Wide

SECTION "AA"

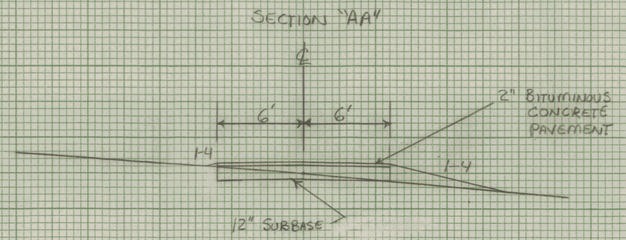


47+80 Rt ~ 50+95 Rt
Remove Existing 15" x 315' CMP, 2x2 DI
& 12" ABS Pipe.

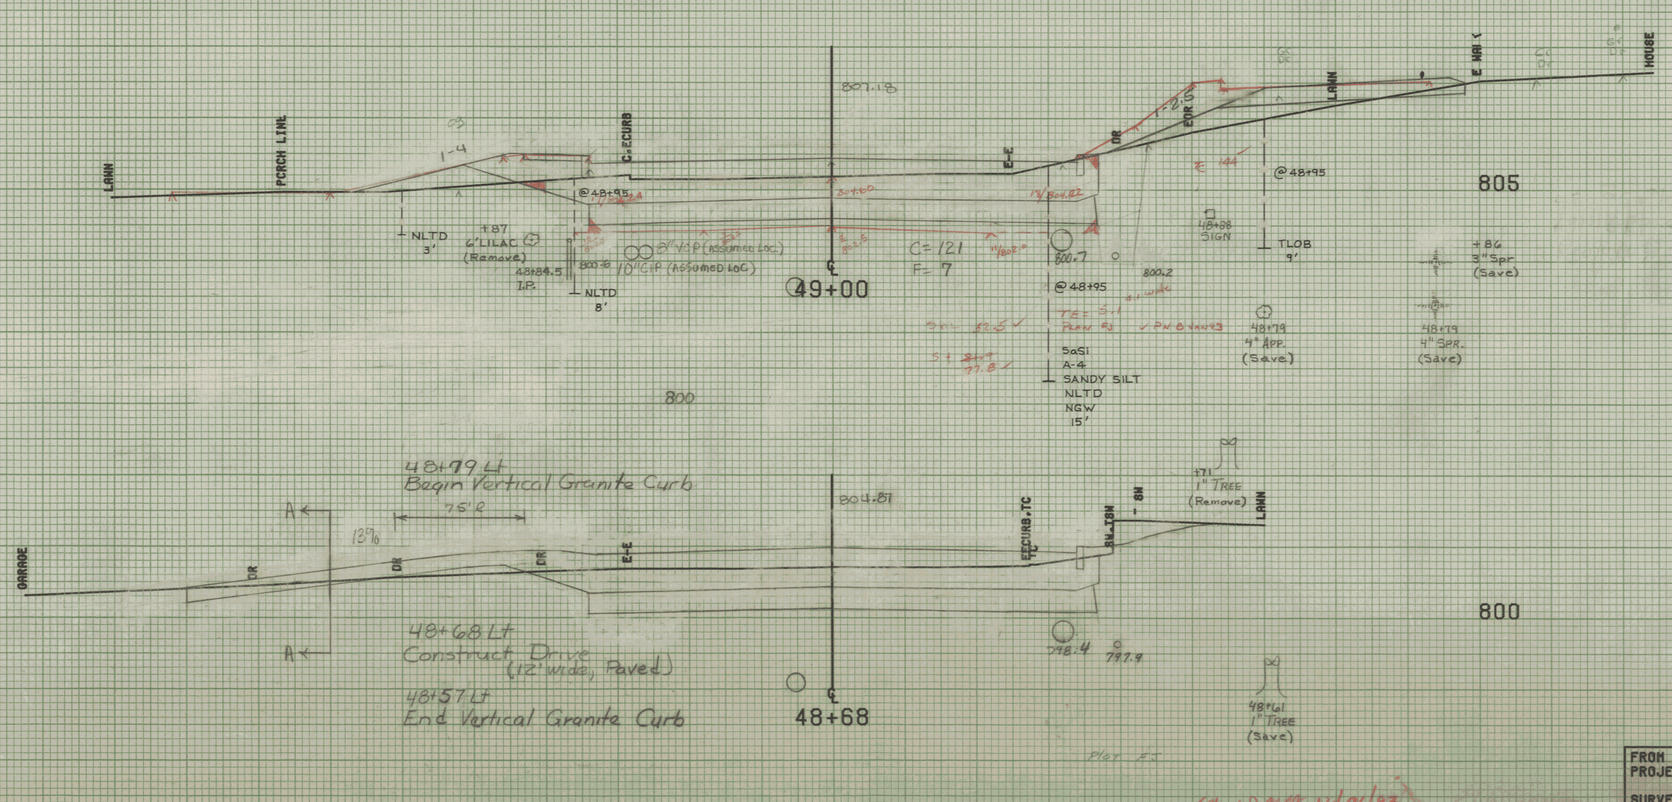

FROM STA.	48+68 TO STA. 48+00
PROJECT NAME	MONTPELIER MAIN5
NO.	M6400(7) PLOTTED 08/07/85
SURVEYED BY	KASTNER-MOREAU JUNE 1985
SHEET	214 OF 335 SHEETS

SCALE 5 FEET

805

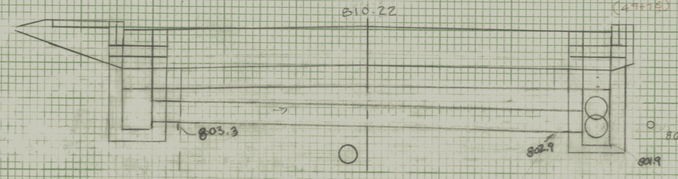


49+45 Rt
New 18"x 30' PCCSP.064 or
CAAP.060


49+45 Rt
Begin New 18"x 154' PCCSP.064
or CAAP.060

End New 18"x 98' PCCSP.064
or CAAP.060

49+48.5 Lt
Remove Existing 12" CMP
With 2'x2' DI

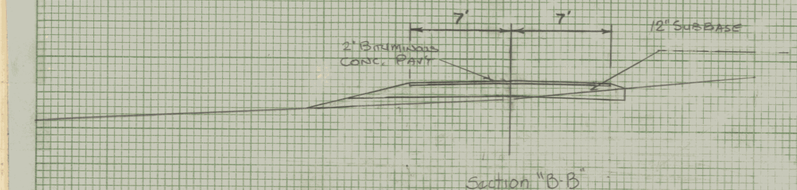


Section "B-B"

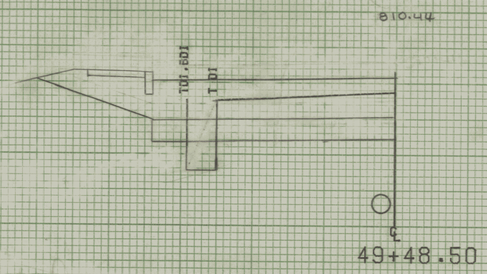

805




49+41 Lt
Begin Vertical Granite Curb

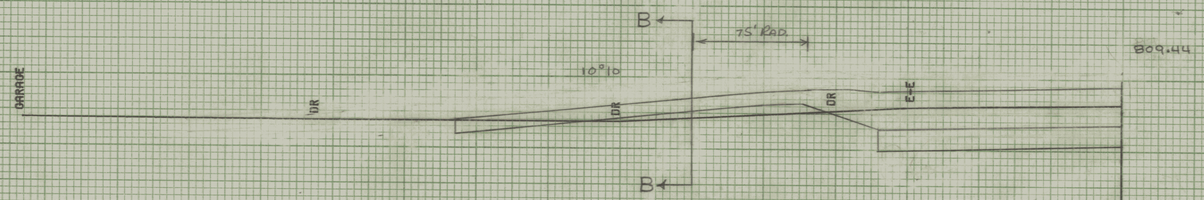

49+33 Lt
Construct Drive
14' Wide, Paved

805

49+21 Lt
End Vertical Granite Curb

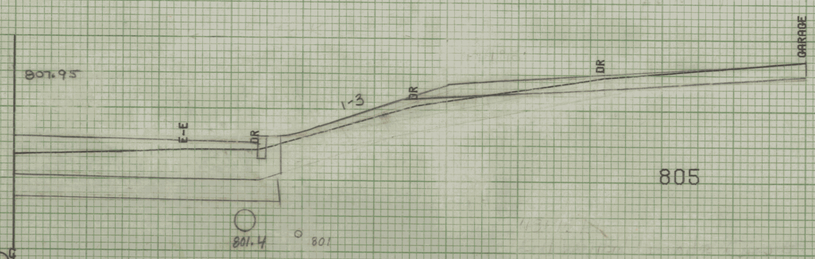


805

FROM STA.	49+11 TO STA. 49+48.50
PROJECT NAME	MONTPELIER MAINE
NO.	MRGL-M6400(7) PLOTTED 08/07/85
SURVEYED BY	KASTNER-MOREAU JUNE 1985 109
SHEET	215 OF 335 SHEETS

SCALE 5 FEET

SECTION "AA"

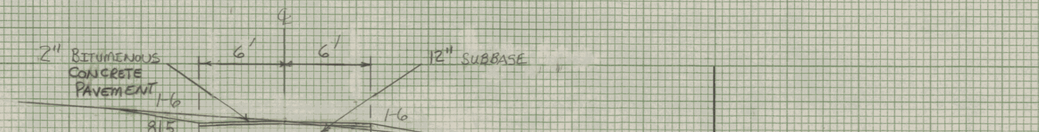

50+06 - 51+00 Lt.
Deciduous Trees
2 - 1½" Sugar Maples
and 1 - 1½" Radiant
Flowering Crab


Trees to be planted outside of R.O.W. in a location which is mutually agreeable with the property owner and resident engineer.


50+53 Lt.
CONSTRUCT DRIVE
(12' WIDE PAVED)

50+42 Lt
End Vertical Granite Curb

50+34 Lt ~ 50+42 Lt
Removing & Resetting Fence

49+70 Rt
Begin Vertical Granite Curb

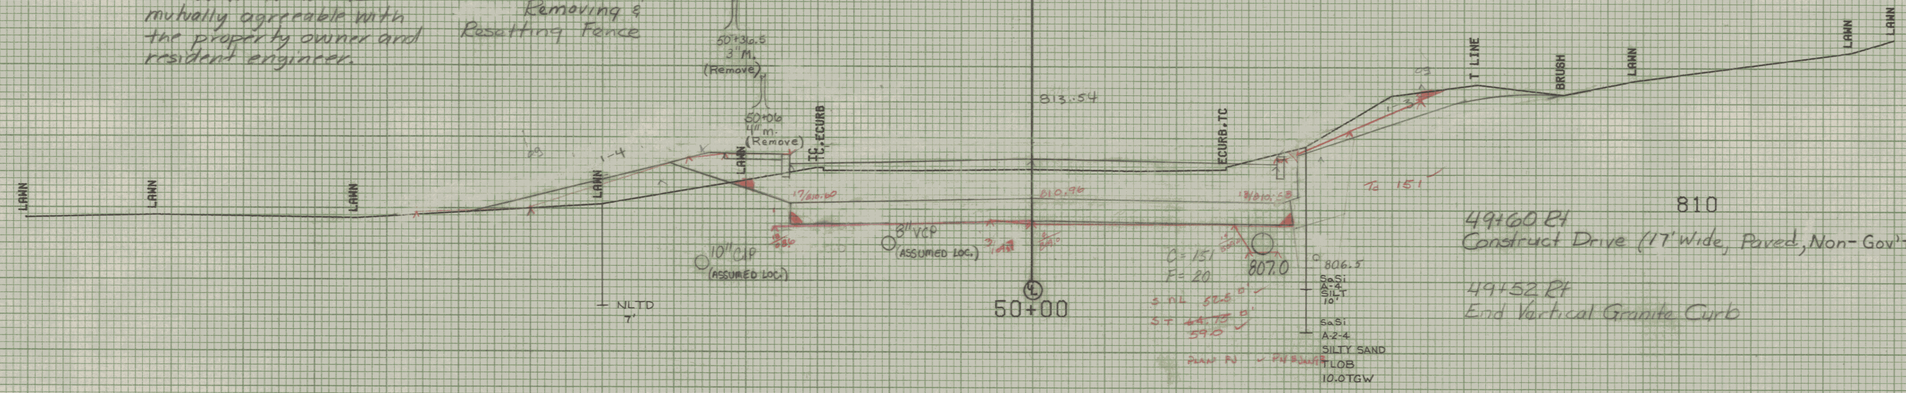

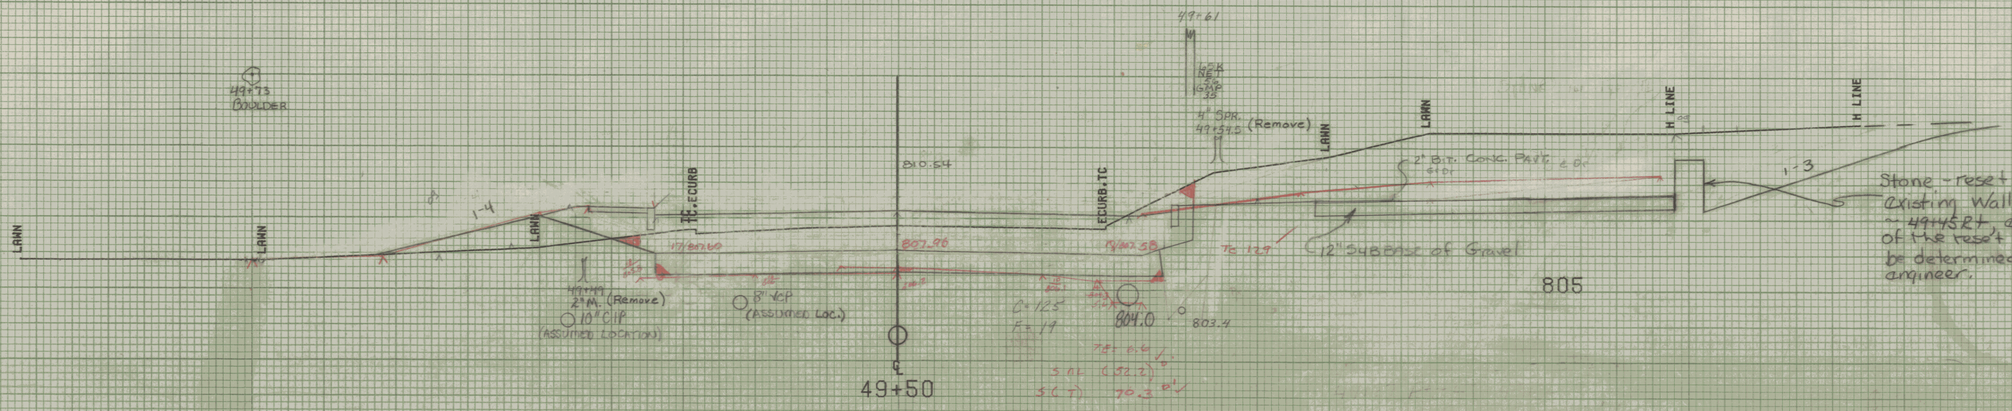

Plan FN


PLAN FN 12/06/93

FROM STA.	49+50 TO STA. 50+50
PROJECT NAME	MONTPELIER MAINE
NO.	M660-M6400(7) PLOTTED 08/07/85
SURVEYED BY	KASTNER-MOREAU JUNE 1985
SHEET	2/6 OF 335 SHEETS

SCALE 5 FEET


50+95Lt~51+03Lt
Removing and Resetting Fence

818.38

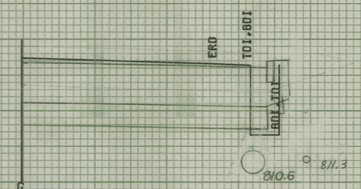

50+95


50+95Rt~51+28.5Lt
Remove Existing 12" CMP and 2'x2' DI
Disposition of 6" VCP to be determined by Resident Engineer.

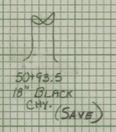

815

PC 50+87.85
Dc 12°00' Rt
N.C.

817.55

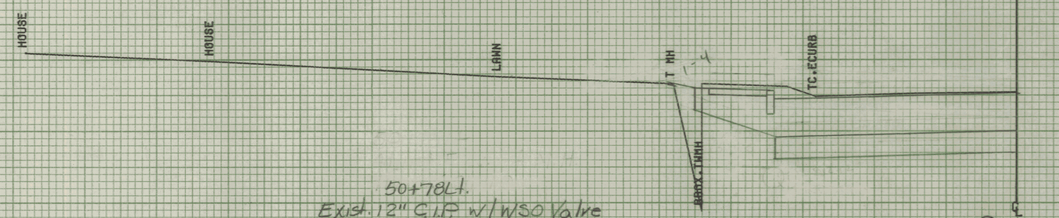

50+78

50+78Lt.
Exist. 12" C.I.P. w/WSO Valve
9'x7' Conc. Box, Retain
Adjust Elev. of Manhole
Non-Gov't. Part.

815

817.11




50+69

50+69Lt
12" C.I.P. w/WSO Valve
9'x7' Conc. Box, Retain

50+66Lt~50+75Lt
Removing and Resetting Fence

815

816.57

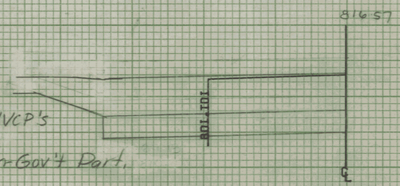

50+58


50+64Lt
Begin Vertical Granite Curb
50+58Lt. Exist. Sewer Manhole w/2-6"VCP's and a 8" PCP - Retain
Adjust Elev. of Manhole Non-Gov't Part.


815


FROM STA. 50+58 TO STA. 50+95
PROJECT NAME MONTPELIER MAINS
NO. MEGC-M6400(7) PLOTTED 08/07/85
SURVEYED BY KASTNER-MOREAU JUNE 1985
SHEET 217 OF 335 SHEETS

SCALE 5 FEET

SECTION "AA"

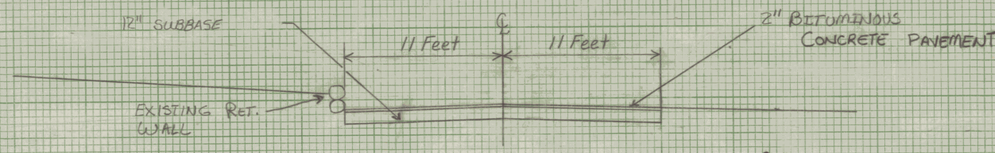
12" SUBBASE
11 Feet
11 Feet
2" BITUMINOUS CONCRETE PAVEMENT
EXISTING RET. WALL

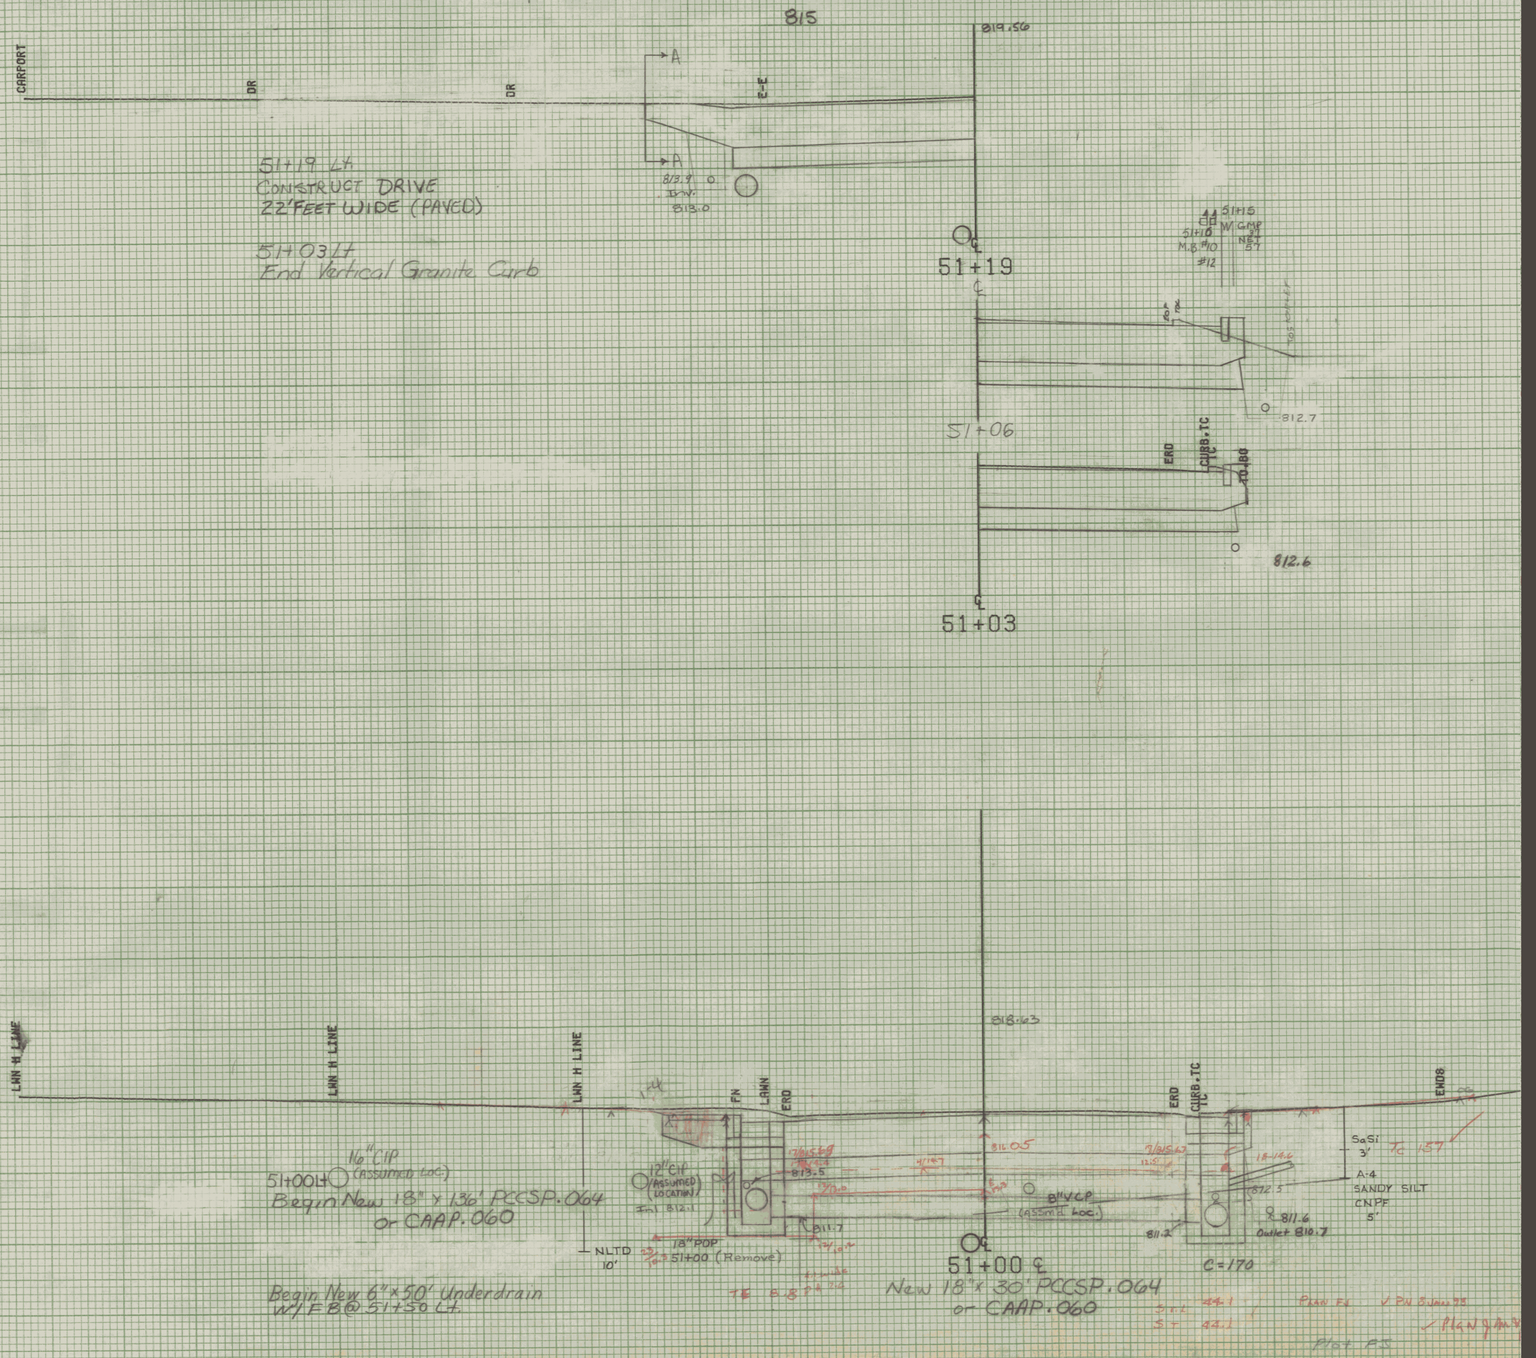

815
819.56
CARPORT
DR
DR
E-E
A
A
813.9
to W.
813.0
51+19 ℄
51+16
M.B. 810
#12
M GMP
NET
51+19
51+06
812.7
812.6
51+03
51+19 LT
CONSTRUCT DRIVE
22' FEET WIDE (PAVED)
51+03 LT
End Vertical Granite Curb
LAN H LINE
LAN H LINE
LAN H LINE
FN
LAWN
END
818.63
END
CURB-TC
END8
16" CIP (assumed Loc.)
51+00 LT
Begin New 18" x 136' RCCSP.064
or CAAP.060
12" CIP (ASSUMED LOCATION)
813.5
811.7
18" POP
51+00 (Remove)
NLTD 10'
816.05
8" V.C.P. (ASSUMED Loc.)
811.2
811.6
Outlet 810.7
C=170
51+00 ℄
New 18" x 30' RCCSP.064
or CAAP.060
SaSi 3'
TC 157
A-4 SANDY SILT CNPF 5'
Begin New 6" x 50' Underdrain w/ FB @ 51+50 LT.
Plot A3

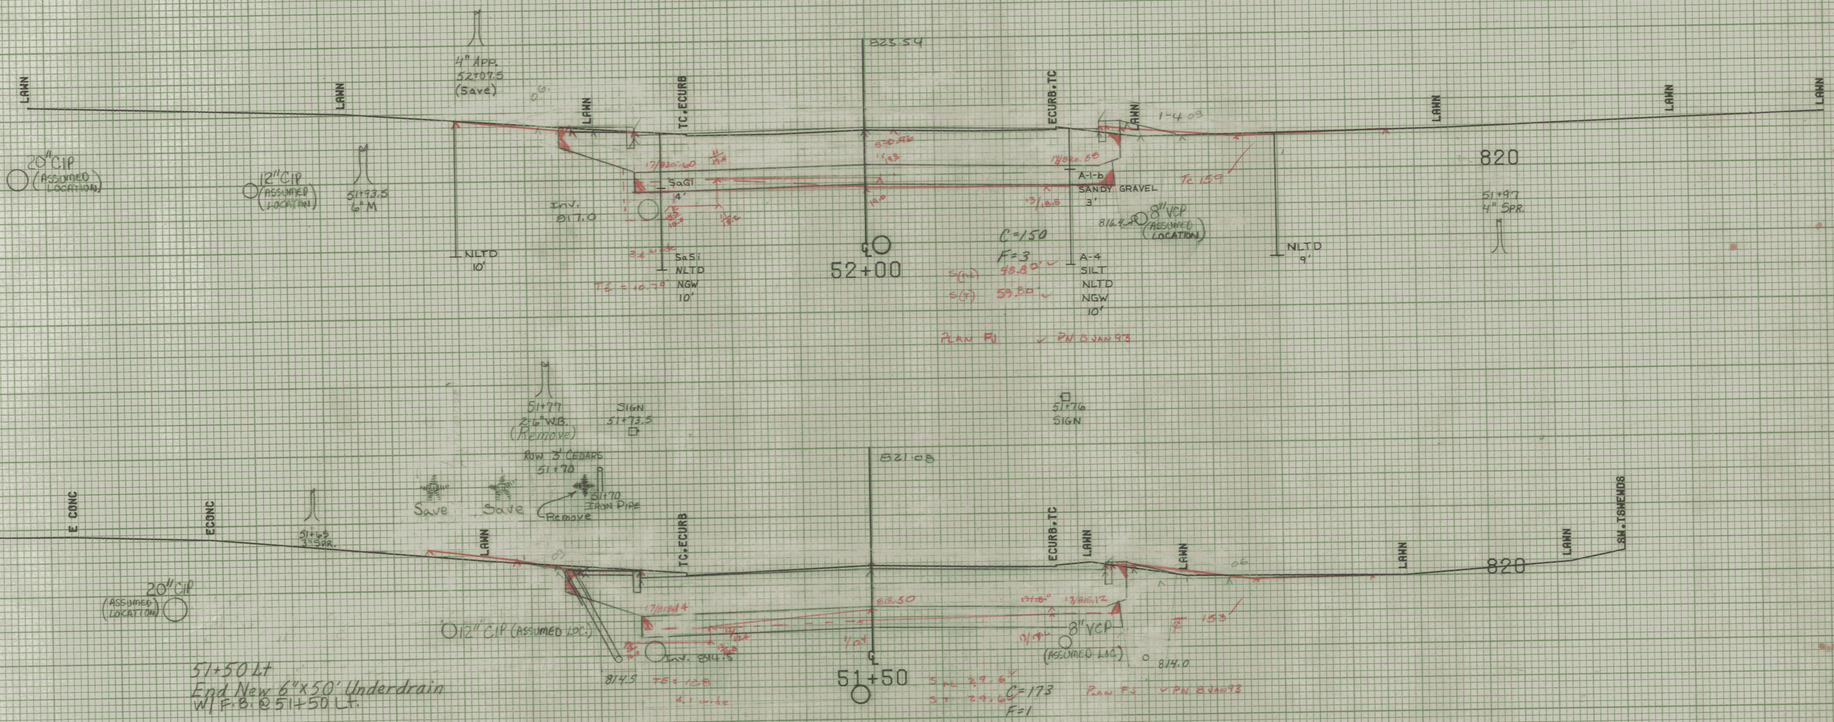
LAWN
4" APP.
52+07.5
(Save)
20" CIP
(ASSUMED LOCATION)
12" CIP
(ASSUMED LOCATION)
51+93.5
6" M
TC=ECURB
ECURB=TC
B23.54
Lev. 811.0
Sa Si
NLTD
NGW
10'
52+00
C=150
F=3
A-1-b
SANDY GRAVEL
3'
A-4
SILT
NLTD
NGW
10'
NLTD
9'
8" VCP
(ASSUMED LOCATION)
820
51+97
4" SPR.
PLAN FU
PW 8 JAN 93
TOSILL=HOUSE
E CONC
ECONC
51+79
2-6" WB
(Remove)
SIGN
51+73.5
ROW 3' CEDARS
51+70
51+70
LIGHT POLE
Remove
Save
Save
51+55
3" SPR.
51+76
SIGN
B21.08
SW=TOMEADOW
8" VCP
(ASSUMED LOC)
814.0
12" CIP (ASSUMED LOC)
814.5
51+50
C=173
F=1
51+50 Lt
End New 6"X50' Underdrain
W/ F.B. @ 51+50 Lt.
51+34 Lt
Begin Vertical Granite Curb
820.03
TOI=BOI
BOI=TOI
814
Inv
813.5
51+28.50
820
FROM STA. 51+28.50 TO STA. 52+00
PROJECT NAME MONTPELIER MAINE
NO. M64C-ME400(7) PLOTTED 08/07/86
SURVEYED BY KASTNER-MOREAU JUNE 1985
SHEET 2/2 OF 335 SHEETS
SCALE 5 FEET
PLOT FI
PLOT 9 May 12/06/93
PLOT 9 May 11/10/93


52+35 Lt ~ 52+54 Rt
New 18"x 36' PCCSP.064
or
CAAP.060

52+45 Rt
Remove Existing 12" Drive Culvert


52+44 Rt
Begin Vertical Granite Curb

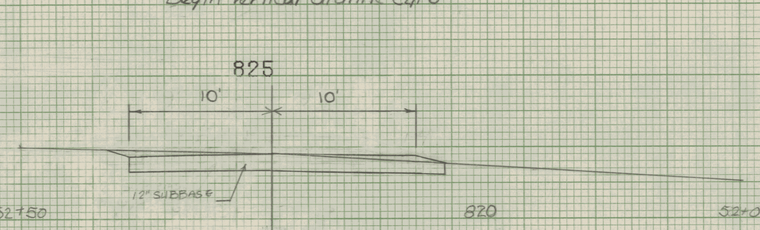


Section "B-B"
SCALE: 1"= 5'

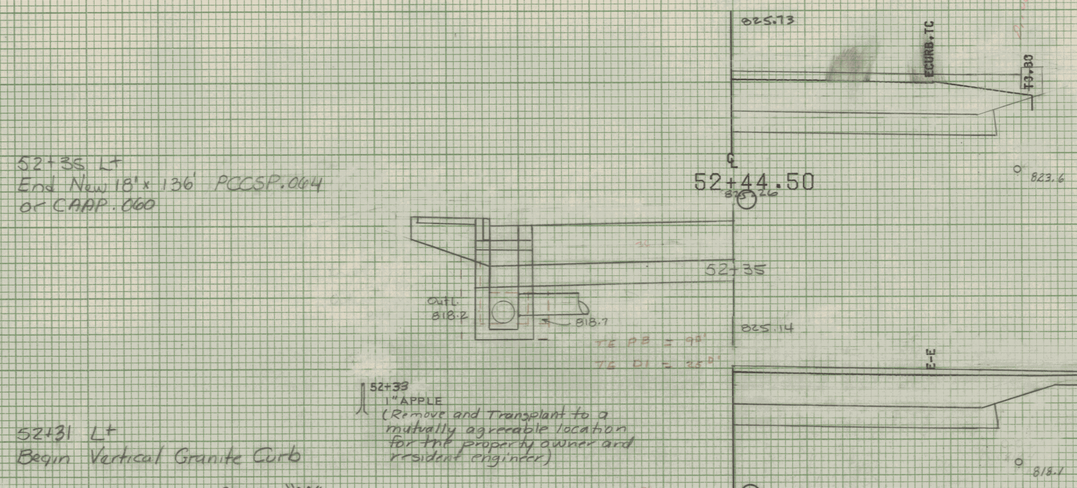

52+31 Lt
Begin Vertical Granite Curb

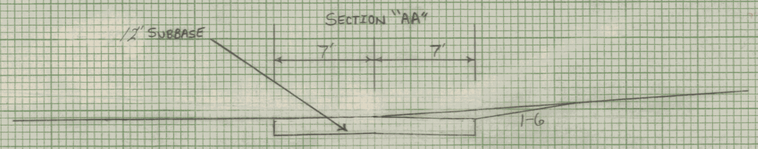


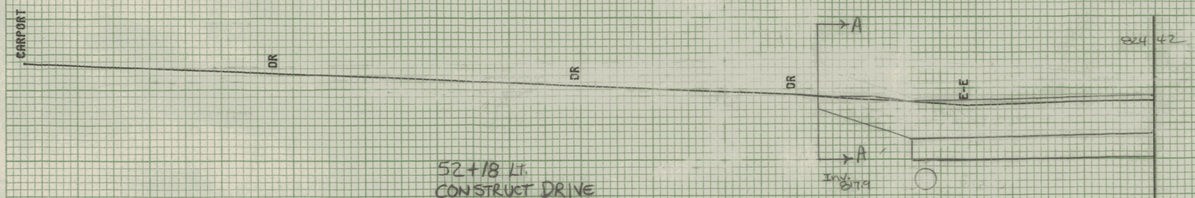

52+18 Lt.
CONSTRUCT DRIVE
14' WIDE (GRAVEL)

52+06 Lt
End Vertical Granite Curb

M.B.#267
52+23
4
52+22
M.B.#22

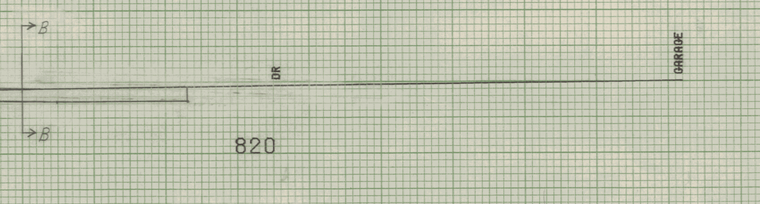

52+35 Rt
Construct Drive
(20' Wide, Gravel)

P.T. 52+28.18
Dc 12°00' Rt
NC

52+25 Rt
End Vertical Granite Curb

52+23 Rt
Relocate Mailbox, Multiple Support (1)

820

SCALE 5 FEET

FROM STA. 52+18	TO STA. 52+44.50
PROJECT NAME	MONTPELIER MAINE
NO. M6400(7)	PLOTTED 08/07/86
SURVEYED BY	KASTNER-MOREAU JUNE 1985
SHEET 220 OF 335 SHEETS	

53+28 ~ 53+55 Rt
Sodding of Existing Drive

53+27 Lt
Begin Vertical Granite Curb
53+16 Lt
Construct Drive 12' Wide (Paved)
(See Next Sht. for Drive Typ.)
53+05 Lt
End Vertical Granite Curb

53+32
53+34
53+14
53+00
52+54

825
830
825
825
825
825
825

FRONT OF POND
BACK OF POND

53+17 ~ 53+70 Rt. Evergreen Trees
4' to 5' Colorado Blue Spruce
Tree to be planted in a location which is mutually agreeable with the property owner and the resident engineer.

52+54 Rt ~ 53+14 Rt
New 6"x62' Underdrain Carrier Pipe

52+54 Rt ~ 54+20 Rt
New 18"x162' PCCSP.064 or CAAP.060

6" PIPE 825.7
6" PIPE 824.6
6" PIPE 821.0
8" SEWER (ASSUMED LOCATION)
8" SEWER (ASSUMED LOCATION)

ROW 3" SPR. TREES 53+19
(Remove) (SAVE) (SAVE) (SAVE)

52+57 2½" W.B. (Save)
+57 HYD
6" WATER
52+49 8" APP. (SAVE)
52+88.5 NET ET CO. 58 GMP 38
53+29 10" W. PINE
4" Cky 52+53

LAWN
HOUSE
HOUSE & BILL
ECURB & TC
DITCH
TLOB 3'
NLTD 8'
NLTD 6'
NLTD 10'
NLTD 9'
NLTD NGW 10'
T.P.
LAWN & SPRING
I.E. S
A-1-b SANDY GRAVEL
A-4 SILT

Inv. 823.5
823.5
Inv. 821.9
821.5
819.6
819.1
826.00

C=109 F=19
C=130 F=4

FROM STA. 52+50 TO STA. 53+34
PROJECT NAME MONTPELIER MAIN6 -
NO. M6400(7) PLOTTED 08/07/85
SURVEYED BY KASTNER-MOREAU JUNE 1985
SHEET 22 OF 335 SHEETS

Plan error 11/10/93
Plan error 10/04/93
SCALE 5 FEET

54+42 Rt
Retain Existing 4'x4' RCDI, 4"CIP
6"CIP and 6"CVP Outlet

54+31 Lt
End Vertical Granite Curb

54+20

54+42

54+20 Lt
Begin Vertical Granite Curb
End Portland Cement Conc. Sidewalk, 5"

54+17 Lt
Construct Sidewalk Ramp
(Type I)

54+08 Lt
End Vertical Granite Curb

54+12 Rt
Begin Vertical Granite Curb
P.C. 53+81.92
Dc 12°00' Rt
N.C.

54+10 Rt.
Removing and Resetting
Curb (15' of Timber
Curb along edge of drive)

53+98 Rt
Construct Drive
(22' Wide, Gravel)

53+88 Rt.
Removing and Resetting
Curb (15' of Timber
Curb along edge of drive)

53+89 Rt
End vertical Granite Curb

53+52 Rt
Relocate Mailbox, Single Support (

Drive at 53+16 Lt.

Section "B-B"

53+50

FROM STA. 53+50 TO STA. 54+42
PROJECT NAME MONTPELIER MAIN6
NO. M6400(7) PLOTTED 08/07/85
SURVEYED BY KASTNER-MOREAU JUNE 1985
SHEET 22 OF 336 SHEETS

SCALE 5 FEET

PT 55+20.49
Dc 12°00' Rt
N.C.
55+20 Rt
End New 6" Underdrain
w/ Flushing Basin @ 55+20 Rt

55+03 Rt
Relocate Mailbox, Single Support (1)

54+98 Rt
Begin Vertical Granite Curb

54+86 Rt
Construct Drive
(20' Wide, Paved)

54+76 Rt
End Vertical Granite Curb

54+59 Lt
Begin Vertical Granite Curb

54+51.70 Lt
Construct Hebert Road Approach

Section "B-B"

Section A-A
Hebert Road


FROM STA. 54+50 TO STA. 55+00
PROJECT NAME MONTPELIER MAINE
NO. MEGC-M6400(7) PLOTTED 08/07/85
SURVEYED BY KASTNER-MOREAU JUNE 1985
SHEET 22 OF 335 SHEETS

SCALE 5 FEET

FINALS - C.R. LOHR 11-10-93

Plot EJ

✓ Plan Proj. 12/06/93

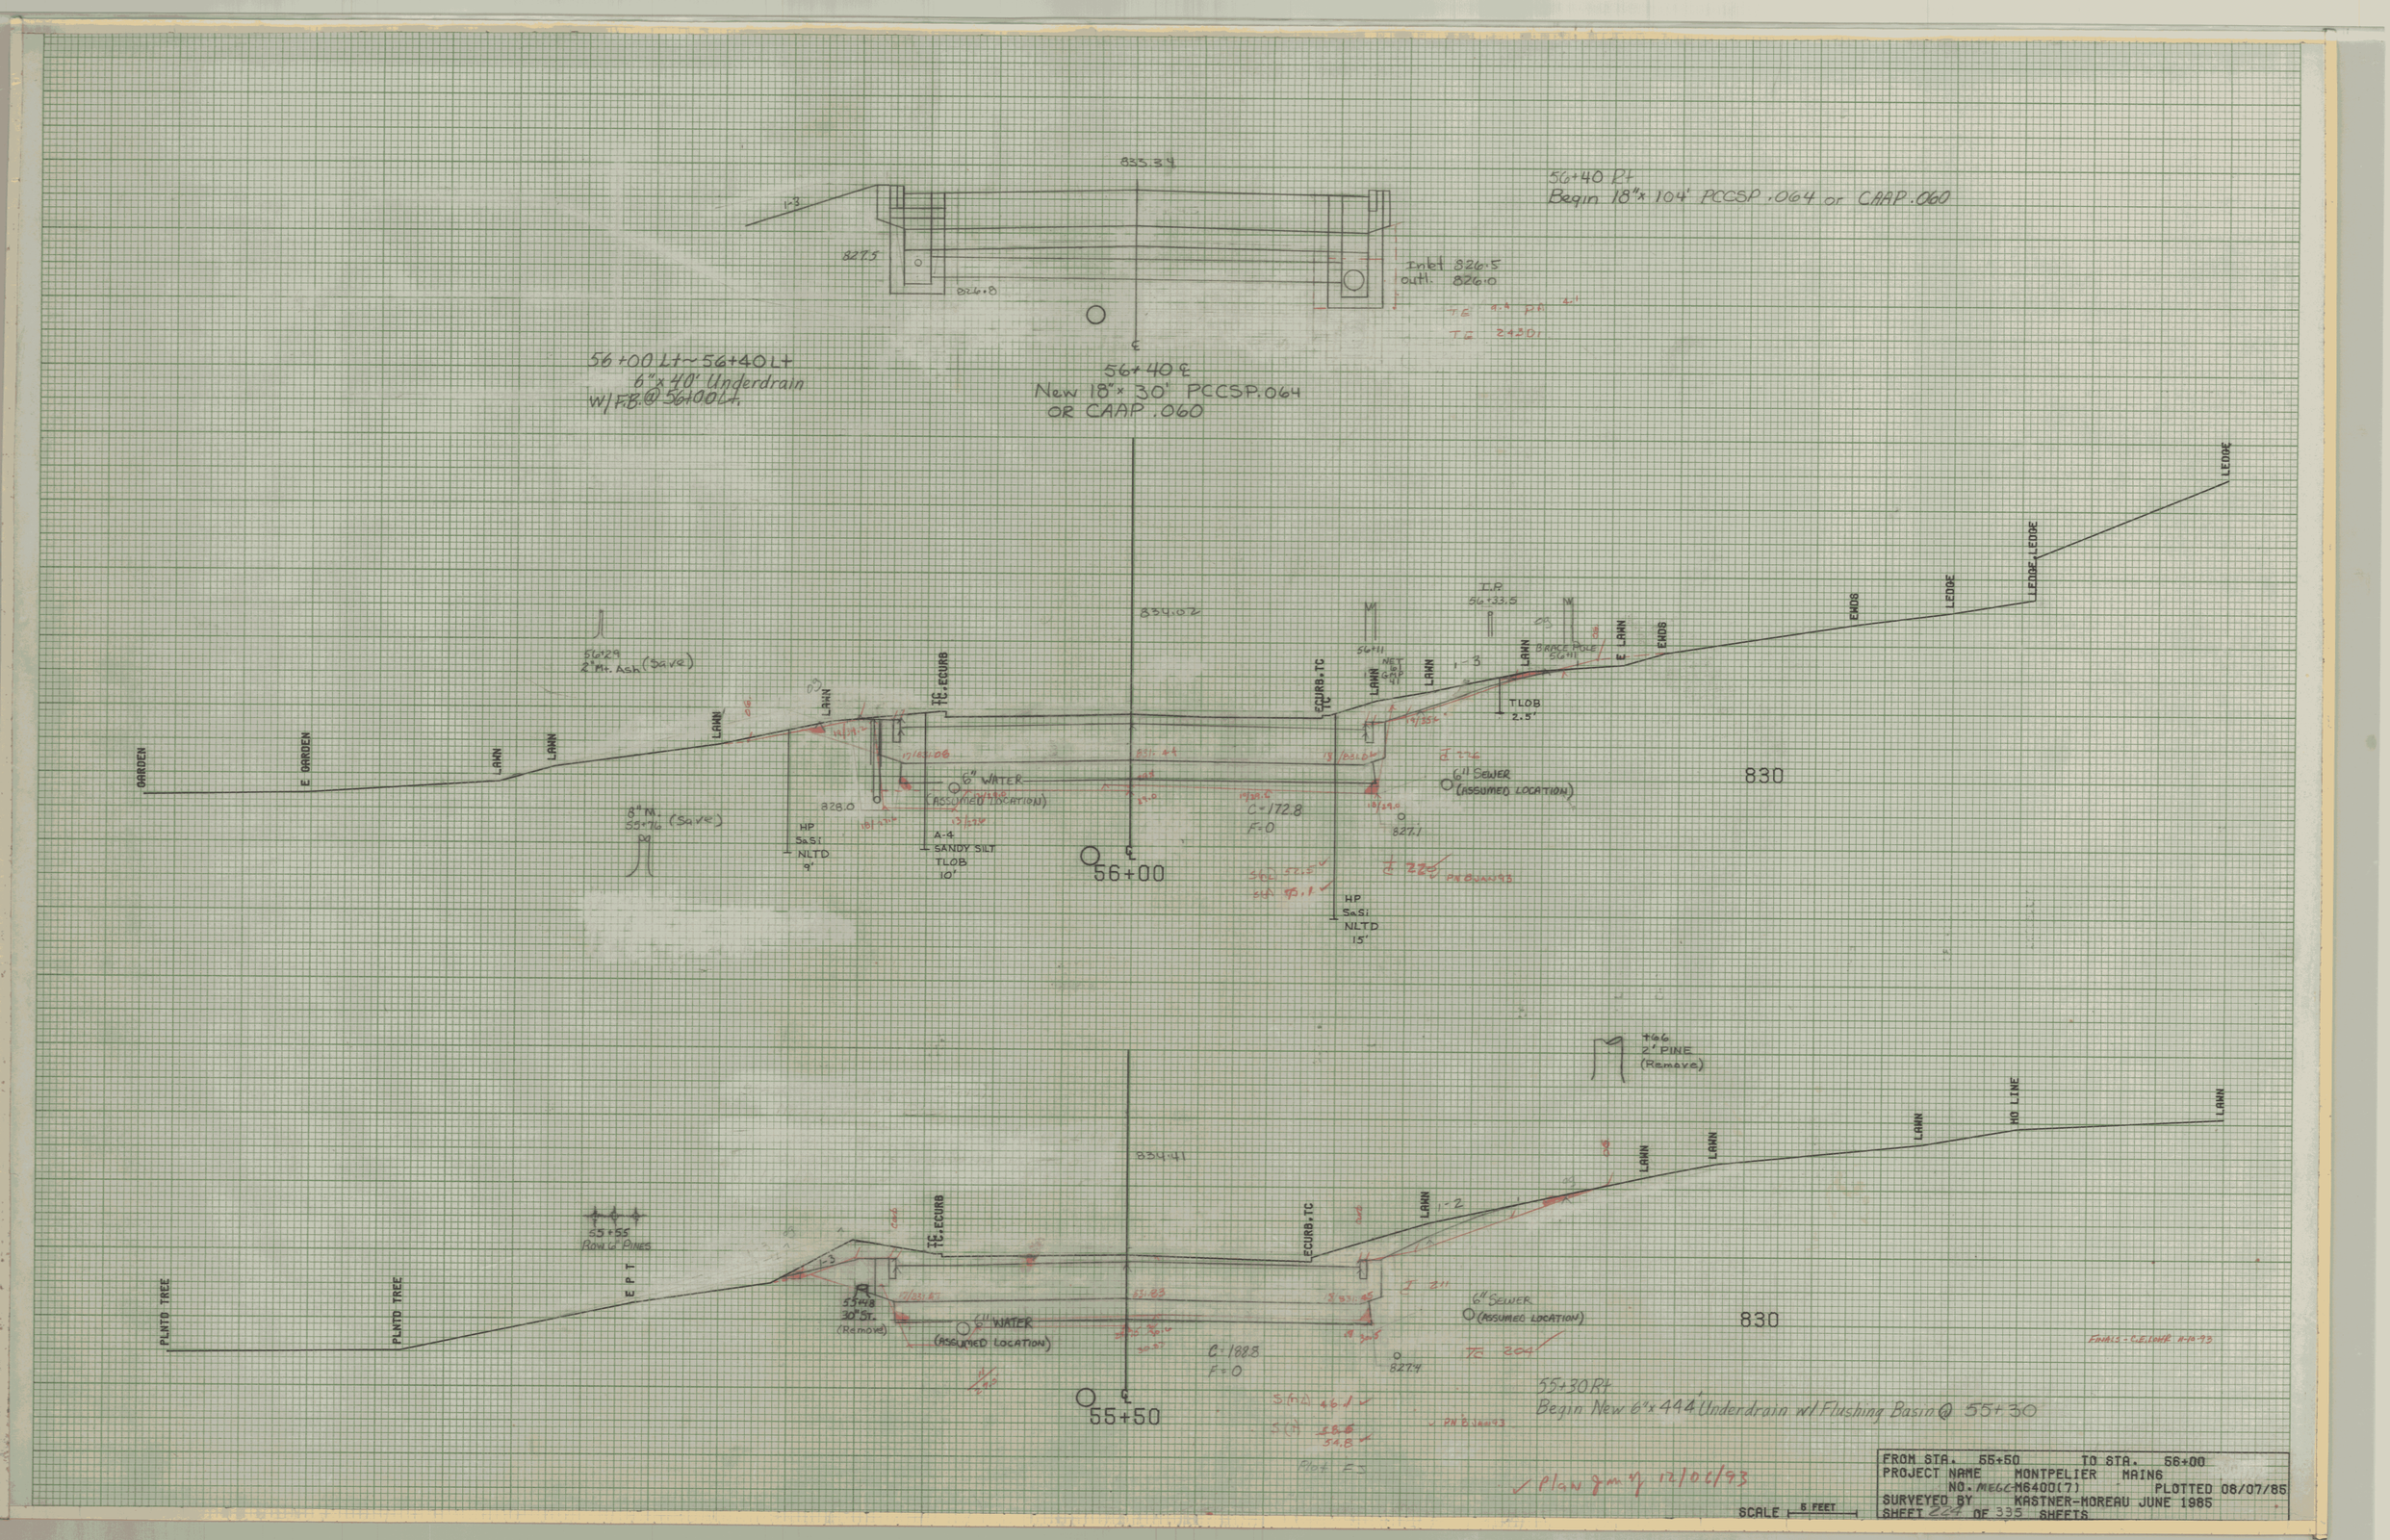
56+40 Pt
Begin 18"x 104' PCCSP .064 or CAAP .060
835.34
1-3
827.5
826.8
Inlet 826.5
outl. 826.0
56+00 Lt ~ 56+40 Lt
6"x 40' Underdrain
w/ FB @ 56+00 Lt.
56+40 ℄
New 18"x 30' PCCSP.064
OR CAAP .060
834.02
56+29
2" Mt. Ash (Save)
8" M.
55+74 (Save)
TC
ECURB
ECURB
TC
LAWN
LAWN
LAWN
LAWN
LAWN
LAWN
LAWN
E. LAWN
EXDS
EXDS
LEDGE
LEDGE
LEDGE
LEDGE
GARDEN
E. GARDEN
C.R.
56+33.5
56+11
NET
25'
BRACE POLE
56+11
TLOB
2.5'
6" WATER
(ASSUMED LOCATION)
328.0
HP
5aSi
NLTD
9'
A-4
SANDY SILT
TLOB
10'
56+00
C=172.8
F=0
827.1
6" SEWER
(ASSUMED LOCATION)
830
HP
5aSi
NLTD
15'
PM 8 Jan 93
834.41
55+55
Row of Pines
PLNTD TREE
PLNTD TREE
E. P. T.
55+48
30" ST.
(Remove)
6" WATER
(ASSUMED LOCATION)
C=188.8
F=0
827.4
6" SEWER
(ASSUMED LOCATION)
830
+66
2" PINE
(Remove)
HO LINE
55+30 Rt
Begin New 6"x 44' Underdrain w/ Flushing Basin @ 55+30
Plan gm 11/01/93
FROM STA. 55+50 TO STA. 56+00
PROJECT NAME MONTPELIER MAINS
NO. MEGC-M6400(7) PLOTTED 08/07/85
SURVEYED BY KASTNER-MOREAU JUNE 1985
SHEET 225 OF 335 SHEETS
SCALE 5 FEET

57+00
End Vertical Granite Curb

BARN · EOR · EOR · LAWN · EOR · E-E · EECURB.TC · LAWN · LAWN · LAWN · LAWN · LAWN · EHOS

@ 56+95 · LEDGE 0.5' · 6" WATER (ASSUMED LOC.) · 6" Sewer (Assumed Location)

A-4 SANDY SILT NLTD 10'

C = 176.6
F = 0

833.67 · 830 · 824 · 824.6

57+00 ℄

56+70 Lt
Begin Vertical Granite Curb

832.81

SECTION "AA"

℄ · 6' · 6' · 1-6 · 12" Bituminous Concrete Pavement · 12" SUBBASE · 830

A ← · LAWN · LAWN · EOR · DR · E-E · A ←

56+62 Lt
CONSTRUCT DRIVE (12' WIDE, PAVED)

56+62 ℄

830

LAWN · LAWN · LAWN · LAWN · LAWN · EOR · E-E · ECURB.TC · LAWN · EHOS

833.11

6" WATER (ASSUMED LOCATION) · 6" SEWER (ASSUMED LOC.)

C = 166.3
F = 0

826.2

830

56+53 Lt
End Vertical Granite Curb

56+50 ℄

56+50 £
Begin Drilling and Blasting of Solid Rock Subgrade

FINALS - CA. 1 CHG 11-10-93

✓ plan jmy 12/06/93

SCALE 1" = 5 FEET

FROM STA.	56+50 TO STA. 57+00
PROJECT NAME	MONTPELIER MAIN7
NO.	M6400(7) PLOTTED 08/07/85
SURVEYED BY	KASTNER-MOREAU JUNE 1985
SHEET	OF 335 SHEETS

57+79
4" Bush
(Remove)

828.56

ECURB.TC

LAWN

1-2

LAWN

LAWN

CONC WLK

C H

HOUSE

825

822.0

821.5

℄ 57+75

829.70

PORCH

LAWN

TC.ECURB

ECURB.TC

LAWN

1-2

LAWN

LAWN

LAWN

H LINE

825

822.3

822.7

℄ 57+50

C=147.9
F=0

S = 48.9 ✓
S = 6.27 ✓

✓ PN & JAN 93

829.87

57+13 Lt
Begin Vertical
Granite Curb

823.3 Int.
823.50 Outl.

823.0

57+46 Rt
End New 18"x 104' PCCSP.064 or CAAP.060
Begin New 18"x 232' PCCSP.064 or CAAP.060

℄ 57+46

851.39

New 18" x 30' PCCSP
or CAAP .060

A

LAWN

EDR

DR

DR
E-E

ECURB.ITC

LEDGE.LEDGE

1-2

LEDGE
E LEDGE

LAWN

830

A

57+08 Lt
CONSTRUCT DRIVE (12' WIDE PAVED)

℄ 57+08

823.7

824.4

Plot At

Plan Comp 12/06/93

SCALE 5 FEET

FROM STA. 57+08 TO STA. 57+75
PROJECT NAME MONTPELIER MAIN7
NO. M6400(7) PLOTTED 08/07/85
SURVEYED BY KASTNER-MOREAU JUNE 1985
SHEET 226 OF 339 SHEETS

SECTION "AA"

1-6

6'


6'

1-6

12" SUBBASE


℄

58+67 Lt. Evergreen Tree
4' to 5' Colorado Blue Spruce
Tree to be planted outside of the R.O.W limits in a location which is mutually agreeable with the property owner and the resident engineer.

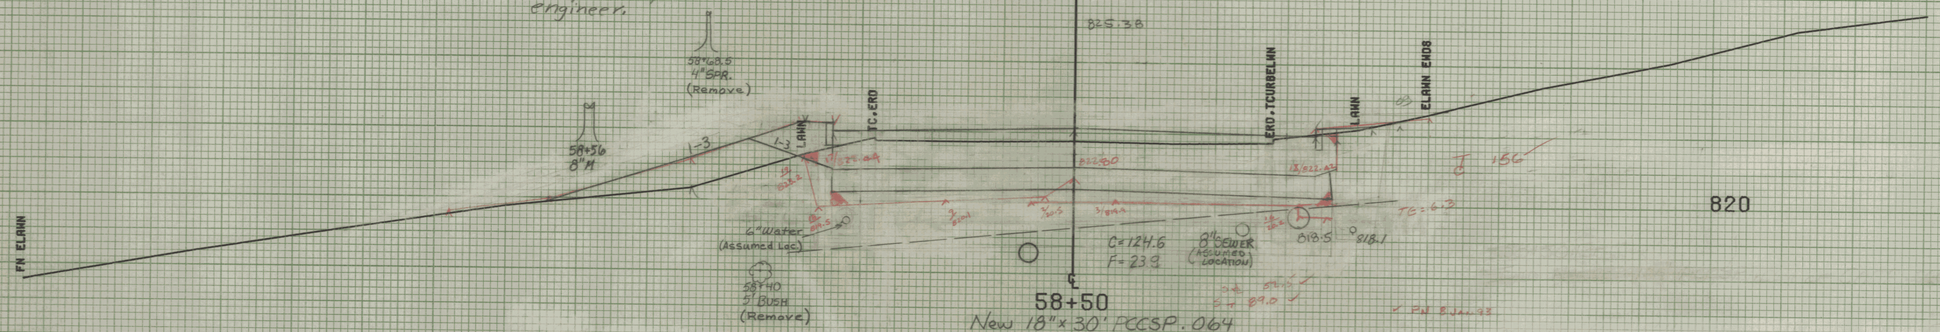


New 18"x30' FCCSP.064
OR CAAP.060


58+20 Lt and 58+40 Lt
Transplanting Trees
(Est 5 @ 58+20 and Est. 5 @ 58+40)
Transplants to be located along Southerly property line, 50±50 ±)

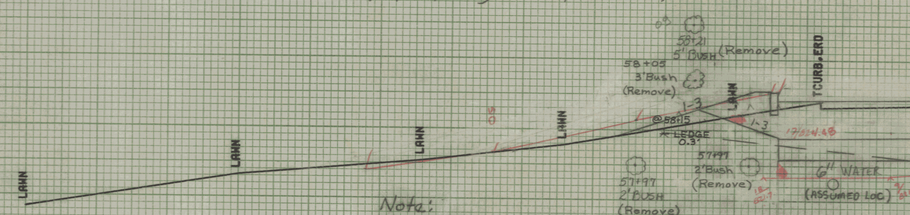


Note:
The portion of the stone wall at 58+00 Lt which is within the city's R.O.W. Limits will be removed and the stone will be stockpiled at a location which is mutually agreeable with the property owner and the Engineer. Costs for removal and any necessary repair of the wall will be paid under Item 602.20 (Mod), Dry Rubble Masonry. These costs will be non-government Participating.

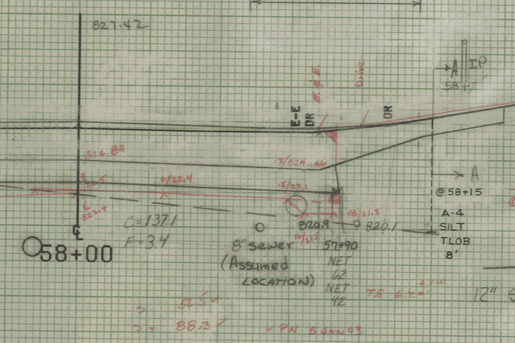

58+10 Rt
Begin Vertical Granite Curb

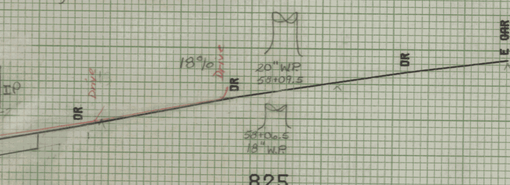

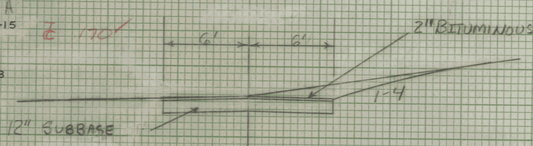

58+00 Rt
Construct Drive
(12' Wide, Paved)

825

57+93 Rt
End Vertical Granite Curb


57+88 Rt
Exist. Sewer Manhole - Retain
Adjust Elev. of Manhole
Non-Govt. Part

57+85 Rt
Relocate Mailbox, Single Support (1)

Note:
Fieldstone Removed From Wall @ Sta 57+93 Rt Is To Be Stockpiled At A Location Specified By The Engineer. Payment For Removal Of The Fieldstone, And/Or Repair To The Stone Wall, Will Be Under Item 602.20, Dry Rubble Masonry And Shall Be Non-Gov't. Participating.

FROM STA.	57+89.50 TO STA. 58+50
PROJECT NAME	MONTPELIER MAIN7
NO. MEGC	M6400(7) PLOTTED 08/07/85
SURVEYED BY	KASTNER-MOREAU JUNE 1985
SHEET 22	OF 335 SHEETS

SCALE 5 FEET

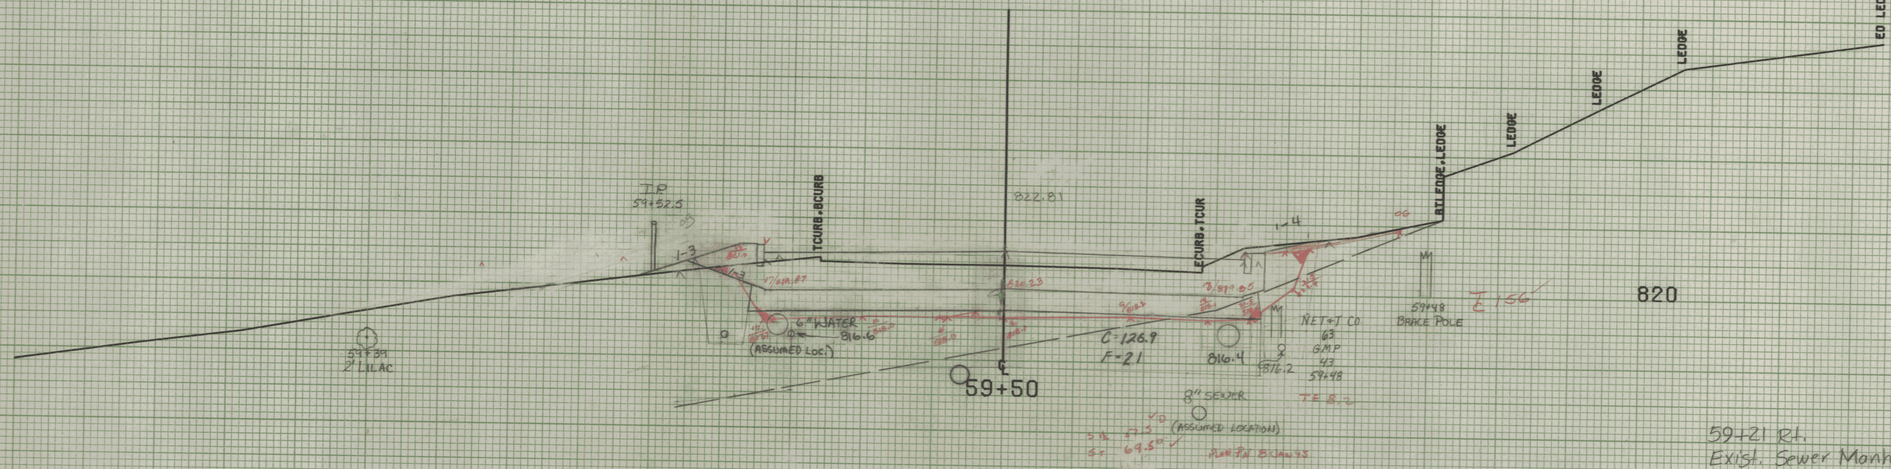


58+25 Lt. Remove and Reset Yard Light
The light shall be relocated outside of the City's R.O.W. limits at a location mutually agreeable with the resident engineer and the property owner. The cost of the work and necessary materials shall be paid as Item 679.25 (mod) Removing and Resetting Light Pole and Shall be Non-Govt. Participating.

59+35
4" SPR.

59+28.5
WISHING WELL


5' Bush
59+27.5

59+30 Lt
Begin New 6"x50' Underdrain
w/ F.B. @ 59+30 Lt.

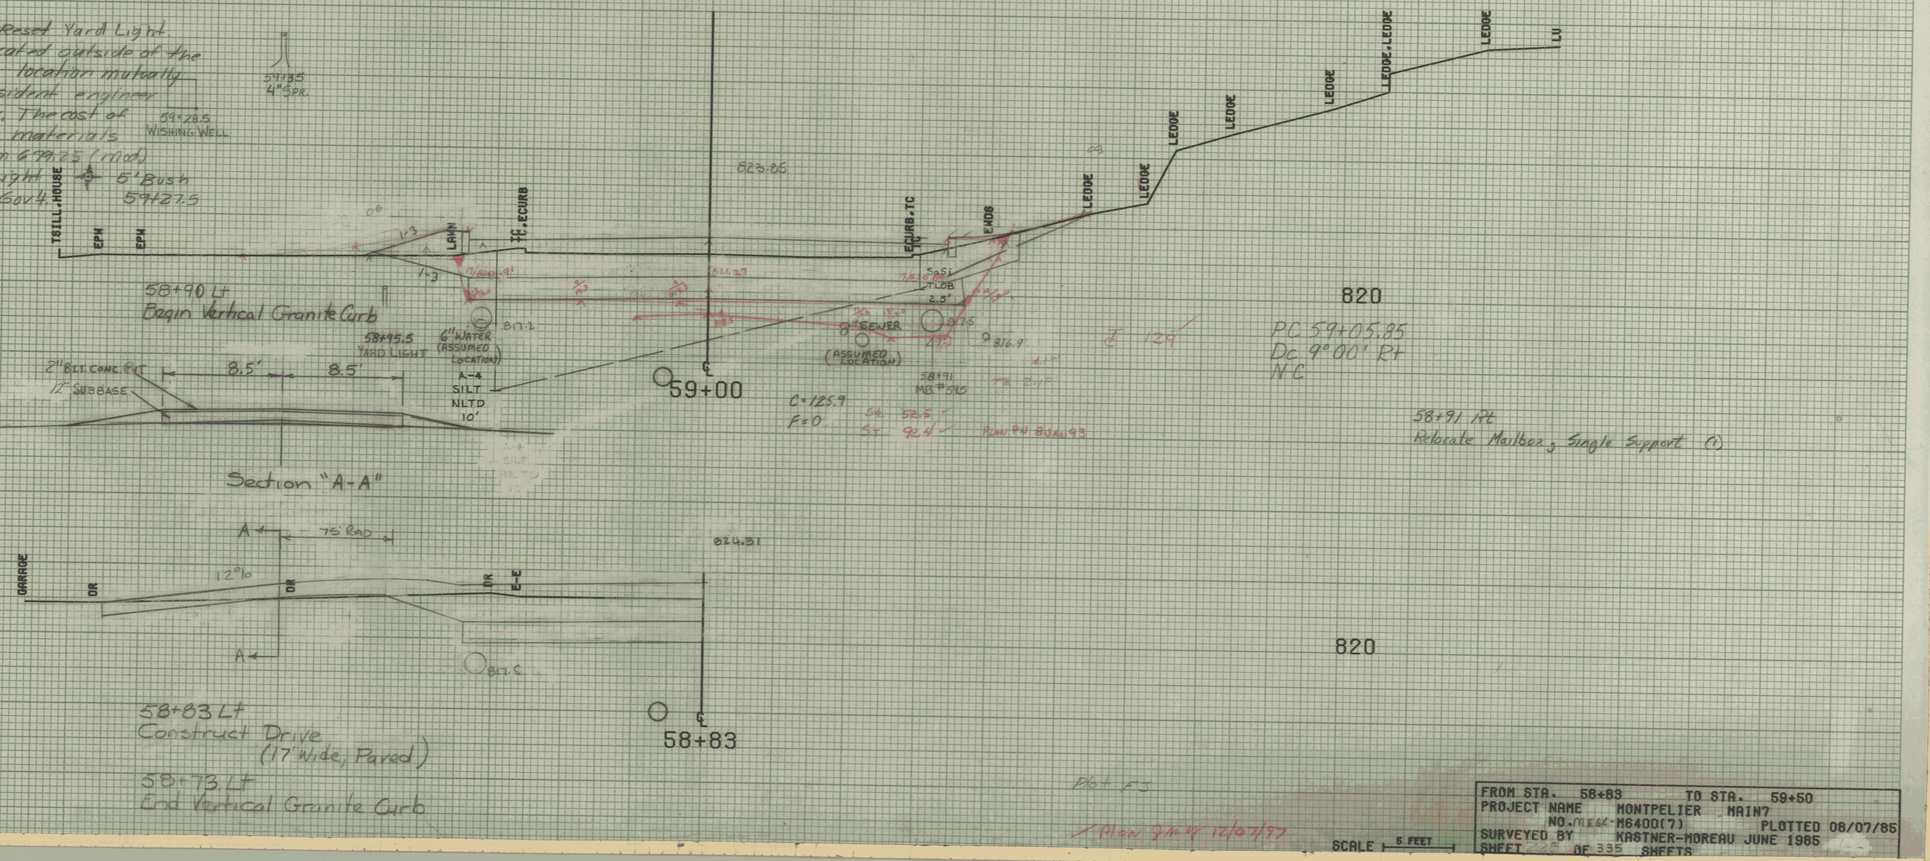

FROM STA.	58+83 TO STA. 59+50
PROJECT NAME	MONTPELIER MAIN7
NO.	MEGC-M6400(7) PLOTTED 08/07/85
SURVEYED BY	KASTNER-MOREAU JUNE 1985
SHEET	OF 335 SHEETS

SCALE 5 FEET

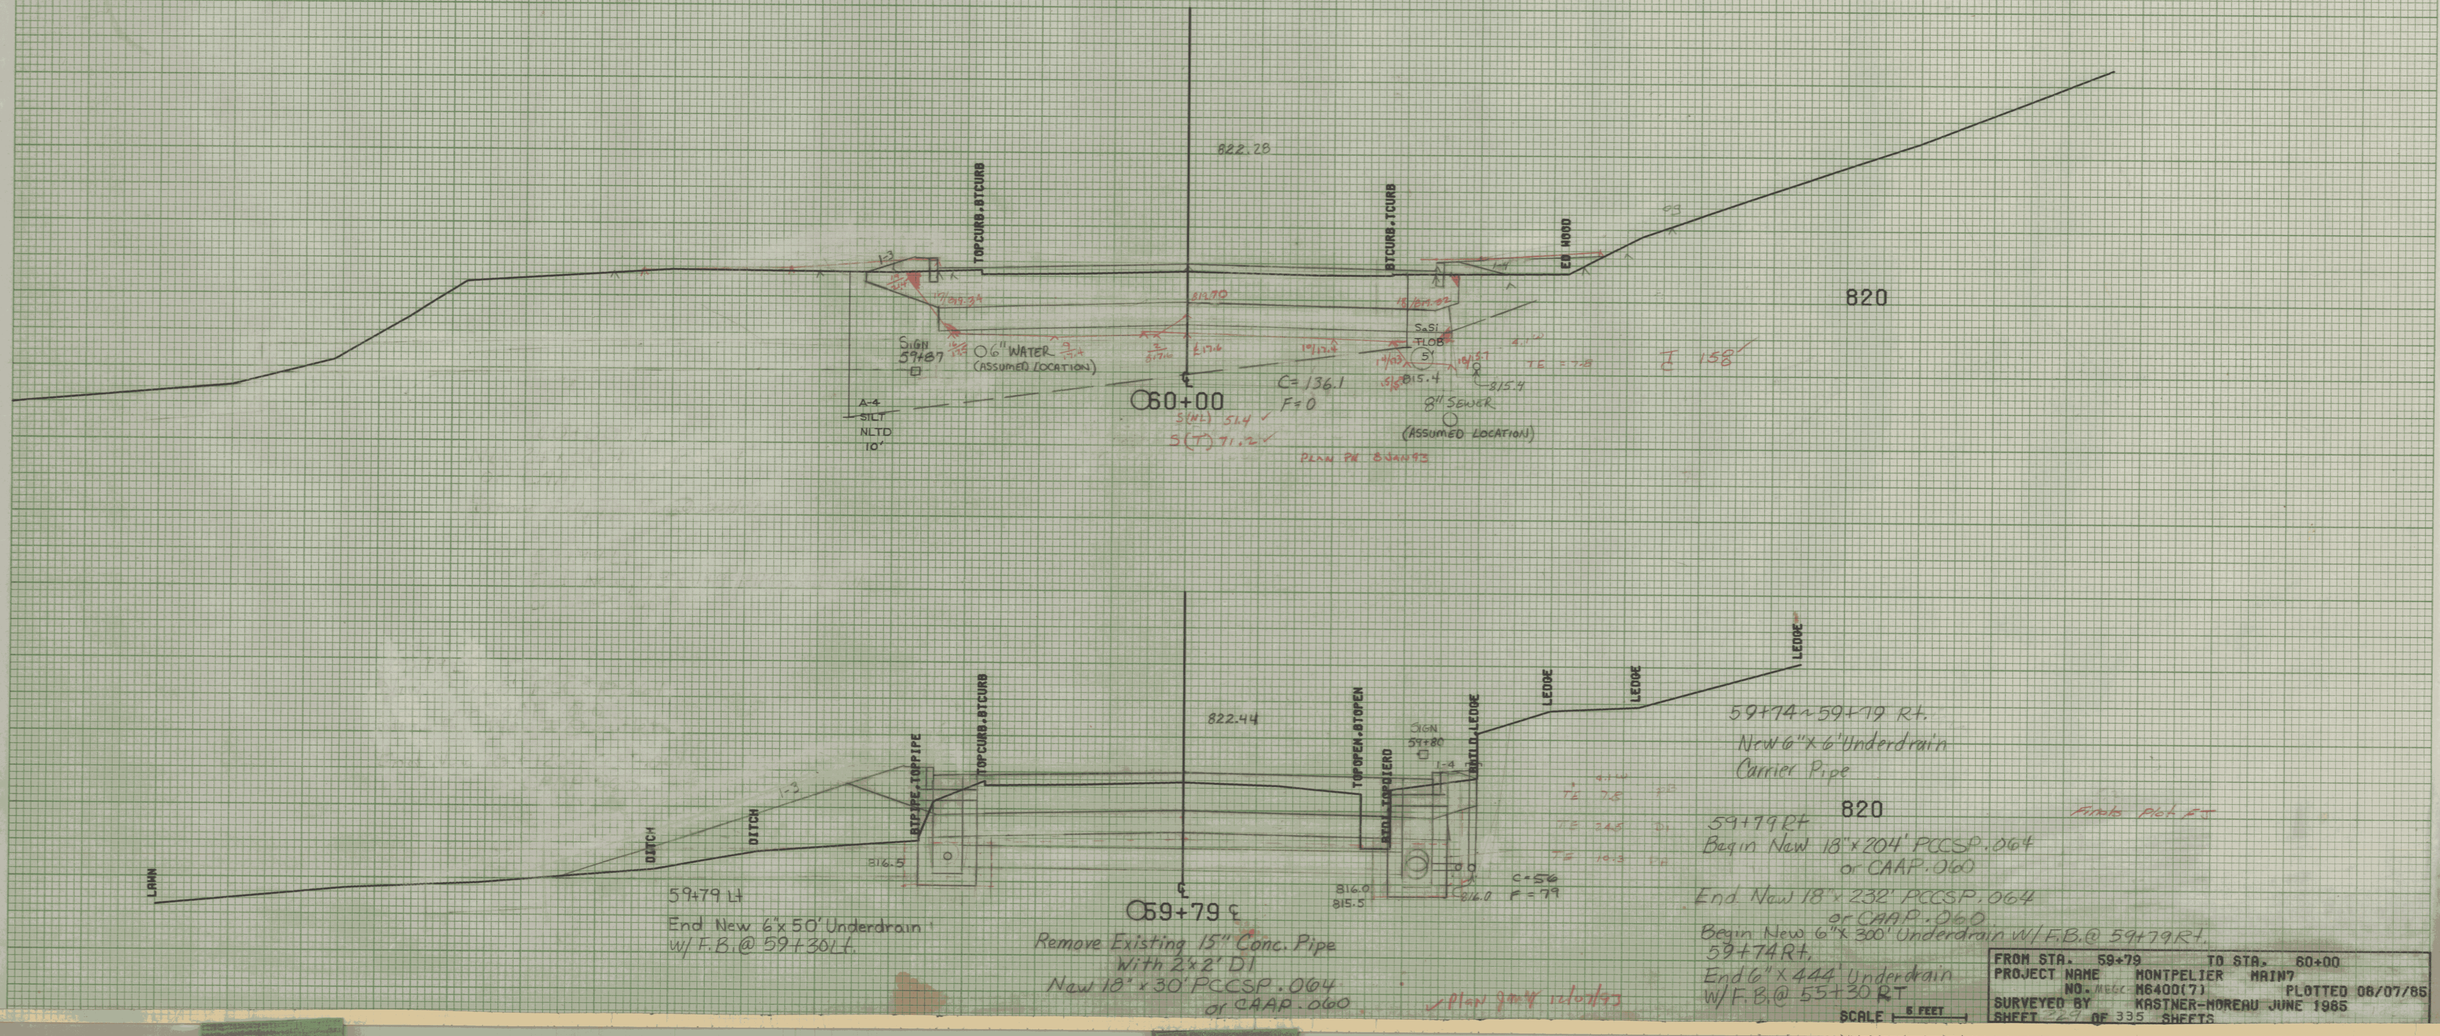
822.28
TOPCURB-BTCURB
BTCURB-TCURB
ED HOOD
820
SIGN 57+87
06" WATER
(ASSUMED LOCATION)
A-4 SILT NLTD 10'
60+00
C=136.1
F=0
S(M)=5.4
S(T)=7.2
PLAN PVT BY MAINE
SaSI TLOB 5'
815.4
8" SEWER
(ASSUMED LOCATION)
822.44
LEDGE
SIGN 59+80
STRIPE-TOPPIPE
DITCH
LAWN
816.5
59+79 ℄
816.0
815.5
C=56
F=79
59+79 Lt
End New 6"x 50' Underdrain
w/ F.B. @ 59+30 Lt.
Remove Existing 15" Conc. Pipe
With 2'x2' DI
New 18"x 30' PCCSP. 064
or CAAP. 060
59+74 ~ 59+79 Rt.
New 6"x 6" Underdrain
Carrier Pipe
59+79 RT
Begin New 18"x 204' PCCSP. 064
or CAAP. 060
End New 18"x 232' PCCSP. 064
or CAAP. 060
Begin New 6"x 300' Underdrain w/ F.B. @ 59+79 RT.
59+74 Rt.
End 6"x 444' Underdrain
w/ F.B. @ 55+30 RT
SCALE 5 FEET
FROM STA. 59+79 TO STA. 60+00
PROJECT NAME MONTPELIER MAIN7
NO. M6400(7) PLOTTED 08/07/85
SURVEYED BY KASTNER-MOREAU JUNE 1985
SHEET 229 OF 335 SHEETS

821.22

61+85 ℄

New 18"x 30' PCCSP .064


or CAAP.060

61+77 Rt
MB


61+97 Rt
Relocate Mailbox, Single Support (1)

61+85 Rt
Begin New 18"x 46' PCCSP.064
or CAAP.060
End New 18" X 204' PCCSP(.064)
or CAAP(.060)

Inlet invert. - 814.6 OR CAAP(.060)
OUTLET INVERT-814.3

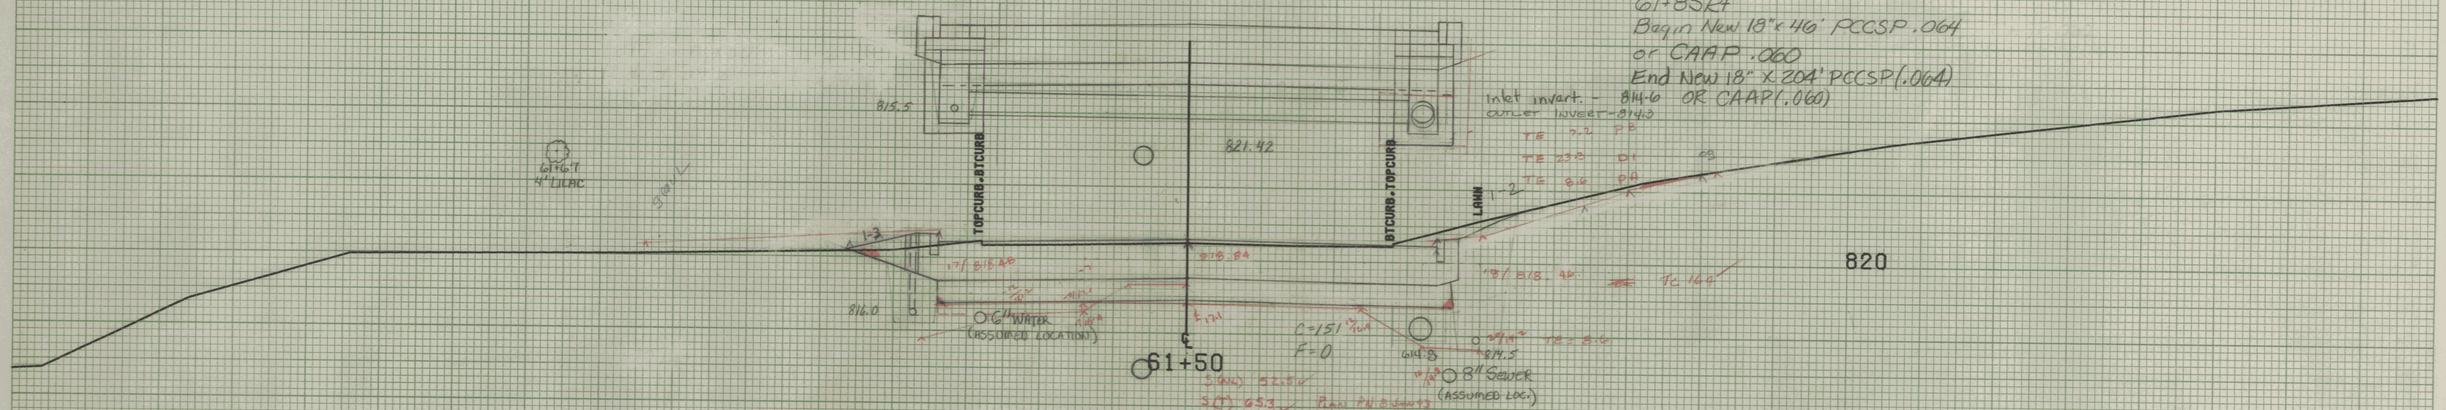

61+35 Lt ~ 61+85 Lt
New 6"x 50' Underdrain
w/ F.B. @ 61+35 Lt.

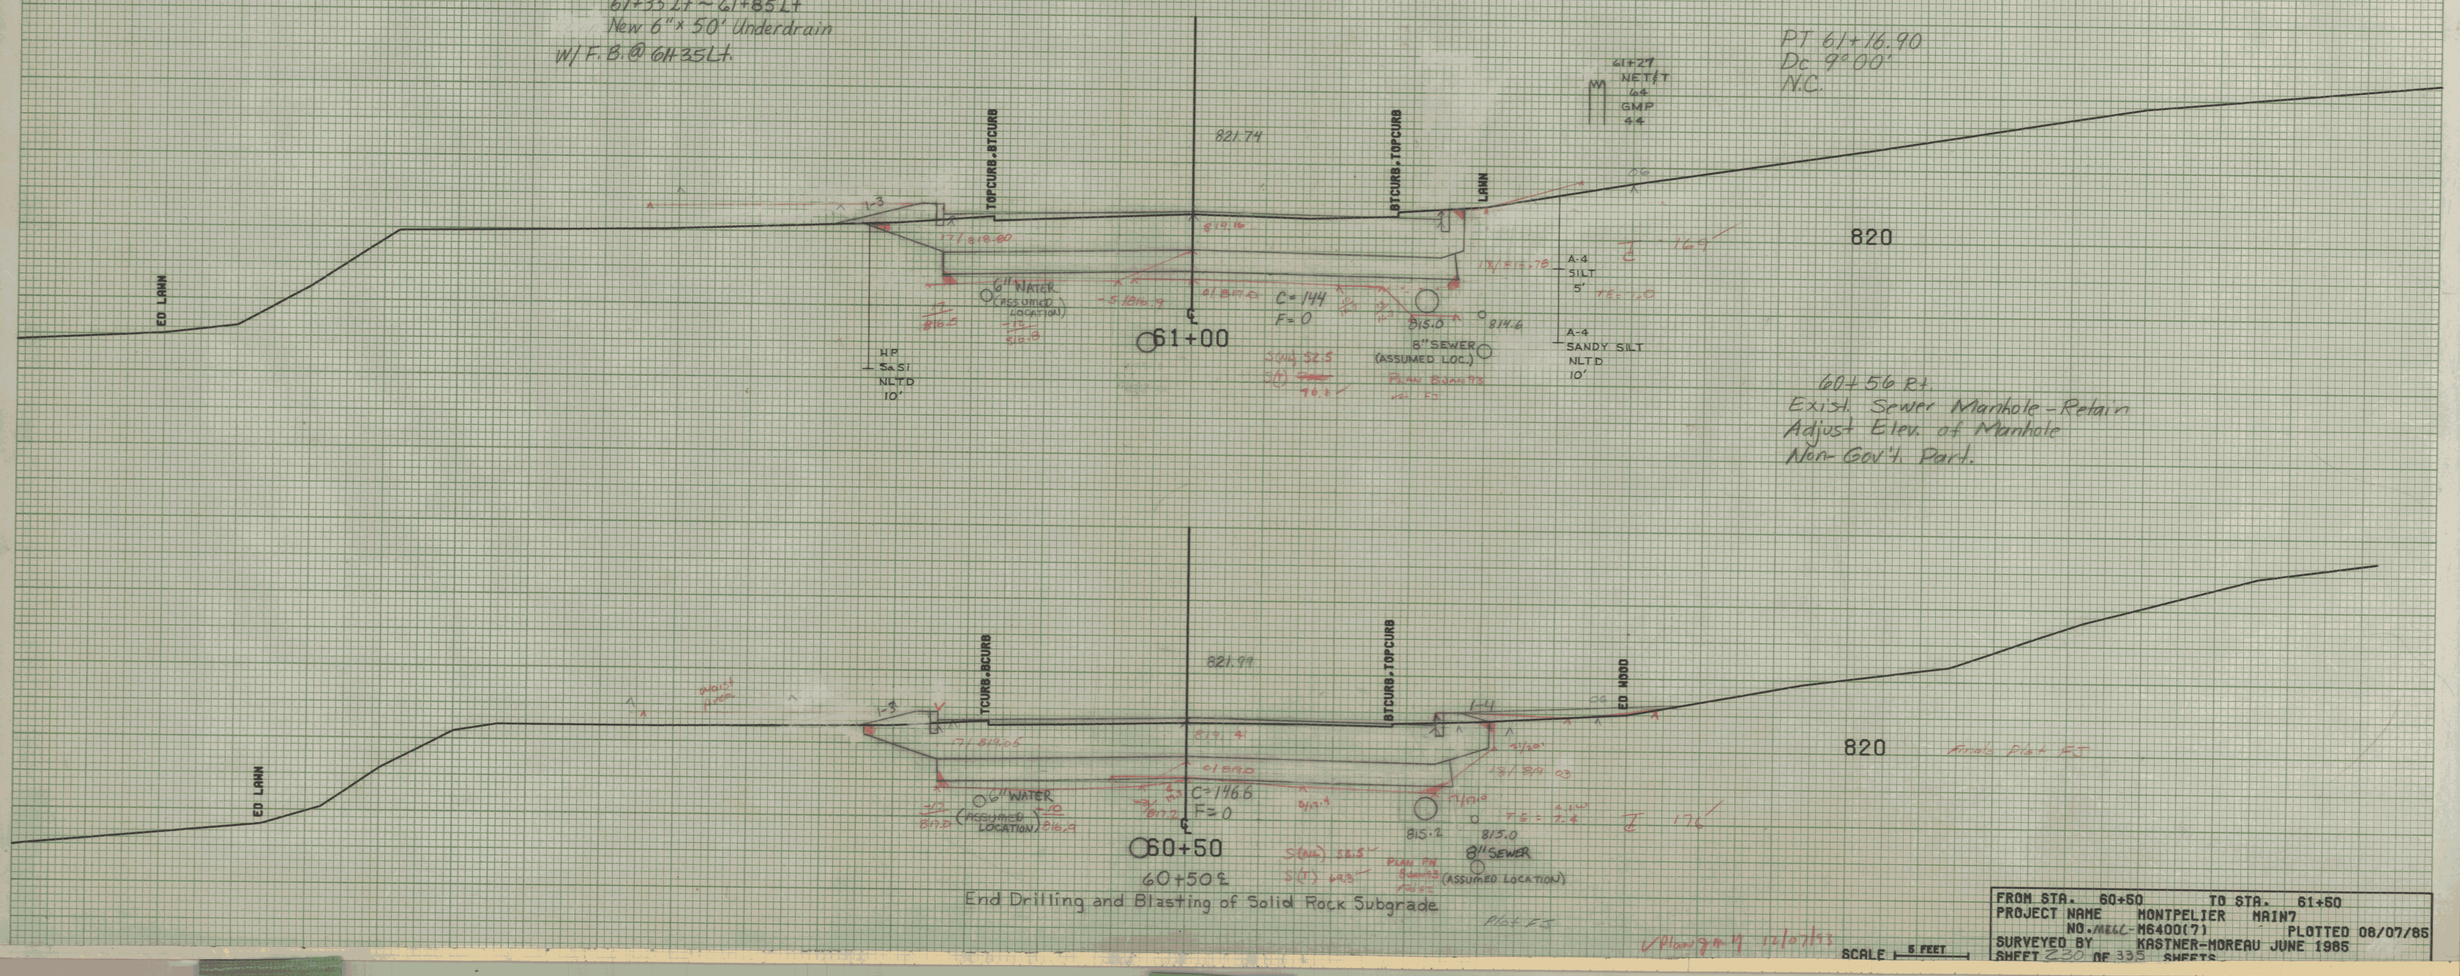

PT 61+16.90
Dc 9°00'
N.C.


60+56 Rt
Exist. Sewer Manhole - Retain
Adjust Elev. of Manhole
Non-Gov't Parl.

60+50 ℄
End Drilling and Blasting of Solid Rock Subgrade

FROM STA. 60+50	TO STA. 61+50
PROJECT NAME	MONTPELIER MAIN7
NO. MELC-M6400(7)	PLOTTED 08/07/85
SURVEYED BY	KASTNER-MOREAU JUNE 1985
SHEET 230 OF 335	SHEETS

SCALE 5 FEET

820.96

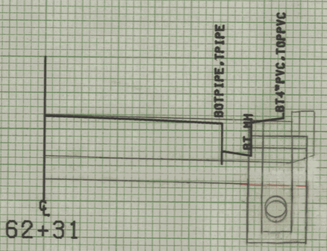

62+31 ℄

62+31 Rt.
Begin Vertical Granite Curb


820

End New 18"x 46" RCCSP. 064
or CAAP. 060
Begin New 18"x 56' RCCSP. 064
or CAAP. 060
Connect Existing 4" PVC Underdrain
to New Drop Inlet


62+40 Lt. Removing and Resetting Yard Light
The light shall be relocated outside the City's R.O.W. Limits at a location mutually agreeable with the resident engineer and the property owner. The cost of work and necessary materials shall be paid as Item 679.25(MOD) Removing and Resetting Light Pole and shall be Non-Gov't. Participating.

+22
2" APPLE
(Save)

62+06
Begin Vertical Granite Curb

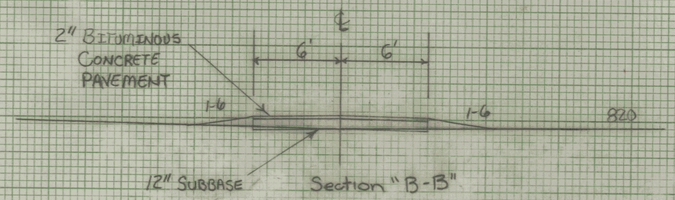

Section "B-B"

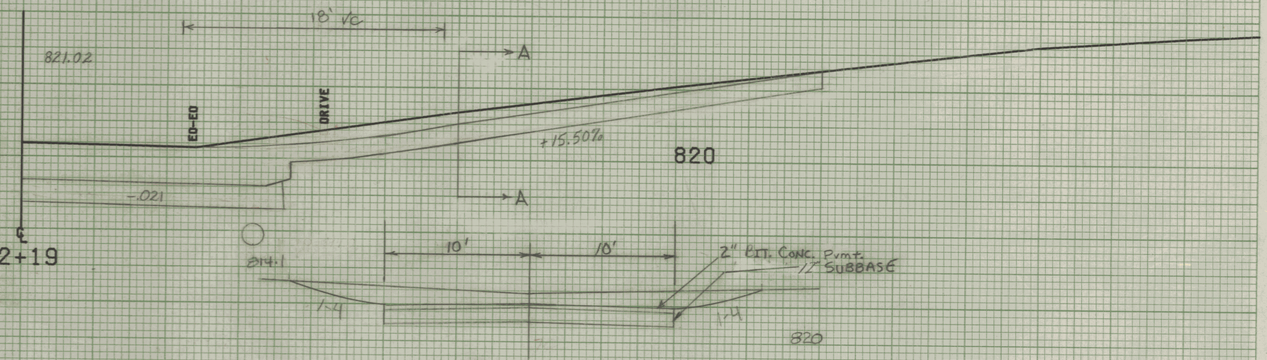

Section "A-A"

62+19 Rt.
CONSTRUCT DRIVE 20' WIDE (PAVED)

62+11 Rt
End Vertical Granite Curb

62+00 Lt.
CONSTRUCT DRIVE 12' WIDE (PAVED)


Plot FE

FROM STA. 62+00 TO STA. 62+31
PROJECT NAME MONTPELIER MAIN7
NO. MEEC-M6400(7) PLOTTED 08/07/85
SURVEYED BY KASTNER-MOREAU JUNE 1985
SHEET 231 OF 335 SHEETS

SCALE 5 FEET

63+39 Rt
Construct 16' Gravel Drive

63+31 Rt
End Vertical Granite Curb

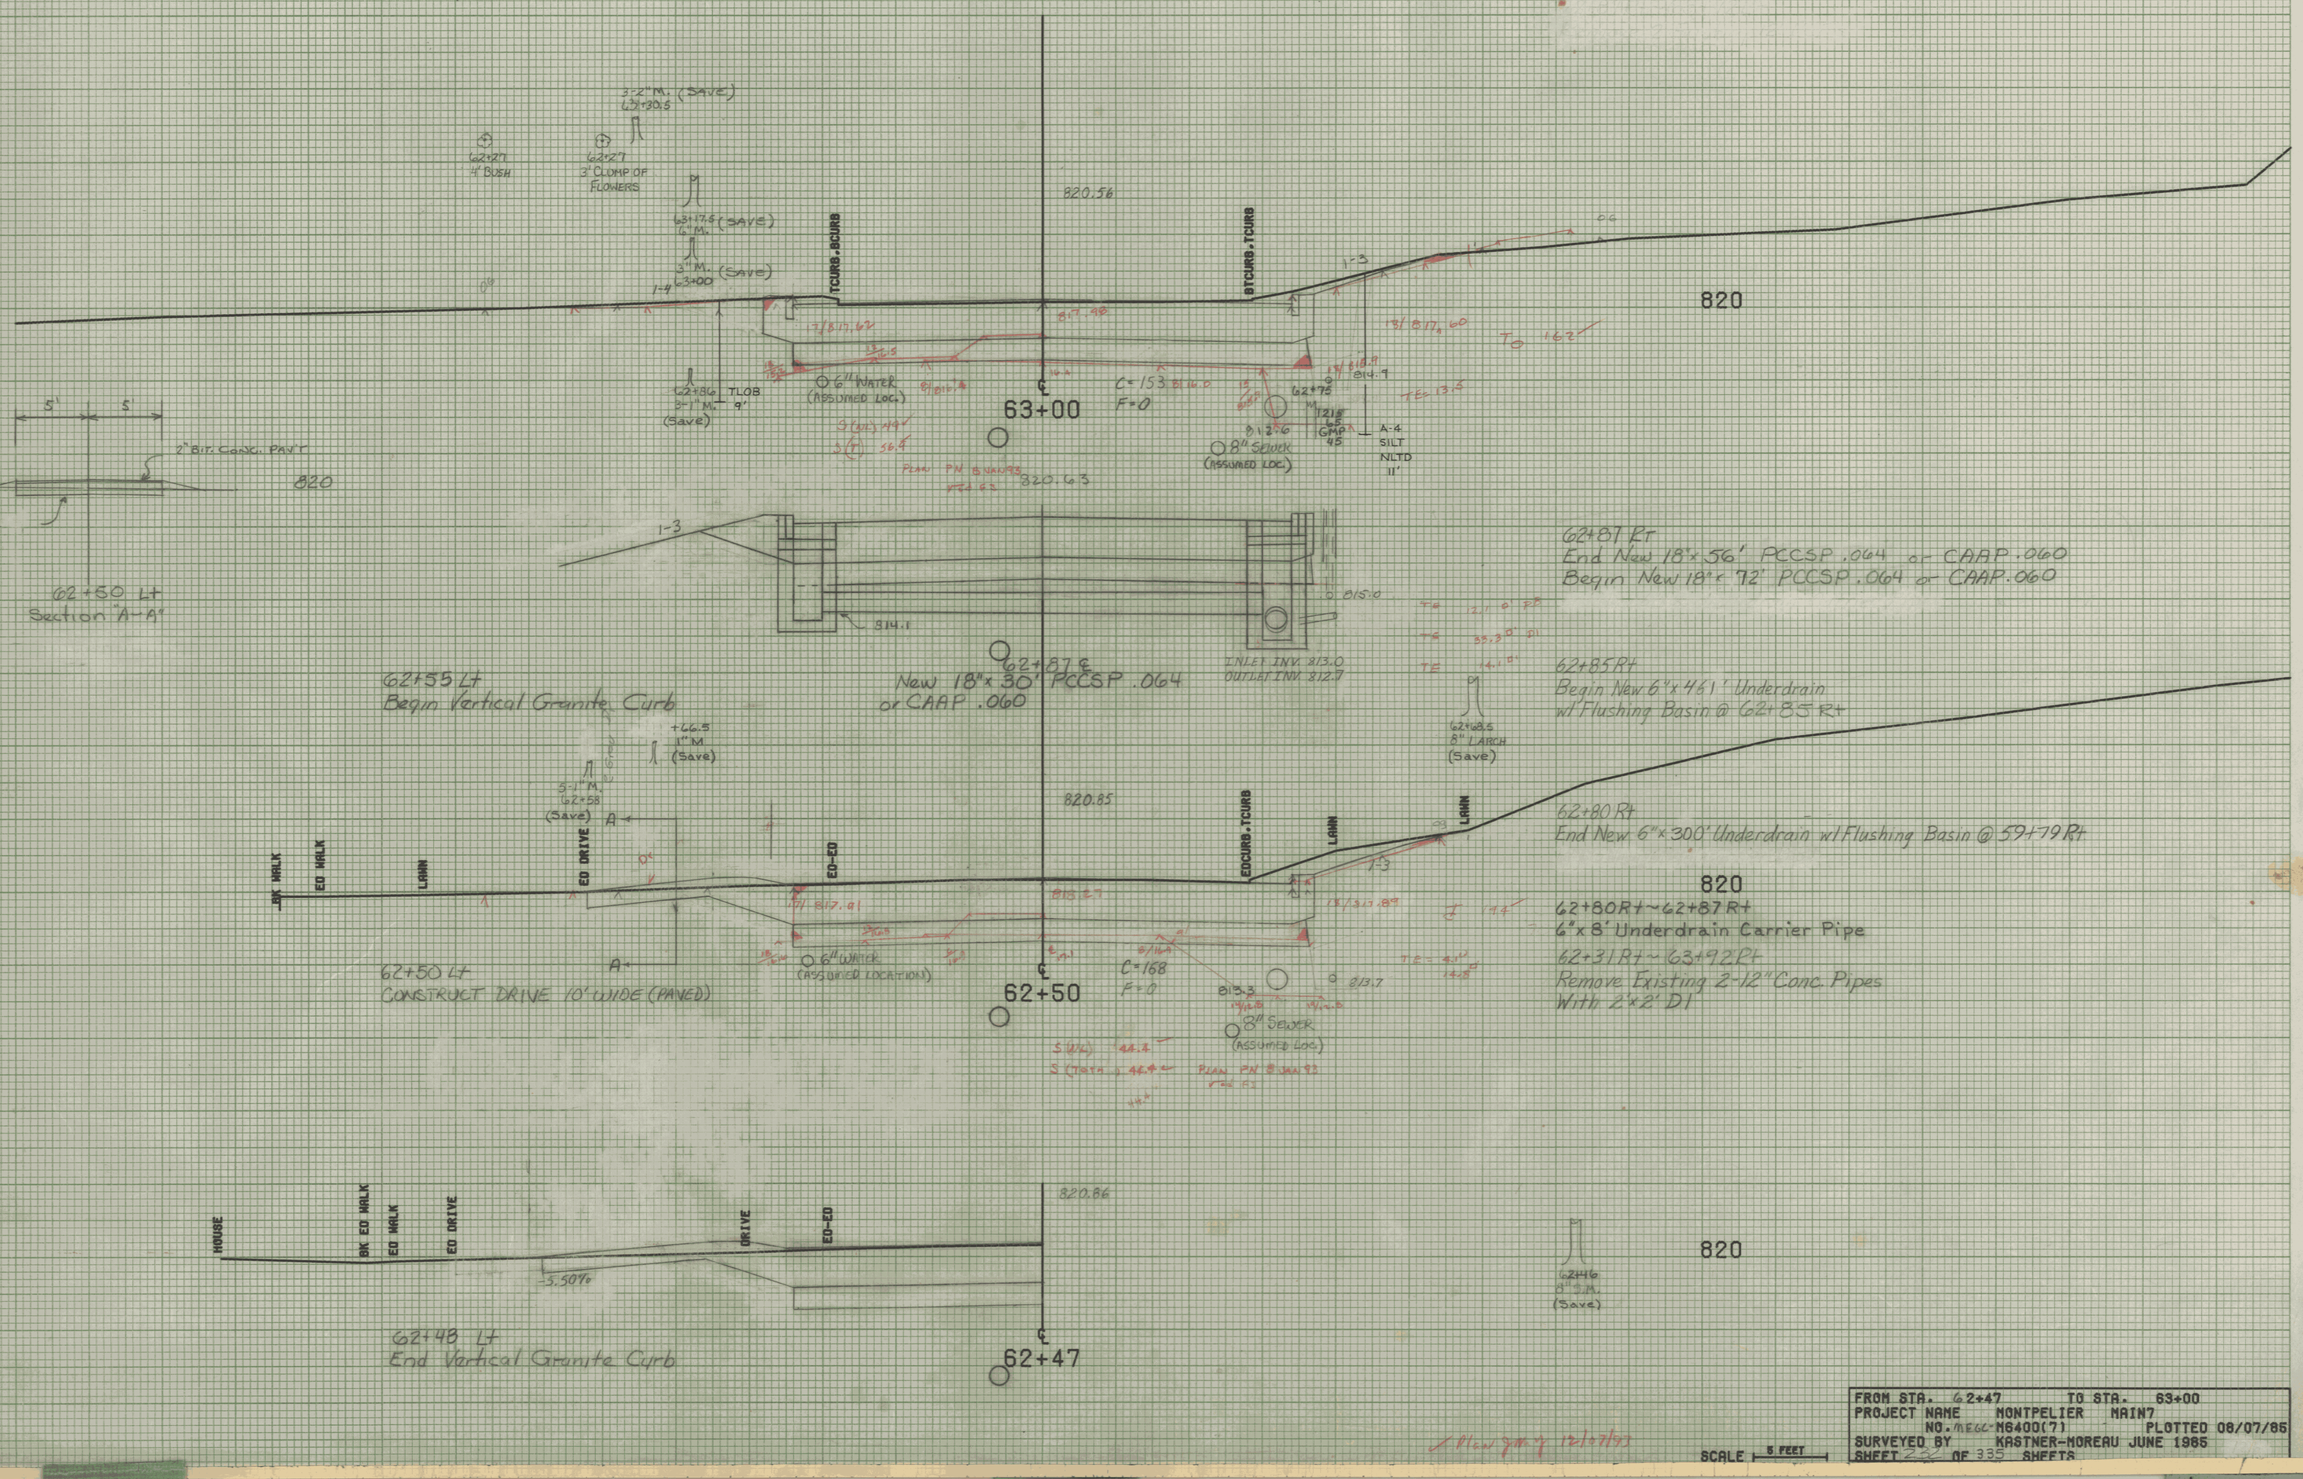



62+81 Rt
End New 18"x 56' PCCSP .064 or CAAP .060
Begin New 18"x 72' PCCSP .064 or CAAP .060

FROM STA. 62+47 TO STA. 63+00
PROJECT NAME MONTPELIER MAIN7
NO. MEGC-M6400(7) PLOTTED 08/07/85
SURVEYED BY KASTNER-MOREAU JUNE 1985
SHEET 22 OF 335 SHEETS

SCALE 5 FEET


Rav 63+90 Lt
Construct Paved Walk (3' Wide)
To Be Paid as Bit. Conc. Sidewalk

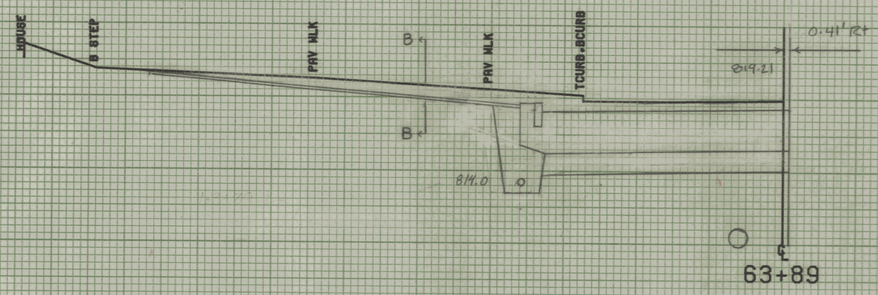

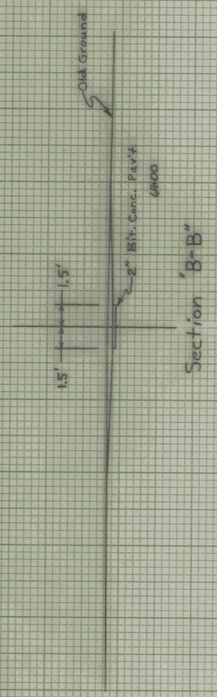


Rav. 63+86 Rt.
Begin Vertical Granite Curb

815

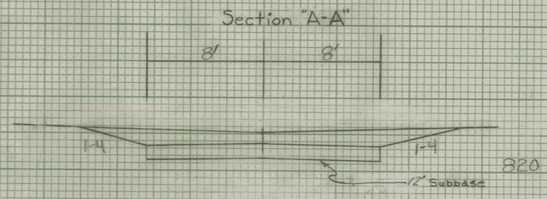

Rav. 63+76 Rt
CONSTRUCT DRIVE 16' WIDE (GRAVEL)

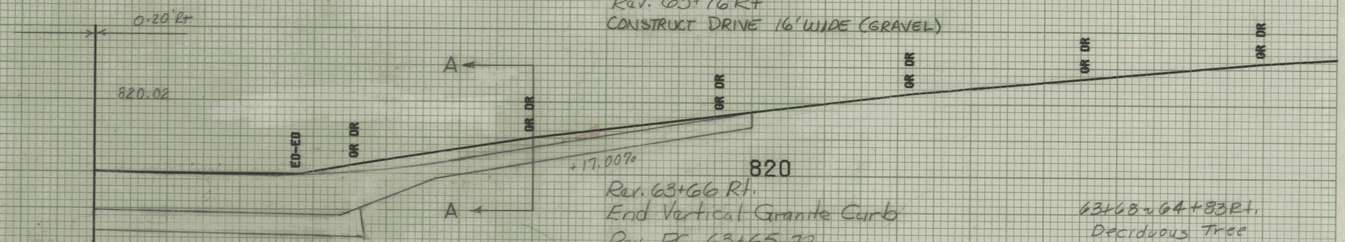


820


Rav. 63+66 Rt.
End Vertical Granite Curb
Rav. PC. 63+65.72
Dc = 12° 18' 00"
No BANKING

63+60 Rt
End New 18"x72' PCCSP.064
or CAAP.060
Begin New 18"x122' PCCSP.064
or CAAP.060
Connect Existing 8" Plastic Drain Pipe
To Drop Inlet @ 63+60 Rt

63+68 - 64+83 Rt.
Deciduous Tree
1½" to 2" Flowering
Dogwood

Tree to be planted out side of R.O.W. in a location which is mutually agreeable with the property owner and the resident engineer.

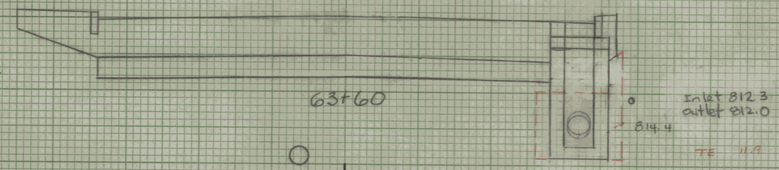

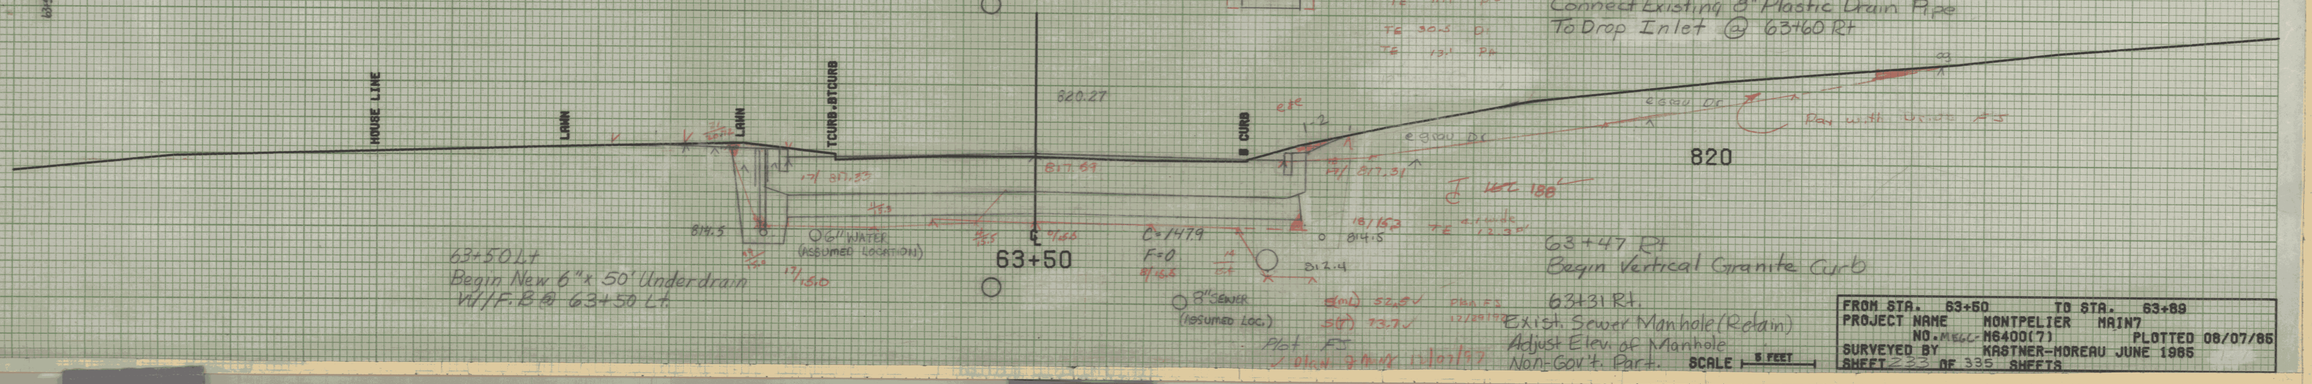


63+50 Lt
Begin New 6"x 50' Underdrain
W/F.B @ 63+50 Lt.

63+47 Rt
Begin Vertical Granite Curb

63+31 Rt.
Exist. Sewer Manhole (Relain)
Adjust Elev. of Manhole
Non-Gov't. Part.

FROM STA. 63+50	TO STA. 63+89
PROJECT NAME MONTPELIER MAIN7	
NO. M6400(7)	PLOTTED 08/07/86
SURVEYED BY KASTNER-MOREAU JUNE 1985	
SHEET 233 OF 335 SHEETS	


SCALE 5 FEET

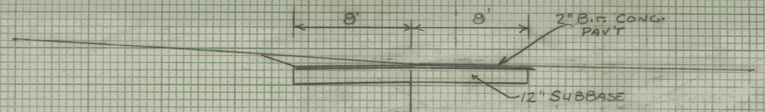

6+10

Section "A-A"
Scale: 1"=5'
Rev 64+27 Lt
Construct Drive 16' Wide (Paved)

Rev. 64+12 Lt ~ 64+83 Rt
New 18"x74' PCCSP.064
CAAP.060

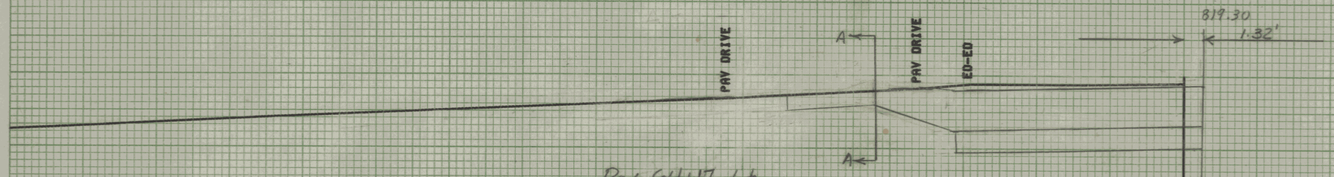

Rev. 64+17 Lt.
End Vertical Granite Curb

Rev. 64+26.94
℄ 64+27 0.96' Rt
819.57


Rev 64+00 ~ Rev 64+12 LT
New 6" x 12' Underdrain
Carrier Pipe

Und. Inv. 813.6


813.0

℄ Rev. 64+11.97
64+12

Rev 64+00 Lt
End New 6"x50' Underdrain
W/F.B. @ 63+50 Lt.

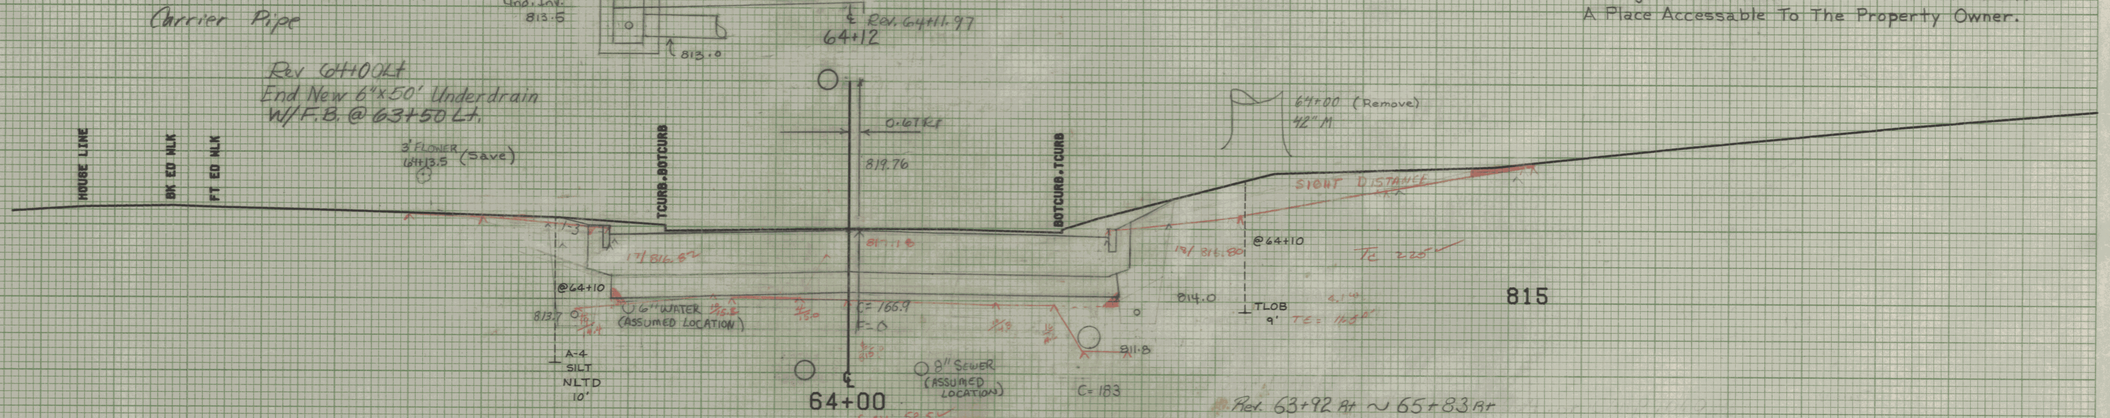

Rev. 63+92 Rt ~ 65+83 Rt
Remove Existing 12" CMP
& 2'x2' DI.

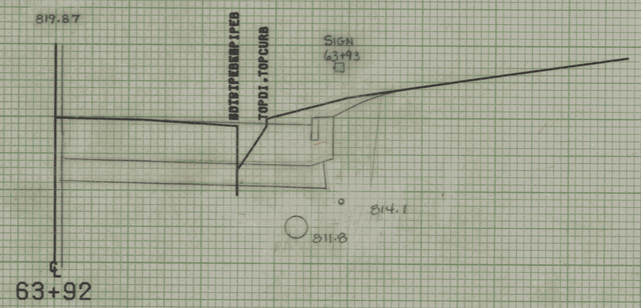

815

Note:
Contractor To Remove 42" Maple @ 64+00 Rt. In 4' Lengths And Stack Them Outside Of R.O.W. In A Place Accessable To The Property Owner.

815

815

FROM STA. 63+92 TO STA. 64+27
PROJECT NAME MONTPELIER MAIN7
NO. M6400(7) PLOTTED 08/07/85
SURVEYED BY KASTNER-MOREAU JUNE 1985
SHEET 232 OF 335 SHEETS

SCALE 5 FEET