


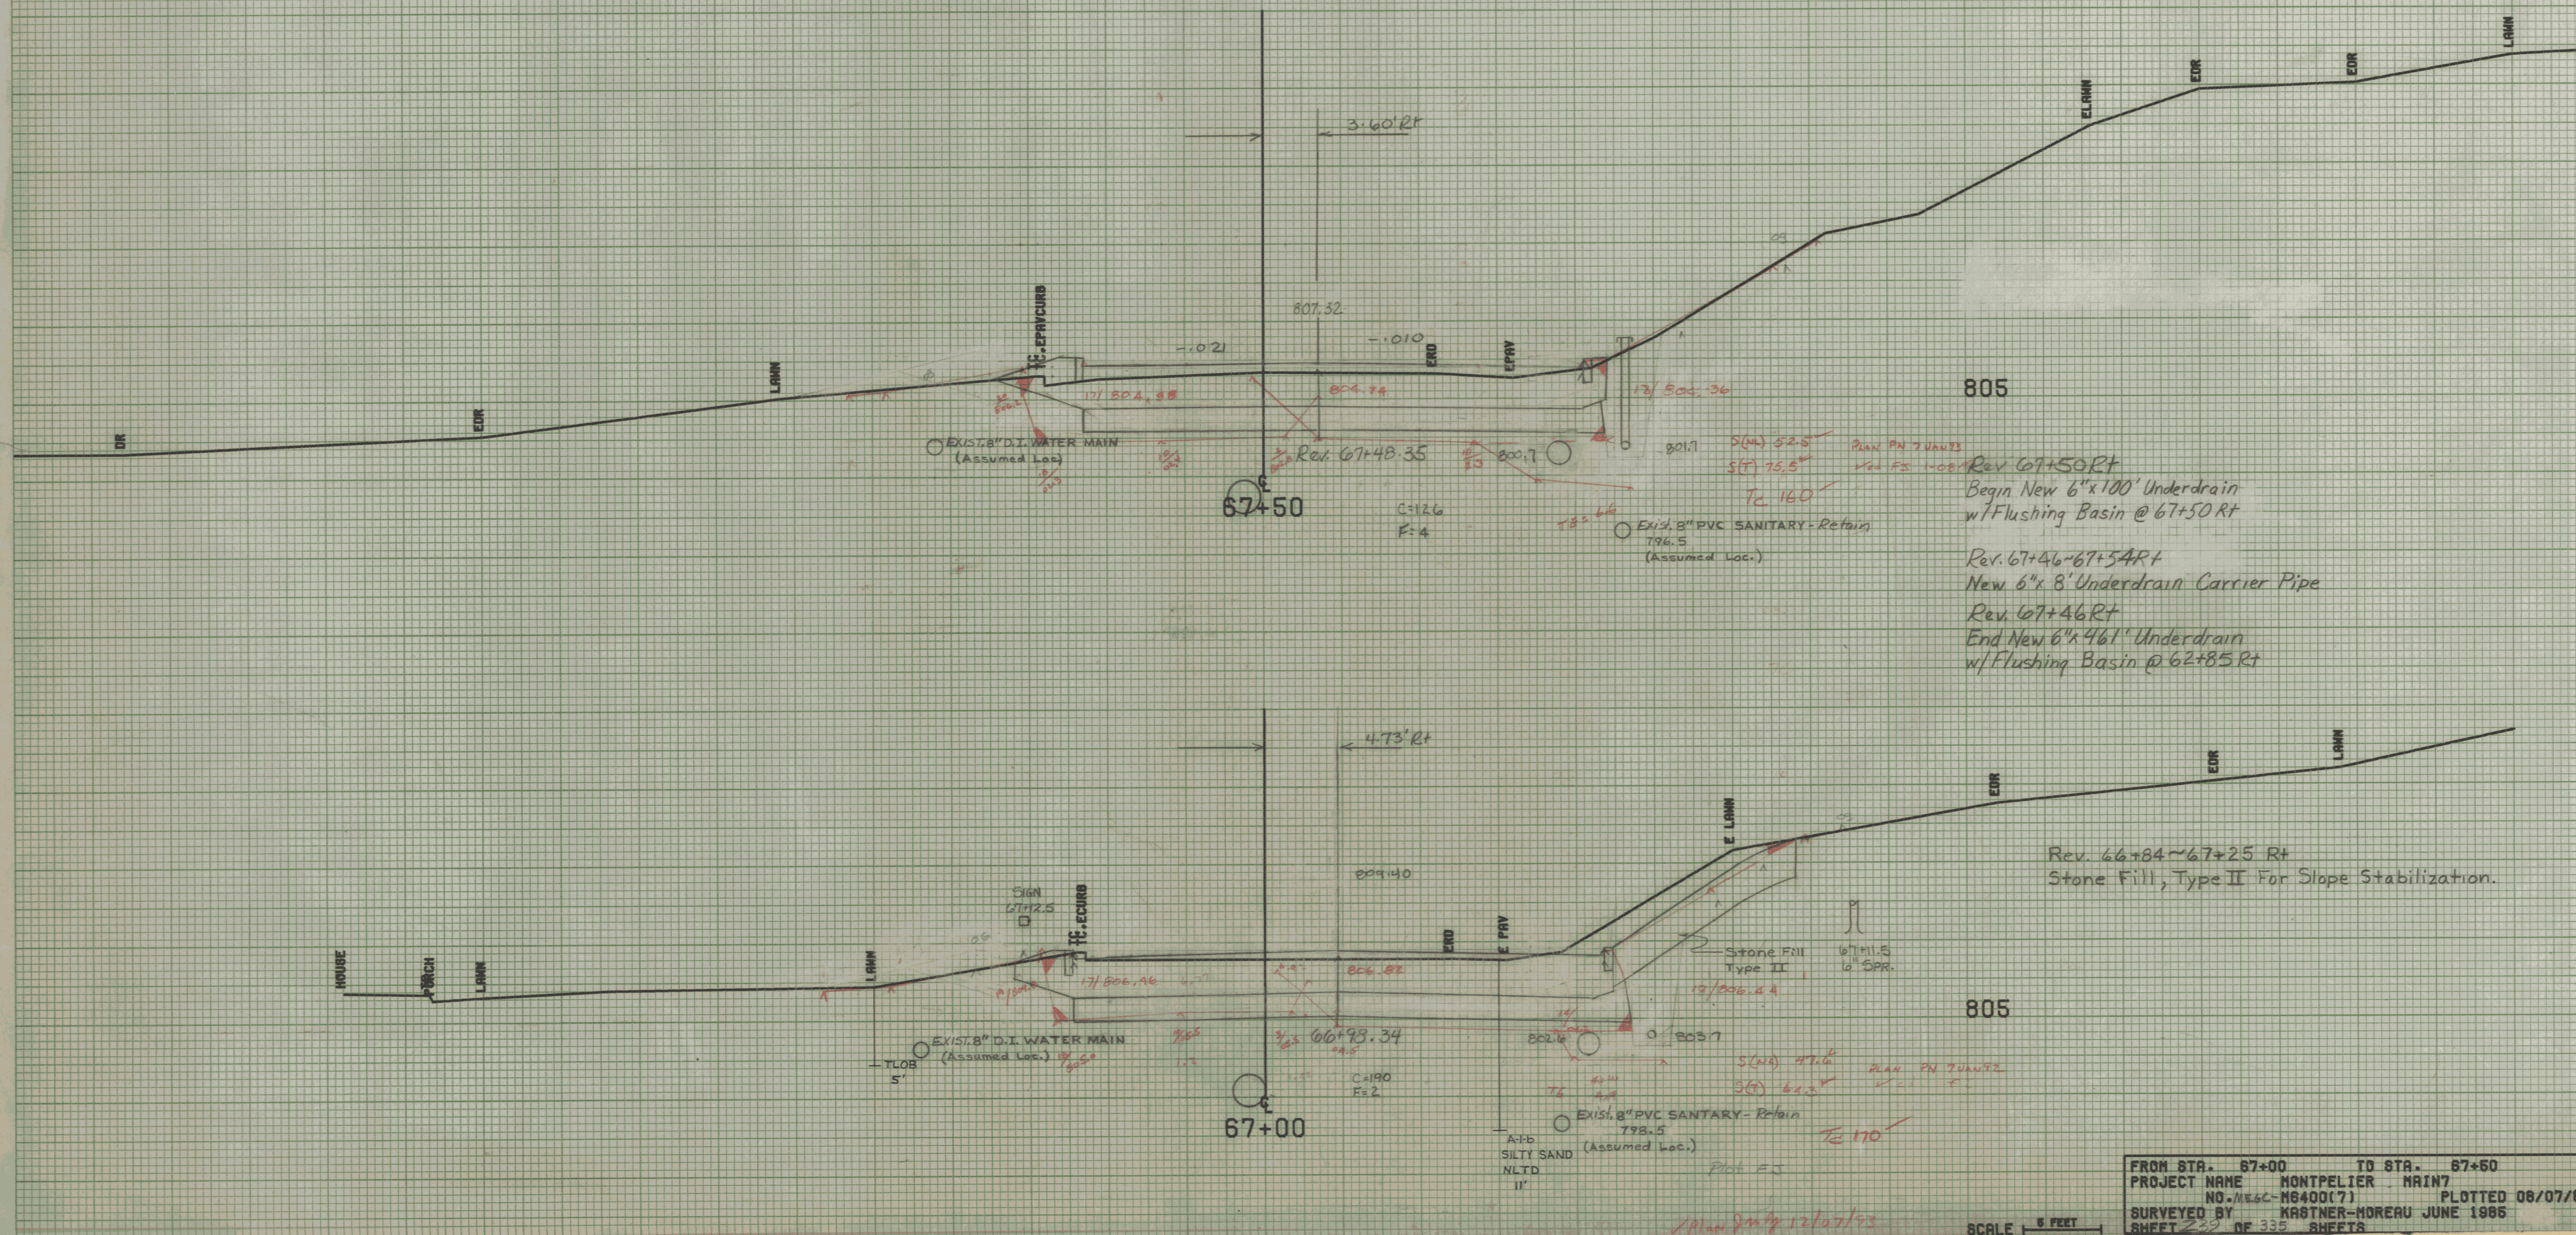

FROM STA. 67+00 TO STA. 67+50
 PROJECT NAME MONTPELIER MAIN7
 NO. MESC-16400(7) PLOTTED 08/07/86
 SURVEYED BY KASTNER-MOREAU JUNE 1985
 SHEET 239 OF 335 SHEETS

SCALE 5 FEET