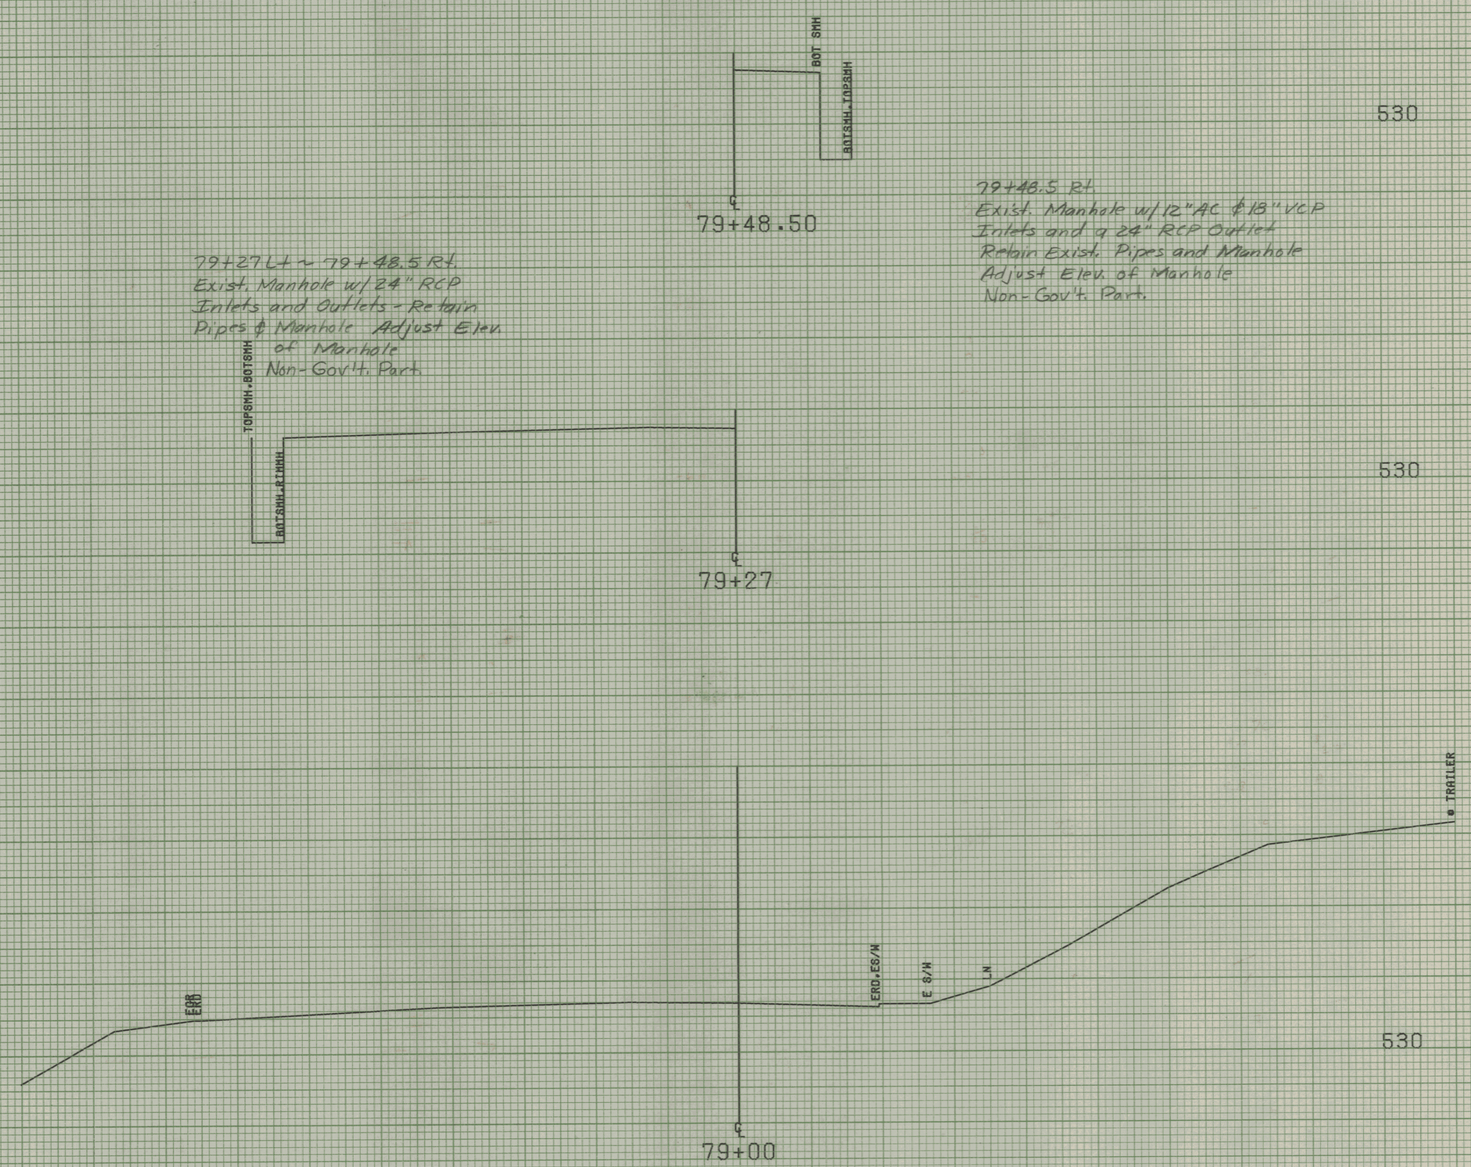

FROM STA. 79+00 TO STA. 79+48.50
PROJECT NAME MONTPELIER
NO. M6400(7) PLOTTED 08/07/85
SURVEYED BY KASTNER-MOREAU JUNE 1985
SHEET 246 OF 335 SHEETS