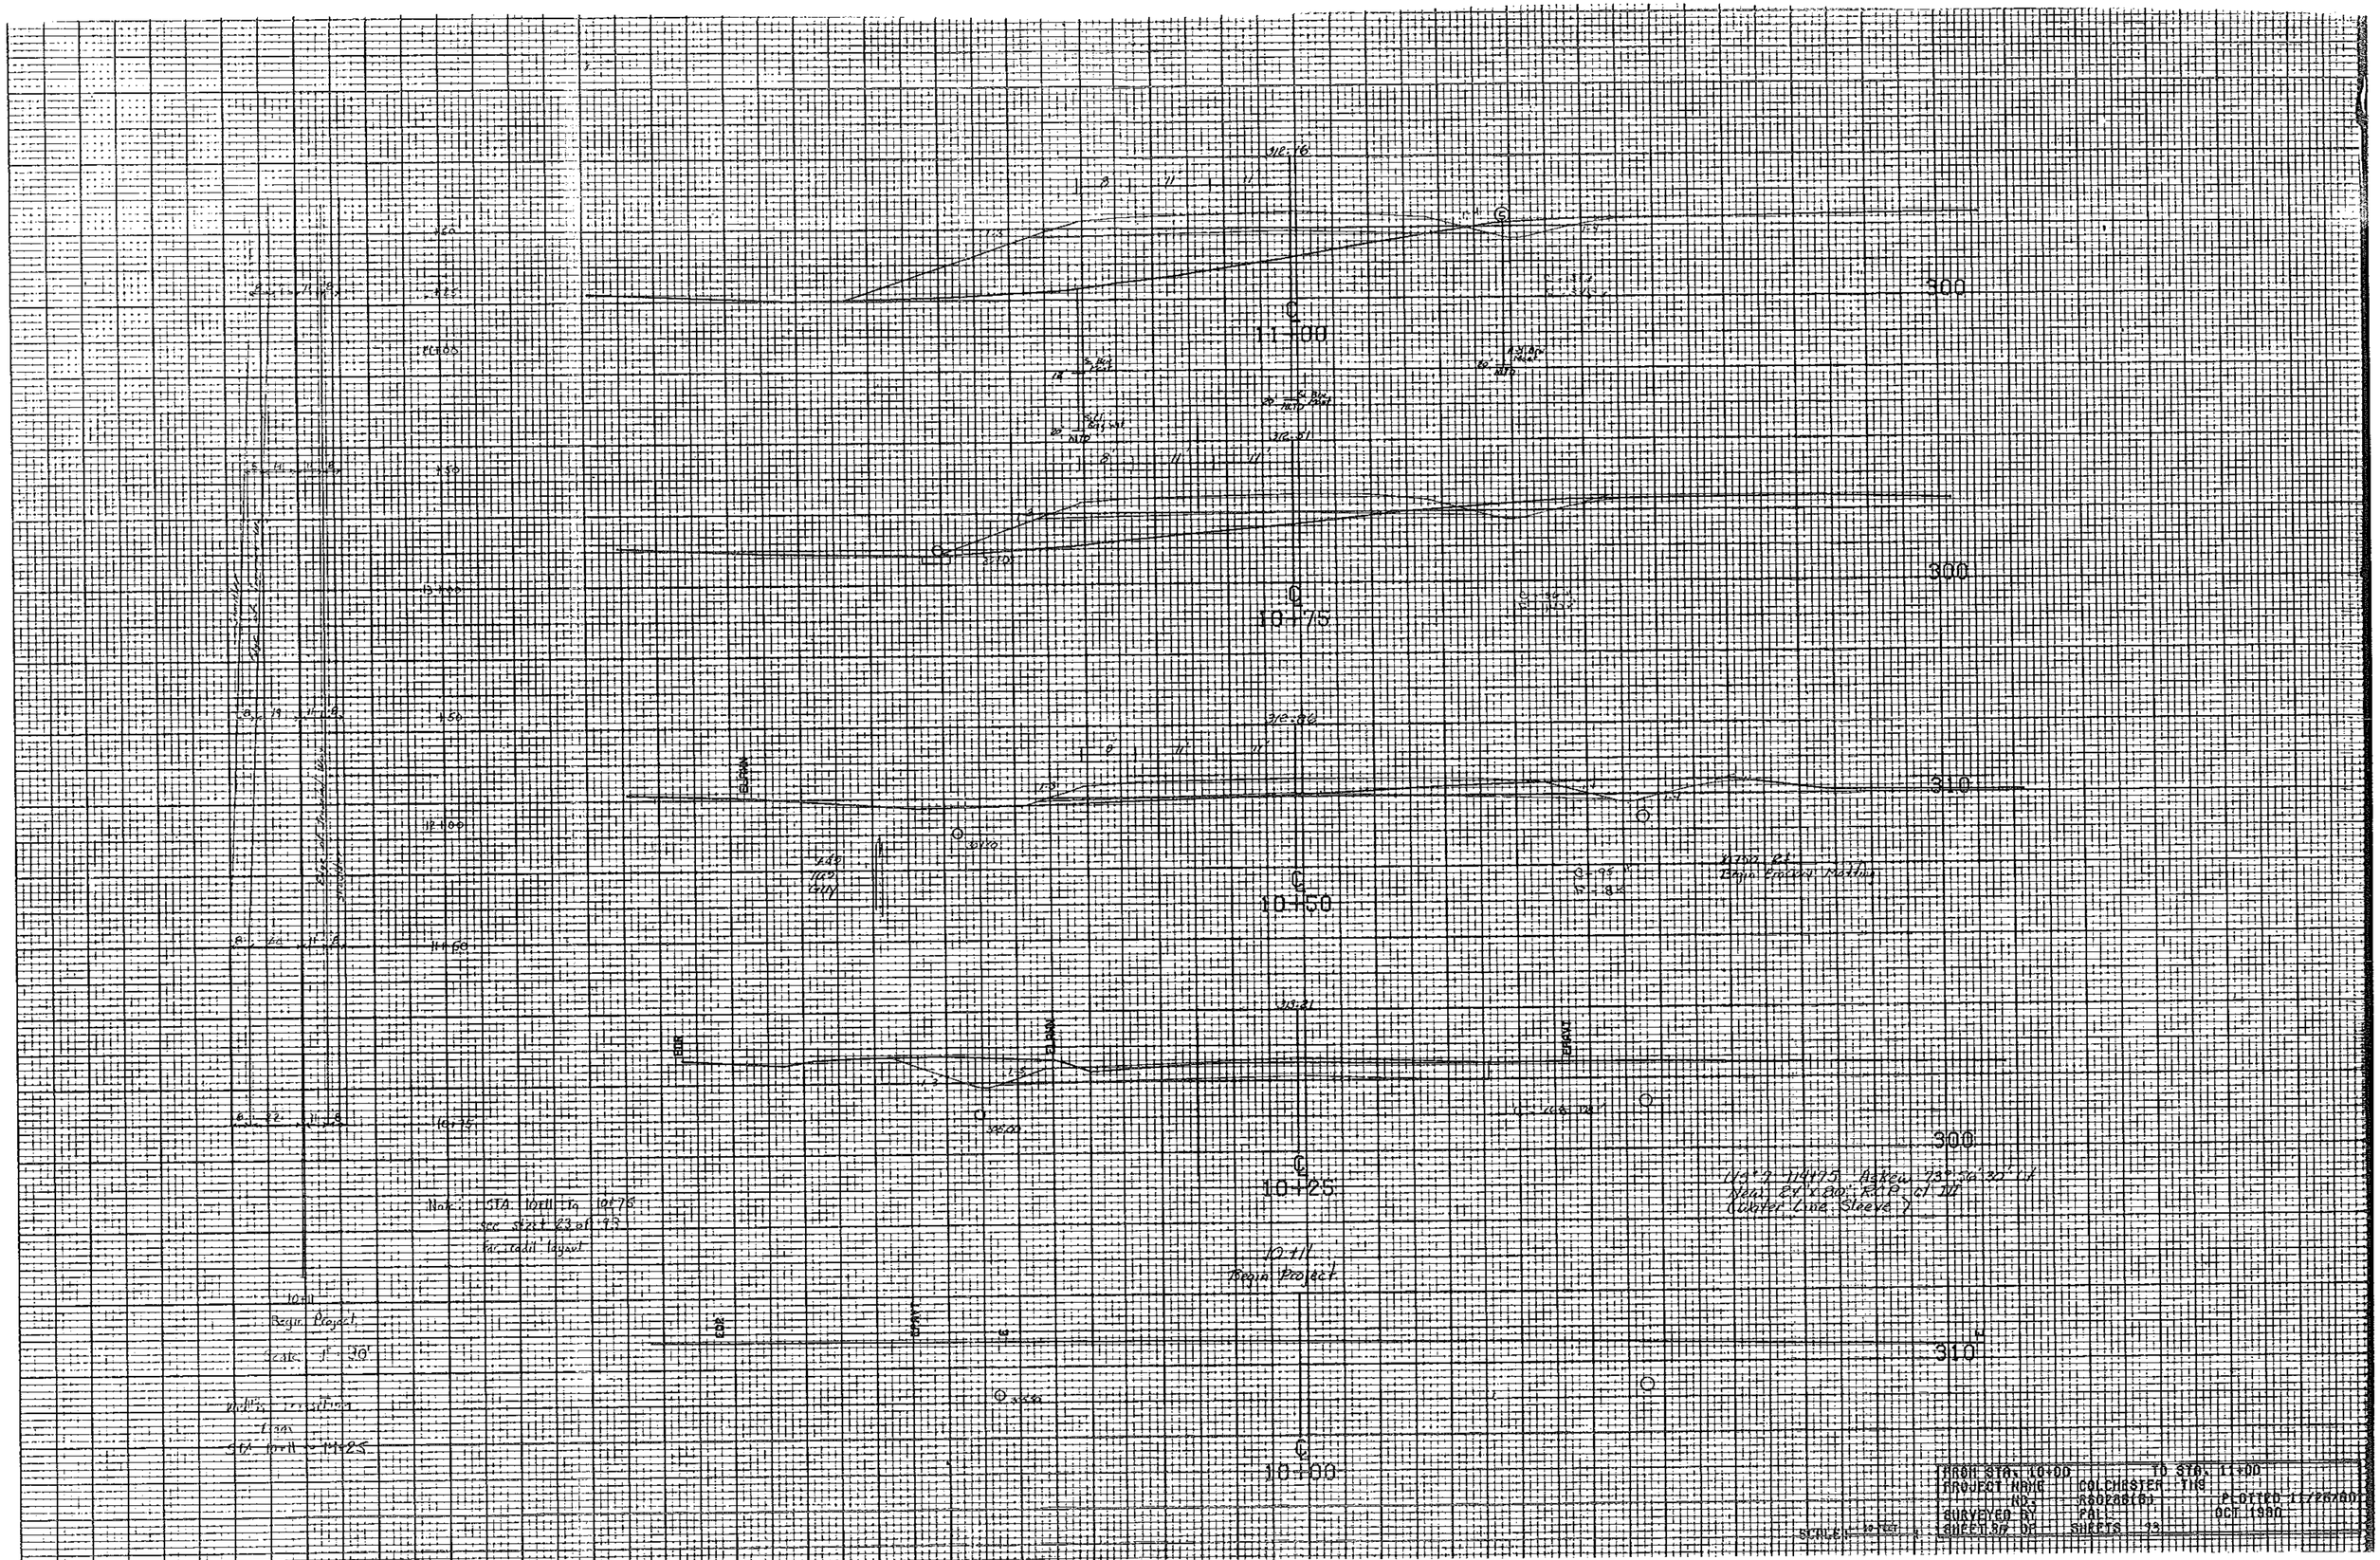
11+00
10+75
10+50
10+25
10+00
300
300
310
300
310
Note: STA 10+11 To 10+76
See Sheet 23 of 73
for Total layout
10+11
Begin Project
Scale 1" 20'
10+11
Begin Project
(13.7 114+75 Ahead 73° 56' 30" LT
New 24" x 20' R.C.P. at 11
(Water Line Sleeve)
FROM STA. 10+00 TO STA. 11+00
PROJECT NAME COLCHESTER TIS
NO. R802881(6) PLOTTED 11/28/80
SURVEYED BY FOR OCT 1980
SHEET 22 OF SHEETS 73
SCALE: 10 FEET