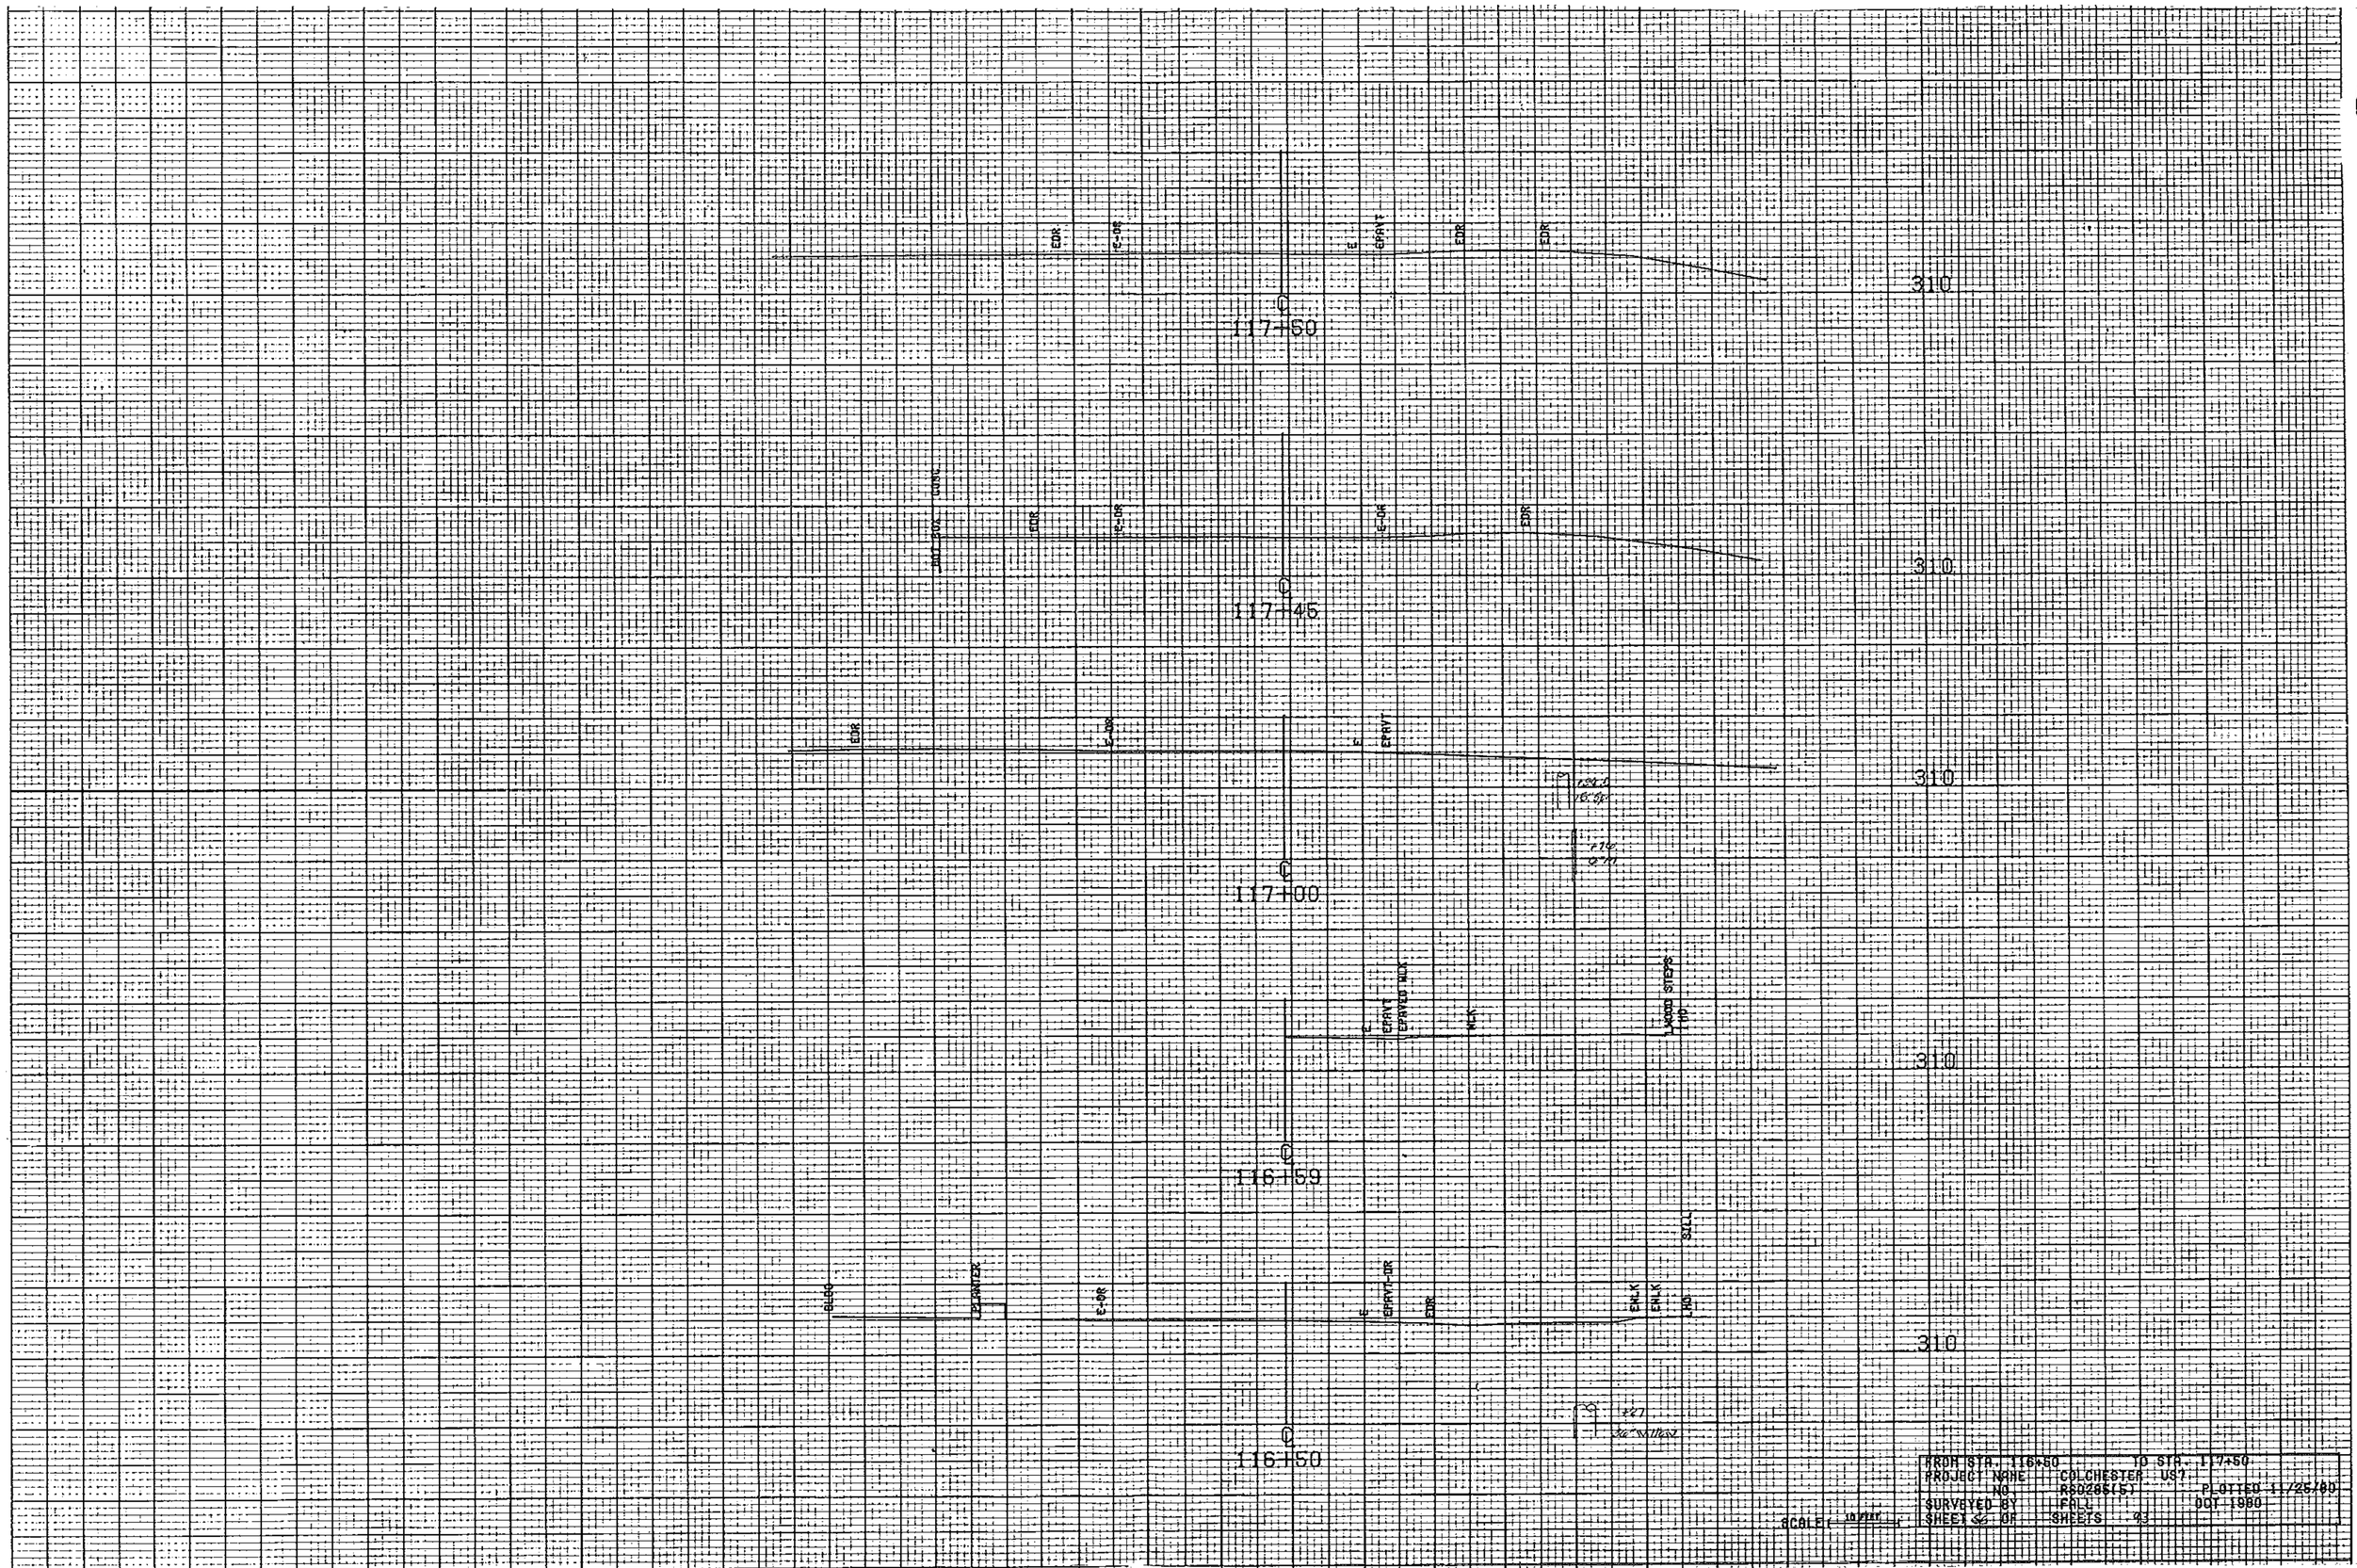
EDR
E-OR
E
GRAVT
EDR
EDR
310
117+60
EDR
E-OR
E-OR
EDR
310
117+45
EDR
E-OR
E
GRAVT
310
117+00
GRAVT
GRAVED WLK
WLK
WOOD STEPS
TYP
310
116+59
BLDG
CONCRETE
E-OR
E
GRAVT-OR
EDR
EN.LK
EN.LK
LKD
SILL
310
116+50
FROM STA. 116+50 TO STA. 117+50
PROJECT NAME COLCHESTER US7
NO. RS0285(5) PLOTTED 11/25/80
SURVEYED BY FOLL OCT 1980
SHEET 56 OF SHEETS 93
SCALE: 10 FEET