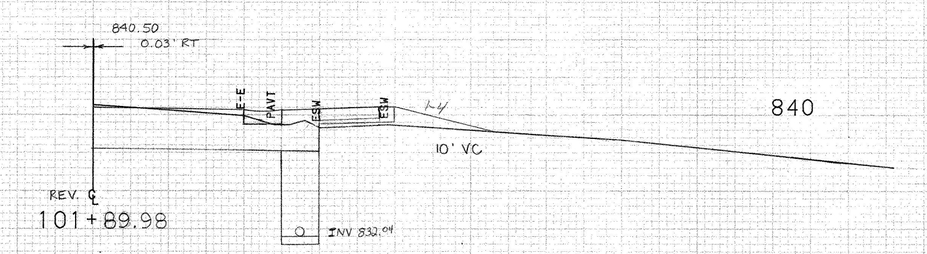

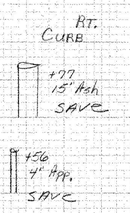

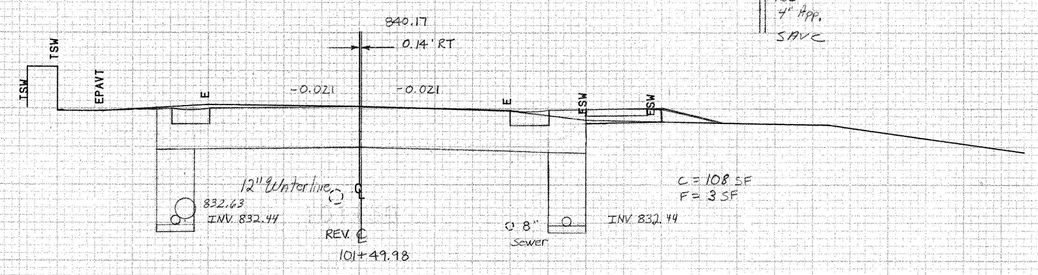

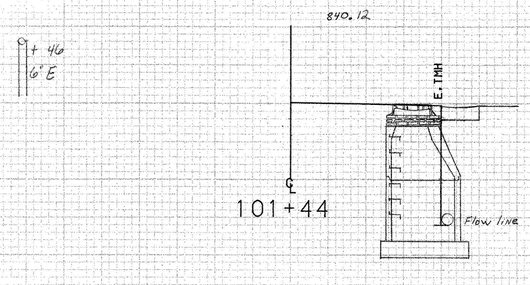

SCALE 5 FEET

FROM STA. 101+44		TO STA. 101+90	
PROJECT NAME	OLD BENNINGTON		[redacted]
NO.	M1400(4)S		PLOTTED 02/24/86
SURVEYED BY	MOREAU		JAN.1986
SHEET #7 OF 63 SHEETS			