INDEX OF SHEETS



1. TITLE SHEET
2. PRELIMINARY INFORMATION
3. QUANTITY SHEET 1
4. QUANTITY SHEET 2
5. TIE SHEET
6. LAYOUT SHEET 1
7. LAYOUT SHEET 2
8. LAYOUT SHEET 3
9. PROFILE SHEET
10. TRAFFIC CONTROL
11. PLAN AND ELEVATION SHEET
12. GENERAL NOTES
13. DECK DETAILS SHEET 1
14. DECK DETAILS SHEET 2
15. TRUSS DETAILS
16. PLATE AND FLOOR BEAM DETAILS
17. GUSSET DETAILS
18. FLOOR BEAM CONNECTION DETAILS
19. FRAMING PLAN & CONNECTION DETAILS
20. LATERAL BRACING DETAILS
21. BEARING DETAILS
22. BEARING NOTES / MISC. DETAILS
23. EXPANSION JOINT DETAILS
24. EXPANSION JOINT PLAN
25. DOWN SPOUT DETAILS
26. ABUTMENT #1 DETAILS
27. ABUTMENT #2 DETAILS
28. BRIDGE RAIL DETAILS
29. LATTICE RAIL DETAILS
30. APPROACH RAIL DETAILS
31. TRAFFIC SIGN SHEET
32. TRAFFIC SIGN SUMMARY SHEET
33. R.O.W. PLAN
34. R.O.W. DETAILS
35. REINFORCING STEEL SCHEDULE
36. MAINLINE CROSS SECTIONS
37. MAINLINE CROSS SECTIONS
38. MAINLINE CROSS SECTIONS
39. MAINLINE CROSS SECTIONS
40. CHANNEL CROSS SECTIONS
41. CHANNEL CROSS SECTIONS
42. CHANNEL CROSS SECTIONS
43. CHANNEL CROSS SECTIONS
44. CHANNEL CROSS SECTIONS
45. CHANNEL CROSS SECTIONS
46. EROSION NARRATIVE
47. EROSION NOTES
48. EXISTING CONDITIONS
49. EROSION PREVENTION AND SEDIMENT CONTROL PLAN
50. FINAL CONDITIONS
51. EPSC1 (SILT FENCE)
52. EPSC5 (DITCH AND SLOPE PROTECTION)
53. EPSC7 (FILTER CURTAIN)


LIST OF STANDARDS

| | |
|---|---|
| B-5 | 6/1/94 |
| B-71 | 7/8/05 |
| E-100 | 1/2/04 |
| E-101 | 5/30/03 |
| E-102 | 6/30/03 |
| E-102A | 5/1/04 |
| E-107 | 6/30/03 |
| E-107A | 8/8/95 |
| E-120 | 8/8/95 |
| E-121 | 8/8/95 |
| E-124 | 8/8/95 |
| E-142 | 9/20/95 |
| E-152 | 5/1/04 |
| E-155 | 5/1/04 |
| E-160 | 5/20/99 |
| E-164 | 5/20/99 |
| G-1 | 1/3/2000 |
| G-1d | 1/3/2000 |

# STATE OF VERMONT
# AGENCY OF TRANSPORTATION

# PROPOSED IMPROVEMENT

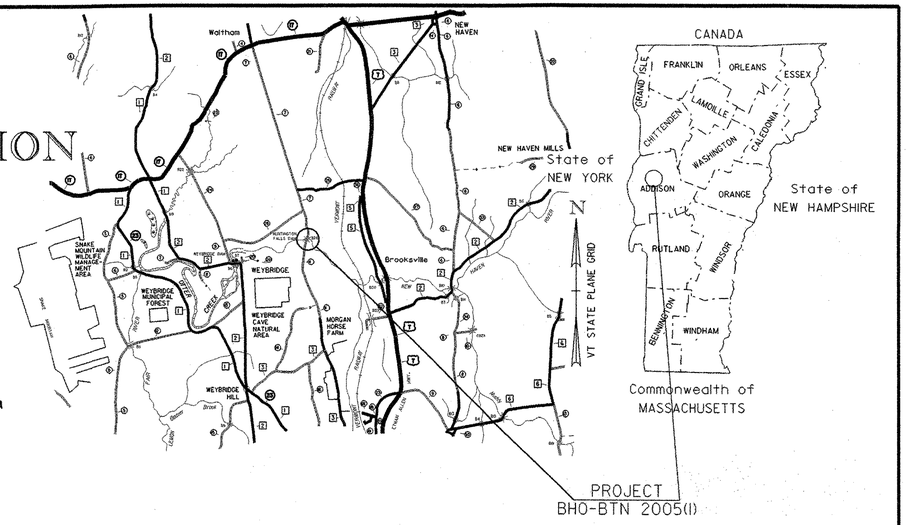



## TOWNS OF NEW HAVEN & WEYBRIDGE
## COUNTY OF ADDISON

ROUTE NO : TH 7/11, CL 3 BRIDGE NO : 26


PROJECT LOCATION : LOCATED IN THE COUNTY OF ADDISON, TOWN OF NEW HAVEN & WEYBRIDGE, ON TH 7/11, BR 26 OVER THE OTTER CREEK, AT THE NEW HAVEN - WEYBRIDGE TOWN LINE.

PROJECT DESCRIPTION : THE PROJECT CONSISTS OF REHABILITATING THE EXISTING STRUCTURE INCLUDING ONE NEW ABUTMENT WITH RELATED CHANNEL AND APPROACH WORK.

| | |
|---|---|
| LENGTH OF STRUCTURE : | 151.42 FEET |
| LENGTH OF ROADWAY : | 3.58 FEET |
| LENGTH OF PROJECT : | 155.00 FEET |

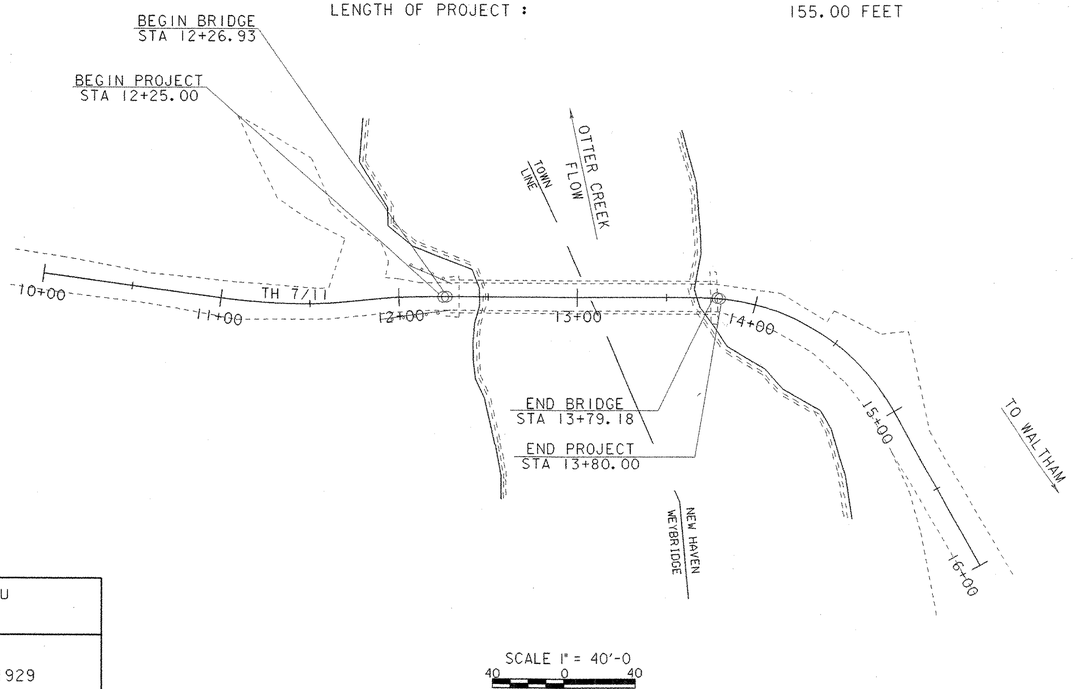


SCALE 1" = 40'-0
40 0 40

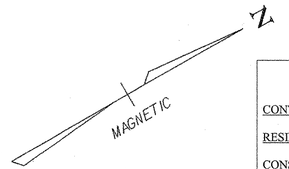


## RECORD PLANS

CONTRACTOR: CCS CONSTRUCTORS LLC – MORRISVILLE, VT

RESIDENT ENGINEER: DALE NORTON

CONSTRUCTION BEGAN: MAY 17, 2007

CONSTRUCTION COMPLETE: SEPTEMBER 18, 2008

RECORD PLANS BY: DALE NORTON & BEN LOGAN

I HEREBY CERTIFY THAT ALL THE CONSTUCTION REQUIRED BY THIS SET OF DRAWINGS HAS BEEN ACCOMPLISHED AS INDICATED HEREIN.

BY Dale R. Norton RESIDENT ENGINEER

DATE 6/3/2009

NOTE: Any further information concerning final quantities, amounts or other details relative to this project may be found at Central Files in the electronic archives.

## CONVENTIONAL SYMBOLS

COUNTY LINE
TOWN LINE
LIMITS OF ACCESS
POINT OF ACCESS
FENCE LINE
STONE WALL
TRAVELED WAY
GUARD RAIL
RAILROAD
SURVEY LINE
CULVERT
POWER POLE
TELEPHONE POLE
TREES
CONTROL OF ACCESS
PROPERTY LINE
R.O.W. TAKING LINE
SLOPE RIGHTS (SR SR SR)
TOP OF CUT
TOE OF SLOPE

SURVEYED BY : R. MOREAU
SURVEYED DATE : 7/90

DATUM
VERTICAL NGVD 1929
HORIZONTAL ASSUMED

THESE PLANS ARE SUBJECT TO SUCH ENGINEERING CHANGES AS MAY BE REQUIRED BY THE FEDERAL HIGHWAY ADMINISTRATION OR THE DIRECTOR OF PROGRAM DEVELOPMENT.

CONSTRUCTION IS TO BE CARRIED ON IN ACCORDANCE WITH THESE PLANS AND THE STANDARD SPECIFICATIONS FOR CONSTRUCTION DATED 2006, AS APPROVED BY THE FEDERAL HIGHWAY ADMINISTRATION ON JUNE 15, 2006 FOR USE ON THIS PROJECT, INCLUDING ALL SUBSEQUENT REVISIONS AND SUCH REVISED SPECIFICATIONS AND SPECIAL PROVISIONS AS ARE INCORPORATED IN THESE PLANS.


DIRECTOR OF PROGRAM DEVELOPMENT
APPROVED Richard Tetreault DATE 1-30-07

PROJECT MANAGER : C.P. WILLIAMS

PROJECT NAME : NEW HAVEN - WEYBRIDGE
PROJECT NUMBER : BHO-BTN 2005 (1)

SHEET 1 OF 53 SHEETS


M:\Projects\89j081\Structures\sj081bdr.dgn PLOTTED 30-JAN-2007

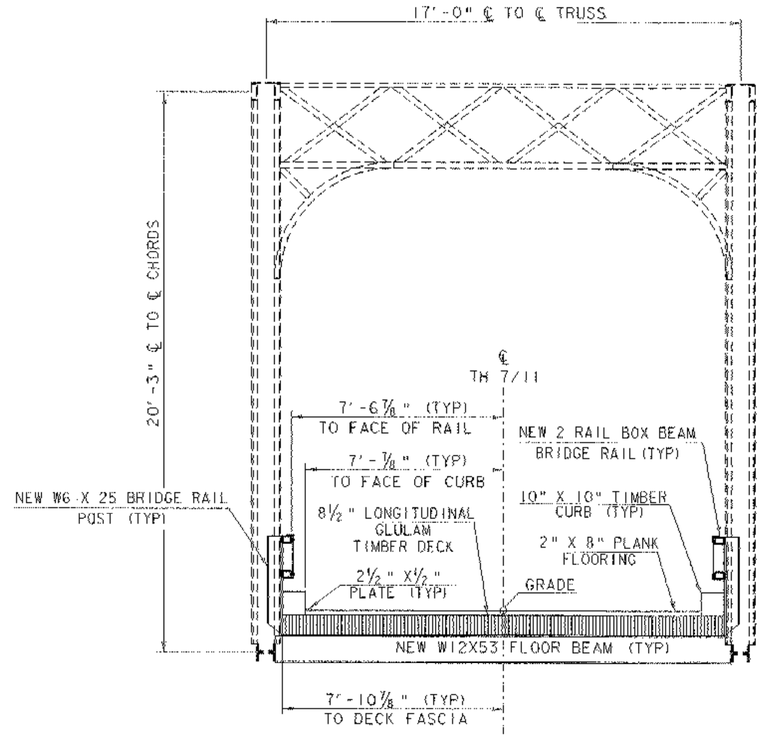


TYPICAL BRIDGE SECTION

SCALE ⅜" = 1'-0

NOTE: TTHE TRANSVERSE DECFKING WAS INSTALLED AS PER PLAN. SUBSEQUENT TO FINAL INSPECTION AND ACCEPTANCE, THE TRANSVERSE DECKING DETERIORATED TO THE POINT THE TOWNS CLOSED THE BRIDGE. THE AGENCY, USING DISTRICT FORCES, REDECKED THE ENTIRE DECK WITH DOUGLADS FIR 2X8 PLANKING, PLACED LONGITUDINALLY, AND SECURELY LAG BOLTED IN PLACE. THE "REDECKING" WAS DONE IN APRIL 2009.

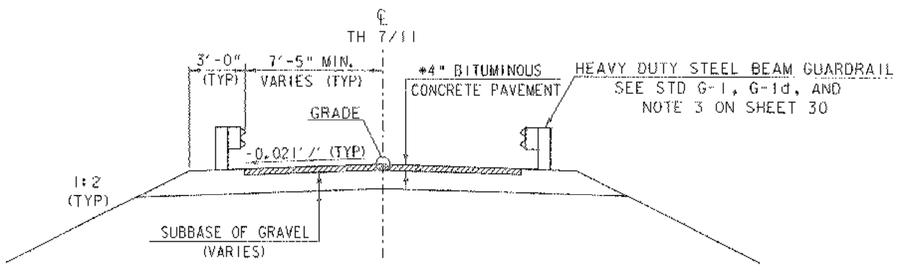


ROADWAY TYPICAL

SCALE ¼" = 1'-0

*1½" TYPE III OVER 2½" TYPE I

| MATERIAL ITEM | TOLERANCE |
|---|---|
| PAVEMENT | ±¼" TOTAL THICKNESS |
| BASE COURSE | ± ½" |
| SUBBASE | ± 1" |

# FINAL HYDRAULICS REPORT

## HYDROLOGIC DATA

DRAINAGE AREA= 749 sq. mi.
CHARACTER OF TERRAIN: Rolling hills
CHARACTER & TYPE OF STREAM: Sinuous, semi-alluvial, probably incised, not braided or anabranched
NATURE OF STREAMBED: Sand, gravel, cobbles, and ledge

Q2.33= 5,000 cfs — Q50= 10,850 cfs
Q10= 8,000 cfs — Q100= 12,200 cfs
Q25= 9,650 cfs — Q500= 15,500 cfs

DATE OF FLOOD OF RECORD: November 1927
WATER SURFACE ELEV. @ 224.5+- ESTIMATED DISCHARGE: 18,800 cfs
NATURAL STREAM VELOCITY @ Q25 = 5.4 fps
ICE CONDITIONS: Moderate DEBRIS: Slight
DOES THE STREAM REACH MAXIMUM HIGHWATER ELEVATION RAPIDLY? No
IS ORDINARY RISE RAPID? No
IS STAGE AFFECTED BY UPSTREAM OR DOWNSTREAM CONDITIONS? Yes
IF YES, DESCRIBE: Huntington Falls Dam is about 350 ft. downstream.
WATERSHED STORAGE N.A. HEADWATERS UNIFORM THROUGHOUT WATERSHED IMMEDIATELY ABOVE SITE

## EXISTING STRUCTURE

STRUCTURE TYPE: Single span steel truss bridge YEAR BUILT: 1908
CLEAR SPAN (NORMAL TO STREAM): 140 ft.
VERTICAL CLEARANCE ABOVE STREAMBED: 22 ft.
WATERWAY OF FULL OPENING: 2,350 sq. ft.
DISPOSITION OF STRUCTURE: Rehabilitate
TYPE OF MATERIAL UNDER SUBSTRUCTURE: Abutment # 1 on ledge, #2 on piles

WATER SURFACE ELEV. @ Q2.33= 218.7 VELOCITY= 3.3 fps
Q10= 219.9 " = 4.8 fps
Q25= 220.7 " = 5.4 fps
Q50= 221.( ) " = 5.9 fps
Q100= 221.7 " = 6.3 fps

LONG TERM STREAM BED CHANGES: None noted. Controlled by the downstream dam.
IS THE ROADWAY OVERTOPPED BELOW THE Q100? No FREQUENCY:
RELIEF ELEVATION: 226.3 DISCHARGE OVER ROAD @ Q100= 0

UPSTREAM STRUCTURE: TOWN: Middlebury-Weybr. DISTANCE: 3.8 miles
HIGHWAY NO.: T.H. 5 & T.H. 3 STRUCTURE NO.: 1
STRUCTURE TYPE: Covered Bridge
CLEAR SPAN: 121 ft. CLEAR HEIGHT: 20 ft.
YEAR BUILT: 1830 FULL WATERWAY: N.A.

DOWNSTREAM STRUCTURE: TOWN: Weybridge DISTANCE: 1.3 miles
HIGHWAY NO.: T.H. 2 STRUCTURE NO.: 6
STRUCTURE TYPE: Two span steel beam bridge
CLEAR SPAN: 118 ft. CLEAR HEIGHT: 22 ft.
YEAR BUILT: 1911 FULL WATERWAY: N.A.

## PROPOSED STRUCTURE

STRUCTURE TYPE: Rehabilitate existing single span steel truss bridge.
CLEAR SPAN (NORMAL TO STREAM): 140 ft.
VERTICAL CLEARANCE ABOVE STREAMBED: 23 ft.
WATERWAY OF FULL OPENING: 2,500 sq. ft.

WATER SURFACE ELEV. @ Q2.33= 218.7 VELOCITY= 3.3 fps
Q10= 219.9 " = 4.8 fps
Q25= 220.7 " = 5.4 fps
Q50= 221.( ) " = 5.9 fps
Q100= 221.7 " = 6.3 fps

IS THE ROADWAY OVERTOPPED BELOW THE Q100? No FREQUENCY:
RELIEF ELEVATION: 226.5 DISCHARGE OVER ROAD @ Q100= 0

AVERAGE LOW ELEVATION OF SUPERSTRUCTURE: 225.5
VERTICAL CLEARANCE @ Q100 = 3.8 ft.

SCOUR: Contraction scour = 8 ft. @ Q100 & 9 ft. @ Q500 *
REQUIRED CHANNEL PROTECTION: Stone Fill, Type III

## PERMIT INFORMATION

AVERAGE DAILY FLOW: 1,580 cfs
ORDINARY LOW WATER: 670 cfs ELEV.: 216.0
ORDINARY HIGH WATER: 2,150 cfs ELEV.: 219.0

## ADDITIONAL COMMENTS

* The scour depths listed are based on free flow (live bed contraction scour). The operation of the downstream dam could affect scour depths at the bridge. The presence of ledge would limit the scour depth. The existing bridge has been in place since 1908, with no known scour related problems.

DESIGN CRITERIA:
1. DESIGN LIVE LOAD AASHTO H-20
2. DESIGN SPAN 148'-0" ℄-℄ BEARING
3. ALLOWABLE LOAD FOR SPREAD FOOTINGS ON SOIL N/A ON LEDGE 10 ksf
4. ALLOWABLE LOAD FOR PILING TYPE ESTIMATED LENGTH
5. STRUCTURAL STEEL AASHTO GRADE M270 GR. 50
6. REINFORCING STEEL GRADE 60
7. CONCRETE, HIGH PERFORMANCE CLASS A $f'_c$ = 4000 PSI
8. CONCRETE, HIGH PERFORMANCE CLASS B $f'_c$ = 3500 PSI

TRAFFIC MAINTENANCE:
1. IS TRAFFIC TO BE MAINTAINED? NO IF YES, ON EXISTING STRUCTURE N/A OR ON TEMPORARY BRIDGE N/A
2. TEMPORARY BRIDGE REQUIREMENTS: ONE OR TWO WAY N/A TRAFFIC CONTROL SIGNALS REQUIRED N/A
MINIMUM CLEAR SPAN (NORMAL TO STREAM):
VERTICAL CLEARANCE ABOVE STREAMBED:
WATERWAY OF FULL OPENING:
ARE SIDEWALKS REQUIRED? (IF SO, ON WHAT SIDE?
STRUCTURE TYPE: Not required. The road will be closed.

LOAD FACTOR LOAD RATING (TONS)

| LOADING LEVELS (LOAD FACTOR) | TRUCK H | HS | 3S2 | 6 AXLE | 3A STR. | 4A STR. | 5A SEMI |
|---|---|---|---|---|---|---|---|
| INVENTORY A=2.17; B=1.00 | 16 | 23 | | | | | |
| POSTED A=1.55; B=1.40 | 22 | 32 | 34 | | 25 | 27 | 33 |
| OPERATING A=1.30; B=1.67 | | 38 | 40 | 34 | 30 | 32 | |

STRENGTH RF= $\frac{\phi M_n - 1.3\,M_{DL}}{A \times M_{LL+I}}$ SERVICEABILITY RF= B $\frac{.95\,f_y S_{LL+I} - M_{DL}\frac{S_{LL+I}}{S_{DL}} - M_{SDL}\frac{S_{LL+I}}{S_{SDL}}}{1.67\,M_{LL+I}}$

TRAFFIC DATA

| YEAR | ADT | DHV | % D | % T | % ADTT |
|---|---|---|---|---|---|
| 1992 | 200 | 30 | —— | <1 | —— |
| 2012 | 270 | 35 | 57 | <1 | —— |

18 Kip ESAL for flexible pavement from 1992 to 2012: <50,000
18 Kip ESAL for flexible pavement from —— to —— : N/A
Design speed 35 mph

# STATE OF VERMONT
## AGENCY OF TRANSPORTATION

| | |
|---|---|
| Town Of NEW HAVEN-WEYBRIDGE | Bridge No. 26 |
| Highway No. TH 7/TH 11 | Log Sta. |
| | Surv. Sta. |

TH 7/TH 11 OVER OTTER CREEK
PRELIMINARY INFORMATION

| | |
|---|---|
| Designed By W.B. SYMONDS | Drawn By W.B. SYMONDS |
| Checked By P.G. JARVIS Date 4/98 | Bridge Design Supervisor C.P. WILLIAMS Date 4/98 |
| PROJECT NEW HAVEN-WEYBRIDGE | PROJECT NO. BHO-BTN 2005 (1) |
| I.C.C. Info. /str4/89j081/sj08ipi.dgn | PLOTTED 28-FEB-2007 |
| Bridge Sheet No. sj08ipi.1 | Sheet 2 of 53 |

STATE OF VERMONT
AGENCY OF TRANSPORTATION

# QUANTITY SHEET

| SUMMARY OF ESTIMATED QUANTITIES | | | | | | | | | | TOTALS | | DESCRIPTIONS | | | | DETAILED SUMMARY OF QUANTITIES | | |
|---|---|---|---|---|---|---|---|---|---|---|---|---|---|---|---|---|---|---|
| SUPERSTR. | ABUT. #1 | ABUT. #2 | | | | | ROADWAY | EROSION CONTROL | BRIDGE | FULL C.C. ITEMS | GRAND TOTAL | FINAL | UNIT | ITEMS | ITEM NUMBER | ROUND | QUANTITIES | UNIT | ITEMS |
| | | | | | | | 1 | | | | 1 | | LS | CLEARING AND GRUBBING, INCLUDING INDIVIDUAL TREES AND STUMPS | 201.10 | | | | |
| | | | | | | | 235 | | | | 235 | | CY | COMMON EXCAVATION | 203.15 | | | | |
| | 220 | | | | | | | | 220 | | 220 | | CY | UNCLASSIFIED CHANNEL EXCAVATION | 209.27 | | | | |
| | | | | | | | | 10 | | | 10 | | CY | TRENCH EXCAVATION OF EARTH | 204.20 | | | | |
| | 50 | | | | | | | | 50 | | 50 | | CY | STRUCTURE EXCAVATION | 204.25 | | | | |
| | 15 | | | | | | | | 15 | | 15 | | CY | GRANULAR BACKFILL FOR STRUCTURES — THIS ITEM CHANGED TO SUBBASE OF CRUSHED GRAVEL (FINE GRADED) ITEM 301.26 | 204.30 | | | | |
| | | | | | | | 290 | 20 | | | 310 | | CY | SUBBASE OF GRAVEL — THIS ITEM CHANGED TO ITEM # 301.35, SUBBASE OF DENSE GRADED CRUSHED STONE | 301.15 | | | | |
| | | | | | | | 2 | | | | 2 | | CWT | EMULSIFIED ASPHALT | 404.65 | | | | |
| | | | | | | | 66 | | | | 66 | | TON | BITUMINOUS CONCRETE PAVEMENT (PGS8-34) CHANGED TO PG 58-28 BY CO #3 | 406.25 | | | | |
| | 29 | 11 | | | | | | | 40 | | 40 | | CY | CONCRETE, HIGH PERFORMANCE CLASS B | 501.34 | | | | |
| 1 | | | | | | | | | 1 | | 1 | | LS | SHORING SUPERSTRUCTURE | 502.10 | | | | |
| 14292 | | | | | | | | | 14292 | | 14292 | | LB | STRUCTURAL STEEL, ROLLED BEAM | 506.50 | | | | |
| 4480 | | | | | | | | | 4480 | | 4480 | | LB | STRUCTURAL STEEL | 506.60 | | | | |
| | 1492 | 1089 | | | | | | | 2581 | | 2581 | | LB | REINFORCING STEEL | 507.15 | | | | |
| | 36 | 32 | | | | | | | 68 | | 68 | | LF | DRILLING AND GROUTING DOWELS | 507.16 | | | | |
| | | 1 | | | | | | | 1 | | 1 | | LS | SHEAR CONNECTORS (10 - 7/8" X 7") | 508.15 | | | | |
| 1 | | | | | | | | | 1 | | 1 | | LS | STRUCTURAL PAINTING,SHOP APPLIED (7.7 Tons) | 513.25 | | | | |
| 1 | | | | | | | | | 1 | | 1 | | LS | STRUCTURAL PAINTING,FIELD APPLIED (19.5 Tons) | 513.30 | | | | |
| 1 | | | | | | | | | 1 | | 1 | | LS | CONTAINMENT & ENVIRONMENTAL PROTECTION,FIELD (19.5 Tons) | 513.36 | | | | |
| 1 | | | | | | | | | 1 | | 1 | | LS | SURFACE PREPARATION,SHOP (7.7 Tons) | 513.40 | | | | |
| 1 | | | | | | | | | 1 | | 1 | | LS | SURFACE PREPARATION, FIELD (19.5 Tons) | 513.41 | | | | |
| 16 | | | | | | | | | 16 | | 16 | | LF | BRIDGE EXPANSION JOINT, VERMONT | 516.11 | | | | |
| 4.3 | | | | | | | | | 4.3 | | 4.3 | | MFBM | NONSTRUCTURAL LUMBER, UNTREATED | 522.30 | | | | |
| 2.5 | | | | | | | | | 2.5 | | 2.5 | | MFBM | NONSTRUCTURAL LUMBER, TREATED | 522.35 | | | | |
| 1 | | | | | | | | | 1 | | 1 | | LS | STRUCTURAL GLUED LAMINATED TIMBER | 522.40 | | | | |
| 16 | | | | | | | | | 16 | | 16 | | LF | JOINT SEALER, POLYURETHANE | 524.21 | | | | |
| 310 | | | | | | | | | 310 | | 310 | | LF | BRIDGE RAILING, GALVANIZED 2 RAIL BOX BEAM | 525.31 | | | | |
| 1 | | | | | | | | | 1 | | 1 | | EACH | PARTIAL REMOVAL OF STRUCTURE | 529.20 | | | | |
| | 2 | 2 | | | | | | | 4 | | 4 | | EACH | BEARING DEVICE ASSEMBLY, PREFORMED FABRIC PAD | 531.10 | | | | |
| | | | | | | | | 10 | | | 10 | | HR | ALL PURPOSE EXCAVATOR RENTAL, TYPE I | 606.25 | | | | |
| | | | | | | | 1 | | | | 1 | | TON | DUST & ICE CONTROL WITH CALCIUM CHLORIDE | 609.15 | | | | |
| | | | | | | | | 10 | | | 10 | | CY | STONE FILL, TYPE I | 613.10 | | | | |
| 240 | | | | | | | | | 240 | | 240 | | CY | STONE FILL, TYPE II | 613.12 | | | | |
| | | | | | | | 180 | | | | 180 | | LF | HD STEEL BEAM GUARDRAIL, GALVANIZED W/8 FEET POSTS — CHANGED TO 6' POSTS BY CO #4 | 621.215 | | | | |
| | | | | | | | 4 | | | | 4 | | EACH | ANCHOR FOR STEEL BEAM RAIL | 621.60 | | | | |
| | | | | | | | 64 | | | | 64 | | LF | REMOVAL AND DISPOSAL OF GUARDRAIL | 621.80 | | | | |
| | | | | | | | 40 | | | | 40 | | LF | TEMPORARY TRAFFIC BARRIER | 621.90 | | | | |
| | | | | | | | | | | | 1 | 1 | LS | FIELD OFFICE-ENGINEERS | 631.10 | | | | |
| | | | | | | | | | | | 1 | 1 | LS | TESTING EQUIPMENT - CONCRETE | 631.16 | | | | |
| | | | | | | | | | | | 1 | 1 | LS | TESTING EQUIPMENT - BITUMINOUS | 631.17 | | | | |

PROJECT NAME: New Haven - Weybridge
PROJECT NUMBER: BTN 2005(1)

FILENAME: s:\08\qty\new.dgn
PROJECT MANAGER: C. P WILLIAMS
DESIGNED BY: R. S. YOUNG
QUANTITY SHEET #1

PLOT DATE: 02/28/2007
DRAWN BY: R. D. BEARD
CHECKED BY:

STATE OF VERMONT
AGENCY OF TRANSPORTATION

# QUANTITY SHEET


| SUMMARY OF ESTIMATED QUANTITIES | | | | | | | | | | TOTALS | | DESCRIPTIONS | | | | DETAILED SUMMARY OF QUANTITIES | | |
|---|---|---|---|---|---|---|---|---|---|---|---|---|---|---|---|---|---|---|
| SUPERSTR | ABUT. #1 | ABUT. #2 | | | | | ROADWAY | EROSION CONTROL | BRIDGE | FULL C.E. ITEMS | GRAND TOTAL | FINAL | UNIT | ITEMS | ITEM NUMBER | ROUND | QUANTITIES | UNIT | ITEMS |
| | | | | | | | | | | 1 | 1 | | LS | TESTING EQUIPMENT - PROTECTIVE COATINGS | 631.18 | | | | |
| | | | | | | | | | | 1 | 1 | | LU | FIELD OFFICE - TELEPHONE (NABI) | 631.25 | | | | |
| | | | | | | | 1 | | | | 1 | | LS | MOBILIZATION/DEMOBILIZATION | 635.11 | | | | |
| | | | | | | | 1 | | | | 1 | | LS | TRAFFIC CONTROL | 641.10 | | | | |
| | | | | | | | | 230 | | | 230 | | SY | GEOTEXTILE UNDER STONE FILL | 649.31 | | | | |
| | | | | | | | | 60 | | | 60 | | SY | GEOTEXTILE FOR SILT FENCE | 649.51 | | | | |
| | | | | | | | | 70 | | | 70 | | SY | GEOTEXTILE FOR FILTER CURTAIN | 649.61 | | | | |
| | | | | | | | | 10 | | | 10 | | LB | SEED | 651.15 | | | | |
| | | | | | | | | 10 | | | 10 | | LB | SEED-WINTER RYE | 651.17 | | | | |
| | | | | | | | | 100 | | | 100 | | LB | FERTILIZER | 651.18 | | | | |
| | | | | | | | | 1 | | | 1 | | TON | AGRICULTURAL LIMESTONE | 651.20 | | | | |
| | | | | | | | | 180 | | | 180 | | SY | GRUBBING MATERIAL | 651.40 | | | | |
| | | | | | | | | 1 | | | 1 | | LS | EPSC PLAN | 652.10 | | | | |
| | | | | | | | | 50 | | | 50 | | HR | MONITORING EPSC PLAN | 652.20 | | | | |
| | | | | | | | | 1 | | | 1 | | LU | MAINTENANCE OF EPSC PLAN (N.A.B.I.) | 652.30 | | | | |
| | | | | | | | | 200 | | | 200 | | SY | TEMPORARY EROSION MATTING | 653.20 | | | | |
| | | | | | | | 290 | | | | 290 | | LF | BARRIER FENCE | 653.50 | | | | |
| | | | | | | | | 280 | | | 280 | | LF | PROJECT DEMARCATION FENCE | 653.55 | | | | |
| | | | | | | | 63.13 | | | | 63.13 | | SF | TRAFFIC SIGNS, TYPE A | 675.20 | | | | |
| | | | | | | | | | | | | | | BEGIN OPTION AA | | | | | |
| | | | | | | | 148 | | | | 148 | | LF | FLANGED CHANNEL SIGN POST | 675.301 | | | | |
| | | | | | | | 148 | | | | 148 | | LF | SQUARE TUBE SIGN POST AND ANCHOR | 675.341 | | | | |
| | | | | | | | | | | | | | | END OPTION AA | | | | | |
| | | | | | | | 7 | | | | 7 | | EACH | REMOVING SIGNS | 675.50 | | | | |
| | | | | | | | 2 | | | | 2 | | EACH | ERECTING SALVAGED SIGNS | 675.60 | | | | |
| | 2 | 3 | | | | | | | | 5 | 5 | | GAL | SPECIAL PROVISION (WATER REPELLENT,SILANE) | 900.625 | | | | |
| | | | | | | | 1 | | | | 1 | | LS | SPECIAL PROVISION (FLOATING DOCK) | 900.645 | | | | |
| | | | | | | | | 1 | | | 1 | | TON | SPECIAL PROVISION (STRAW MULCH) | 900.680 | | | | |

PROJECT NAME: New Haven - Weybridge
PROJECT NUMBER: BTN 2005(1)


FILE NAME: sj081qtynew.xls
PROJECT MANAGER: C. P WILLIAMS
DESIGNED BY: R. S. YOUNG
QUANTITY SHEET #2

PLOT DATE: 02/26/2007
DRAWN BY: D. D. BEARD
CHECKED BY:


# SURVEY TIES

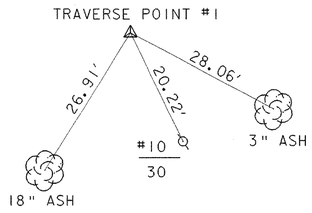



N = 10081.9152
E = 10057.3576

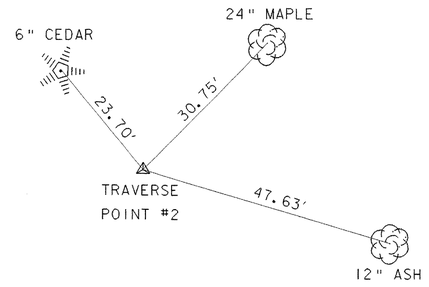


N = 10532.5307
E = 10372.8820

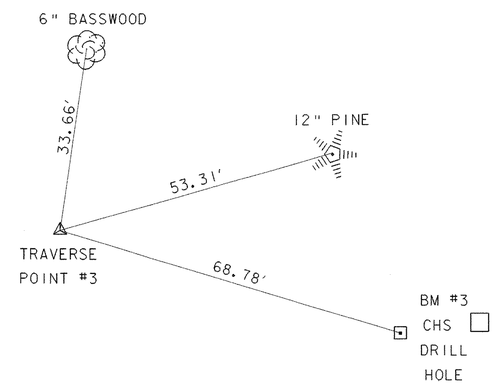



N = 10522.4974
E = 10486.7547

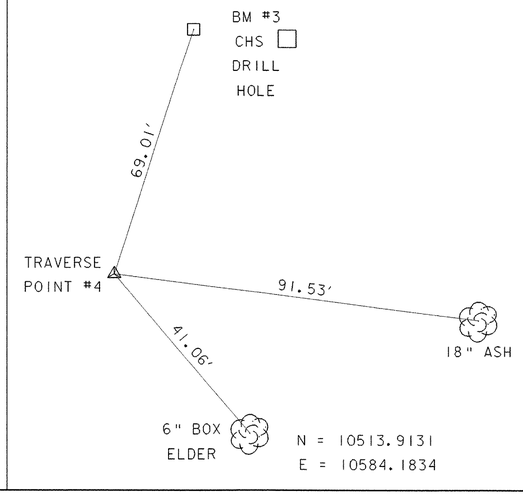


N = 10513.9131
E = 10584.1834


# ALIGNMENT TIES

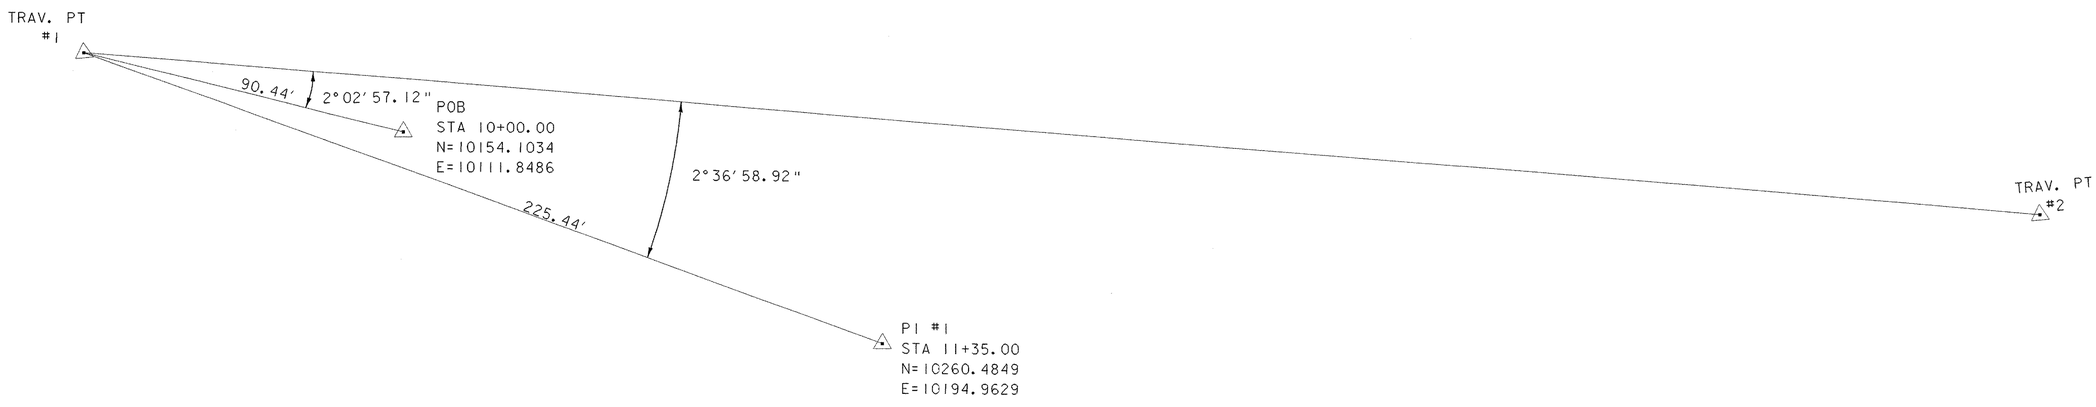


TIES ARE NOT TO SCALE

**DATUM**
VERTICAL NGVD 1929
HORIZONTAL ASSUMED

| | |
|---|---|
| PROJECT: NEW HAVEN - WEYBRIDGE | PROJECT NO.: BHO-BTN 2005(1) |
| DESIGN FILE NAME: /str4/89j081/sj081tie.dgn | |
| IPARM FILE NAME: sj081tie.i | PLOT DATE: 28-FEB-2007 |
| SURVEYED BY: R. MOREAU | SURVEY DATE: 7/90 |
| SQUAD LEADER: C.P. WILLIAMS | DRAWN BY: P.G. JARVIS |
| TIE SHEET | SHEET: 5 OF 53 |

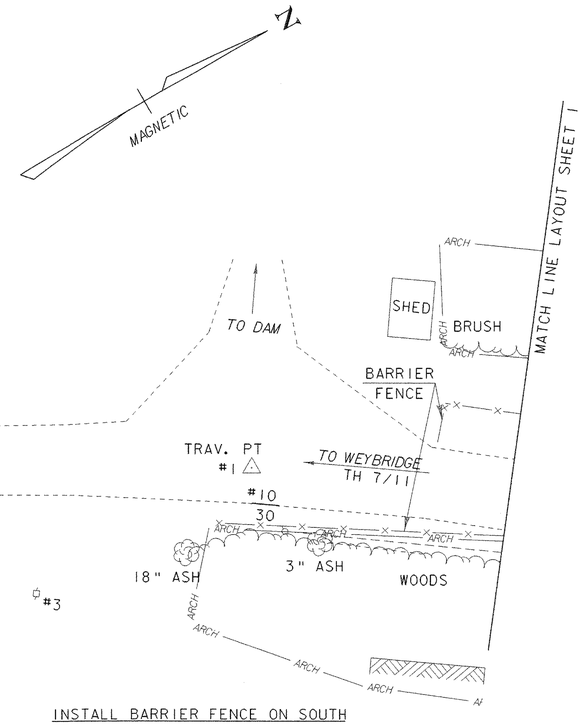



INSTALL BARRIER FENCE ON SOUTH
SIDE OF BRIDGE AS SHOWN

# LAYOUT SHEET 1

SCALE 1" = 20'-0
20 0 20

**DATUM**
VERTICAL NGVD 1929
HORIZONTAL ASSUMED

| PROJECT: NEW HAVEN-WEYBRIDGE | PROJECT NO.: BHO-BTN 2005(1) |
|---|---|
| DESIGN FILE NAME: /usr/str4/89j081/sj08lbdr.dgn | |
| IPARM FILE NAME: sj08llal.i | PLOT DATE: 28-FEB-2007 |
| SURVEYED BY: R. MOREAU | SURVEY DATE: 7/90 |
| SQUAD LEADER: C.P. WILLIAMS | DRAWN BY: W.B. SYMONDS |
| LAYOUT SHEET 1 | SHEET: 6 OF 53 |

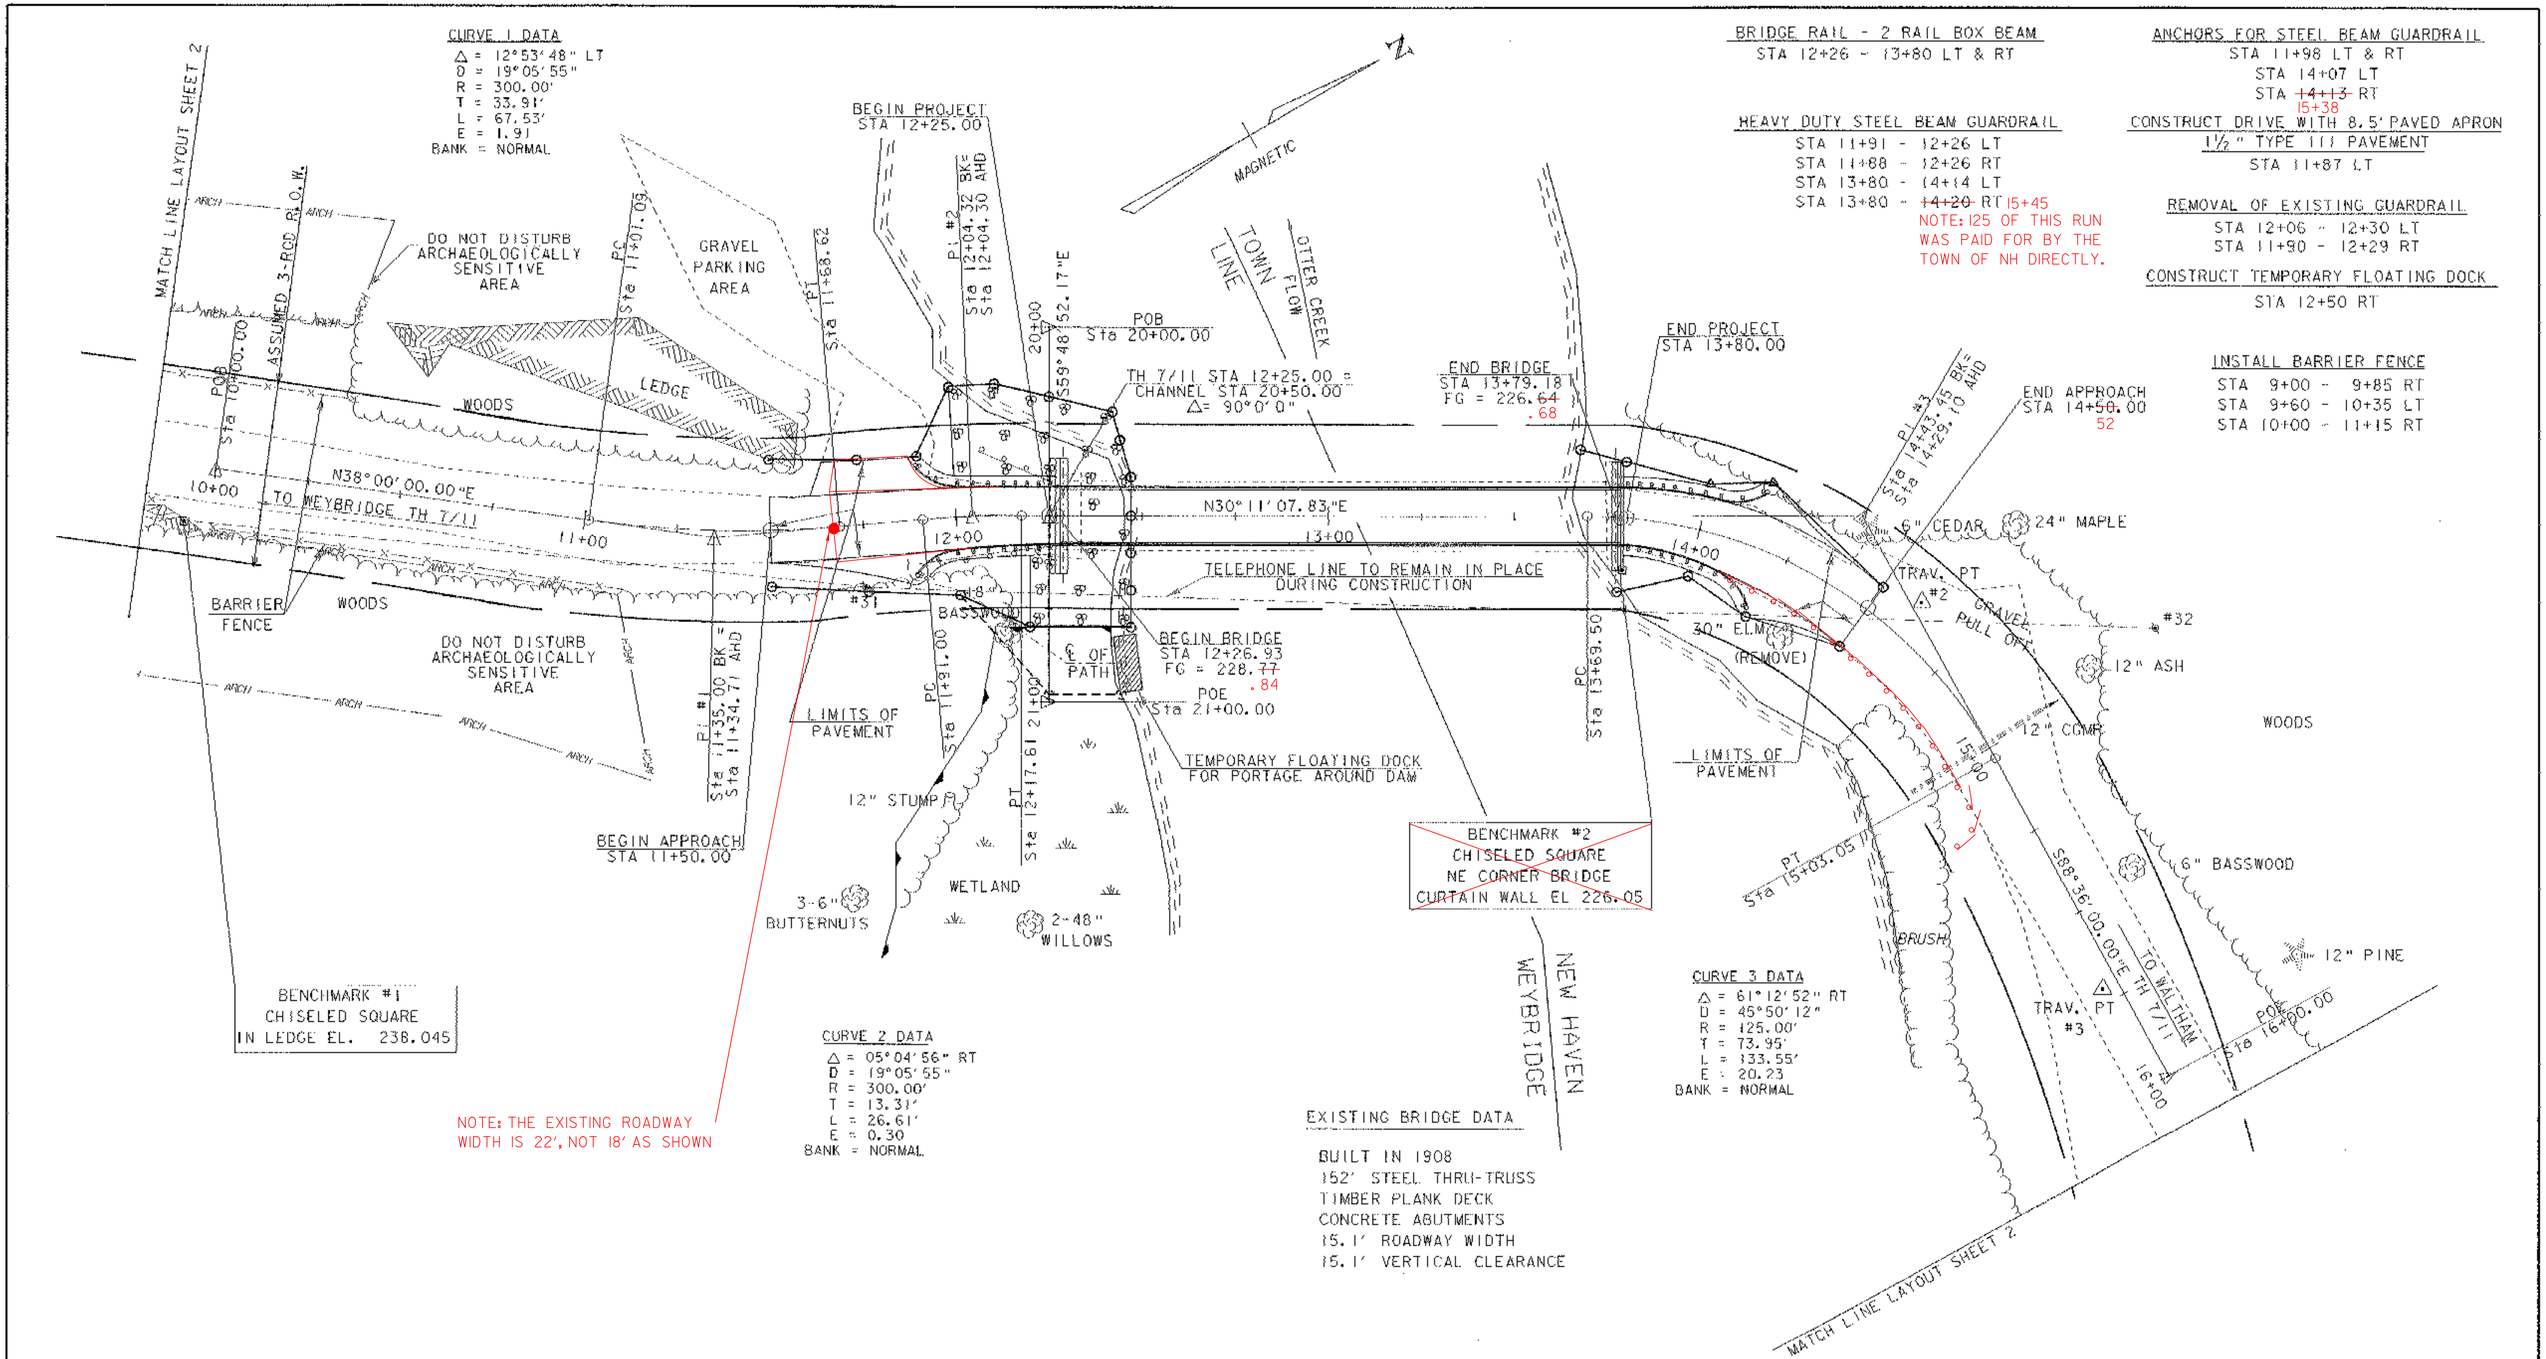



# LAYOUT SHEET 2

SCALE 1" = 20'-0

20 0 20

DATUM
VERTICAL NGVD 1929
HORIZONTAL ASSUMED

| | |
|---|---|
| PROJECT: NEW HAVEN-WEYBRIDGE | PROJECT NO.: BHO-BTN 2005(1) |
| DESIGN FILE NAME: /usr/str4/89j081/sj081bdr.dgn | |
| IPARM FILE NAME: sj081lo2.i | PLOT DATE: 28-FEB-2007 |
| SURVEYED BY: R. MOREAU | SURVEY DATE: 7/90 |
| SQUAD LEADER: C.P. WILLIAMS | DRAWN BY: W.B. SYMONDS |
| LAYOUT SHEET 2 | SHEET: 7 OF 53 |

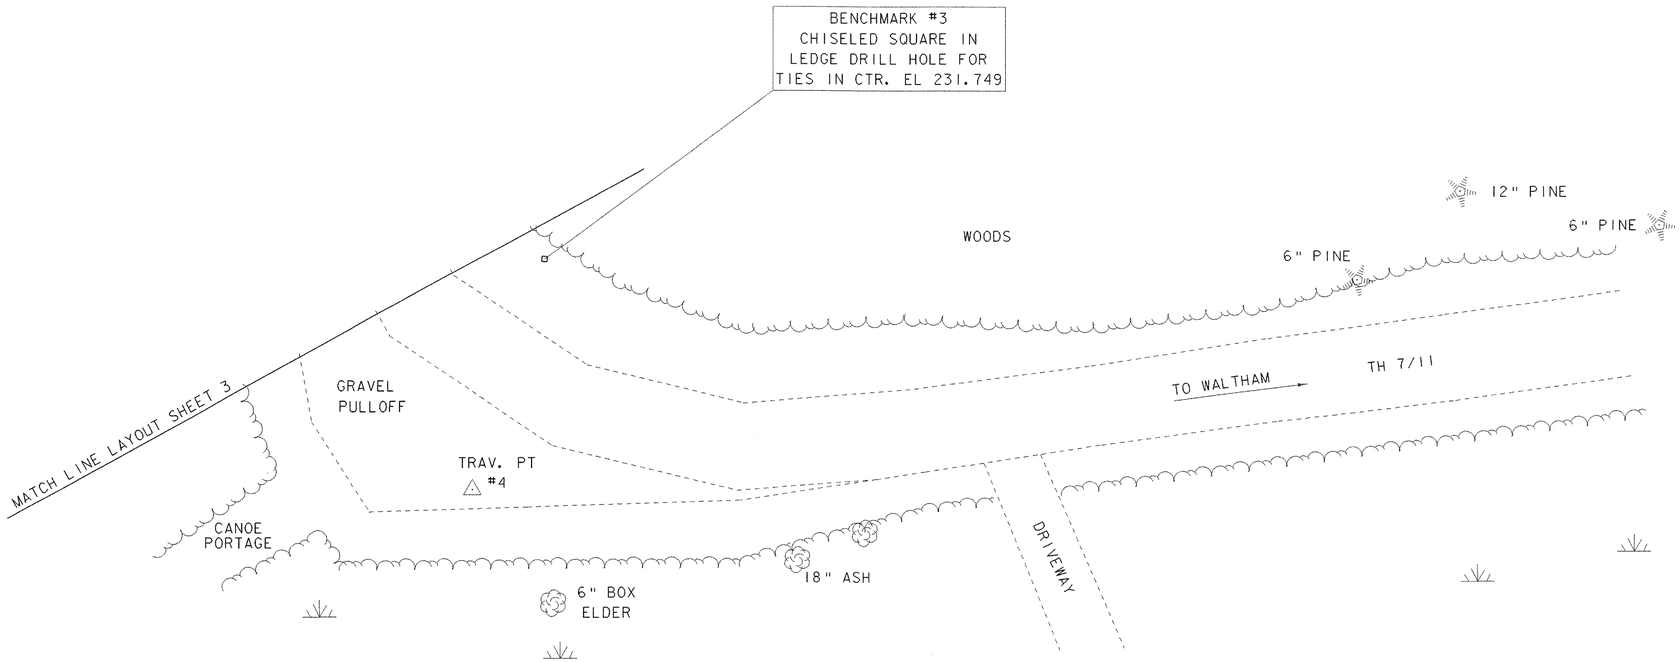



## LAYOUT SHEET 3

SCALE 1" = 20'-0
20 0 20

**DATUM**
VERTICAL NGVD 1929
HORIZONTAL ASSUMED

| | |
|---|---|
| PROJECT: NEW HAVEN-WEYBRIDGE | PROJECT NO.: BHO-BTN 2005(1) |
| DESIGN FILE NAME: /usr/str4/89J081/sj081bdr.dgn | |
| IPARM FILE NAME: sj081la3.i | PLOT DATE: 28-FEB-2007 |
| SURVEYED BY: R. MOREAU | SURVEY DATE: 7/90 |
| SQUAD LEADER: C.P. WILLIAMS | DRAWN BY: W.B. SYMONDS |
| LAYOUT SHEET 3 | SHEET: 8 OF 53 |

# Profile

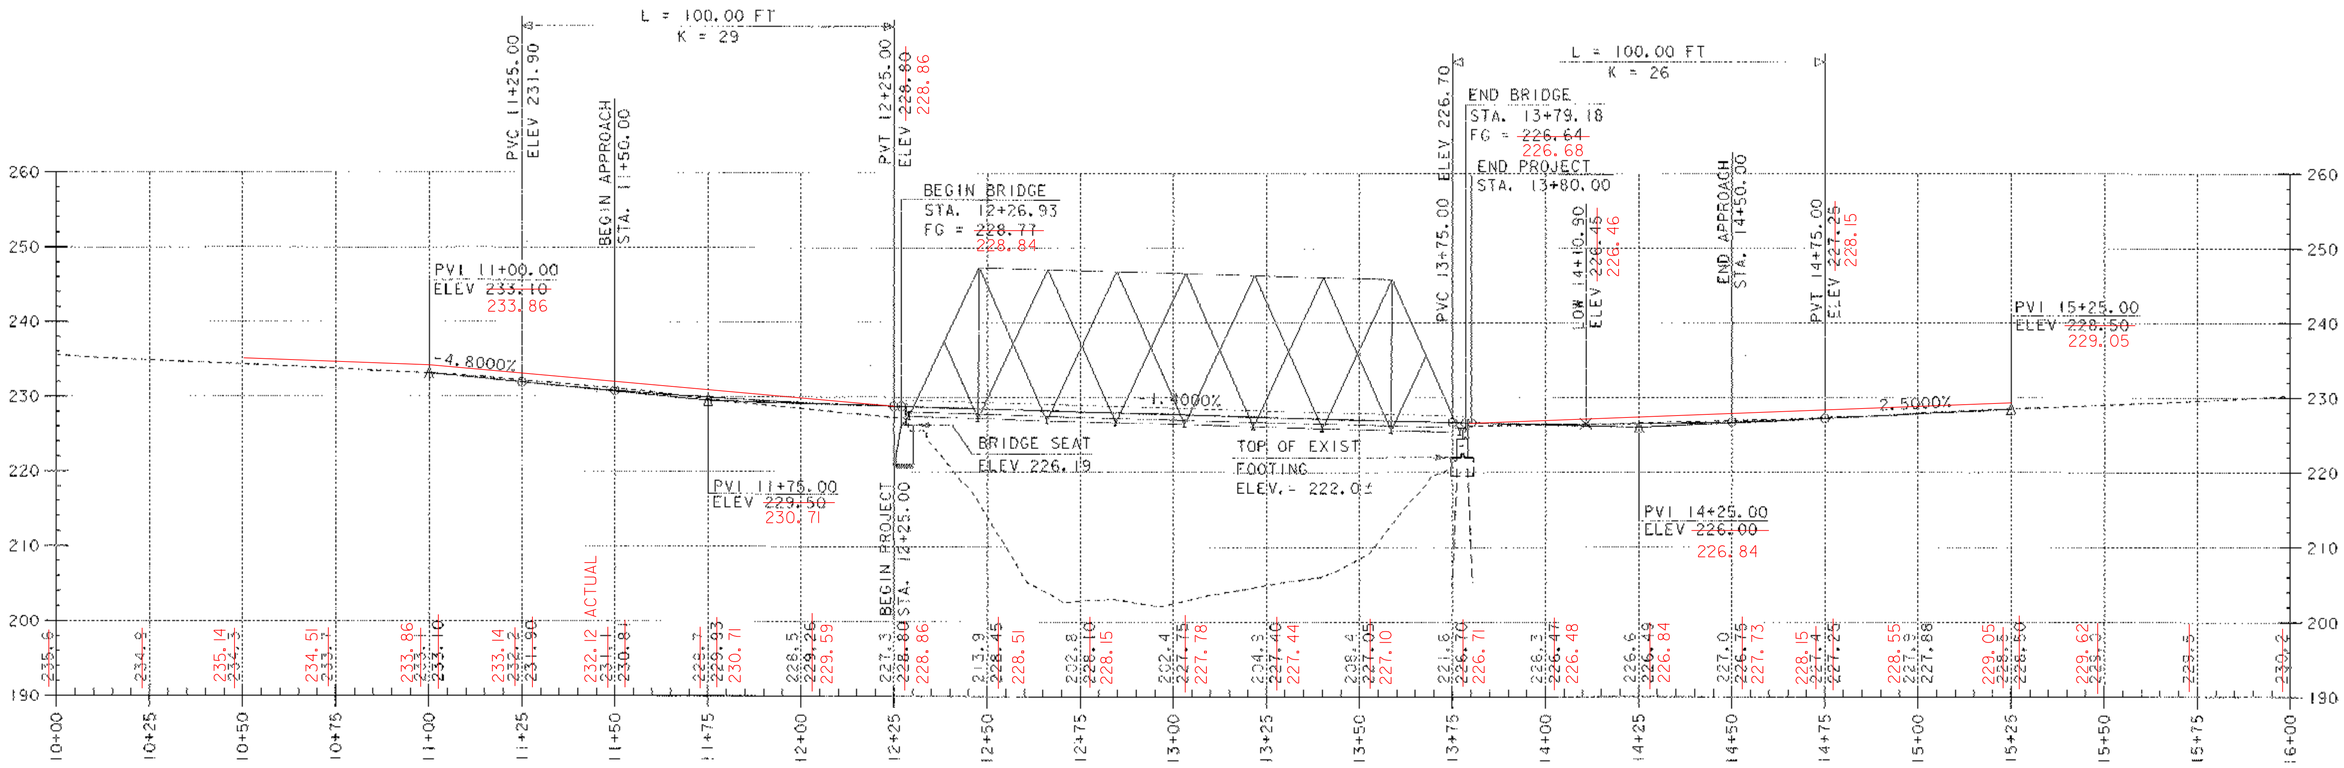


VERTICAL 0 10 20 30

HORIZONTAL 0 20 40 60

SCALE IN FEET


NOTE: EXISTING CENTERLINE ELEVATIONS ARE SHOWN TO THE TENTH.
PROPOSED CENTERLINE ELEVATIONS ARE SHOWN TO THE HUNDREDTH.

DATUM
VERTICAL NGVD 1929
HORIZONTAL ASSUMED


| | |
|---|---|
| PROJECT: NEW HAVEN-WEYBRIDGE | PROJECT NO.: BHO-BTN 2005(1) |
| DESIGN FILE NAME: /usr/str4/89j081/sj081prl.dgn | |
| IPARM FILE NAME: sj081pro.I | PLOT DATE: 28-FEB-2007 |
| SURVEYED BY: R. MOREAU | SURVEY DATE: 7/90 |
| SQUAD LEADER: C.P. WILLIAMS | DRAWN BY: W.B. SYMONDS |
| PROFILE SHEET | SHEET: 9 OF 53 |

NOTE:


TEMPORARY TRAFFIC BARRIER SHALL BE PLACED AT BOTH ENDS OF THE BRIDGE AS SHOWN. THE BARRIER SHALL BE PAID FOR UNDER ITEM 621.90 "TEMPORARY TRAFFIC BARRIER".

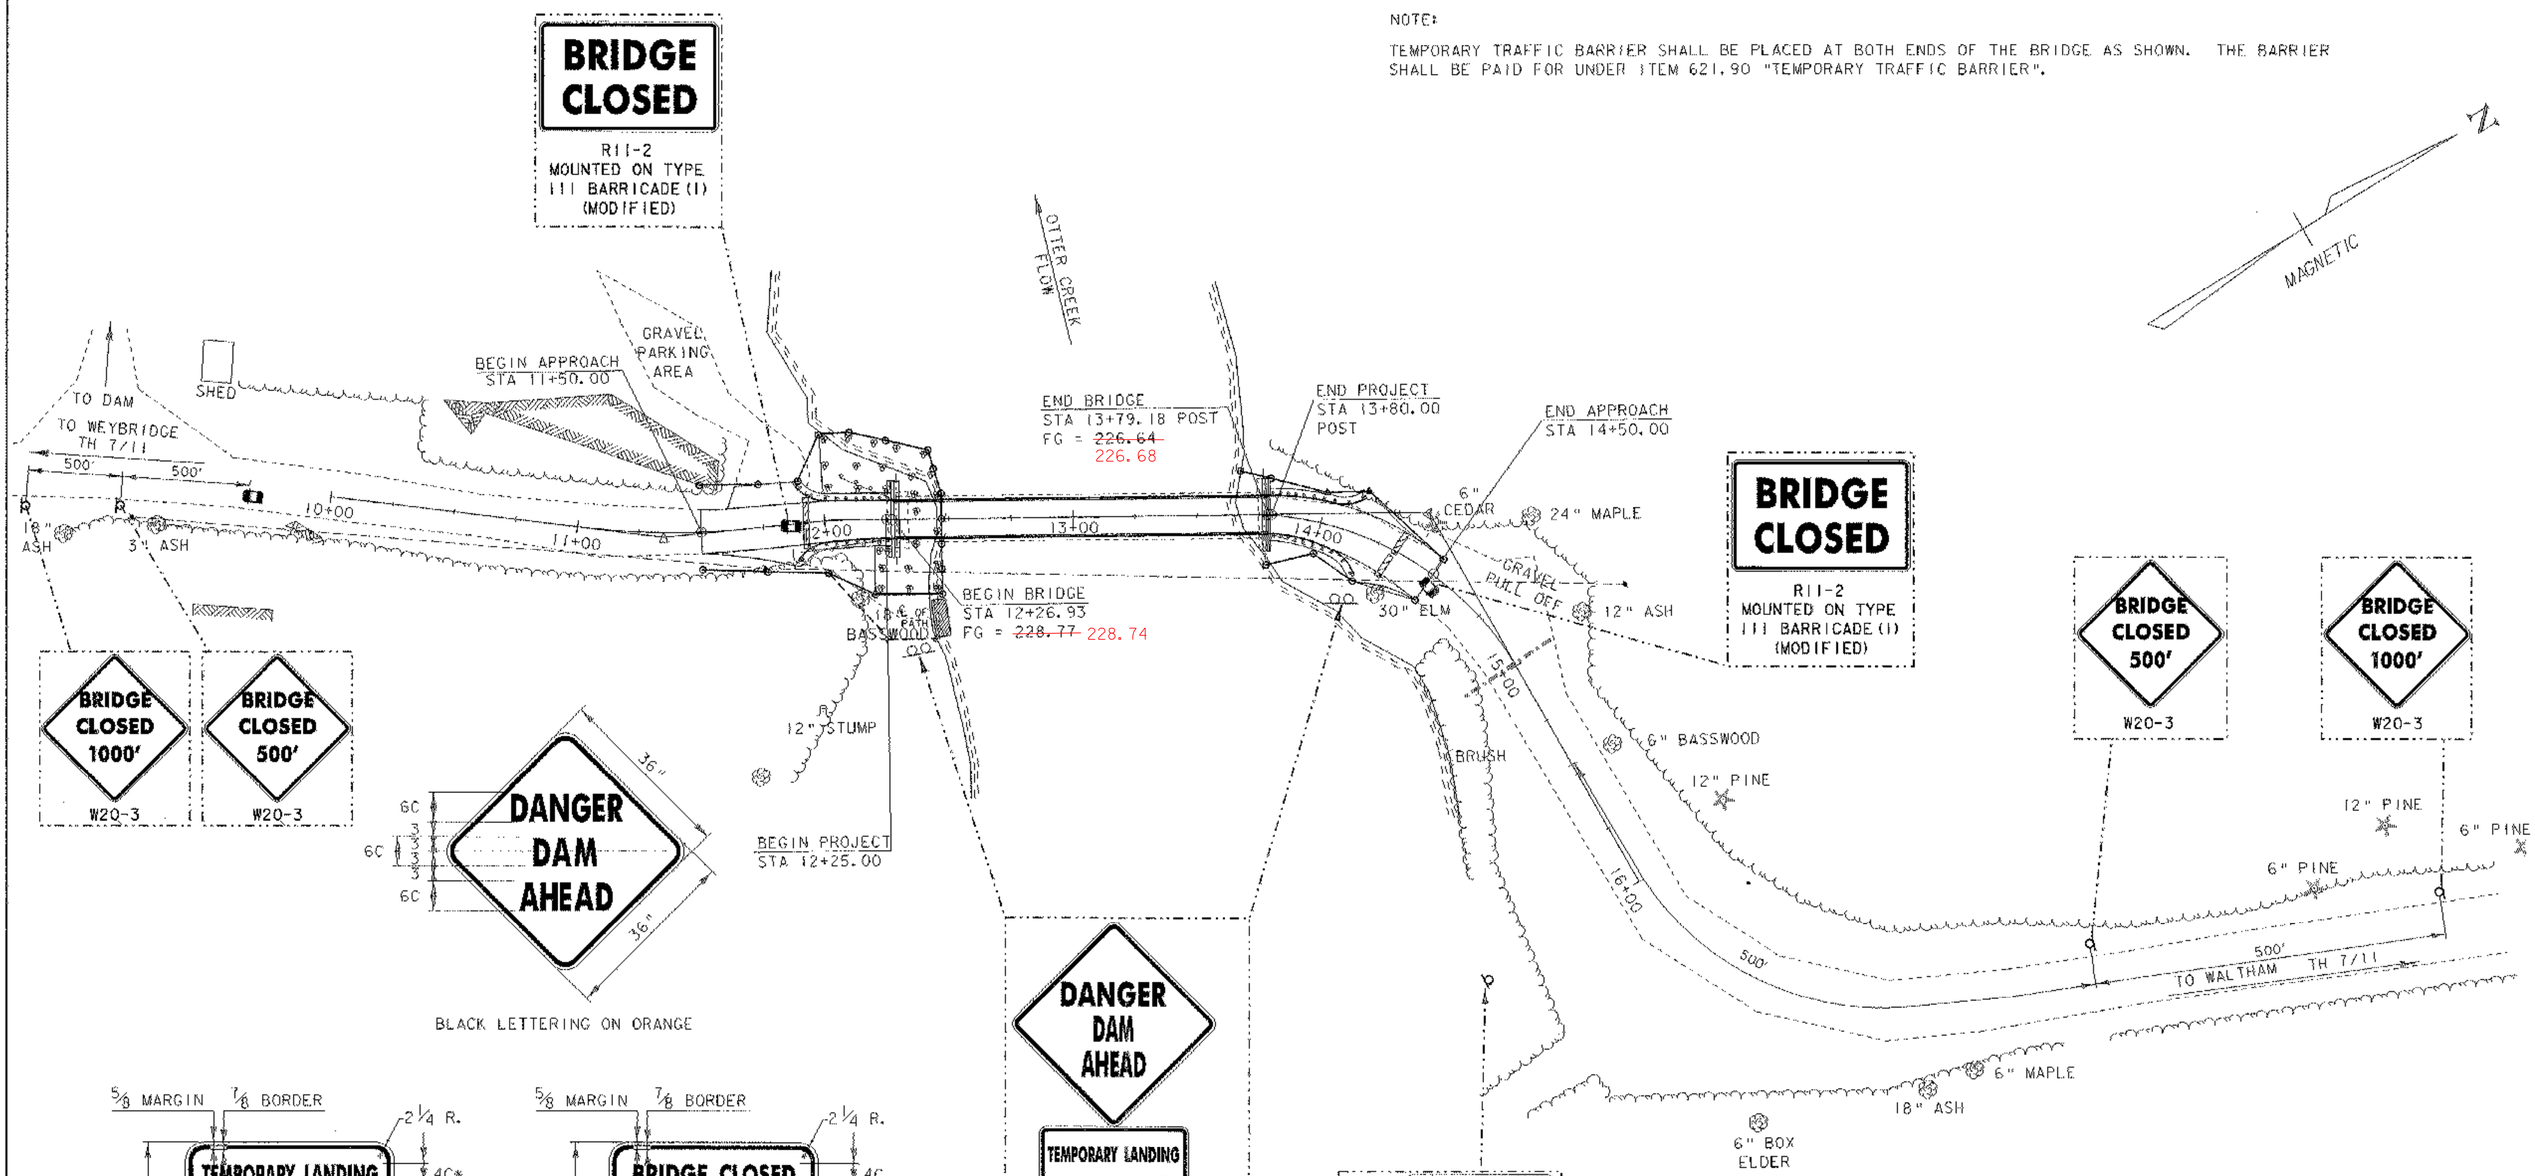


BLACK LETTERING ON ORANGE

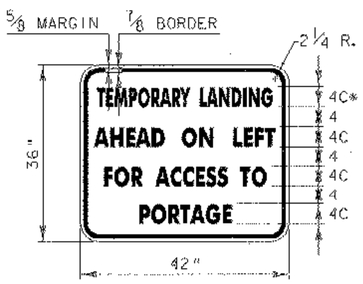


BLACK LETTERING ON ORANGE
*REDUCE SPACING BY 76%

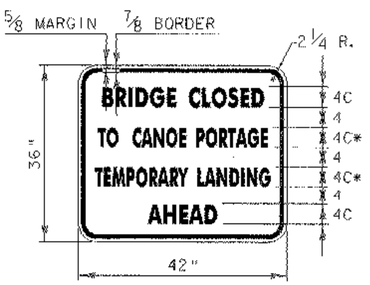


BLACK LETTERING ON ORANGE
*REDUCE SPACING BY 76%

THESE SIGNS SHALL BE VISIBLE AT ALL TIMES DURING CONSTRUCTION INCLUDING ALL PAINTING OPERATIONS


TO BE PLACED AT LOCATION OF EXISTING CANOE PORTAGE LANDING.

DATUM
VERTICAL NGVD 1929
HORIZONTAL ASSUMED

# TRAFFIC CONTROL SHEET


SCALE 1" = 30'-0
30 0 30

PROJECT: NEW HAVEN-WEYBRIDGE
PROJECT NO.: BHO-BTN 2005 (1)
DESIGN FILE NAME: /str4/89j081/sj081trf.dgn
IPARM FILE NAME: sj081det1
SURVEYED BY: R. MOREAU
SQUAD LEADER: C.P. WILLIAMS
TRAFFIC CONTROL SHEET
PLOT DATE: 28-FEB-2007
SURVEY DATE: 7/90
DRAWN BY: P.G. JARVIS
SHEET: 10 OF 53

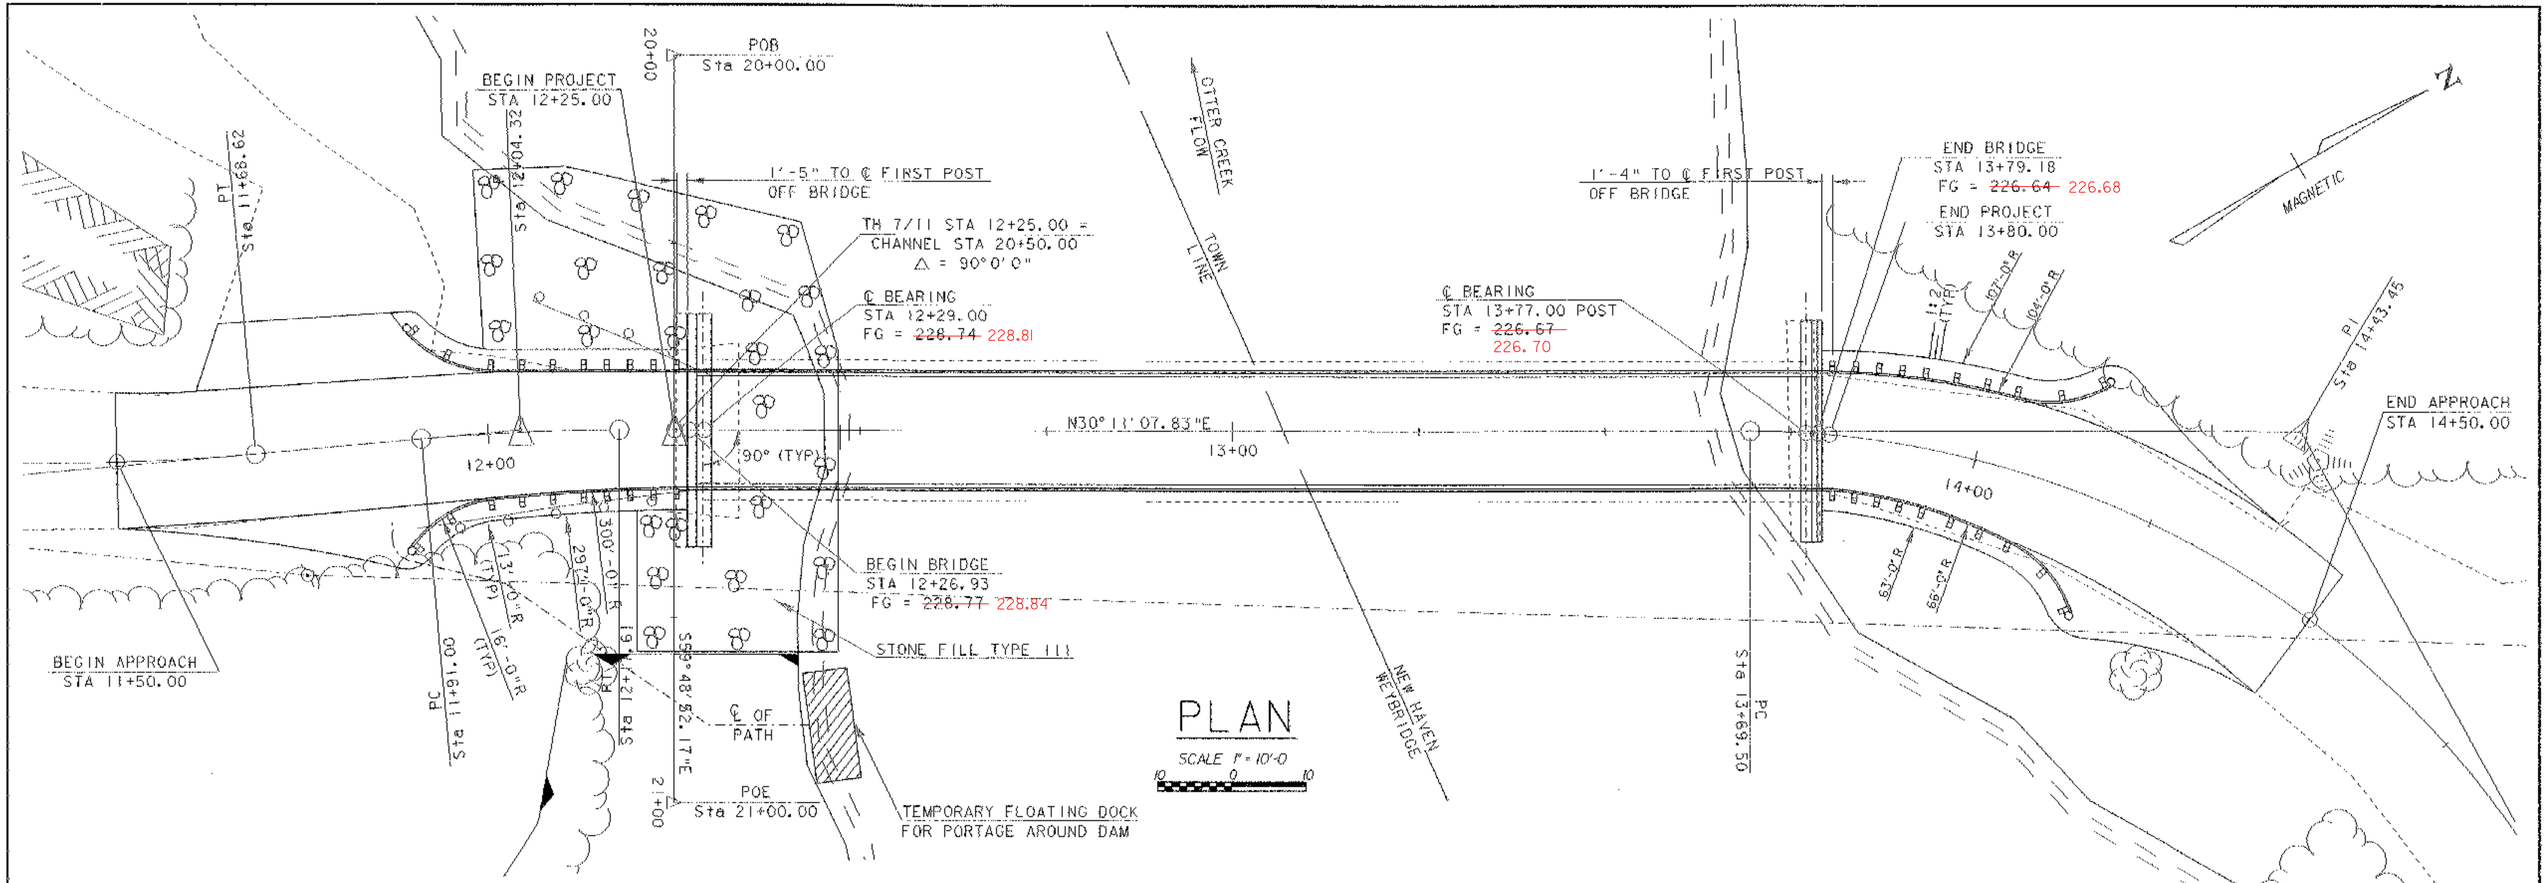


## PLAN

SCALE 1" = 10'-0

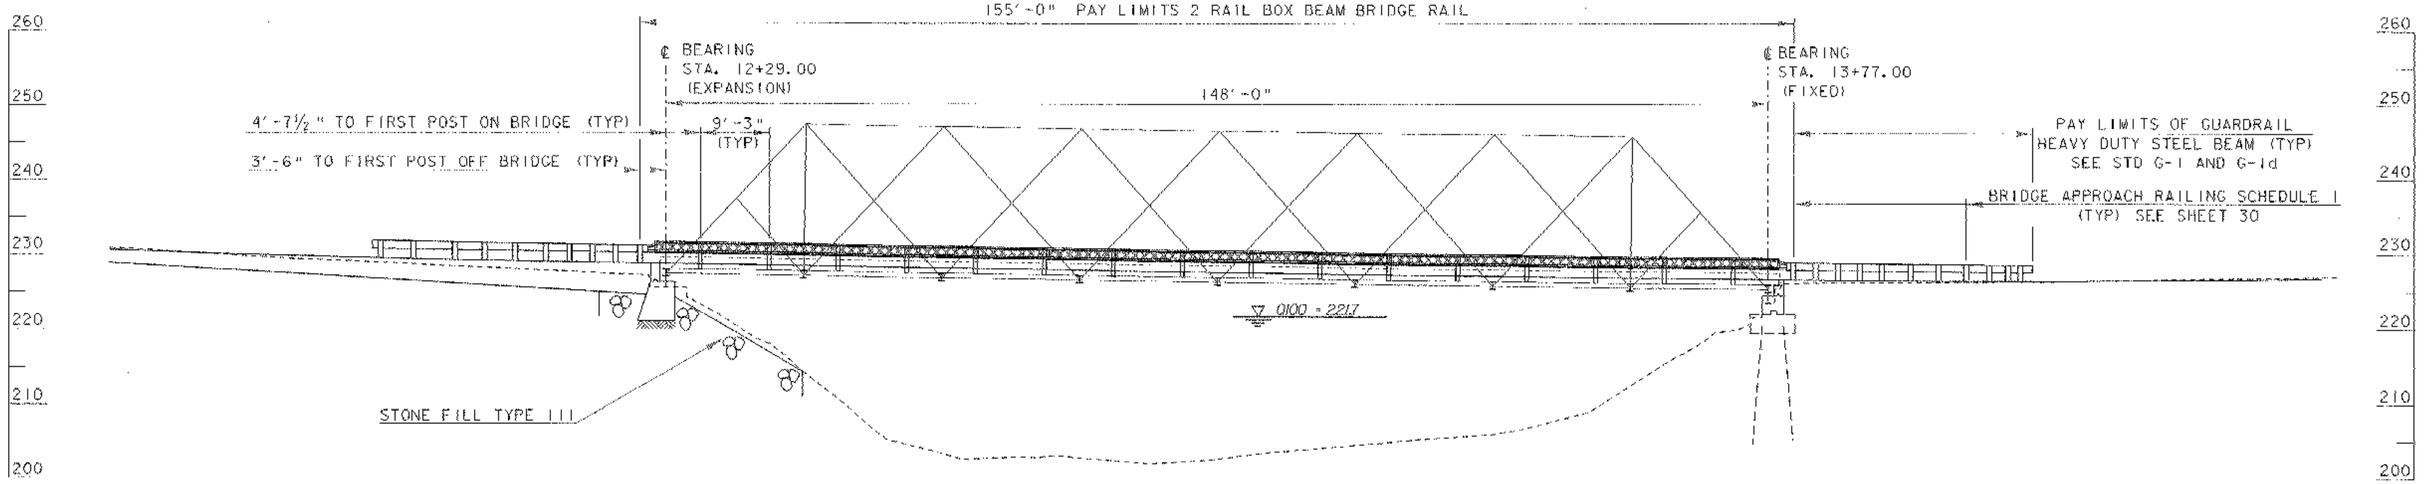


## ELEVATION

SCALE 1" = 10'-0

DATUM
VERTICAL NGVD 1929
HORIZONTAL ASSUMED

PROJECT: NEW HAVEN - WEYBRIDGE
PROJECT NO.: BHO-BTN 2005(1)
DESIGN FILE NAME: str-4/89j081/sj081pe.dgn
PARM FILE NAME: sj081pe.i
SURVEYED BY: R. MOREAU
SQUAD LEADER: C.P. WILLIAMS
PLAN AND ELEVATION SHEET
PLOT DATE: 28-FEB-2007
SURVEY DATE: 7/90
DRAWN BY: P.G. JARVIS
SHEET: 11 OF 53

## GENERAL NOTES

1. ALL MATERIALS AND CONSTRUCTION SHALL CONFORM TO STATE OF VERMONT, AGENCY OF TRANSPORTATION STANDARD SPECIFICATIONS FOR CONSTRUCTION, DATED 2006, AND ITS LATEST REVISIONS, AND THE AASHTO STANDARD SPECIFICATIONS FOR HIGHWAY BRIDGES, SEVENTEENTH EDITION. THE GLULAM DECK SHALL CONFORM TO THE NATIONAL DESIGN SPECIFICATION FOR WOOD CONSTRUCTION, 1997 EDITION. AND WITH THE STRUCTURAL GLUED LAMINATED TIMBER SUPPLEMENT.

2. ALL DIMENSIONS ARE HORIZONTAL OR VERTICAL AND ARE GIVEN AT 68 DEGREES F, UNLESS OTHERWISE NOTED.

3. DESIGN MEETS H20-44 LIVE LOADING (POSTED RATING).

4. BRIDGE 26 SHALL REMAIN CLOSED TO THROUGH TRAFFIC DURING CONSTRUCTION. ACCESS TO THE GRAVEL PARKING AREA AT STA 11+75 LEFT AND THE GRAVEL PULL OFF AT STA 14+75 LEFT WILL BE MAINTAINED AT ALL TIMES DURING CONSTRUCTION.

5. ALL PROJECT SIGNS AND BARRICADES ON SITE SHALL BE THE RESPONSIBILITY OF THE CONTRACTOR AND PAID FOR UNDER THE ITEM 641.10 "TRAFFIC CONTROL". ANY DETOUR SIGNS OFF SITE SHALL BE THE RESPONSIBILITY OF THE TOWNS OF NEW HAVEN AND WEYBRIDGE.

6. THE CONTRACTOR SHALL NOTIFY THE TOWNS OF NEW HAVEN AND WEYBRIDGE IN WRITING TWO WEEKS PRIOR TO CLOSING BRIDGE 26 TO TRAFFIC.

7. A TEMPORARY FLOATING DOCK SHALL BE CONSTRUCTED AT STA 12+50 RT. THE DOCK SHALL BE PAID FOR UNDER THE ITEM 900.645 "SPECIAL PROVISIONS (FLOATING DOCK)". SEE SPECIAL PROVISIONS FOR DETAILS.

8. ANY EXISTING SIGNS NOT REUSED SHALL REMAIN THE PROPERTY OF THE TOWN OF NEW HAVEN OR WEYBRIDGE. THE OWNERSHIP SHALL BE DETERMINED BY THE CURRENT LOCATION. THE CONTRACTOR SHALL REMOVE AND STOCKPILE SIGNS TO BE PICKED UP BY PHILIP BUSIER, ROAD FOREMAN, TOWN OF NEW HAVEN (453-3397) /BY ROBERT CYR, ROAD FOREMAN, TOWN OF WEYBRIDGE (545-2265).

9. ITEM 529.20 "PARTIAL REMOVAL OF STRUCTURE" SHALL INCLUDE THE FOLLOWING:

   - REMOVAL OF TRUSS MEMBERS AS DETAILED IN THE CONTRACT PLANS OR AS ORDERED BY THE ENGINEER.
   - REMOVAL OF FLOOR BEAMS, STRINGERS, ANY PLATES OR ANGLES CONNECTING THE FLOOR BEAMS TO THE TRUSS, AND BEARING ASSEMBLIES
   - REMOVAL OF ANY MEMBER WITH MORE THAN 25% SECTION LOSS, AS DETERMINED BY THE ENGINEER.
   - REMOVAL OF LATERAL BRACING BETWEEN FLOOR BEAMS.
   - REMOVAL AND DISPOSAL OF THE EXISTING BRIDGE DECKING.
   - REMOVAL OF LATTICE RAILING, TO BE REHABILITATED AS DETAILED ON SHEET 28, AND REMOVAL OF THE SUPPORTING PLATES AND ANGLES.
   - REMOVAL AND DISPOSAL OF PORTIONS OF ABUTMENT 2 AS DETAILED IN THE CONTRACT PLANS.
   - REMOVAL OF ANY PORTION OF ABUTMENT 1 NOT REMOVED UNDER ITEMS 204.25 "STRUCTURE EXCAVATION" OR 203.27 "UNCLASSIFIED CHANNEL EXCAVATION".

11. THESE PLANS WERE PREPARED BASED ON INFORMATION OBTAINED FROM FIELD MEASUREMENTS. THE CONTRACTOR MAY BE REQUIRED TO MAKE CHANGES TO THE DIMENSIONS SHOWN ON THE PLANS TO FIT THE ACTUAL FIELD CONDITIONS. THE CONTRACTOR SHALL FIELD VERIFY AND/OR OBTAIN ALL DIMENSIONS PRIOR TO FABRICATION.

12. THE ITEM 502.10 "SHORING SUPERSTRUCTURE" SHALL BE PAYMENT FOR SUPPORTING THE SUPERSTRUCTURE WHILE TRUSS COMPONENTS, SUBSTRUCTURES, AND BEARINGS ARE BEING PLACED. THE CONTRACTOR MAY CHOOSE TO MOVE THE TRUSS, SO THAT WORK MAY BE CONDUCTED AT A STAGING AREA. PAYMENT FOR REMOVAL AND REPLACEMENT SHALL BE INCLUDED UNDER ITEM 502.10.

## PAINTING NOTES

13. THE SURFACE PREPARATION OF THE EXISTING STEEL SHALL INCLUDE 100% REMOVAL OF THE EXISTING PAINT SYSTEM.

14. THE COLOR OF THE FINAL COAT OF PAINT SHALL BE GREEN AND SHALL CONFORM WITH FEDERAL STANDARD NO. 595, COLOR CHIP #14062.

15. AFTER THE FINAL COAT OF PAINT HAS BEEN APPLIED, AND HAS THOROUGHLY CURED, THE FOLLOWING STRUCTURAL STEEL SHALL BE GREASED PER SPECIFICATION 513:

    -FLOOR BEAMS
    -ALL TRUSS COMPONENTS BELOW THE TOP OF CURB
    -BEARINGS

16. PAYMENT FOR THE GREASE SHALL BE INCIDENTAL TO THE ITEM 513.30 "STRUCTURAL PAINTING FIELD APPLIED". THE COLOR OF THE GREASE SHALL BE GREEN.

17. ALL NEW STEEL ELEMENTS PROVIDED UNDER ITEM 506.50 "STRUCTURAL STEEL (ROLLED BEAM)" SHALL BE GIVEN AN APPROVED SHOP APPLIED PAINT SYSTEM PER SPECIFICATION 513. ALL EXISTING STEEL AND NEW STEEL UNDER THE ITEM 506.60 "STRUCTURAL STEEL", EXCEPT STEEL TO BE GALVANIZED, SHALL BE GIVEN A FIELD APPLIED PAINT SYSTEM PER SPECIFICATION 513.

18. THE PAINT SYSTEM USED IN THE FIELD AND THE SHOP APPLIED PAINT SYSTEMS SHALL BE COMPATIBLE AND PROVIDED FROM THE SAME MANUFACTURER.

19. ALL FAYING SURFACES SHALL MEET THE CLASS "B" SLIP COEFFICIENT AS SPECIFIED IN THE "AASHTO STANDARD SPECIFICATIONS FOR HIGHWAY BRIDGES". THE FAYING SURFACES ON THE TRUSS WHERE THE NEW FLOOR BEAMS CONNECT SHALL BE BLAST CLEANED AND PRIMED IN ACCORDANCE WITH SPECIFICATION 513, PRIOR TO THE INSTALLATION OF THE NEW STEEL ELEMENTS.

## CONCRETE NOTES

20. THE MINIMUM COVER FOR REINFORCING STEEL IN THE SUBSTRUCTURES SHALL BE TWO INCHES ALONG WALL FACES AGAINST EARTH, AND THREE INCHES ELSEWHERE UNLESS DETAILED OTHERWISE.

21. REINFORCING STEEL PLACEMENT TOLERANCES SHALL BE AS FOLLOWS:

| | |
|---|---|
| SPACING | +/- 1" |
| CLEARANCE | +/- 1/4" |

22. ALL EXPOSED EDGES OF CONCRETE SHALL BE CHAMFERED 1" X 1".

23. WATER REPELLENT SHALL BE APPLIED TO ALL EXPOSED CONCRETE SURFACES.

24. JOINTS AND SCORE MARKS IN CONCRETE SHALL BE CONSTRUCTED AS INDICATED ON THE PLANS OR AS DIRECTED BY THE ENGINEER.

25. SURFACES OF BRIDGE SEATS UNDER THE BEARING DEVICES SHALL BE LEVEL. OTHER AREAS OF THE BRIDGE SEAT SHALL BE SLOPED 2.0%. THE ABUTMENT SEATS SHALL BE SLOPED FULL WIDTH TOWARD MIDSPAN. THE ENTIRE BRIDGE SEAT SURFACE SHALL BE GIVEN A MAGNESIUM FLOAT FINISH.

26. CONCRETE PORTIONS OF THE ABUTMENT ABOVE THE ADJACENT BRIDGE SEAT ELEVATIONS SHALL NOT BE PLACED UNTIL THE TRUSS HAS BEEN PLACED AND FINISH GRADE HAS BEEN DETERMINED BY THE RESIDENT ENGINEER.

27. THE KEY IN CONCRETE CONSTRUCTION JOINTS SHALL BE MONOLITHIC AND CONTINUOUS FOR THE FULL LENGTH OF THE JOINT. UPWARD KEYS SHALL BE PLACED INTEGRALLY WITH THE CONCRETE BELOW THE JOINT.

## STEEL NOTES

28. THE NEW FLOORBEAMS, LATERAL BRACING, AND NEW TRUSS MEMBERS SHALL BE PAID FOR UNDER THE ITEM 506.50 "STRUCTURAL STEEL (ROLLED BEAM)". ALL OTHER PLATES, ANGLES, NEW LATTICE RAILING, AND STRUCTURAL TUBING FOR DOWN SPOUT SHALL BE INCLUDED UNDER THE ITEM 506.60 "STRUCTURAL STEEL".

29. ALL STRUCTURAL STEEL PAID FOR UNDER THE ITEM 506.50 "STRUCTURAL STEEL (ROLLED BEAM)" AND ITEM 506.60 "STRUCTURAL STEEL" SHALL CONFORM TO AASHTO M-270 GRADE 50. EXCEPT ALL STRUCTURAL TUBING SHALL CONFORM TO ASTM A-500 GRADE B.

30. ALL NEW STRUCTURAL STEEL ELEMENTS SUBJECT TO TENSION SHALL BE CHARPY V-NOTCH TESTED. THESE MEMBERS ARE DESIGNATED BY (CVN) IN THE APPLICABLE DETAILS. ANY REPAIRS ORDERED BY THE ENGINEER SUBJECT TO TENSION WILL ALSO REQUIRE CHARPY V-NOTCH TESTING.

31. ANY RIVETS THAT ARE REMOVED FOR REPAIRS DETAILED ON THE PLANS OR AS ORDERED BY THE ENGINEER SHALL BE REPLACED WITH 3/4" DIAMETER HIGH STRENGTH BOLTS MEETING AASHTO M-164 TYPE 1. ALL BOLTS SHALL BE FULL DIAMETER BODY ROUND HEAD BOLTS MEETING ANSI/ASME B 18.5 REQUIREMENTS, EXCEPT BOLTS FOR THE NEW LATTICE RAILING SHALL BE 7/16" DIAMETER, AND BOLTS FOR THE NEW COVER PLATE SHALL BE 5/8" DIAMETER, MEETING THE REQUIREMENTS ABOVE.

32. CONNECTIONS NOT DETAILED SHALL BE DETAILED BY THE FABRICATOR AND SUBMITTED TO THE PROJECT MANAGER FOR APPROVAL.

33. ALL BOLTS SHALL BE GALVANIZED IN ACCORDANCE WITH AASHTO M-298. FASTENERS FOR THE TRUSS SHALL RECEIVE INTERMEDIATE AND FINAL COATS OF PAINT AFTER INSTALLATION. FASTENERS FOR THE GLULAM DECK SHALL BE GALVANIZED ONLY.

34. EXISTING FLOOR BEAMS, STRINGERS, AND TRUSS MEMEBERS THAT ARE REMOVED SHALL BECOME PROPERTY OF THE CONTRACTOR. THE EXISTING STEEL IS PAINTED WITH A MATERIAL THAT MAY CONTAIN LEAD. THE CONTRACTOR MAY DISPOSE OF IT OR RETAIN IT FOR FUTURE USE. THE CONTRACTOR SHALL INFORM THE RESIDENT ENGINEER OF HIS/HER PLANS FOR DISPOSAL OR RETENTION OF THE STEEL PRIOR TO ITS REMOVAL.

35. THE EDGES OF THE GUSSET PLATES SHALL BE CAULKED AT THE LOCATION WHERE THEY MEET THE TRUSS MEMBERS. THE CAULK SHALL BE APPLIED BEFORE THE FINAL COAT OF PAINT. THE CONTRACTOR SHALL SUBMIT TO THE PROJECT MANAGER THE TYPE OF CAULK TO BE USED ALONG WITH THE MANUFACTURER'S RECOMMENDED USE. PAYMENT FOR THE CAULKING SHALL BE INCIDENTAL TO ITEM 513.30 "STRUCTURAL PAINTING, FIELD APPLIED".

## LEDGE NOTES

36. NO LEDGE SHALL BE EXCAVATED TO PLACE THE STONE FILL TYPE III. ANY SMOOTH LEDGE SHALL BE MECHANICALLY ROUGHENED TO KEY IN THE STONE FILL IF DEEMED NECESSARY BY THE RESIDENT ENGINEER. PAYMENT FOR ROUGHENING THE LEDGE SHALL BE CONSIDERED INCIDENTAL TO STONE FILL TYPE III.


37. ABUTMENT 1 SHALL BE FOUNDED ON LEDGE WHICH HAS BEEN CLEANED OF ALL LOOSE ROCK AND OTHER DEBRIS. THE LEDGE SHALL BE REMOVED AS REQUIRED TO ENSURE PLACEMENT ON COMPETENT ROCK. PAYMENT FOR ANY LEDGE REMOVAL SHALL BE INCLUDED UNDER ITEM 204.25 "STRUCTURE EXCAVATION".

38. DOWELS SHALL BE DRILLED AND GROUTED INTO LEDGE AT ABUTMENT 1 AND INTO EXISTING CONCRETE AT ABUTMENT 2 AS SHOWN ON THE PLANS. THE DOWELS SHALL HAVE A 2'-0" EMBEDMENT LENGTH AND SHALL EXTEND INTO THE NEW CONCRETE A MINIMUM OF 1'-6" UNLESS NOTED OTHERWISE. THE DRILLING AND GROUTING SHALL BE PAID FOR UNDER THE ITEM 507.16 "DRILLING AND GROUTING DOWELS", HOWEVER THE DOWELS SHALL BE PAID FOR UNDER THE ITEM 507.15 "REINFORCING STEEL".

39. UPON COMPLETION OF THE STRUCTURE EXCAVATION, AND PRIOR TO THE PLACING OF THE CONCRETE FORMS, THE RESIDENT ENGINEER SHALL CONTACT THE SOILS AND FOUNDATIONS ENGINEER/ENGINEERING GEOLOGIST FROM THE VERMONT AGENCY OF TRANSPORTATION, TO INSPECT THE ROCK TO DETERMINE IF IT IS COMPETENT TO SUPPORT THE DESIGN BEARING PRESSURE SHOWN ON THE PLANS. THE GEOLOGIST SHALL BE ALLOWED 5 WORKING DAYS FROM NOTICE OF EXCAVATION TO MAKE HIS INSPECTION AND REPORT HIS DETERMINATION ON THE COMPETENCY OF THE ROCK.


| PROJECT: | PROJECT NO.: |
|---|---|
| NEW HAVEN - WEYBRIDGE | BHO-BTN 2005(1) |

DESIGN FILE NAME: 89j081/structures/sj081notes.dgn
IPARM FILE NAME: sj081notes.i — PLOT DATE: 28-FEB-2007
DESIGNED BY: R.S. YOUNG — DRAWN BY: R.S. YOUNG
SQUAD LEADER: C.P. WILLIAMS — CHECKED BY: W.B. SYMONDS
GENERAL NOTES — SHEET: 12 OF 53

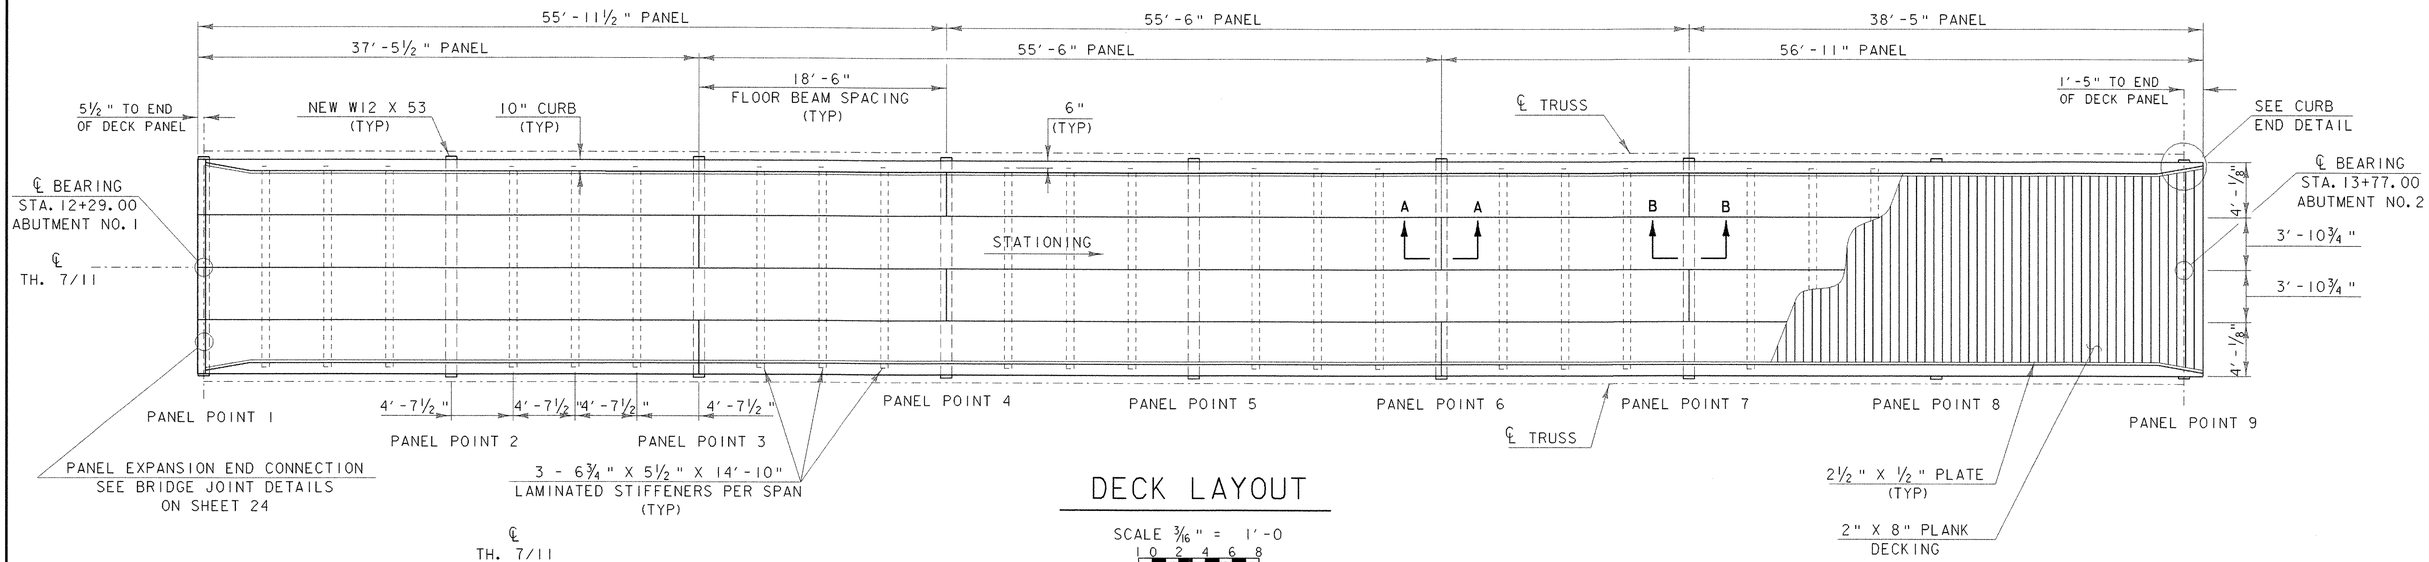



## DECK LAYOUT

SCALE 3/16" = 1′-0

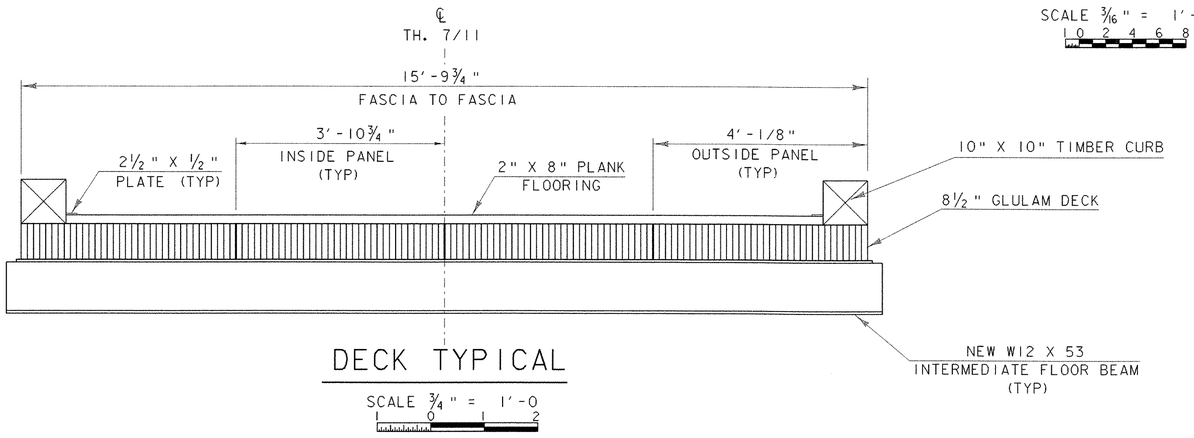


## DECK TYPICAL

SCALE ¾" = 1′-0

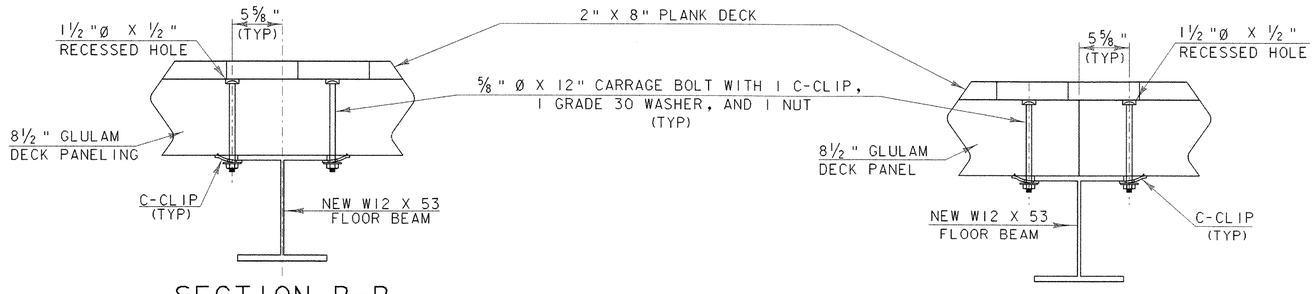



## SECTION B-B INTERMEDIATE PANEL CONNECTION

SCALE 1½" = 1′-0

## SECTION A-A CONNECTION AT PANEL JOINT


SCALE 1½" = 1′-0

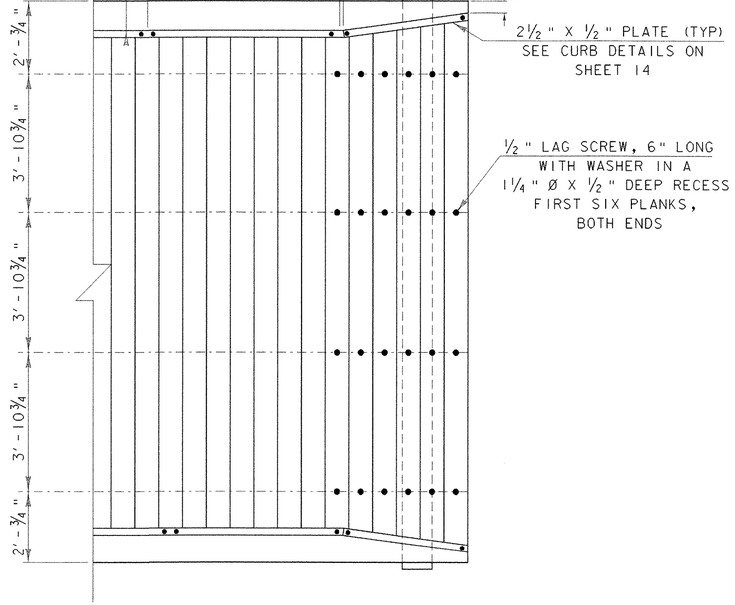


## DECK AND CURB DETAIL

SCALE ½" = 1′-0

| | |
|---|---|
| PROJECT: NEW HAVEN-WEYBRIDGE | PROJECT NO.: BHO-BTN 2005(1) |
| DESIGN FILE NAME: 89j081/structures/sj081deck.dgn | |
| IPARM FILE NAME: deckplan.i | PLOT DATE: 28-FEB-2007 |
| DESIGNED BY: R. S. YOUNG | DRAWN BY: D. A. ECKSTEIN |
| SQUAD LEADER: C. P. WILLIAMS | CHECKED BY: R.S. YOUNG |
| DECK DETAILS SHEET 1 | SHEET: 13 OF 53 |

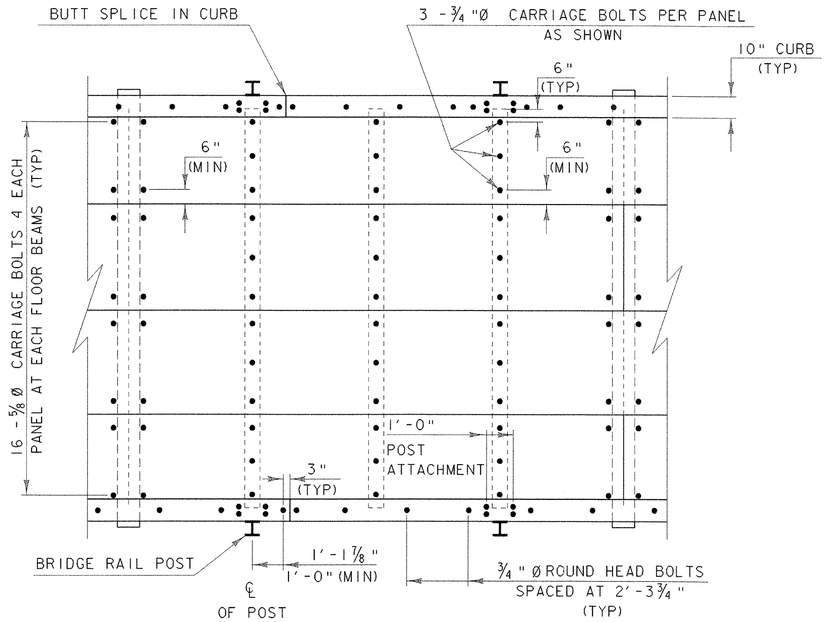



## BOLT DETAILS

(PLANK DECKING NOT SHOWN FOR CLARITY)

NOTE: SPLICE LOCATIONS OF CURB SHALL BE A MINIMUM 1'-3" FROM ℄ OF POST

SCALE ⅜" = 1'-0


1 0 1 2 3 4

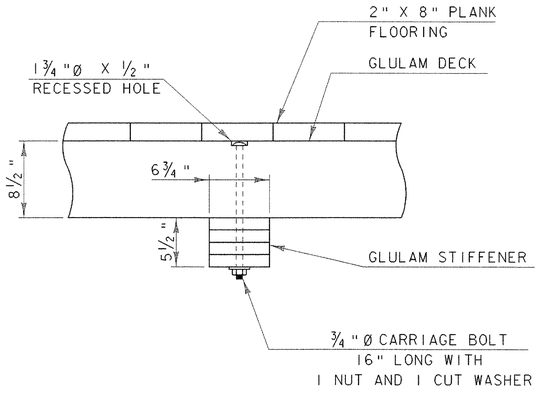


## TRANSVERSE STIFFENER DETAIL

SCALE 1 ½" = 1'-0

1 9 6 3 0 1

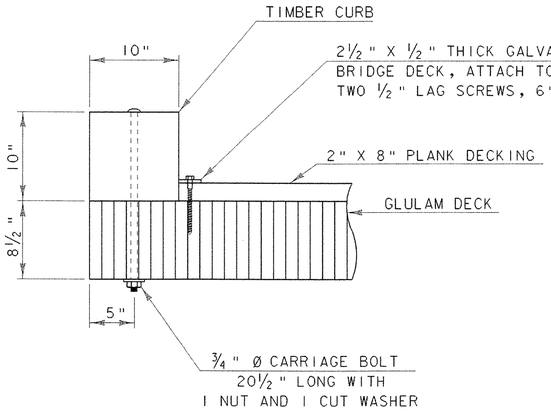



## CURB DETAIL

SCALE 1 ½" = 1'-0

1 9 6 3 0 1

## DECK NOTES:

1. THE GLULAM DECK PANELS AND TRANSVERSE STIFFENERS SHALL BE SOUTHERN PINE, COMBINATION SYMBOL 49 OR BETTER. THE CURB SHALL BE 10" X 10" ROUGH LUMBER, FULL SAWN, SOUTHERN PINE NO. 1 OR BETTER. THE PLANK DECKING SHALL BE 2" X 8", ROUGH LUMBER, FULL SAWN, EASTERN HEMLOCK NO. 1 OR BETTER.
2. THE GLULAM DECK PANELS, TRANSVERSE STIFFENERS, AND THE TIMBER CURB SHALL BE TREATED WITH A TYPE II (PENTACHLOROPHENOL) PRESERVATIVE PER SPECIFICATION 726, INCIDENTAL TO THE PAY ITEM OF THE WOOD TREATED.
3. ALL WOOD SHALL BE CUT, DRILLED, AND COMPLETELY FABRICATED PRIOR TO TREATMENT WITH PRESERVATIVES. WHEN FIELD FABRICATION OF WOOD IS REQUIRED OR IF WOOD IS DAMAGED, ALL CUTS, BORE HOLES, AND DAMAGE SHALL BE IMMEDIATELY TREATED WITH TWO APPLICATIONS OF A COPPER NAPHTHENATE SOLUTION.
4. THE GLULAM DECK PANELS AND TRANSVERSE STIFFENERS SHALL BE PAID FOR UNDER ITEM 522.40 "STRUCTURAL GLUED LAMINATED TIMBER." THE CURB SHALL BE PAID FOR UNDER 522.35 "NONSTRUCTURAL LUMBER, TREATED." THE PLANK DECKING SHALL BE PAID FOR UNDER ITEM 522.30 "NONSTRUCTURAL LUMBER, UNTREATED."
5. BOLTS SHALL BE ASTM A307. BOLTS, NUTS, WASHERS, AND C-CLIPS SHALL BE INCLUDED UNDER THE ITEM 522.40 "STRUCTURAL GLUED LAMINATED TIMBER." ALL HARDWARE SHALL BE GALVANIZED.
6. THE ANGLE USED AT ABUTMENT #2, AND PLATES USED TO ATTACH PLANK FLOORING, SHALL BE INCLUDED UNDER ITEM 506.60 "STRUCTURAL STEEL", AND SHALL BE GALVANIZED IN ACCORDANCE WITH AASHTO M111. THE SHEAR STUDS SHALL BE PAID FOR UNDER ITEM 508.15 "SHEAR CONNECTORS".
7. GROUPS OF SEVEN PLANKS SHALL BE KEPT IN PLACE BY THE ½" PLATE ONLY. THEY ARE INTENDED TO RATTLE. THE FIRST SIX PLANKS SHALL BE ATTACHED WITH LAG SCREWS AS SHOWN ON SHEET 13.
8. CLOSED CELL FOAM SHALL BE INCIDENTAL TO ITEM 522.40 AND SHALL CONFORM TO SPECIFICATION 707.09.

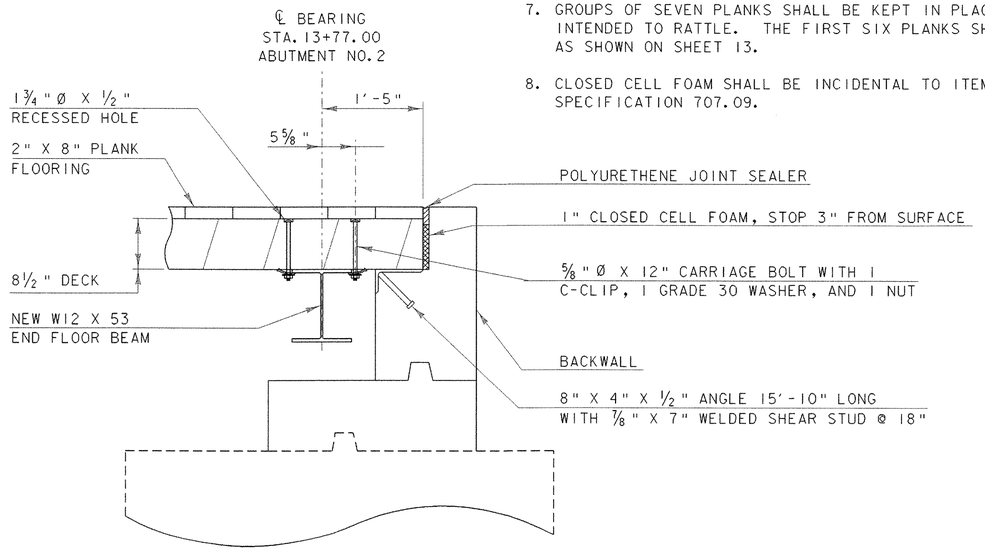



## FIXED END BRIDGE DETAIL AT ABUTMENT 2

(SEE SHEETS 23 AND 24 FOR HOLE LOCATIONS AT ABUTMENT 1)

SCALE 1" = 1'-0

1 9 6 3 0 1 2

| PROJECT: NEW HAVEN-WEYBRIDGE | PROJECT NO.: BH0-BTN 2005(1) |
|---|---|
| DESIGN FILE NAME: 89j081/structures/sj081deck.dgn | |
| IPARM FILE NAME: deckdt1.i | PLOT DATE: 28-FEB-2007 |
| DESIGNED BY: R. S. YOUNG | DRAWN BY: D. A. ECKSTEIN |
| SQUAD LEADER: C. P. WILLIAMS | CHECKED BY: R. S. YOUNG |
| DECK DETAILS SHEET 2 | SHEET: 14 OF 53 |

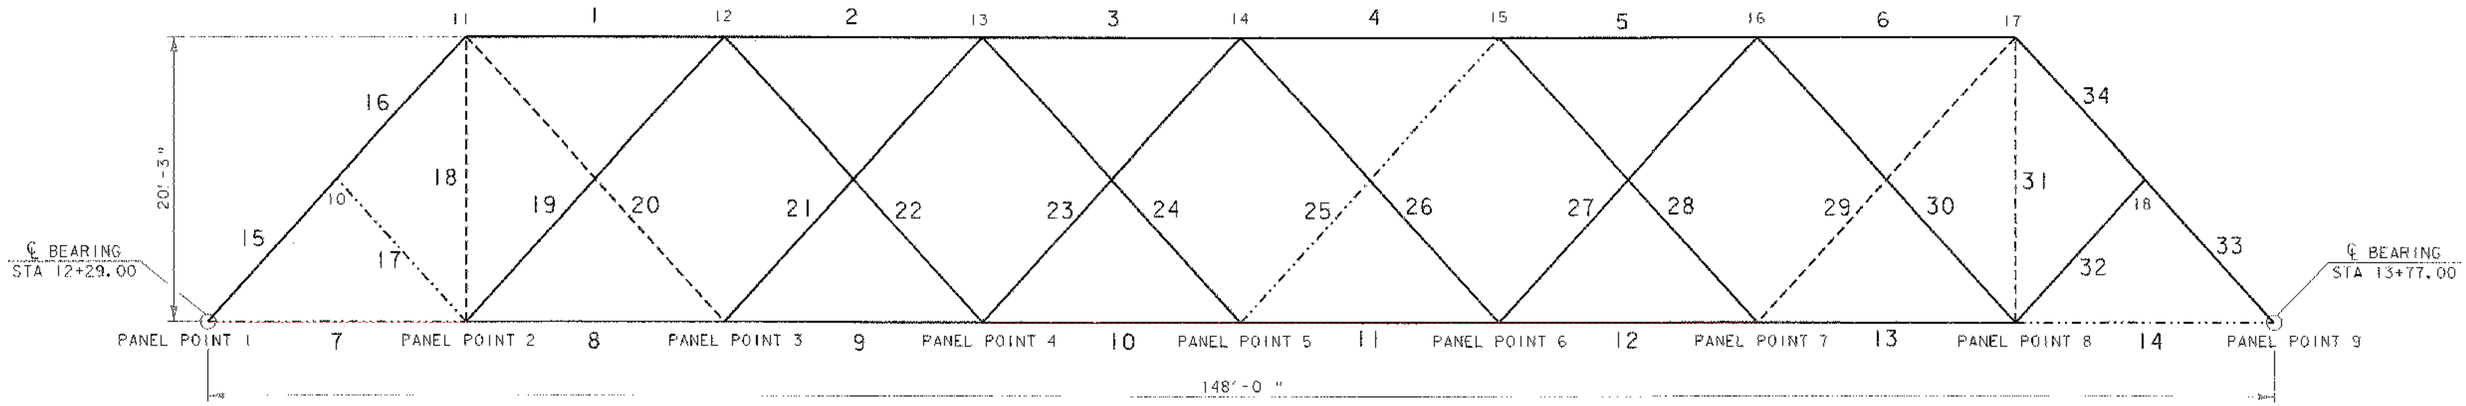


## TRUSS ELEVATION (TYP) (LOOKING WEST)


SCALE 3/16" = 1'-0

## TRUSS MEMBER REPLACEMENT CHART

| | |
|---|---|
| ---------- | MEMBERS TO BE REPLACED IN KIND WITH GRADE 50 STEEL<br>ALL ANGLES SHALL BE CHARPY V-NOTCH TESTED<br>- 18,31 ARE TWO 3" X 2½" X ¼" ANGLES<br>- 20,29 ARE TWO 3" X 2½" X ¼" ANGLES |
| ———— | MEMBERS TO BE REPLACED IN KIND WITH GRADE 50 STEEL IF MORE THAN 25% SECTION LOSS |
| ———·———·——— | MEMBERS TO BE REPLACED IN KIND WITH GRADE 50 STEEL ON THE UPSTREAM SIDE ONLY:<br>ALL ANGLES SHALL BE CHARPY V-NOTCH TESTED<br>- 17 IS TWO 3½" x 2½" x ¼" ANGLES<br>- 7,14 ARE FOUR 3" x 2½" x ¼" ANGLES<br>- 25 IS TWO 2½" x 2½" x¼" ANGLES |

10, 11 ARE FOUR 3½" X 3" X ¼" ANGLES
7 IS FOUR 3" X 2 ½" X ¼" ANGLE

12 IS FOUR 3 ½"X3"X ¼" ANGLES
(2 OF 4 REPLACED)

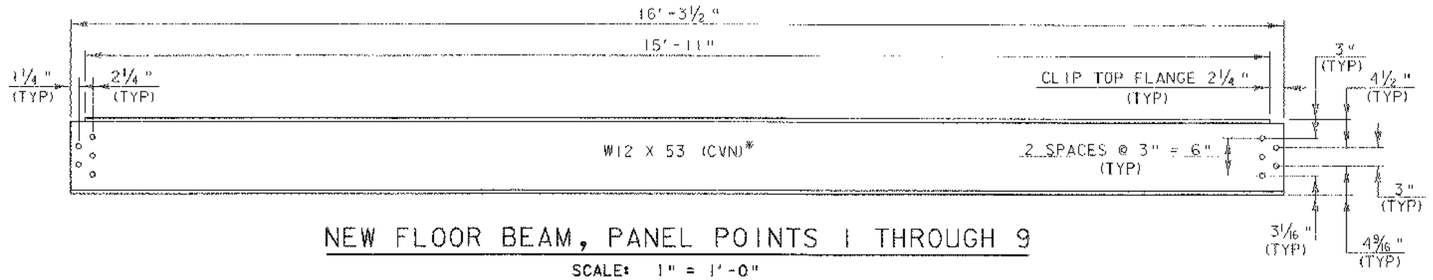


## NEW FLOOR BEAM, PANEL POINTS 1 THROUGH 9

SCALE: 1" = 1'-0"

* FLOOR BEAMS SHALL BE CHARPY V-NOTCH TESTED




## BOTTOM FLANGE OF FLOOR BEAM

SCALE: 1" = 1'-0"


(7 REQUIRED AS SHOWN, 2 REQUIRED WITH HOLES ALONG ONE SIDE OF ℄ OF BEAM ONLY)

## TRUSS NOTES

1. TRUSS MEMBERS SHALL BE REPLACED ACCORDING TO THE REPLACEMENT CHART.
2. ALL GUSSET PLATES SHALL BE REPLACED WITH ¼" THICK GRADE 50 STEEL.
3. ANY RIVETS THAT ARE REMOVED FOR REPAIRS DETAILED ON THE PLANS OR AS ORDERED BY THE RESIDENT ENGINEER SHALL BE REPLACED WITH ¾" DIAMETER, M-164, TYPE 1 BOLTS. THE CONTRACTOR SHALL VERIFY HOLE SIZE AND HOLE SPACING AS WELL AS GUSSET DIMENSIONS AT ALL LOCATIONS. HOLES FOR THE GUSSET PLATES MAY BE FIELD DRILLED.
4. HOLES IN THE EXISTING GUSSET PLATES FOR THE EXISTING RAIL SUPPORT SHALL BE OMITTED IN THE NEW GUSSET PLATES. THE EXISTING RAILING SHALL BE ATTACHED TO A NEW BOX BEAM RAIL.
5. WHEN EXISTING STEEL SIZES ARE NOT AVAILABLE, AN EQUIVALENT SIZE MAY BE SUBSTITUTED WITH APPROVAL OF THE PROJECT MANAGER.
6. THE EXISTING FLOORING SYSTEM INCLUDING TIMBER DECKING, STEEL STRINGERS, AND CHANNELS SHALL BE REMOVED AND REPLACED WITH GULAM DECK PANELS. SEE DECK DETAIL SHEETS 13 AND 14.
7. EXISTING FLOOR BEAMS ARE CURRENTLY HANGING BELOW THE TRUSS BOTTOM CHORDS. THE NEW FLOOR BEAMS AND LATERAL BRACING SHALL BE NESTED BETWEEN THE BOTTOM CHORDS. ONE FLOOR BEAM SHALL BE ADDED TO THE EXISTING FRAMING PLAN AT ℄ BEARING AT EACH END OF THE TRUSS. SEE FLOOR BEAM CONNECTION DETAILS ON SHEETS 18 AND 19.
8. THE ROUND HEAD END OF THE BOLTS SHALL BE VISIBLE FROM THE EXTERIOR SIDE OF THE TRUSS.
9. THE CONTRACTOR SHALL INSTALL THE FLOOR BEAMS SO THAT ANY SHOP CAMBER WILL BE POSITIVE.


SCALE 1" = 1'-0

| | |
|---|---|
| PROJECT: NEW HAVEN - WEYBRIDGE | PROJECT NO.: BHO-BTN 2005(1) |
| DESIGN FILE NAME: 89j081/structures/sj081truss.dgn | |
| IPARM FILE NAME: sj081trussdtl.i | PLOT DATE: 28-FEB-2007 |
| DESIGNED BY: R.S. YOUNG | DRAWN BY: R.S. YOUNG |
| SQUAD LEADER: C.P. WILLIAMS | CHECKED BY: R.S. YOUNG |
| TRUSS DETAILS | SHEET: 15 OF 53 |

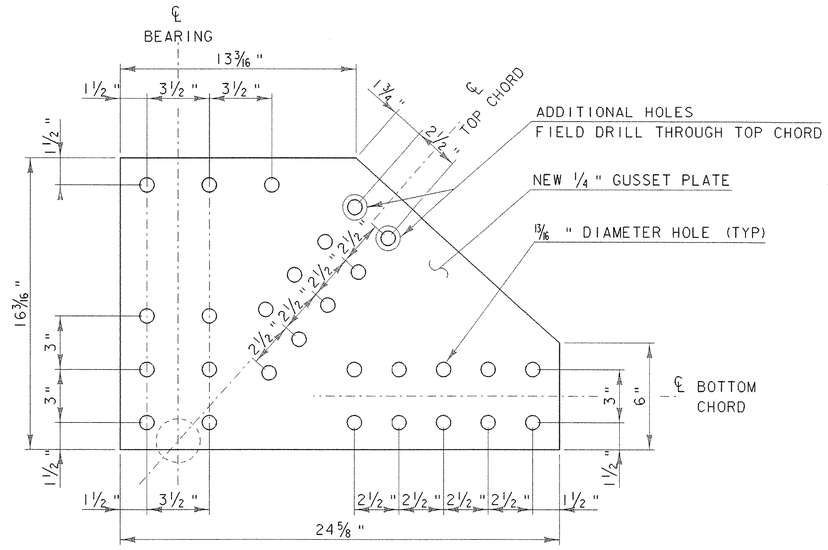



## GUSSET PLATE AT PANEL POINTS 1 AND 9

SCALE: 3" = 1'-0" (8 REQUIRED)

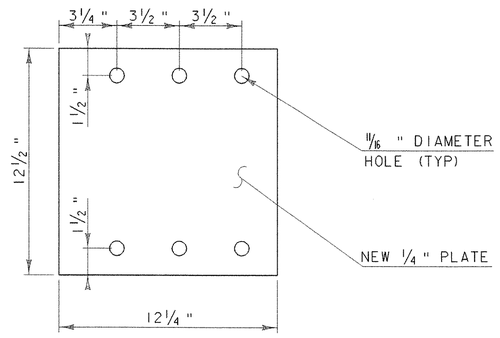



## COVER PLATE

SCALE: 3" = 1'-0" (4 REQUIRED)

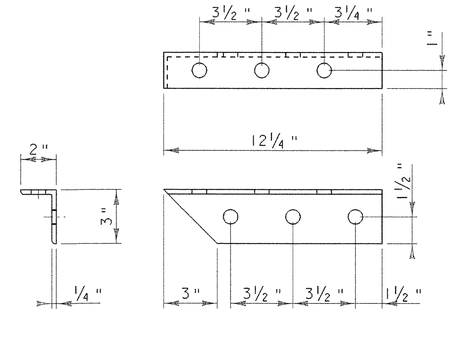



## LEFT COVER BRACE
## L 3"x2"x1/4"

SCALE: 3" = 1'-0" (4 REQUIRED)

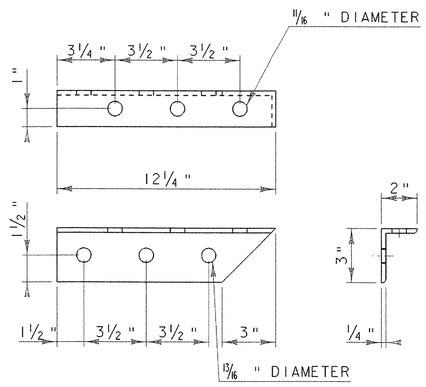



## RIGHT COVER BRACE
## L 3"x2"x1/4"

SCALE: 3" = 1'-0" (4 REQUIRED)

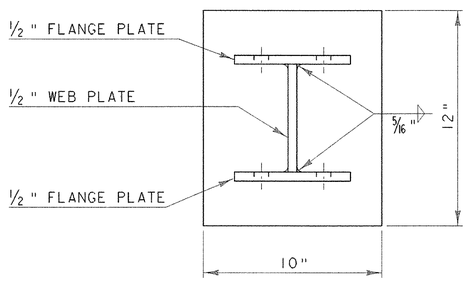



## BEARING COLUMN
## TOP VIEW

SCALE: 3" = 1'-0"

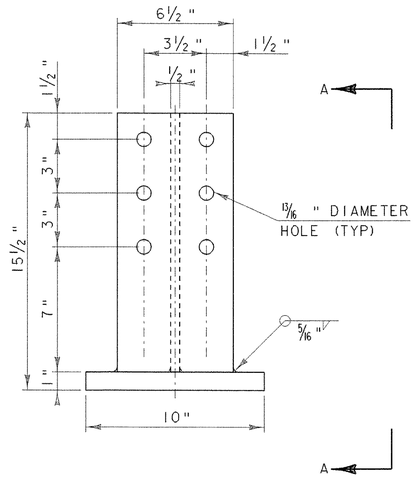



## BEARING COLUMN HOLE PATTERN

SCALE: 3" = 1'-0" (4 REQUIRED)

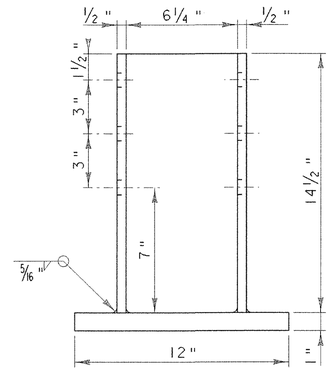


## VIEW "A-A"

SCALE: 3" = 1'-0"

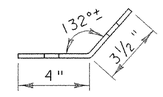



## NEW BENT PLATE

PL 12 1/2 " X 1/4 " X 7 1/2 " (4 REQUIRED)
SCALE: 3" = 1'-0"


SCALE 3" = 1'-0
1 9 6 3 0 1

| PROJECT: NEW HAVEN - WEYBRIDGE | PROJECT NO.: BHO-BTN 2005(1) |
|---|---|
| DESIGN FILE NAME: 89j081/structures/sj081truss.dgn | |
| IPARM FILE NAME: sj081platebeam.i | PLOT DATE: 28-FEB-2007 |
| DESIGNED BY: R.S. YOUNG | DRAWN BY: R.S. YOUNG |
| SQUAD LEADER: C.P. WILLIAMS | CHECKED BY: W.B. SYMONDS |
| BEARING PLATE AND COLUMN DETAILS | SHEET: 16 OF 53 |

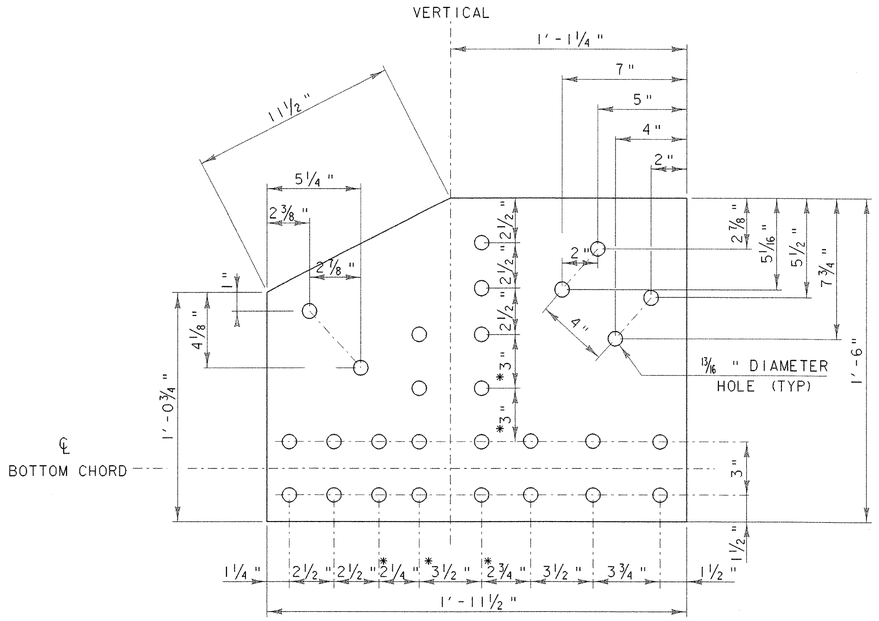



## PANEL POINTS 2 AND 8

SCALE 3" = 1'-0 (8 REQUIRED)

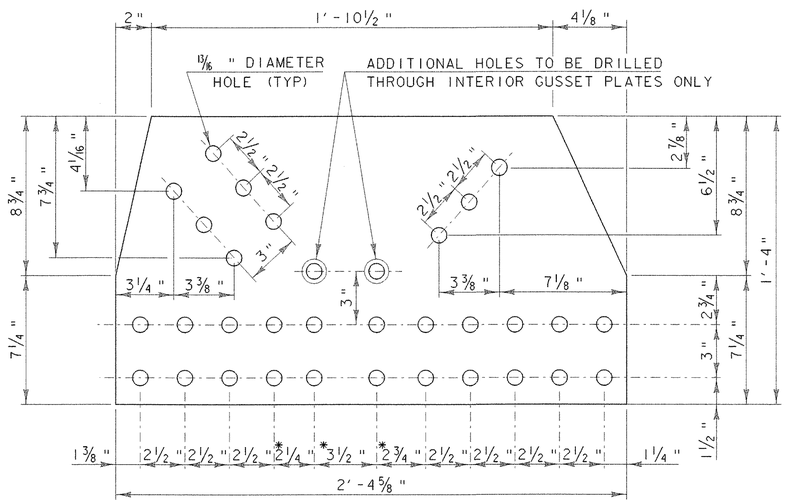



## PANEL POINTS 3 AND 7

SCALE 3" = 1'-0 (8 REQUIRED)

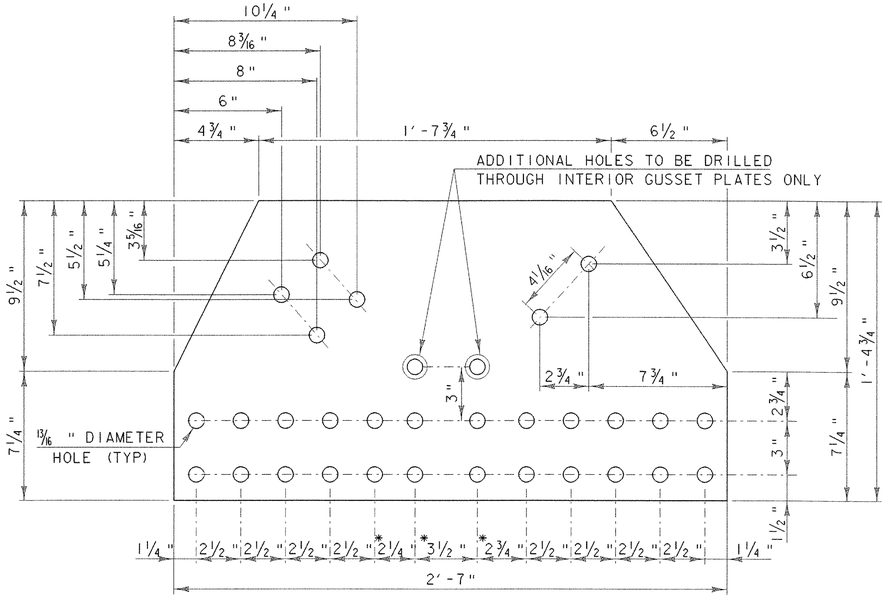


## PANEL POINTS 4 AND 6

SCALE 3" = 1'-0 (8 REQUIRED)

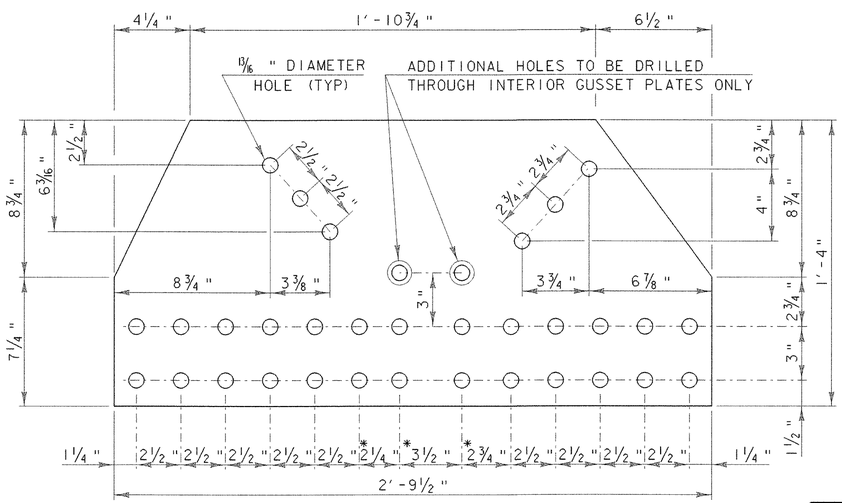


## PANEL POINT 5

SCALE 3" = 1'-0 (4 REQUIRED)


*NOTE- INTERIOR GUSSET PLATES ONLY

THE ORIGINAL SPACING HAS BEEN CHANGED FOR CONNECTION TO THE FLOOR BEAM. HOLES IN THE NEW VERTICAL ANGLES SHALL BE ADJUSTED ACCORDINGLY. HOLES IN THE EXISTING BOTTOM CHORD SHALL BE REAMED ¼" TO FIT THE NEW SPACING. REAMING SHALL BE INCIDENTAL TO ITEM 506.60 "STRUCTURAL STEEL."

SCALE 3" = 1'-0


1 9 6 3 0 1


| PROJECT: | PROJECT NO.: |
|---|---|
| NEW HAVEN - WEYBRIDGE | BHO-BTN 2005(1) |
| DESIGN FILE NAME: 89j081/structures/sj081truss.dgn | |
| IPARM FILE NAME: sj081gusset.i | PLOT DATE: 28-FEB-2007 |
| DESIGNED BY: R.S. YOUNG | DRAWN BY: M.C. LONGSTREET |
| SQUAD LEADER: C.P. WILLIAMS | CHECKED BY: R.S. YOUNG |
| GUSSET PLATES | SHEET: 17 OF 53 |

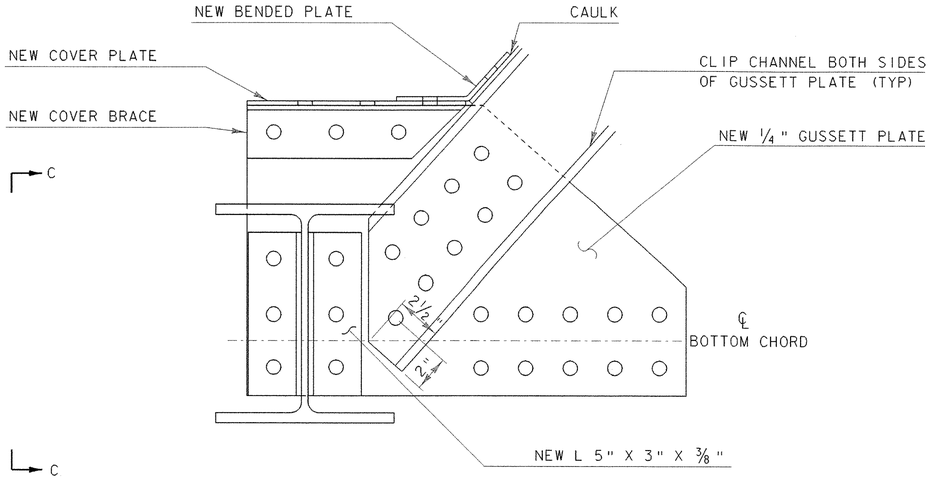


## FLOOR BEAM CONNECTION AT PANEL POINTS 1 AND 9


SCALE 3" = 1'-0

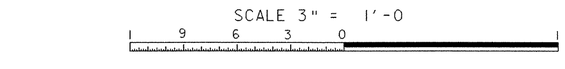


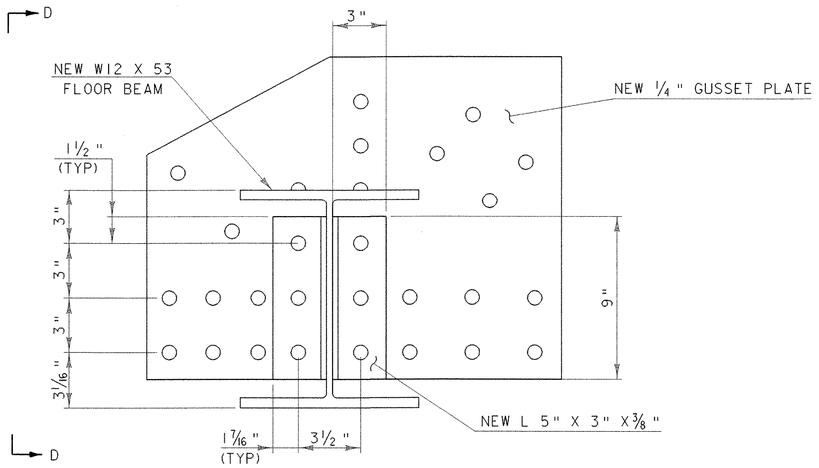
## FLOOR BEAM CONNECTON AT PANEL POINTS 2 THROUGH 8

SCALE 3" = 1'-0




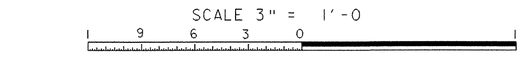


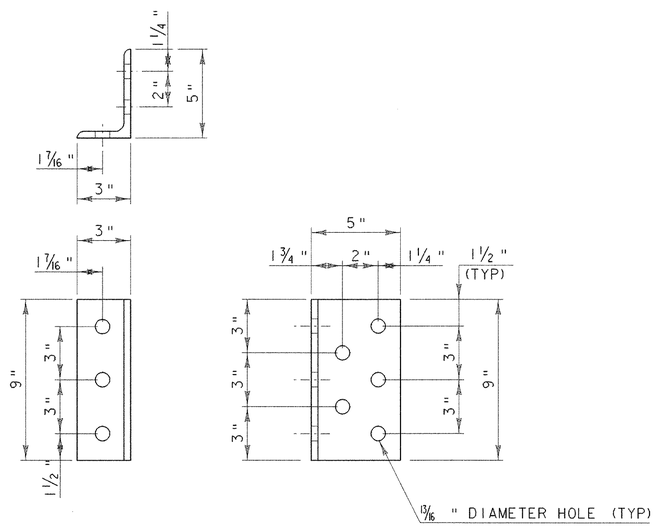

## ANGELS AT PANEL POINTS 1 THROUGH 9

(36 REQUIRED)

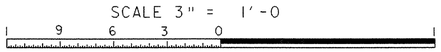
SCALE 3" = 1'-0

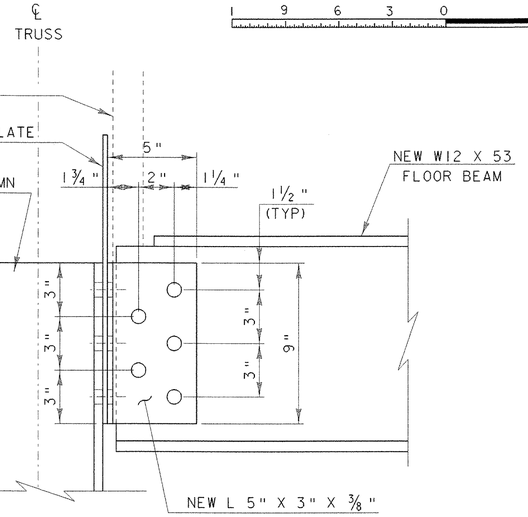



## VIEW C-C

SCALE 3" = 1'-0

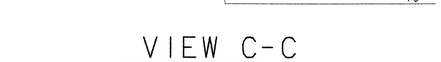



## VIEW D-D

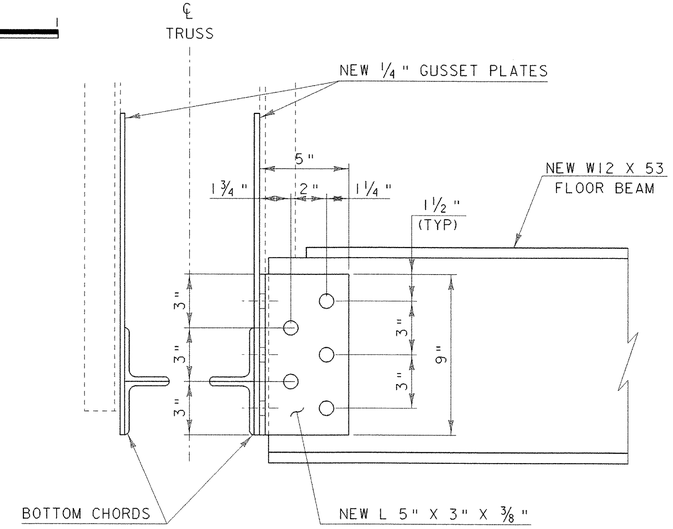SCALE 3" = 1'-0




NOTE: EXISTING ANGLES CONNECTING THE TRUSS TO THE FLOOR BEAMS SHALL BE REPLACED WITH THE ANGLES DETAILED ON THIS SHEET.

| PROJECT: NEW HAVEN-WEYBRIDGE | PROJECT NO.: BHO-BTN 2005 (1) |
|---|---|
| DESIGN FILE NAME: /89j081/structures/sj081frame.dgn | |
| IPARM FILE NAME: floorbeamconn.i | PLOT DATE: 28-FEB-2007 |
| DESIGNED BY: R.S. YOUNG | DRAWN BY: R.S. YOUNG |
| SQUAD LEADER: C.P. WILLIAMS | CHECKED BY: R.S. YOUNG |
| FLOOR BEAM CONNECTION DETAILS | SHEET: 18 OF 53 |

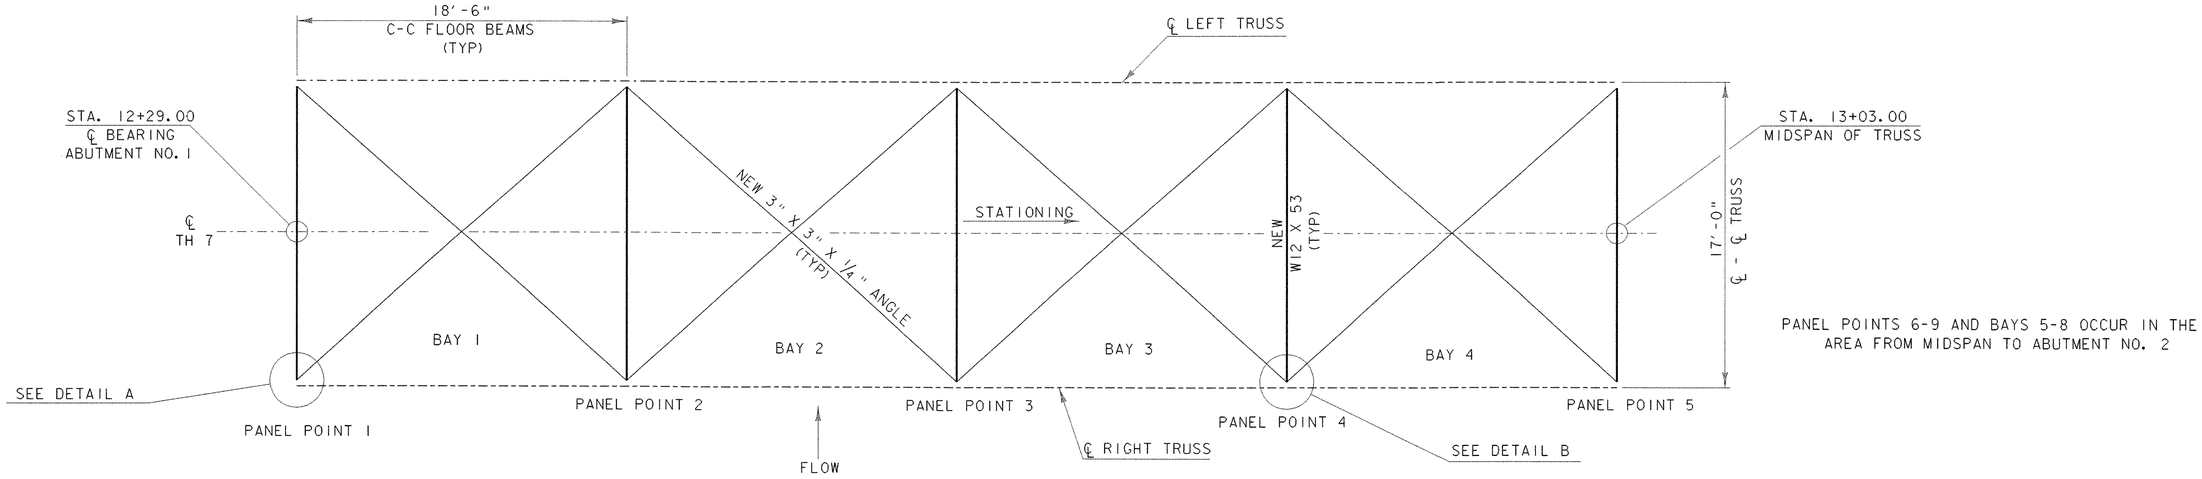



PANEL POINTS 6-9 AND BAYS 5-8 OCCUR IN THE AREA FROM MIDSPAN TO ABUTMENT NO. 2

## HALF PLAN OF FLOOR FRAMING PLAN


SCALE: 1/4" = 1'-0"

(BRIDGE FRAMING PLAN SYMMETRICAL ABOUT MIDSPAN)

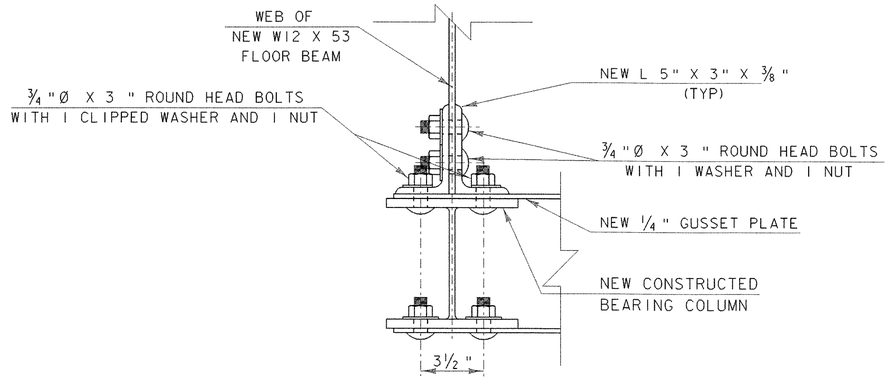



### DETAIL A
### PLAN OF NEW FLOOR BEAM CONNECTION PANEL POINTS 1 AND 9

SCALE: 3" = 1'-0"

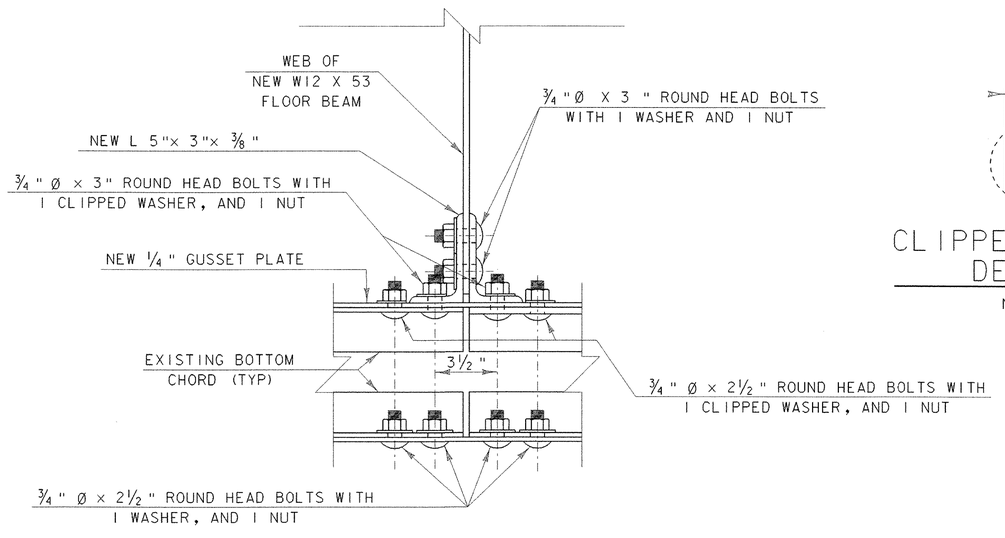


### DETAIL B
### PLAN OF NEW FLOOR BEAM CONNECTION PANEL POINTS 2 THROUGH 8

SCALE: 3" = 1'-0"

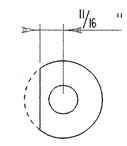



### CLIPPED WASHER DETAIL

N.T.S.

SCALE 1/4" = 1'-0
1 0 2 4 6


SCALE 3" = 1'-0
1 9 6 3 0

| PROJECT: NEW HAVEN-WEYBRIDGE | PROJECT NO.: BHO-BTN 2005(1) |
|---|---|
| DESIGN FILE NAME: /89j081/structures/sj081frame.dgn | |
| IPARM FILE NAME: frame.i | PLOT DATE: 28-FEB-2007 |
| DESIGNED BY: R. S. YOUNG | DRAWN BY: D. A. ECKSTEIN |
| SQUAD LEADER: C. P. WILLIAMS | CHECKED BY: R.S. YOUNG |
| FRAMING PLAN & CONNECTION DETAILS | SHEET: 19 OF 53 |

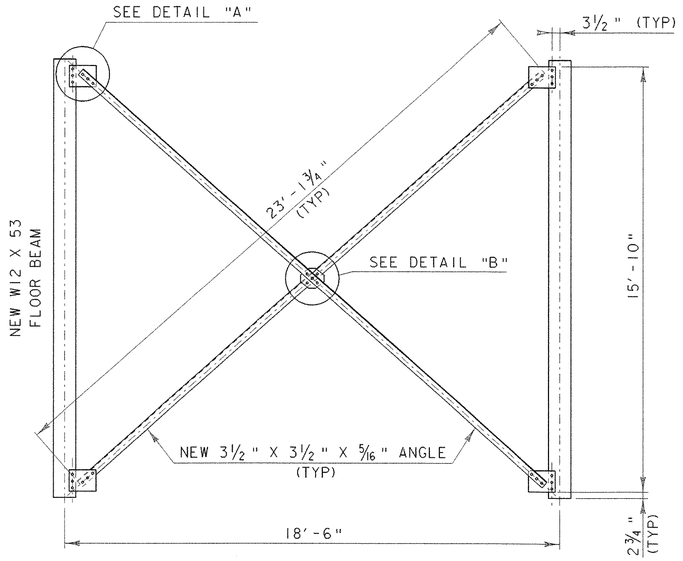


## LATERAL BRACING DETAIL


SCALE: ⅜ " = 1'-0"

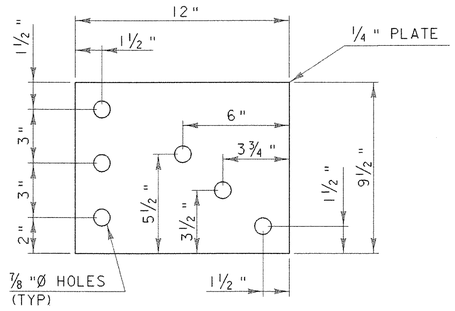


## DETAIL "A"

END CONNECTION PLATE


SCALE: 3" = 1'-0"
(32 REQUIRED)

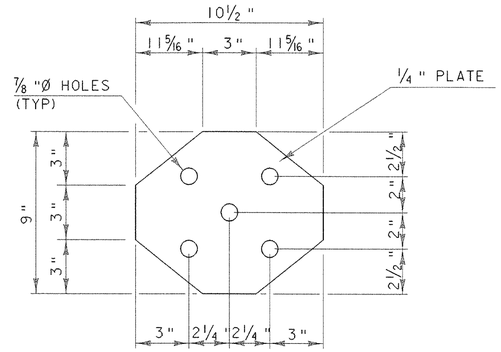


## DETAIL "B"

CENTER CONNECTION PLATE

SCALE: 3" = 1'-0"
(8 REQUIRED)

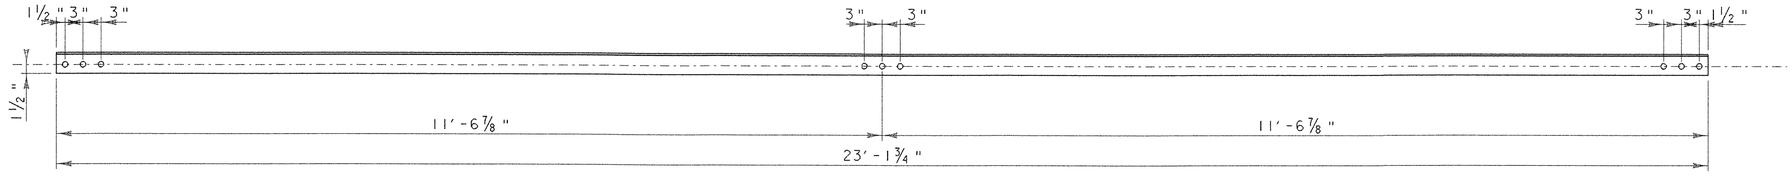


## LATERAL BRACING (TYP)
## 3½ " X 3½ " X 5/16 " ANGLE


SCALE: 1" = 1'-0"

SCALE ⅜ " = 1'-0
0 1 2

SCALE 1" = 1'-0
1 9 6 3 0 1 2


SCALE 3" = 1'-0
1 9 6 3 0

| | |
|---|---|
| PROJECT: NEW HAVEN-WEYBRIDGE | PROJECT NO.: BHO-BTN 2005(1) |
| DESIGN FILE NAME: /89j081/structures/sj081frame.dgn | |
| IPARM FILE NAME: bracing.i | PLOT DATE: 28-FEB-2007 |
| DESIGNED BY: R. S. YOUNG | DRAWN BY: D. A. ECKSTEIN |
| SQUAD LEADER: C. P. WILLIAMS | CHECKED BY: R. S. YOUNG |
| LATERAL BRACING DETAILS | SHEET: 20 OF 53 |

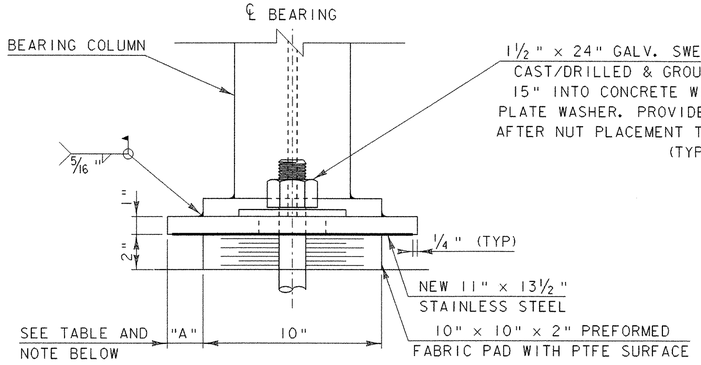



## SIDE ELEVATION EXPANSION BEARING

STA 12 + 29.00

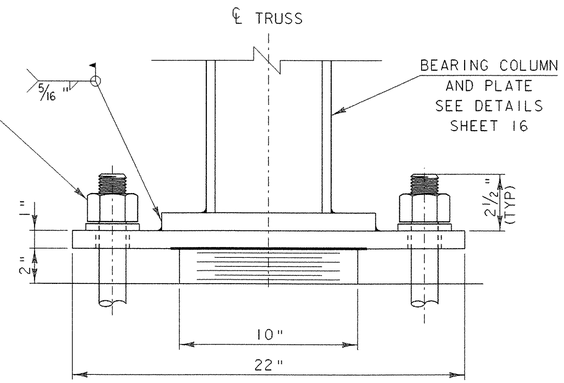


## FRONT ELEVATION EXPANSION BEARING

STA 12 + 29.00

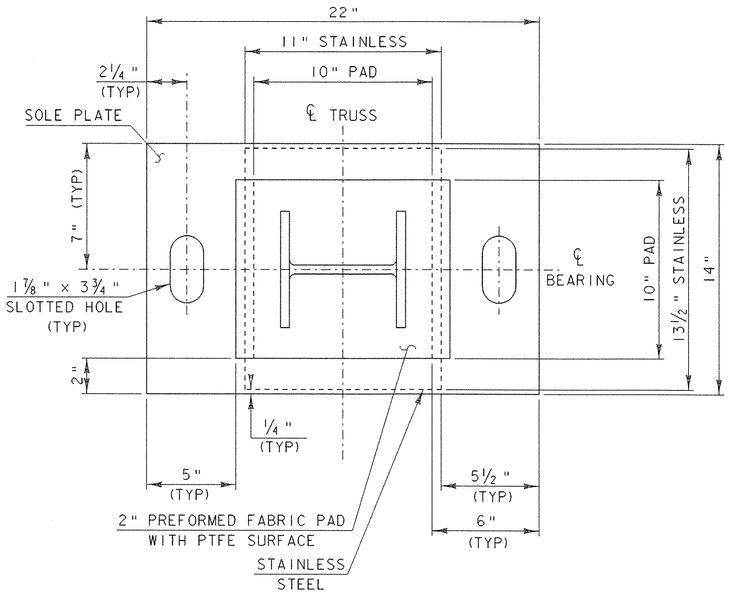


## PLAN VIEW EXPANSION BEARING

STA 12 + 29.00

EXPANSION BEARING


| TEMP | "A" DIST |
|---|---|
| 0°F | 1½ " |
| 15°F | 1 11/16 " |
| 30°F | 1 13/16 " |
| 45°F | 2 " |
| 60°F | 2 3/16 " |
| 75°F | 2 3/8 " |
| 90°F | 2½ " |
| 105°F | 2 11/16 " |

"A" DISTANCE IS THE FINAL SETTING FOR THE BEARING PAD WHEN THE DEAD LOAD OF THE NEW DECK IS IN PLACE.

## ALL DETAILS SCALE 3: 1


SCALE 3" = 1'-0

1 9 6 3 0 1

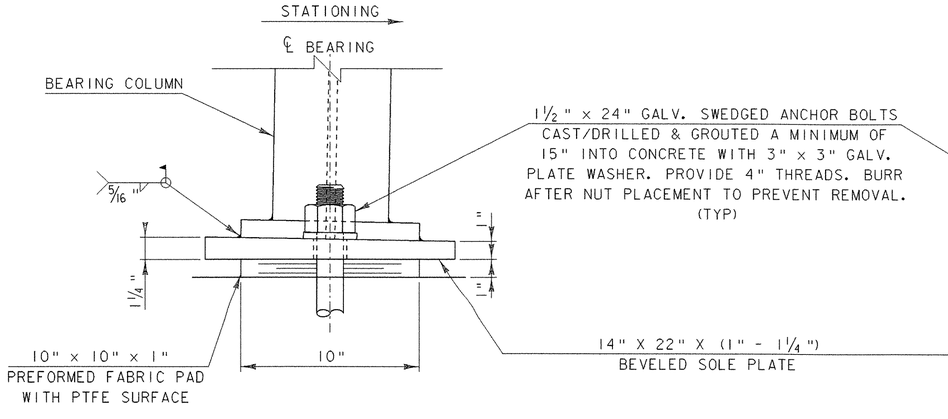



## SIDE ELEVATION FIXED BEARING

STA 13 + 77.00

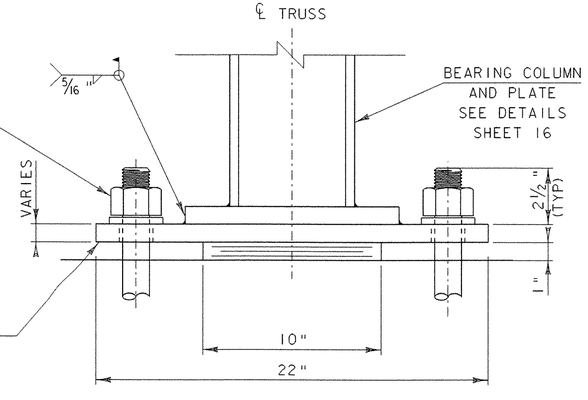


## FRONT ELEVATION FIXED BEARING

STA 13 + 77.00

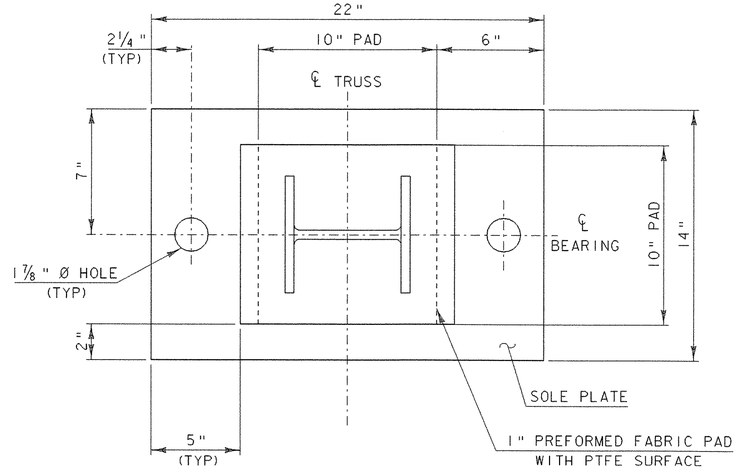


## PLAN VIEW OF FIXED BEARING

STA 13 + 77.00

| PROJECT: | PROJECT NO.: |
|---|---|
| NEW HAVEN - WEYBRIDGE | BHO-BTN 2005 (1) |

DESIGN FILE NAME: 89j081/structures/sj081bearing.dgn
IPARM FILE NAME: sj081bearing2.i
PLOT DATE: 28-FEB-2007
DESIGNED BY: R.S. YOUNG
DRAWN BY: D. D. BEARD
SQUAD LEADER: C.P. WILLIAMS
CHECKED BY: R.S. YOUNG
BEARING DETAILS
SHEET: 21 OF 53

# BEARING NOTES

1) BEARINGS SHALL CONFORM TO VAOT STANDARD SPECIFICATIONS FOR CONSTRUCTION SECTIONS 531 AND 731.

2) ALL COMPONENTS OF BEARINGS, EXCEPT STAINLESS STEEL, SHALL BE AASHTO M-270 GRADE 50 STEEL.


3) ALL COMPONENTS OF BEARING DEVICES SHALL BE METALIZED IN CONFORMANCE WITH VAOT STANDARD SPECIFICATIONS FOR CONSTRUCTION SECTIONS 533.04 AND 506.15. AREAS OF METALIZING DAMAGED BY FIELD WELDING OR HANDLING SHALL BE REPAIRED IN CONFORMANCE WITH ASTM A 760/A 760M.

4) ALL ANCHOR BOLTS, NUTS, AND WASHERS SHALL BE GALVANIZED. ALL WASHERS SHALL BE ⅜" PLATE. PAYMENT FOR ANCHOR BOLTS, NUTS, AND WASHERS SHALL BE INCLUDED IN THE UNIT BID PRICE FOR ITEM 531.10 "BEARING DEVICE ASSEMBLY, PREFORMED FABRIC PAD". ANCHOR BOLTS SHALL CONFORM TO VAOT STANDARD SPECIFICATIONS FOR CONSTRUCTION SECTION 714.08.

5) MANUFACTURING OF THE SOLE PLATE, BEARING PADS, ANCHOR BOLTS,AND STAINLESS STEEL SHALL BE PAID FOR UNDER THE BID ITEM 531.10 "BEARING DEVICE ASSEMBLY, PREFORMED FABRIC PAD" PAYMENT FOR THE BEARING COLUMN AND PLATE SHALL BE INCLUDED UNDER THE ITEM 506.60 "STRUCTURAL STEEL."

6) DESIGN CRITERIA:
- A: PAD TO CONCRETE DESIGN PRESSURE = 1000 PSI
- B: MINIMUM ALLOWABLE DESIGN ROTATION = 0.015 RADIANS
- C: HORIZONTAL CAPACITY SHALL BE MINIMUM OF 10% VERTICAL CAPACITY.
- D: DESIGN LOAD PER TRUSS BEARING = 82 KIPS
  - RDL = 38 KIPS
  - RLL = 44 KIPS


7) ANCHOR BOLTS SHALL BE CAST/DRILLED AND GROUTED PRIOR TO CONNECTING THE END FLOOR BEAMS

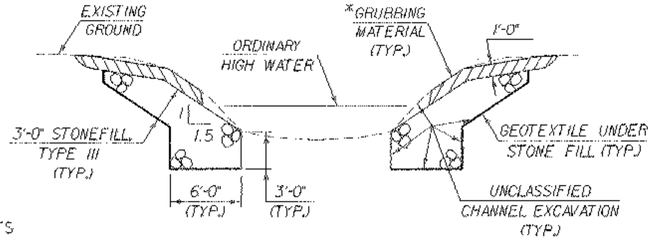


## TYPICAL CHANNEL SECTION

(NOT TO SCALE)


*GRUBBING MATERIAL SHALL NOT BE PLACED ON THE STONE FILL IN THE AREA UNDER THE BRIDGE. WHENEVER CHANNEL SLOPE INTERSECTS ROADWAY SUBBASE. GRUBBING MATERIAL SHALL BEGIN AT THE BOTTOM OF SUBBASE.

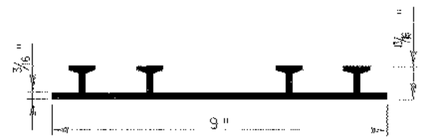


## P.V.C. WATERSTOP FOR CONSTRUCTION JOINTS

NTS


THE COSTS FOR P.V.C. WATERSTOP SHALL BE INCLUDED IN THE UNIT PRICE BID FOR CONCRETE. OTHER CONFIGURATIONS MAY BE USED UPON APPROVAL OF THE STRUCTURES ENGINEER.

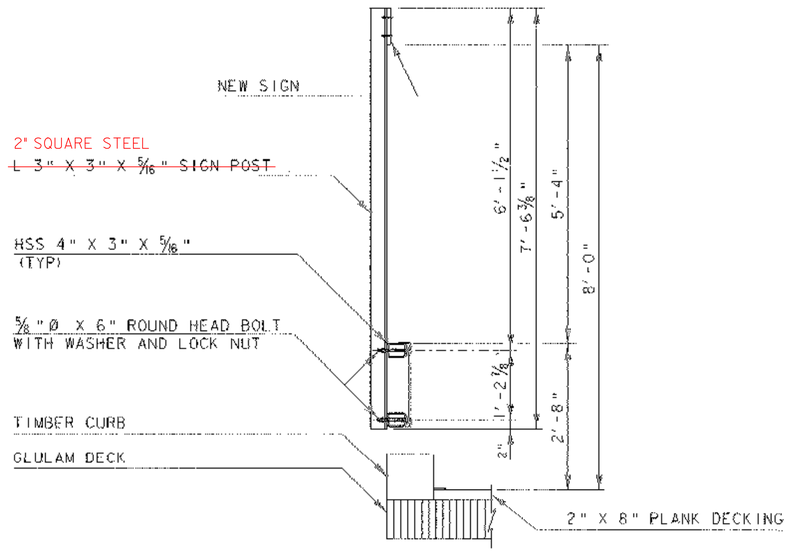


## TOWN LINE SIGN POST DETAIL

(STA 13+03.00) RT

SCALE ¾" = 1'-0

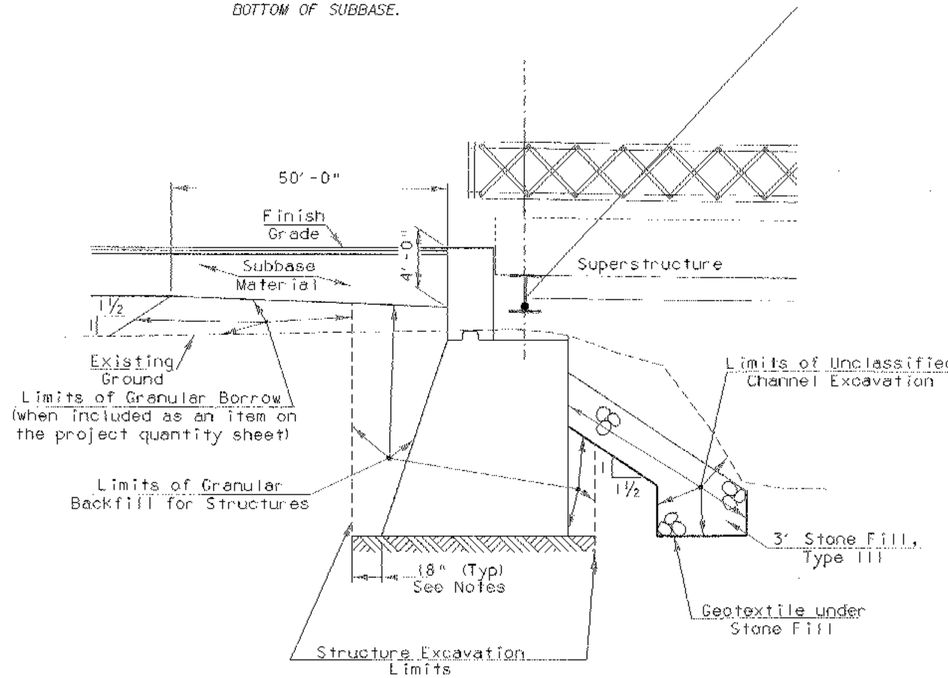



## ABUTMENT #1 TYPICAL SECTION

(NOT TO SCALE)

## NOTES

1. FOR PURPOSES OF ESTIMATING EARTHWORK QUANTITIES, THE LIMITS OF STRUCTURE EXCAVATION HAVE BEEN ASSUMED TO BE 18" OUTSIDE THE PERIMETER OF THE FOOTING.

2. THE ACTUAL EXCAVATION LIMITS TO BE DETERMINED BY THE CONTRACTOR. NO PAYMENT WILL BE MADE FOR WORK OUTSIDE THE STRUCTURE EXCAVATION LIMITS SHOWN ABOVE

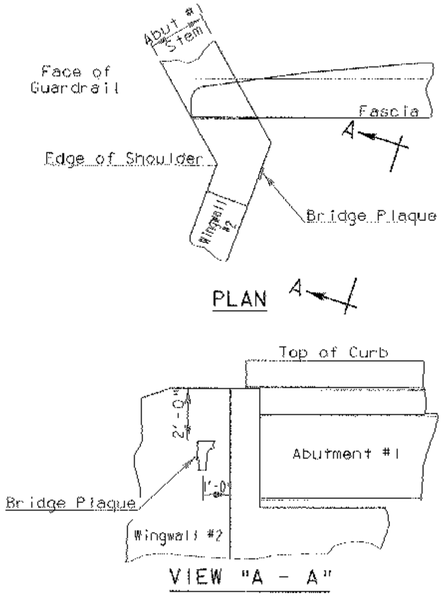



VIEW "A - A"

## LOCATE BRIDGE PLAQUE

THE BRIDGE PLAQUE WILL BE SUPPLIED BY THE AGENCY OF TRANSPORTATION AND SHALL BE INSTALLED BY THE CONTRACTOR AT ABUTMENT #1 ON THE RIGHT SIDE AS SHOWN OR AS DIRECTED BY THE ENGINEER.


| PROJECT: NEW HAVEN - WEYBRIDGE | PROJECT NO.: BHO-BTN 2005(1) |
|---|---|
| DESIGN FILE NAME: 89\081\structures\sj081bearing.dgn | |
| IPARM FILE NAME: sj081bgnotesmisc.i | PLOT DATE: 28-FEB-2007 |
| DESIGNED BY: R.S. YOUNG | DRAWN BY: M. LONGSTREET |
| SQUAD LEADER: C.P. WILLIAMS | CHECKED BY: R.S. YOUNG |
| BEARING NOTES/MISC DETAILS | SHEET: 22 OF 53 |

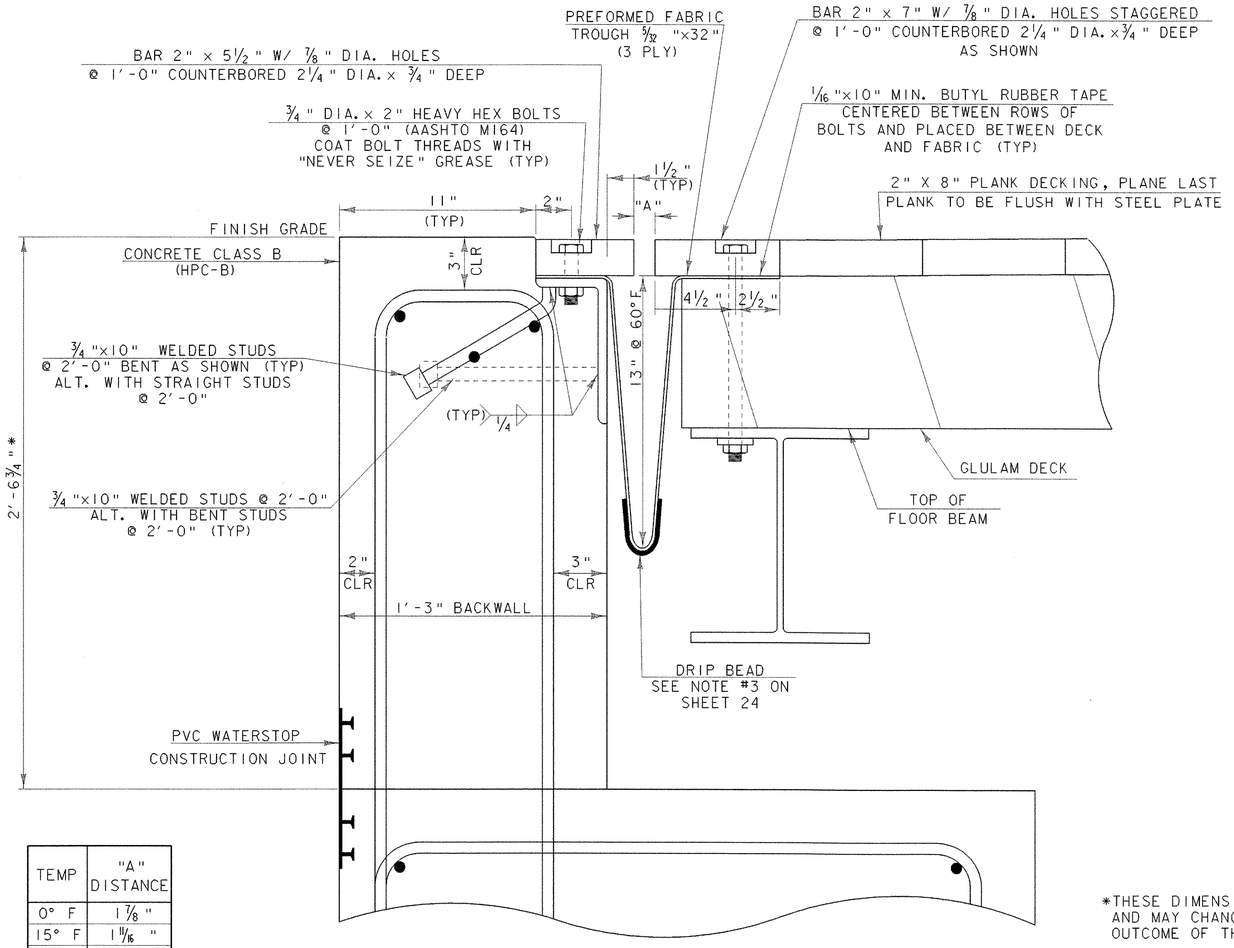


| TEMP | "A" DISTANCE |
|---|---|
| 0° F | 1⅞" |
| 15° F | 1 11/16" |
| 30° F | 1 9/16" |
| 45° F | 1⅜" |
| 60° F | 1 3/16" |
| 75° F | 1" |
| 90° F | ⅞" |
| 105° F | 11/16" |

## TYPICAL SECTION BETWEEN BRACKETS

SCALE 3" = 1'-0

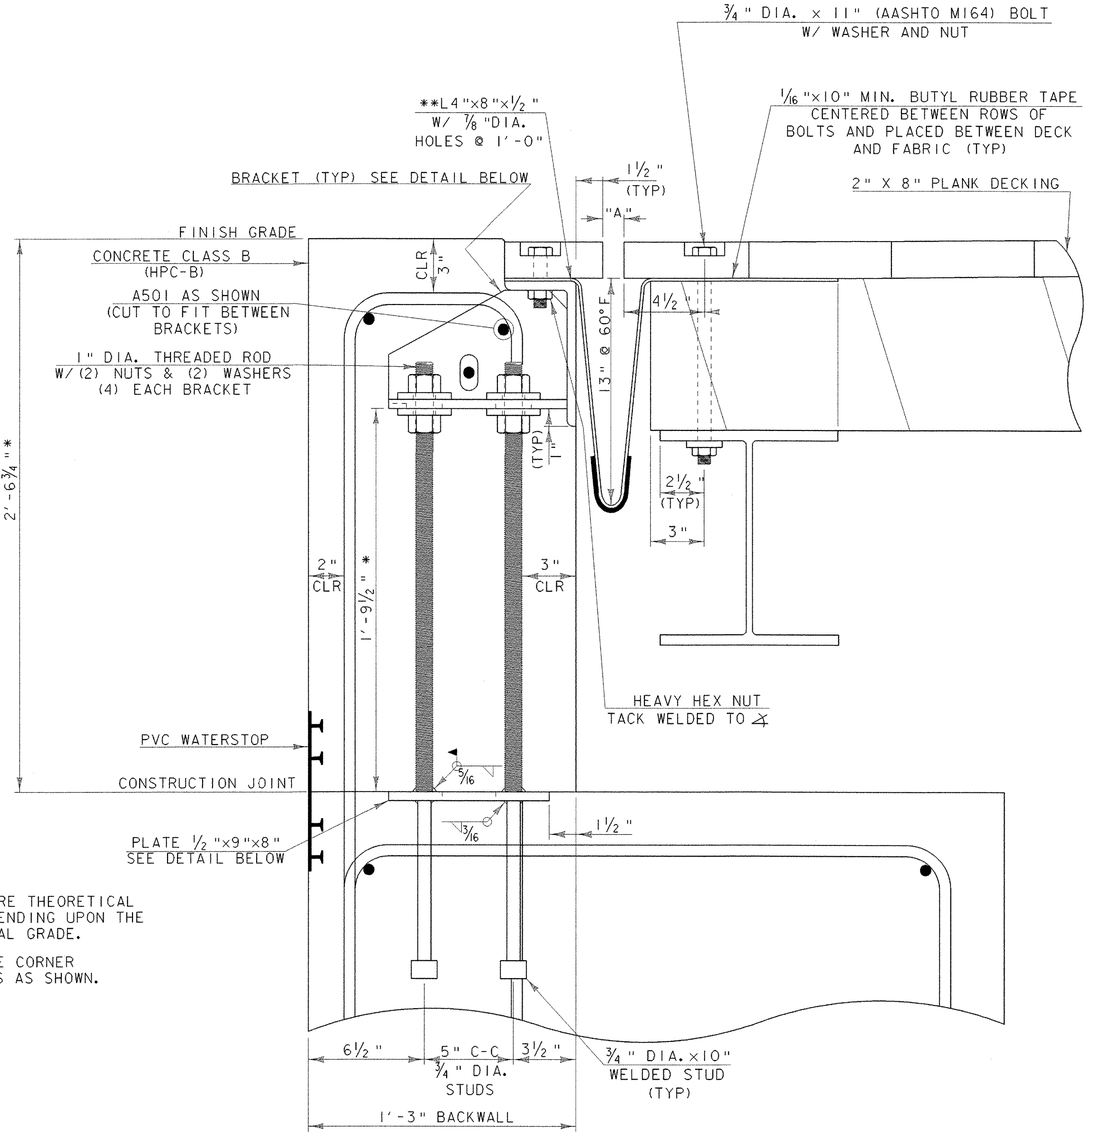



*THESE DIMENSIONS ARE THEORETICAL AND MAY CHANGE DEPENDING UPON THE OUTCOME OF THE FINAL GRADE.

**GRIND OUTSIDE CORNER TO ¼" RADIUS AS SHOWN.

## TYPICAL SECTION AT BRACKET


SCALE 3" = 1'-0

ALL PLATES ½"

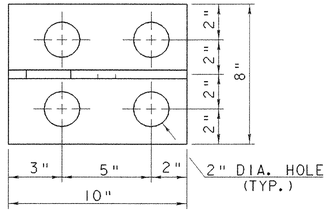



## BRACKET PLAN

SCALE 3" = 1'-0

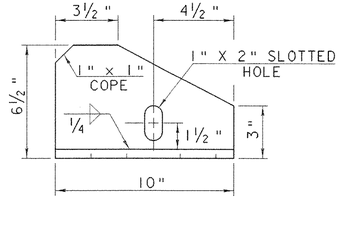



## BRACKET ELEVATION

SCALE 3" = 1'-0

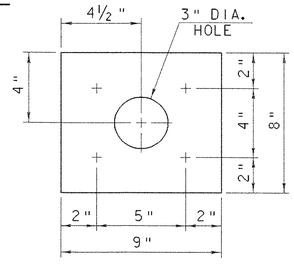


## PLATE PLAN

SCALE 3" = 1'-0

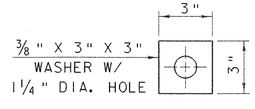



## WASHER FOR BRACKET

SCALE 3" = 1'-0

SCALE 3" = 1'-0

| PROJECT: | PROJECT NO.: |
|---|---|
| NEW HAVEN - WEYBRIDGE | BHO-BTN 2005(1) |
| DESIGN FILE NAME: 89j081/structures/sj081joint.dgn | |
| IPARM FILE NAME: sj081joint.i | PLOT DATE: 28-FEB-2007 |
| DESIGNED BY: R.S. YOUNG | DRAWN BY: R.S. YOUNG |
| SQUAD LEADER: C.P. WILLIAMS | CHECKED BY: W.B. SYMONDS |
| EXPANSION JOINT DETAILS | SHEET: 23 OF 53 |

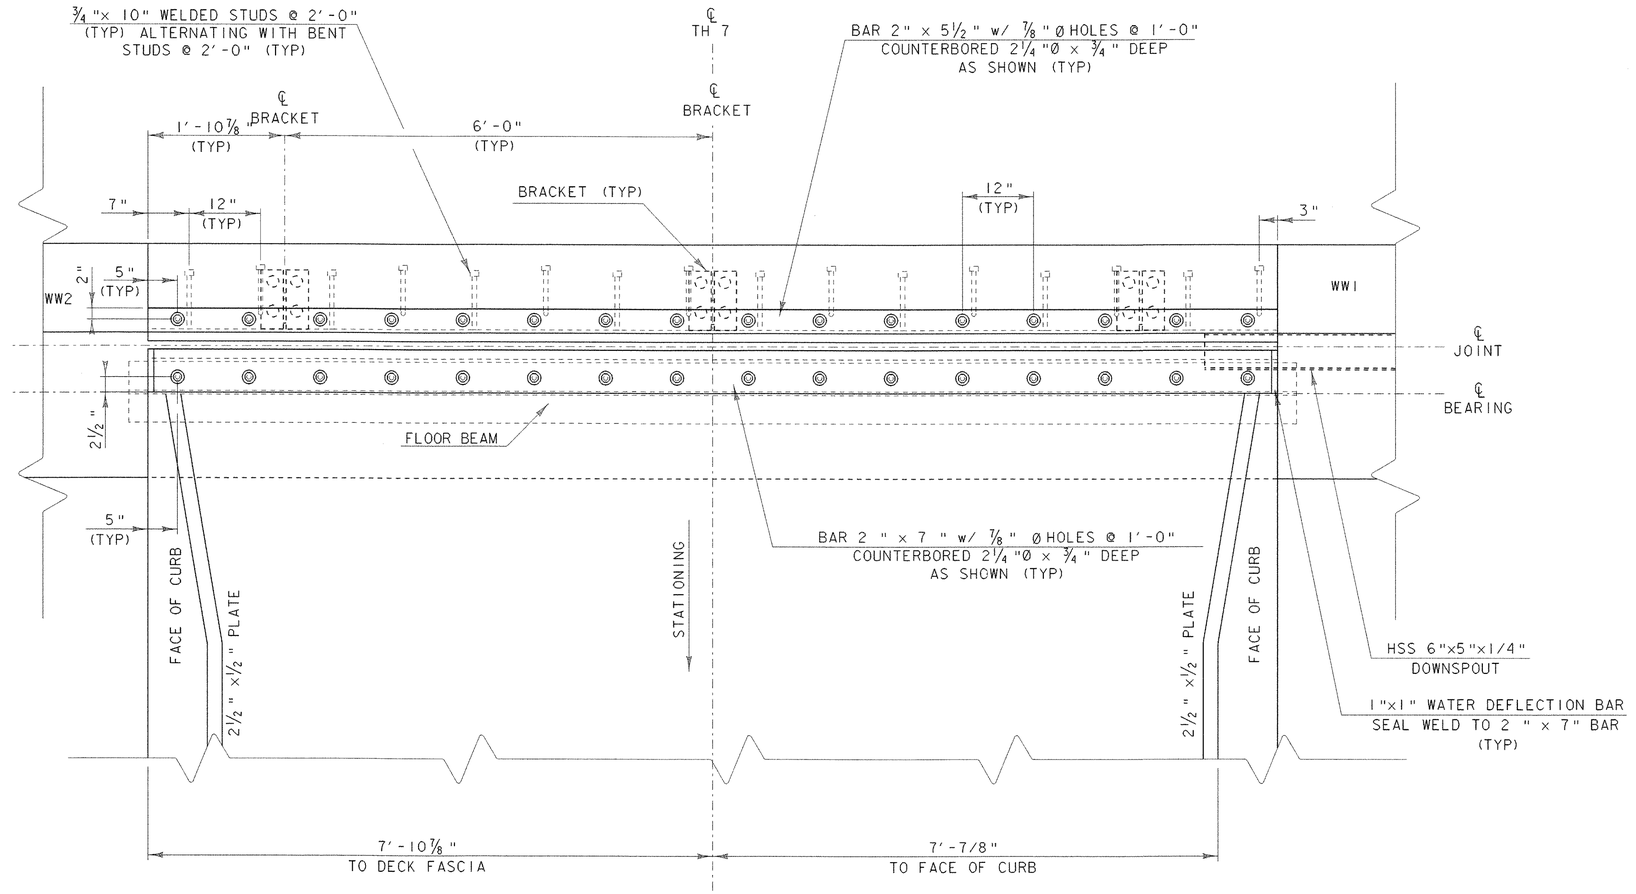


## EXPANSION JOINT PLAN


SCALE 1" = 1'-0

1 9 6 3 0 1 2

EXPANSOIN JOINT NOTES:

1. DETAILS ON SHEET 23 AND THIS SHEET ARE FOR ITEM 516.11 "BRIDGE EXPANSION JOINT, VERMONT".
2. PREFORMED FABRIC MATERIAL SHALL BE CONTINUOUS AND SHALL CONFORM TO SUBSECTION 707.07.
3. BUTYL RUBBER TAPE SHALL CONFORM TO AASHTO SPECIFICATION M-198, TYPE II.
4. ALL STEEL COMPONENTS SHALL BE AASHTO M270 GRADE 36 GALVANIZED OR METALIZED AS PER SUBSECTION 516.04. THREADED RODS SHALL CONFORM TO ASTM A307, GRADE C. THE NUTS FOR THE THREADED RODS SHALL BE ASTM A 563.
5. THE ITEM "BRIDGE EXPANSION JOINT, VERMONT" SHALL INCLUDE THE FABRICATION AND ERECTION OF THE COMPLETE JOINT ASSEMBLY INCLUDING ALL STEEL PLATES, BOLTS, BRACKETS, ANGLES, WELDED STUDS OR RODS, PREFORMED FABRIC DRAIN TROUGH MATERIAL, BUTYL RUBBER TAPE AND ANY OTHER MISCELLANEOUS MATERIAL NECESSARY TO INSTALL JOINT.
6. PAYMENT FOR DRILLING HOLES IN THE GLULAM DECK AND FLOOR BEAM SHALL BE INCIDENTAL TO 522.40 "STRUCTURAL GLUED LAMINATED TIMBER", AND 506.60 "STRUCTURAL STEEL"
7. COAT CONCRETE CONTACT SURFACES WITH EPOXY BONDING COMPOUND MEETING THE REQUIREMENTS OF SUBSECTION 516.05. PAYMENT SHALL BE INCLUDED IN THE UNIT PRICE BID FOR ITEM 516.11 "BRIDGE EXPANSION JOINT, VERMONT".
8. FILL COUNTERBORED HOLES WITH HOT POURED JOINT SEALER (STD. SPEC. 707.04) AFTER BOLT INSTALLATION. PAYMENT FOR THE WORK SHALL BE INCIDENTAL TO ITEM 516.11.
9. PAYMENT FOR WATERSTOP SHALL BE INCIDENTAL TO THE CONCRETE PAY ITEM.
10. A DRIP BEAD OF ¼"x7" STRIP OF PREFORMED MATERIAL SHALL BE CEMENTED TO THE BOTTOM OF THE FABRIC TROUGH USING AN ADHESIVE APPROVED BY THE MANUFACTURER. THE DRIP BEAD SHALL BE APPLIED 1" FROM THE DOWNSPOUT END OF THE TROUGH.
11. FABRIC TROUGH SHALL BE THOROUGHLY CLEANED AND FLUSHED AFTER PAVING OPERATION.


| PROJECT: NEW HAVEN - WEYBRIDGE | PROJECT NO.: BHO-BTN 2005(1) |
|---|---|
| DESIGN FILE NAME: 89j081/structures/sj081joint.dgn | |
| IPARM FILE NAME: sj081jointplan.i | PLOT DATE: 28-FEB-2007 |
| DESIGNED BY: R.S. YOUNG | DRAWN BY: R.S. YOUNG |
| SQUAD LEADER: C.P. WILLIAMS | CHECKED BY: W.B. SYMONDS |
| EXPANSION JOINT PLAN/WATERSTOP | SHEET: 24 OF 53 |

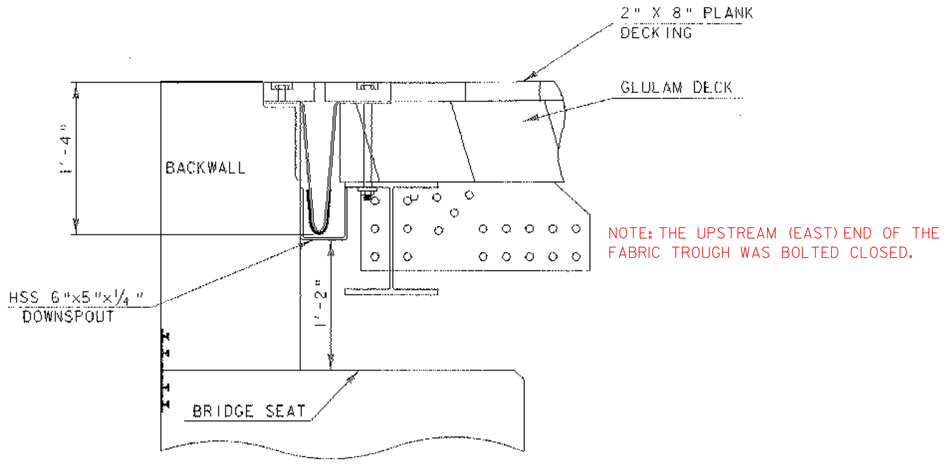


NOTE: THE UPSTREAM (EAST) END OF THE FABRIC TROUGH WAS BOLTED CLOSED.


## VIEW A - A


SCALE 1 1/2" = 1'-0

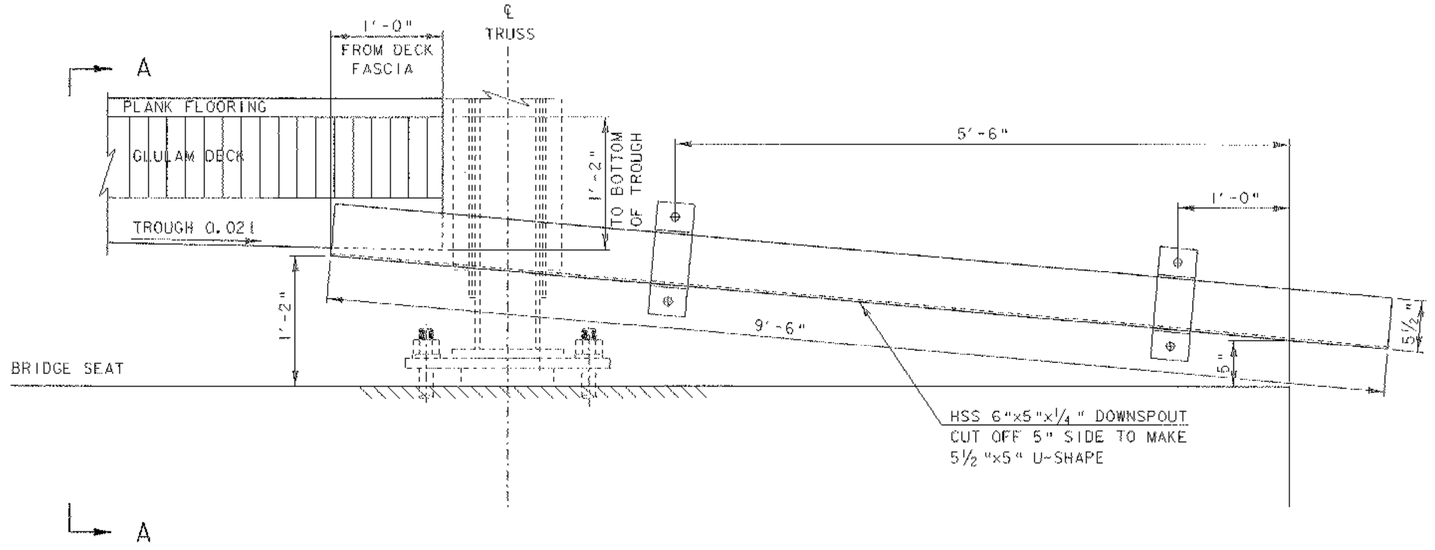


## DOWNSPOUT ELEVATION

SCALE 1 1/2" = 1'-0

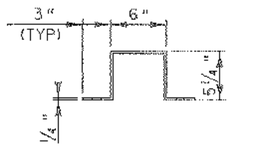


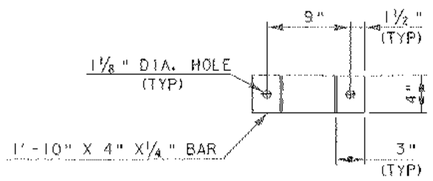
## BAR A

SCALE 1 1/2" = 1'-0

(2 REQUIRED)

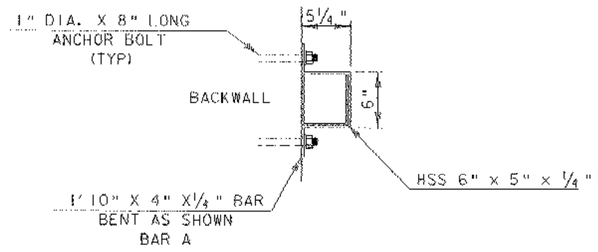



## CROSS SECTION OF DOWNSPOUT AT BAR LOCATION

SCALE 1 1/2" = 1'-0

## DOWNSPOUT NOTES


1. STRUCTURAL STEEL TUBING SHALL CONFORM TO ASTM A-500 GRADE B.
2. ALL PLATES, BARS, AND ANGLES SHALL CONFORM TO AASHTO M270 GRADE 50.
3. DOWNSPOUT SHALL BE GALVANIZED IN ACCORDANCE WITH VAOT STANDARD SPECIFICATIONS FOR CONSTRUCTION SECTION 506.15.
4. ALL BOLTS AND RELATED HARDWARE SHALL BE ASTM A-307 AND SHALL BE GALVANIZED IN ACCORDANCE WITH AASHTO M 232M/M 232.
5. ANY PLACE WHERE THE GALVANIZING HAS BEEN REMOVED FROM THE DOWNSPOUT EITHER BY CUTTING, BURNING, WELDING, PLACING, OR ANY OTHER MEANS, SHALL BE REPAIRED BY THOROUGHLY CLEANING THE DAMAGED AREAS WITH A WIRE BRUSH AND PAINTING THE DAMAGED AREAS WITH AN APPROVED SEALANT, PAYMENT SHALL BE INCIDENTAL TO ITEM 506.60 "STRUCTURAL STEEL".
6. PLATES, BARS, AND ANGLES SHALL BE PAID FOR UNDER THE ITEM 506.60 "STRUCTURAL STEEL".
7. GRIND ALL CORNERS TO A 1/16" RADIUS PRIOR TO GALVANIZING.


| PROJECT: | PROJECT NO.: |
|---|---|
| NEW HAVEN - WEYBRIDGE | BHO-BTN 2005(1) |
| DESIGN FILE NAME: 89\081\structures\sj081downspt.dgn | |
| IPARM FILE NAME: sj0812downspt2.i | PLOT DATE: 28-FEB-2007 |
| DESIGNED BY: R.S. YOUNG | DRAWN BY: R.S. YOUNG |
| SQUAD LEADER: C.P. WILLIAMS | CHECKED BY: R. S. YOUNG |
| DOWN SPOUT DETAILS | SHEET: 25 OF 53 |

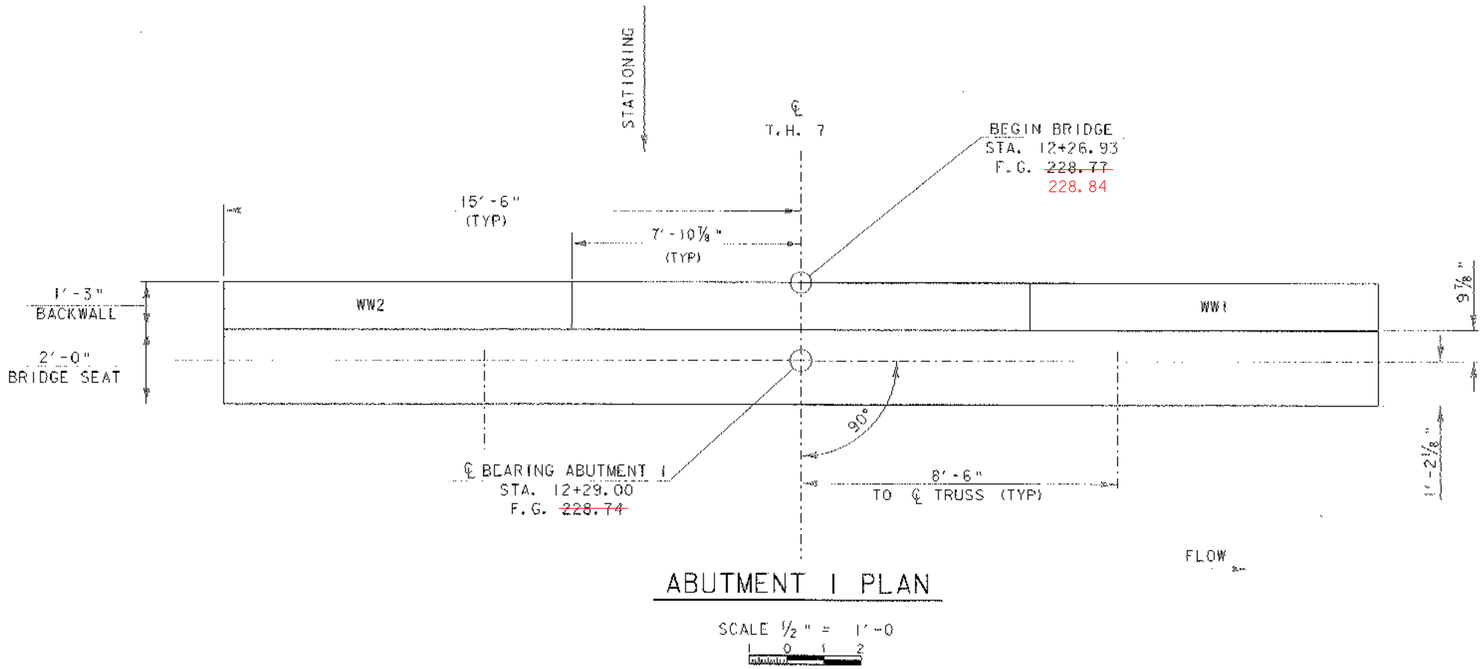


## ABUTMENT 1 PLAN


SCALE ½" = 1'-0

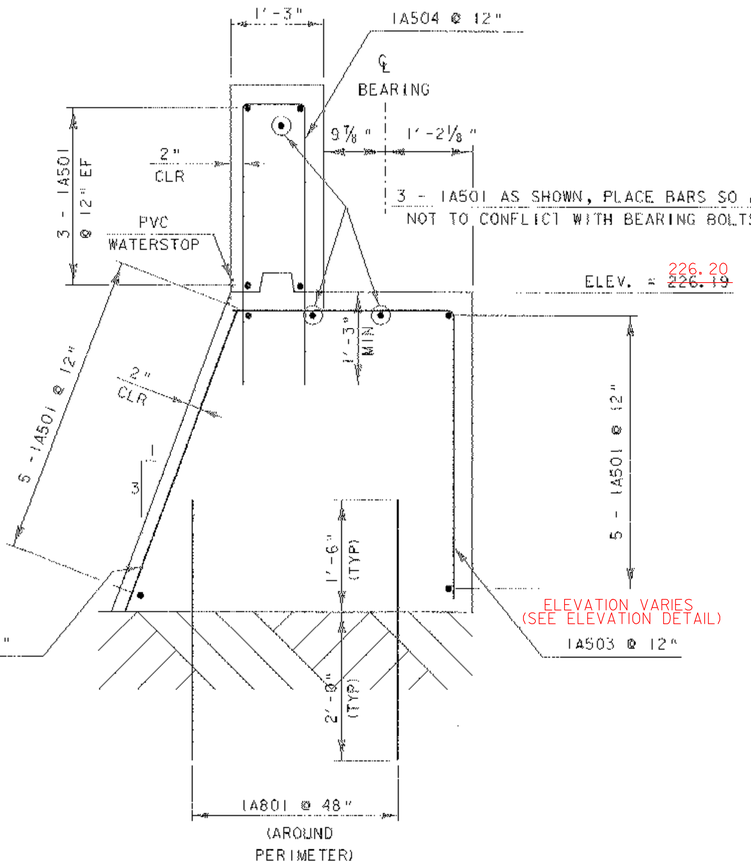

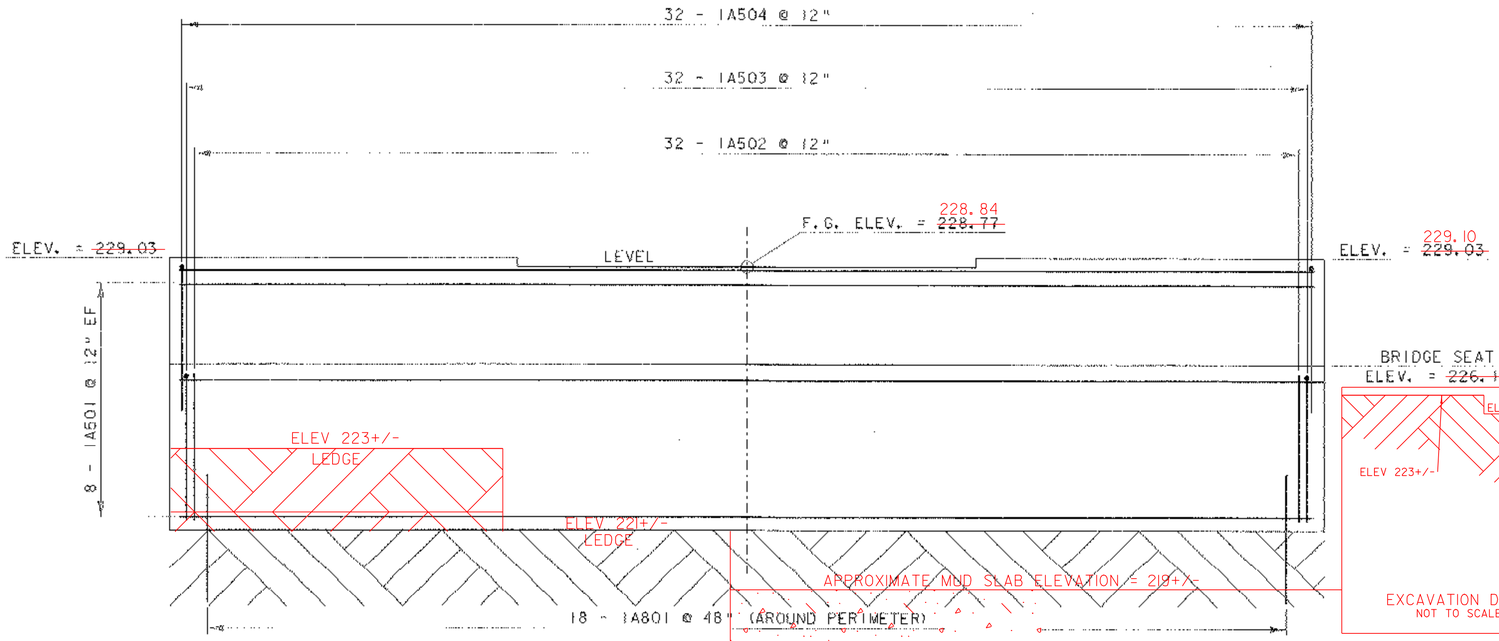
## ABUTMENT 1 ELEVATION

SCALE ½" = 1'-0

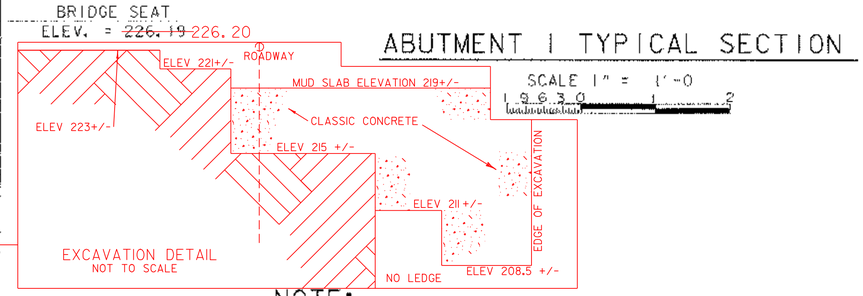


EXCAVATION DETAIL
NOT TO SCALE


## ABUTMENT 1 TYPICAL SECTION

SCALE 1" = 1'-0

### NOTE:


NF = NEAR FACE
FF = FAR FACE
EF = EACH FACE
▲ = CUT TO FIT IN FIELD
3" CLR. UNLESS OTHERWISE SPECIFIED ON THE PLANS.


| | |
|---|---|
| PROJECT: NEW HAVEN-WEYBRIDGE | PROJECT NO.: BHO-BTN 2005(1) |
| DESIGN FILE NAME: 89j081/structures/sj081sub.dgn | |
| IPARM FILE NAME: sj081ab1.i | PLOT DATE: 28-FEB-2007 |
| DESIGNED BY: R. S. YOUNG | DRAWN BY: R.S. YOUNG |
| SQUAD LEADER: C. P. WILLIAMS | CHECKED BY: R.S. YOUNG |
| ABUTMENT 1 DETAILS | SHEET: 26 OF 53 |

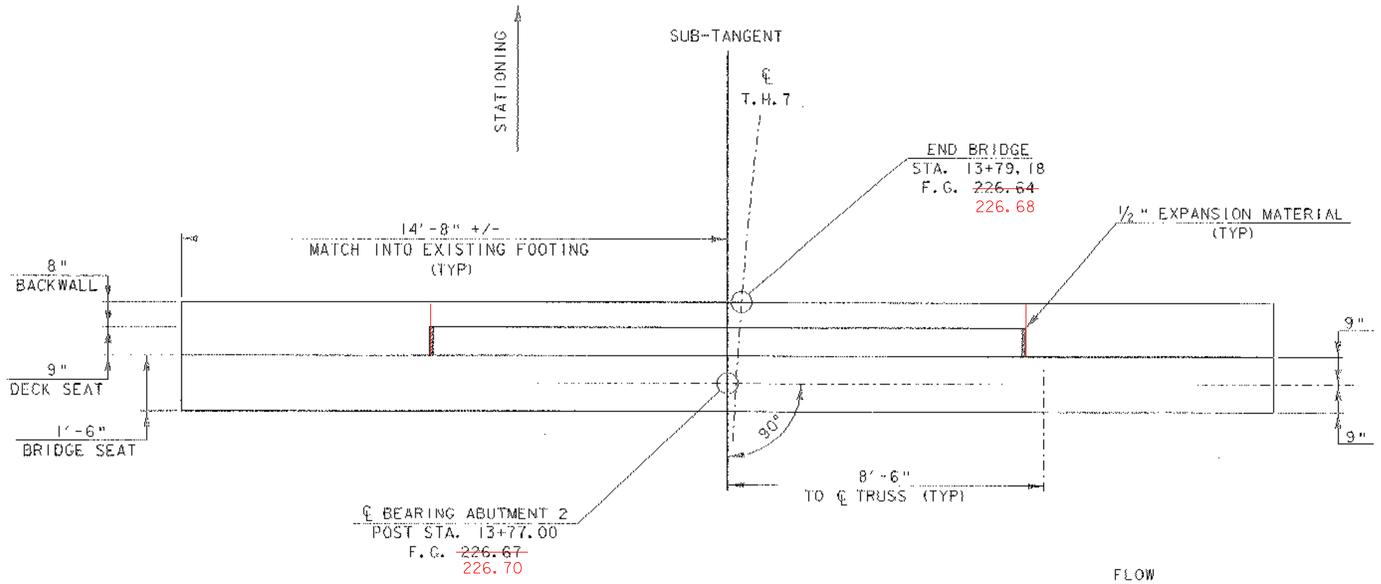


## ABUTMENT 2 PLAN

SCALE ½" = 1'-0

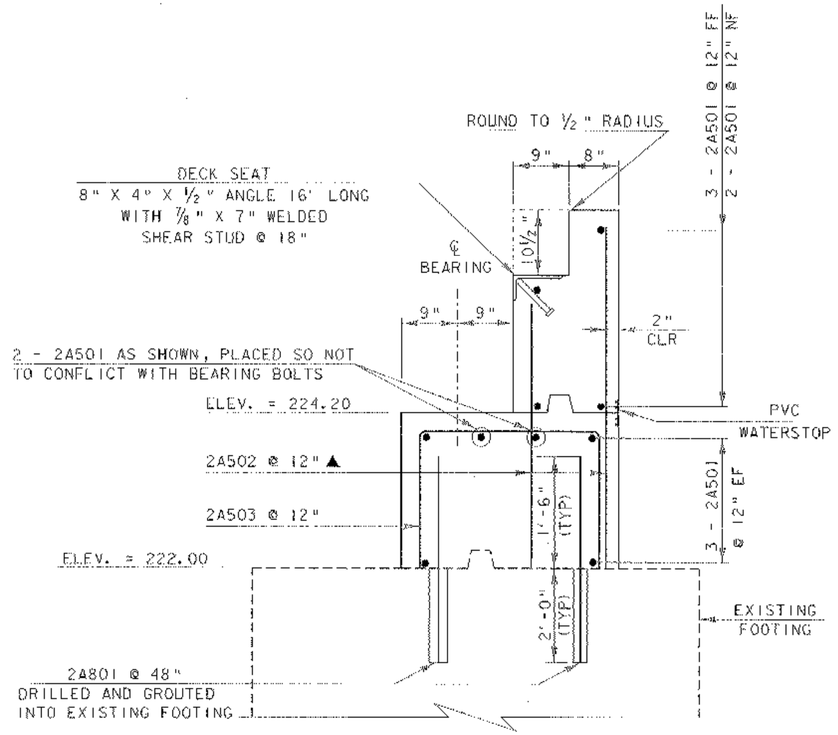

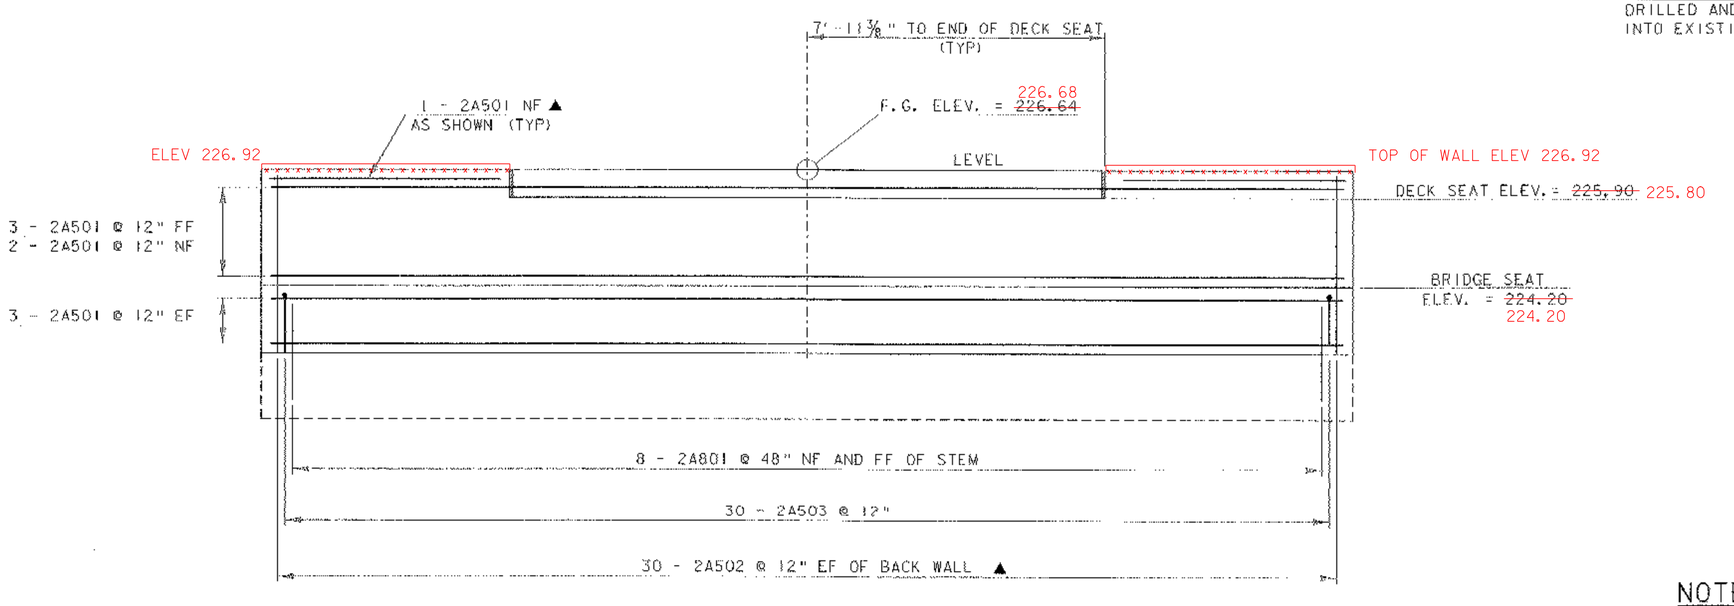
## ABUTMENT 2 ELEVATION

SCALE ½" = 1'-0

## ABUTMENT 2 TYPICAL SECTION

SCALE 1" = 1'-0


NOTES:

1. TRUSS SHALL BE PLACED ON NEW BEARINGS IN ITS FINAL POSITION BEFORE BACKWALL IS POURED.
2. REMOVE EXISTING ABUTMENT DOWN TO TOP OF THE EXISTING FOOTING AS SHOWN.

## NOTE:


NF = NEAR FACE
FF = FAR FACE
EF = EACH FACE
▲ = CUT TO FIT IN FIELD
3" CLR. UNLESS OTHERWISE SPECIFIED ON THE PLANS.

| | |
|---|---|
| PROJECT: NEW HAVEN-WEYBRIDGE | PROJECT NO.: BHO-BTN 2005 (1) |
| DESIGN FILE NAME: 89J081/structures/sj081sub.dgn | |
| IPARM FILE NAME: sj081ab2.i | PLOT DATE: 28-FEB-2007 |
| DESIGNED BY: R. S. YOUNG | DRAWN BY: R.S. YOUNG |
| SQUAD LEADER: C. P. WILLIAMS | CHECKED BY: R.S. YOUNG |
| ABUTMENT 2 DETAILS | SHEET: 27 OF 53 |

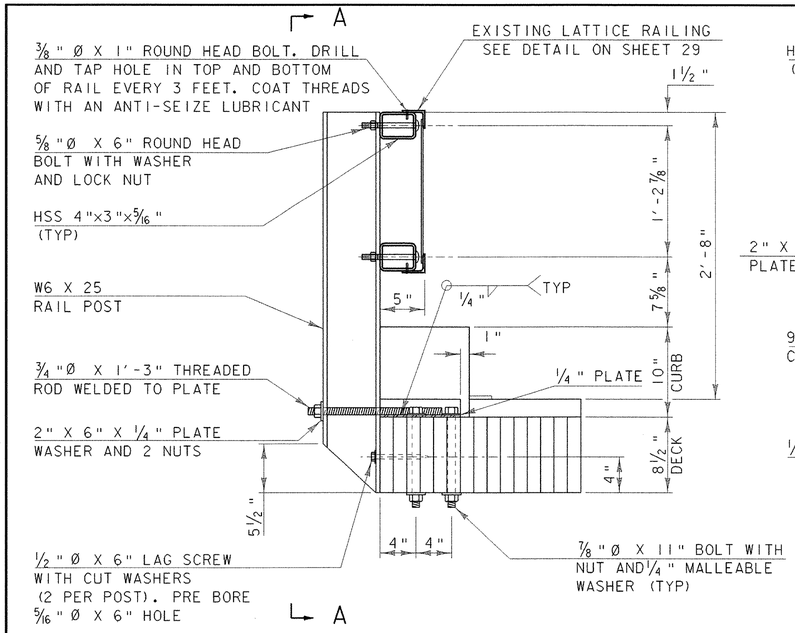



## RAILING TYPICAL SECTION

SCALE 1 ½" = 1'-0

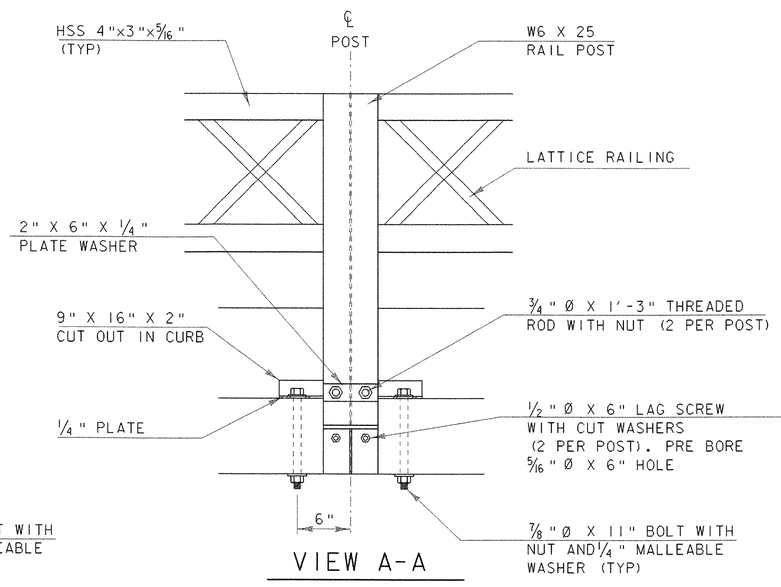



## VIEW A-A

SCALE 1 ½" = 1'-0

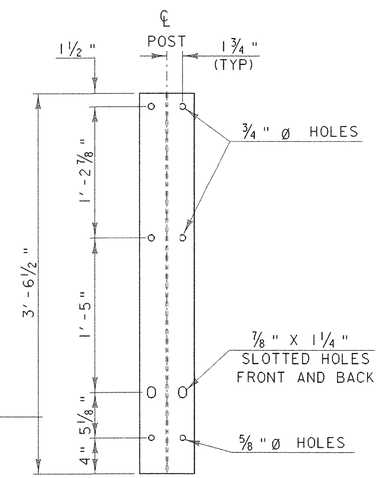


## FRONT VIEW OF POST

SCALE 1 ½" = 1'-0

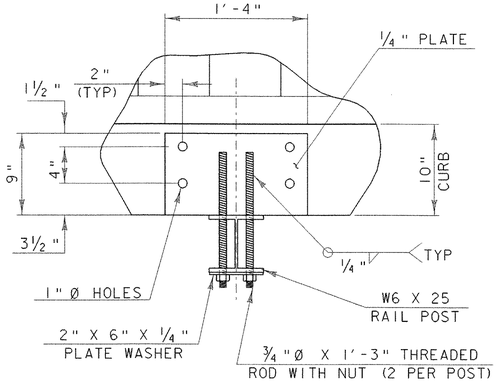



## TOP VIEW OF POST CONNECTION

SCALE 1 ½" = 1'-0


## RAILING NOTES :

1. STEEL PLATES AND POSTS SHALL COMPLY WITH THE REQUIREMENTS OF ASTM A709, GRADE 50 STEEL. BOX BEAM RAIL SHALL BE ASTM A 500, GRADE B.
2. BOLTS AND LAG SCREWS SHALL COMPLY WITH THE REQUIREMENTS OF ASTM A307, EXCEPT FOR ROUND HEADED BOLTS IN RAILING SHALL BE 5/8 "Ø ASTM A325. THREADED RODS SHALL BE ASTM A572, GRADE 50.
3. ALL HARDWARE SHALL BE GALVANIZED IN ACCORDANCE WITH AASHTO M232. BOX BEAM RAILING AND POSTS SHALL BE GALVANIZED IN ACCORDANCE WITH AASHTO M111.
4. HOLES IN RAILING MAY BE FIELD DRILLED.
5. NUTS FOR ASTM A307 AND A325 BOLTS SHALL COMPLY WITH ASTM A563.
6. BOX BEAM RAIL MAY ALTERNATIVELY BE ATTACHED USING 5/8 " Ø AASHTO M164 (TYPE 1) OR 3/4 " Ø ASTM F568, CLASS 4.6 ROUND HEAD BOLTS INSERTED THROUGH THE FACE OF THE RAIL. HOLES IN POSTS SHALL BE 1/16 " LARGER THAN THE BOLT SIZE.
7. ALL EXPOSED CUT OR SHEARED EDGES SHALL BE ROUNDED TO A 1/16 " RADIUS AND BE FREE OF BURRS.
8. RAIL POSTS SHALL BE NORMAL TO GRADE
9. BOX BEAM RAIL EXPANSION JOINTS SHALL BE PROVIDED OVER THE SUPERSTRUCTURE EXPANSION JOINT.
10. THE HOLLOW STRUCTURAL STEEL, POSTS, PLATES, RODS, LAG SCREWS, AND BOLTS, SHALL BE INCLUDED UNDER ITEM 525.31 "BRIDGE RAILING - GALVANIZED 2 RAIL BOX BEAM."
11. DRILLING AND TAPPING HOLES FOR LATTICE RAILING ATTACHMENT SHALL BE INCLUDED UNDER ITEM 525.31 "BRIDGE RAILING, GALVANIZED 2 RAIL BOX BEAM".
12. RAIL SPACING SHALL BE AS SHOWN ON SHEET 11

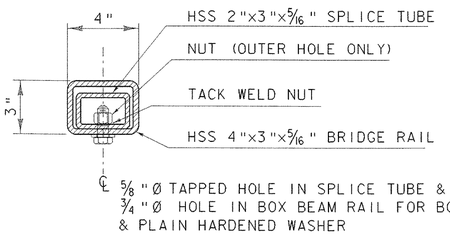



## RAIL SECTION B-B (SPLICE)

SCALE 3" = 1'-0

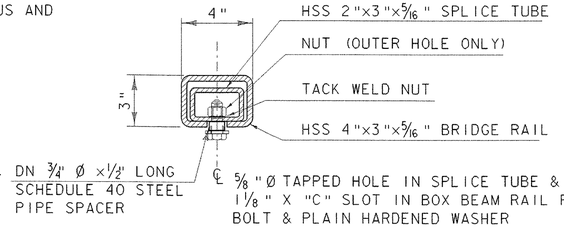


## RAIL SECTION B-B (EXPANSION JOINT)

SCALE 3" = 1'-0

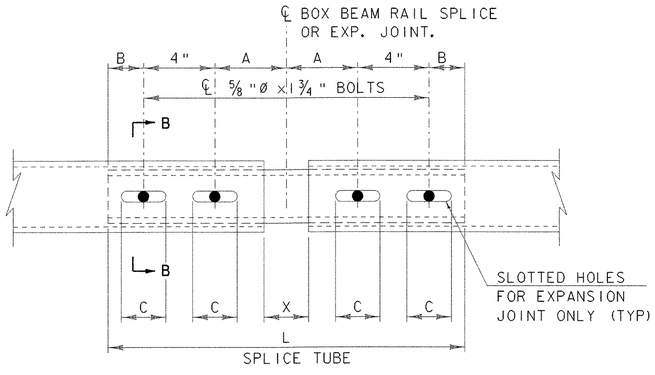



## BOX BEAM RAIL SPLICE JOINT DETAIL

SCALE 3" = 1'-0

| SPLICE & EXPANSION JOINT TABLE | | | | | |
|---|---|---|---|---|---|
| T | A | T | C | L | X |
| SPLICE | 4" | 2" | -- | 20" | 3/4 " |
| ≤ | 4" | 2" | 2 1/2 " | 20" | 2 1/2 " |


T = TOTAL REQUIRED MOVEMENT

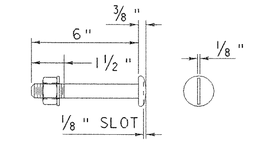


## 5/8 "Ø M164 (TYPE 1) ROUND HEAD BOLT

SCALE 3" = 1'-0

[WITH WASHER & LOCK NUT]
[SEE NOTE NO. 6]
NOTE: 3/4 "Ø BOLT DETAIL SIMILAR TO 5/8 "Ø BOLT.

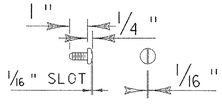



## 3/8 " Ø A307 (GRADE A) ROUND HEAD BOLT

SCALE 3" = 1'-0

SCALE 1 ½" = 1'-0"
9 6 3 0

SCALE 3" = 1'-0
9 6 3 0


| PROJECT: | PROJECT NO.: |
|---|---|
| NEW HAVEN - WEYBRIDGE | BHO-BTN 2005 (1) |
| DESIGN FILE NAME: 89j081/structures/sj081rail.dgn | |
| IPARM FILE NAME: sj081rail.i | PLOT DATE: 28-FEB-2007 |
| DESIGNED BY: R.S. YOUNG | DRAWN BY: R.S. YOUNG |
| SQUAD LEADER: C.P. WILLIAMS | CHECKED BY: R.S. YOUNG |
| BRIDGE RAIL DETAILS | SHEET: 28 OF 53 |

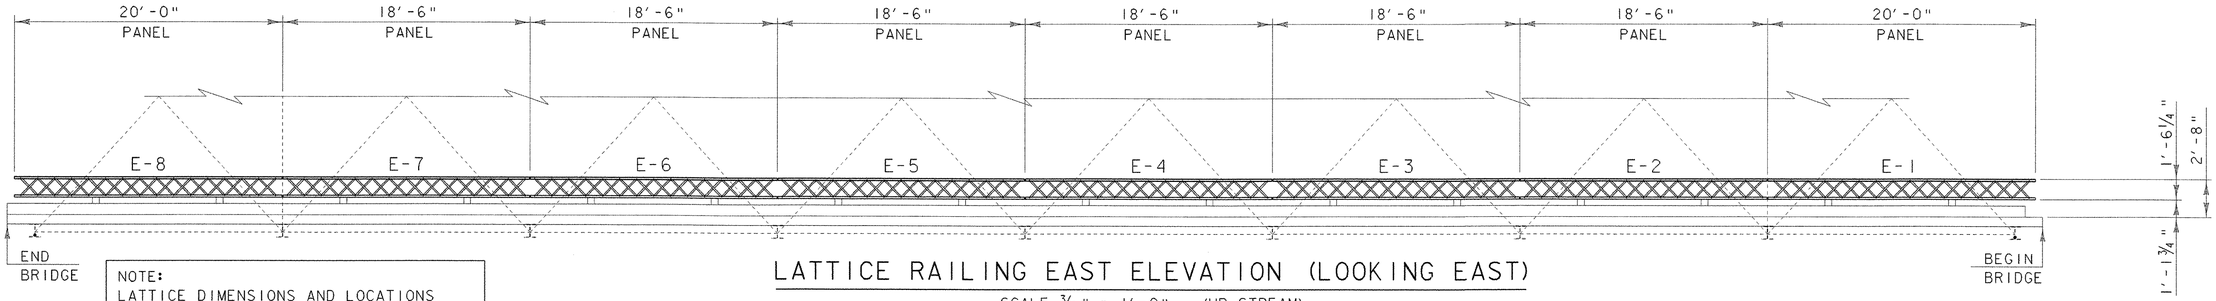


NOTE:
LATTICE DIMENSIONS AND LOCATIONS ARE TYPICAL FOR BOTH SIDES OF BRIDGE

## LATTICE RAILING EAST ELEVATION (LOOKING EAST)

SCALE 3/16" = 1'-0" (UP STREAM)

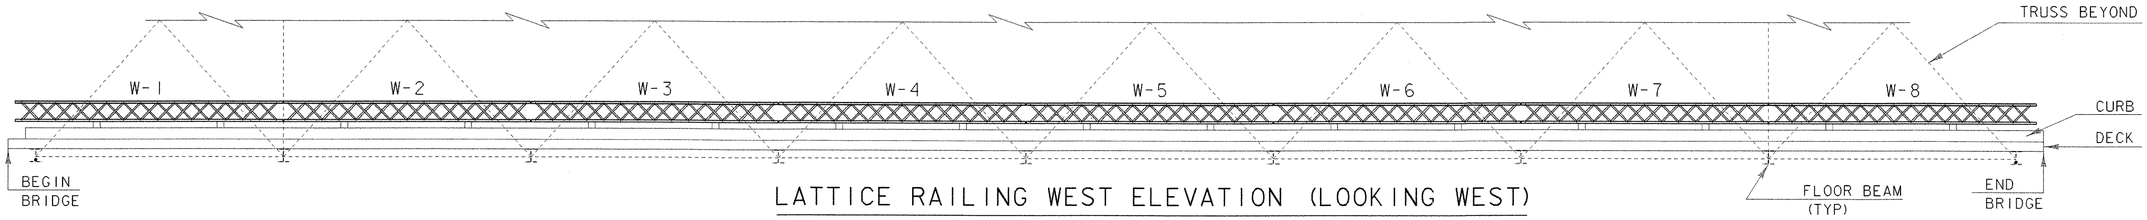


## LATTICE RAILING WEST ELEVATION (LOOKING WEST)

SCALE 3/16" = 1'-0" (DOWN STREAM)


LATTICE RAILING NOTES:

1. THE EXISTING LATTICE RAILING SHALL BE REMOVED FROM THE TRUSS, AND EITHER REPLACED IN KIND OR STRAIGHTENED ACCORDING TO THE LATTICE RAILING SCHEDULE. THE NEW PANELS SHALL BE ASSEMBLED WITH 3/8" DIA. GALVANIZED ROUND HEAD BOLTS. STRAIGHTENING SHALL BE IN ACCORDANCE WITH STANDARD SPECIFICATION 506.21.

2. FABRICATION OF REPLACEMENT PANELS, STRAIGHTENING OF EXISTING PANELS, AND ATTACHMENT TO THE 2 RAIL GALVANIZED BOX BEAM SHALL BE PAID FOR UNDER THE ITEM 506.60 "STRUCTURAL STEEL". SEE ATTACHMENT DETAILS ON SHEET 28.


3. EXISTING POSTS SHALL NOT BE REPLACED.

| LATTICE RAILING SCHEDULE | |
|---|---|
| PANEL # | ACTION REQUIRED |
| E-1 | STRAIGHTEN/REUSE |
| E-2 | STRAIGHTEN/REUSE |
| E-3 | STRAIGHTEN/REUSE |
| E-4 | STRAIGHTEN/REUSE |
| E-5 | REPLACE IN KIND |
| E-6 | REPLACE IN KIND |
| E-7 | STRAIGHTEN/REUSE |
| E-8 | REPLACE IN KIND |
| W-1 | STRAIGHTEN/REUSE |
| W-2 | STRAIGHTEN/REUSE |
| W-3 | STRAIGHTEN/REUSE |
| W-4 | STRAIGHTEN/REUSE |
| W-5 | STRAIGHTEN/REUSE |
| W-6 | STRAIGHTEN/REUSE |
| W-7 | STRAIGHTEN/REUSE |
| W-8 | REPLACE IN KIND |

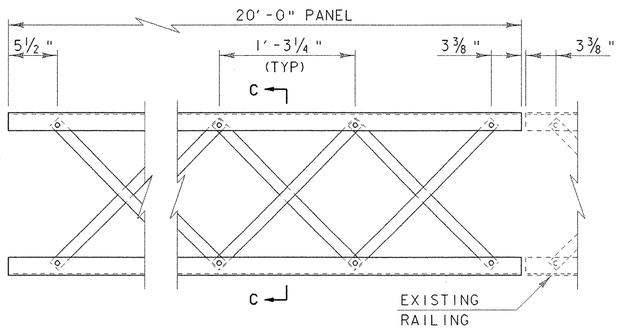



## 20'-0" LATTICE RAILING

SCALE 1½" = 1'-0

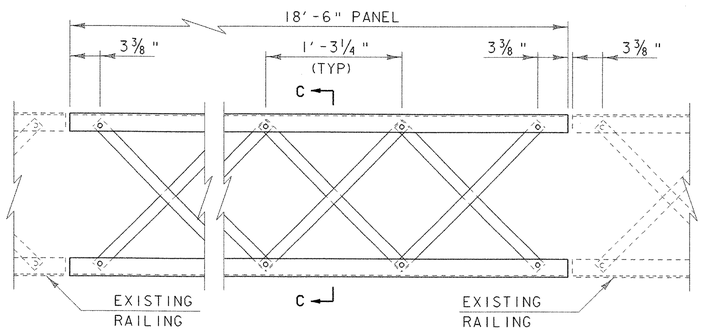


## 18'-6" LATTICE RAILING

SCALE 1½" = 1'-0

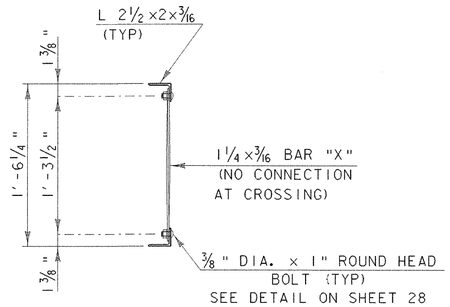


## VIEW C-C (TYP)

SCALE 1½" = 1'-0

SCALE 3/16" = 1'-0"
1 0 2 4 6 8

SCALE 1½" = 1'-0"
1 9 6 3 0 1


| PROJECT: | PROJECT NO.: |
|---|---|
| NEW HAVEN - WEYBRIDGE | BHO-BTN 2005(1) |
| DESIGN FILE NAME: 89j081/structures/sj081rail.dgn | |
| IPARM FILE NAME: sj081raillat.i | PLOT DATE: 28-FEB-2007 |
| DESIGNED BY: R.S. YOUNG | DRAWN BY: R.S. YOUNG |
| SQUAD LEADER: C.P. WILLIAMS | CHECKED BY: R.S. YOUNG |
| LATTICE RAIL DETAILS | SHEET: 29 OF 53 |

## APPROACH RAIL NOTES:

1. SEE STANDARD DRAWING G-1 & G-1d FOR ADDITIONAL DETAILS OF STEEL BEAM GUARDRAIL.
2. POSTS AND OFFSET BLOCKS SHALL BE WOOD AND MEET THE REQUIREMENTS OF VAOT STANDARD SPECIFICATIONS FOR CONSTRUCTION 728.01.
3. POSTS SHALL BE TWO FEET LONGER THAN SPECIFIED IN STANDARDS G-1 & G-1d.
4. SPLICES SHALL LAP IN DIRECTION OF TRAFFIC FLOW.
5. SEE STANDARD SHEET G-1 FOR DELINEATOR DETAILS AND PLACEMENT.
6. ERECT DELINEATOR ON EVERY FIFTH POST OR APPROXIMATELY 30 FEET APART. PAYMENT SHALL BE INCIDENTAL TO OTHER ITEMS.
7. ANCHORAGE CONNECTOR AND ANCHORAGE PLATE SHALL BE ASTM A 36 STEEL GALVANIZED TO ASTM A 123 AFTER FABRICATION, AND PAID FOR UNDER ITEM 525.31 "BRIDGE RAILING - GALVANIZED 2 RAIL BOX BEAM".
8. ALLOWABLE DIMENSIONAL TOLERANCE FOR BENT SECTIONS IS +/- 1/16".


## BRIDGE APPROACH RAILING

| SCHEDULE 1 | | |
|---|---|---|
| POST NO. | SPACING | PAYMENT FACTOR |
| 1 | 3'-1 1/2" | 1.4 X 12'-6" |
| 2 | 3'-1 1/2" | |
| 3 | 3'-1 1/2" | |
| 4 | 3'-1 1/2" | |
| 5 | 4'-2" | 1.2 X 12'-6" |
| 6 | 4'-2" | |
| 7 | 4'-2" | |
| 8 | 6'-3" (TYP.) | 1.0 (TYP.) |
| 9 | | |

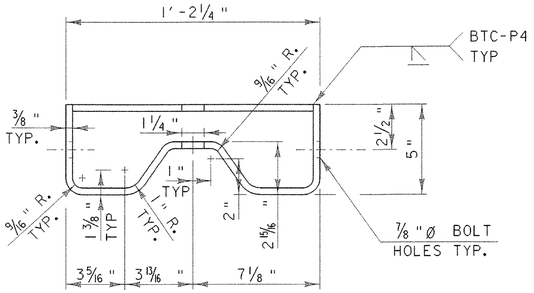



## ANCHORAGE CONNECTOR DETAIL

SCALE 3" = 1'-0

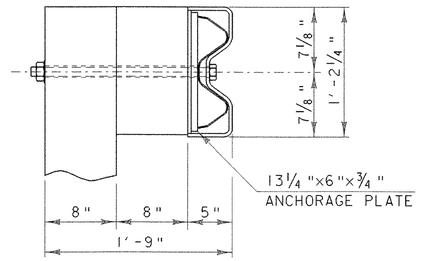



## VIEW B - B

SCALE 1 1/2" = 1'-0

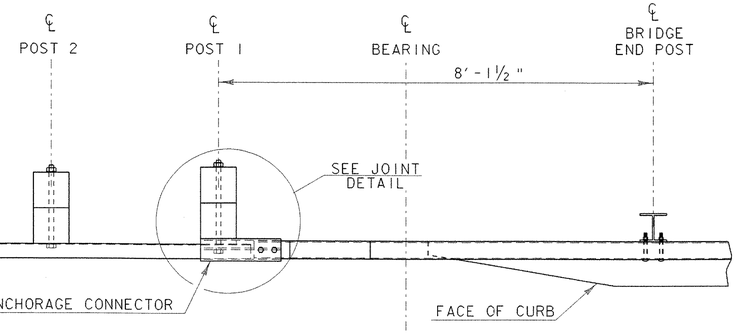


## BRIDGE APPROACH PLAN


SCALE 3/4" = 1'-0

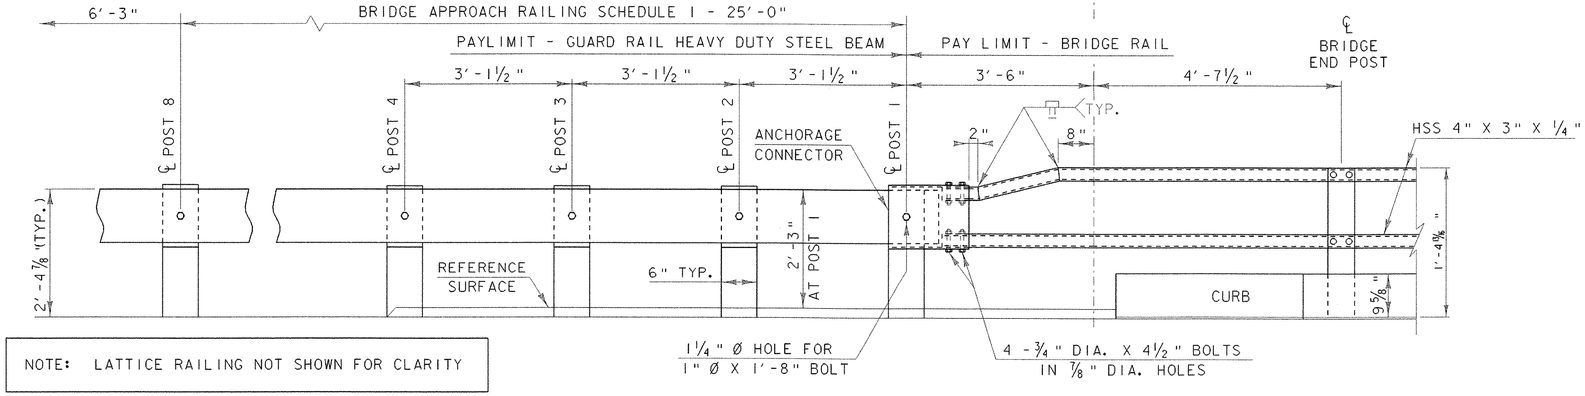


NOTE: LATTICE RAILING NOT SHOWN FOR CLARITY


## BRIDGE APPROACH ELEVATION

SCALE 3/4" = 1'-0

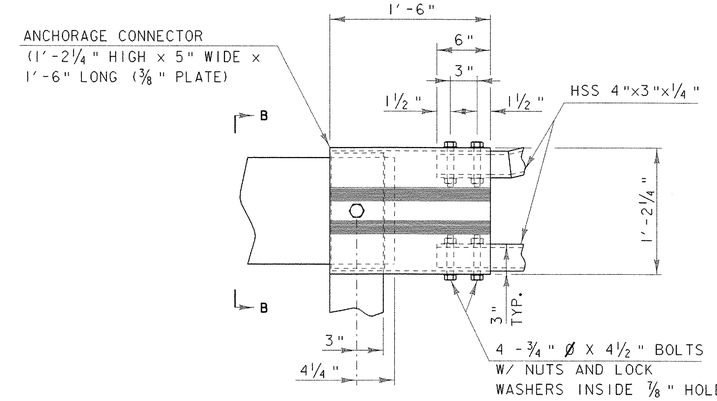


## VIEW A - A

SCALE 1 1/2" = 1'-0

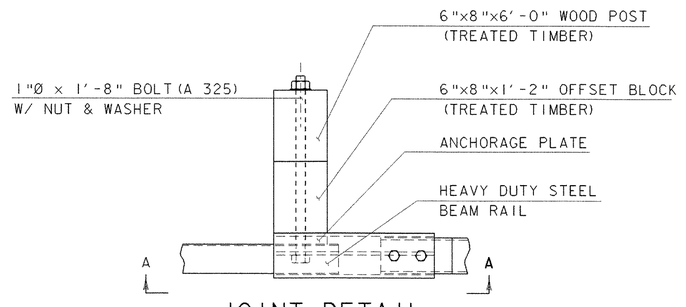


## JOINT DETAIL

SCALE 1 1/2" = 1'-0

0 1 2
SCALE 3/4" = 1'-0

9 6 3 0
SCALE 1 1/2" = 1'-0

9 6 3 0
SCALE 3" = 1'-0

| | |
|---|---|
| PROJECT: NEW HAVEN-WEYBRIDGE | PROJECT NO.: BHO-BTN 2005(1) |
| DESIGN FILE NAME: 89i081/structures/sj081rail.dgn | |
| IPARM FILE NAME: sj081apprail.i | PLOT DATE: 28-FEB-2007 |
| DESIGNED BY: R. S. YOUNG | DRAWN BY: R.S. YOUNG |
| SQUAD LEADER: C. P. WILLIAMS | CHECKED BY: R.S. YOUNG |
| APPROACH RAIL DETAILS | SHEET: 30 OF 53 |

*SEE TOWN LINE SIGN POST DETAIL ON SHEET 22.

NEW HAVEN | WEYBRIDGE N

NEW HAVEN | WEYBRIDGE R

SLOW CHILDREN AT PLAY

SPEED LIMIT 35 N

SPEED LIMIT 35 R

BRIDGE LOAD LIMIT 7000 POUNDS R

OTTER CREEK FLOW

GRAVEL PARKING AREA

BEGIN APPROACH STA 11+50.00

TO DAM

TO WEYBRIDGE TH 7/11

SHED

ASSURED 3-RDS R.O.W.

18" ASH

3" ASH

10+00

11+00

12+00

13+00

14+00

15+00

16+00

END BRIDGE STA 13+79.18 POST FG = 226.64

END PROJECT STA 13+80.00 POST

END APPROACH STA 14+50.00

6" CEDAR

24" MAPLE

30" ELM

12" ASH

GRAVEL PULL OFF

BEGIN BRIDGE STA 12+26.93 FG = ~~228.77~~

18" BASSWOOD

PATH

12" STUMP

WETLAND

BEGIN PROJECT STA 12+25.00

DANGER DAM BUILT AHEAD R&S

DANGER DAM BUILT AHEAD S/N

BRUSH

6" BASSWOOD

12" PINE

6" PINE

12" PINE

6" PINE

TO WALTHAM TH 7/11

6" MAPLE

18" ASH

6" BOX ELDER

S

R&S

NO SIGN TO REMOVE AND SALVAGE DMY 5/1/07

SPEED LIMIT 40 R&S

LEGAL LOAD LIMIT 7,000 POUNDS R

MAXIMUM BRIDGE CAPACITY 3 TONS R

ONE LANE BRIDGE N

320' NORTH OF W1-3R/W13-1

20 M.P.H. N

NOTE:
W1-3R/W13-1 SHALL BE 300 FT FROM CORNER AND W5-3 SHALL BE 300 FT FROM W1-3R/W13-1.

*350'+/- NORTH OF W5-3

20 M.P.H. N

ONE LANE BRIDGE N

NOTE:
W5-3 SHALL BE 300 FT FROM W1-6 AND W1-3R/W13-1 SHALL BE 300 FT FROM W5-3.

MAGNETIC N

REMOVE SIGNS
STA 10+60 LT
STA 11+34 RT
STA 12+30 RT
STA 13+75 LT
STA 18+19 RT
STA 13+03 RT
STA 12+98 RT
STA 16+90 RT

REMOVE AND SALVAGE SIGNS
~~STA 12+98 RT~~
~~STA 14+37 LT~~
STA 15+25 RT

TRAFFIC SIGNS, TYPE A

220' ~~100'~~ SOUTHERLY OF STA 10+00 RT
STA 10+35 LT
STA ~~11+07~~ RT 11+00
STA 12+27 RT,LT
STA 13+03 RT
STA 13+78 RT,LT
30' NORTHERLY OF STA 16+00 RT
300' ~~140'~~ NORTHERLY OF STA 16+00 LT
650' ~~350'~~ NORTHERLY OF STA 16+00 LT
STA 12+98 RT (ON BRIDGE)

ERECT SALVAGED SIGNS
~~12+98 RT (ON BRIDGE)~~
~~14+37 LT~~
15+25 RT

LEGEND

ALL SIGNS AND POSTS WILL BE NEW UNLESS OTHERWISE NOTED:

R - REMOVE
R&S - REMOVE & SALVAGE
S - SALVAGE
RET - RETAIN

DATUM
VERTICAL NGVD 1929
HORIZONTAL ASSUMED

# TRAFFIC SIGN SHEET

SCALE 1" = 30'-0

PROJECT: NEW HAVEN-WEYBRIDGE
PROJECT NO.: BHO-BTN 2005(1)
DESIGN FILE NAME: /str4/89j081/sj081trf.dgn
IPARM FILE NAME: sj081trf.i
SURVEYED BY: R. MOREAU
SQUAD LEADER: C. P. WILLIAMS
TRAFFIC SIGN SHEET
PLOT DATE: 28-FEB-2007
SURVEY DATE: 7/90
DRAWN BY: P. G. JARVIS
SHEET: 31 OF 53

STATE OF VERMONT
AGENCY OF TRANSPORTATION

# TRAFFIC SIGN SUMMARY SHEET

| MILEMARKER, STATION, OR SIGN NUMBER | SIGN LEGEND | SIGN DIMENSIONS | | | NEW & SALVAGED SIGNS | | | | EXIST POST | | NEW SIGN POSTS | | | | | | | | | | | | | | | | | | | | REMARKS | SIGN DETAIL | |
|---|---|---|---|---|---|---|---|---|---|---|---|---|---|---|---|---|---|---|---|---|---|---|---|---|---|---|---|---|---|---|---|---|
| | | EA | WIDTH (in) | HEIGHT (in) | "A" | "B" | SALV SIGN | SALV TIS | RETAIN | SALVAGE | NO. OF POSTS | FLANGED CHANNEL lb/ft | | | SQUARE STEEL (in) lb/ft | | | ANCHOR | SLEEVE | TUBULAR ALUMINUM Ø (in) lb/ft | | | FOUNDATION | TUBULAR STEEL Ø (in) lb/ft | | | | W-SHAPE STEEL FTG. SIZE | | WEIGHT | POST SIZE | SIGN REMOVED | | DETAIL ON SHEET NUMBER | STD. SHEET NUMBER |
| | | | | | | | | | | | | 1.12 | 2.0 | 3.0 | 1.75 | 2.0 | 2.5 | | | 3.0 | 4.0 | 4.0 MOD. | | 3.0 | 3.5 | 4.0 | 5.0 | 24" | 30" | | | | | | |
| | | | | | | | | | | | | | | | 1.88 | 2.16 | 3.35 | | | 1.3 | 1.7 | 1.7 | | 7.6 | 9.0 | 10.8 | 14.6 | | | | | | | | |
| | | | | | | | | | | | OPTION ITEMS | | | | | | | | | | | | | | | | | | | | | | | | |
| | ONE LANE BRIDGE | 1 | 36 | 36 | 9 | | | | | | 1 | | | X 14′ | | X | | | X | | | | | | | | | | | | | | W5-3 | 39 | |
| STA 10+40 | SPEED LIMIT 35 | 1 | 24 | 30 | 5 | | | | | | 1 | | | X 12′ | | X | | | X | | | | | | | | | | | | | | R2-1 | | E-142 |
| STA ~~11+05~~ 11+00 | | 1 | 30 | 30 | 6.25 | | | | | | 2 | | | X 16′ | | | X | | X | | | | | | | | | | | | | | W1-3R | | E-101 |
| STA ~~11+05~~ 11+00 | 20 M.P.H. | 1 | 18 | 18 | 2.25 | | | | | | | | | | | | | | | | | | | | | | | | | | | | W13-1 | | E-155 |
| | | | | | | | | | | | | | | | | | | | | | | | | | | | | | | | | | | | |
| STA 12+25 | | 1 | 12 | 36 | 3 | | | | | | 1 | | X 12′ | | | X | | | X | | | | | | | | | | | | | | OM-3R | 39 | |
| STA 12+25 | | 1 | 12 | 36 | 3 | | | | | | 1 | | X 10′ | | | X | | | X | | | | | | | | | | | | | | OM-3L | 39 | |
| STA 13+03 | NEW HAVEN WEYBRIDGE | 1 | 60 | 7.5 | 3.13 | | | | | | 1 | | | *8′ | | X | *NOTE: USED SQUARE STEEL POST BUT PAID AS FLANGED CHANNEL POST. | | | | | | | | | | | | | | | | E-124 | | E-124 |
| STA 13+80 | | 1 | 12 | 36 | 3 | | | | | | 1 | | X 12′ | | | X | | | X | | | | | | | | | | | | | | OM-3R | 39 | |
| STA 13+80 | | 1 | 12 | 36 | 3 | | | | | | 1 | | X 10′ | | | X | | | X | | | | | | | | | | | | | | OM-3L | 39 | |
| 35 FT PAST STA 16+00 | | 1 | 48 | 24 | 8 | | | | | | 2 | | | X 16′X2 | | X | | | X | | | | | | | | | | | | | | W1-6 | | E-152 |
| STA 13+10 (ON BRIDGE) | CAUTION DAM AHEAD | 1 | 36 | 18 | 4.5 | | | | | | 0 | | | | | | | | | | | | | | | | | | | | | | ATTACHED TO BRIDGE | | |
| | ONE LANE BRIDGE | 1 | 36 | 36 | 9 | | | | | | 1 | | | X 14′ | | X | | | X | | | | | | | | | | | | | | W5-3 | 39 | |
| 15+25 | SPEED LIMIT 40 | 1 | | | | | X | | | | | | | | | | | | | | | | | | | | | | | | | | | | |
| | | 1 | 30 | 30 | 6.25 | | | | | | 2 | | | X 16′ | | | X | | X | | | | | | | | | | | | | | W1-3R | | |
| | 20 M.P.H. | 1 | 18 | 18 | 2.25 | | | | | | | | | | | | | | | | | | | | | | | | | | | | W13-1 | | E-155 |
| | | | | | | | | | | | | FT | FT ~~40~~ 44 | FT ~~108~~ 112 | FT | FT 100 | FT 48 | | EA 13 | LB | LB | LB | | LB | LB | LB | LB | | | | | | | | |

FINAL POST LENGTHS ARE TO BE DETERMINED IN THE FIELD. POST SIZES ARE COMPUTED BASED ON INFORMATION FURNISHED ON THE STANDARD SHEETS AND THE TRAFFIC & SAFETY DIVISION'S "SIGN POST DESIGN GUIDELINE."

| TOTALS | SF | SF | EA. | SF | | FT | FT | EA. | LB | EA. | LB | EA. | EA. | LB |
|---|---|---|---|---|---|---|---|---|---|---|---|---|---|---|
| | ~~63.13~~ 67.63 | | | | | ~~148~~ 156 | 148 | | | | | | | |

PROJECT: NEW HAVEN-WEYBRIDGE
PROJECT NO.: BHO-BTN 2005(1)
DESIGN FILE NAME: /str4/89j081/sj081trf.dgn
IPARM FILE NAME: sj081tss.i
SURVEYED BY: R. MOREAU
SQUAD LEADER: C.P. WILLIAMS
TRAFFIC SIGN SUMMARY SHEET
PLOT DATE: 28-FEB-2007
SURVEY DATE: 7/90
DRAWN BY: P.C. JARVIS
SHEET: 32 OF 53

BRIDGE RAIL - 2 RAIL BOX BEAM
STA 12+26 - 13+80 LT & RT

HEAVY DUTY STEEL BEAM GUARDRAIL
STA 11+91 - 12+26 LT
STA 11+88 - 12+26 RT
STA 13+80 - 14+14 LT
STA 13+80 - ~~14+20~~ RT 15+45

ANCHORS FOR STEEL BEAM GUARDRAIL
STA 11+98 LT & RT
STA 14+07 LT
STA ~~14+13 RT~~ 15+45 RT

CONSTRUCT DRIVE WITH 8.5' PAVED APRON
1½" TYPE III PAVEMENT
STA 11+87 LT

REMOVAL OF EXISTING GUARDRAIL
STA 12+06 - 12+30 LT
STA 11+90 - 12+29 RT

CONSTRUCT TEMPORARY FLOATING DOCK
STA 12+50 RT

INSTALL BARRIER FENCE
STA 9+00 - 9+85 RT
STA 9+60 - 10+35 LT
STA 10+00 - 11+15 RT

MATCH LINE LAYOUT SHEET 2

LIMIT 35

CURVE 1 DATA
Δ = 15°00'00" LT
D = 19°05'55"
R = 300.00'
T = 33.91'
L = 67.53'
E = 1.91
BANK = NORMAL

1

OMYA, INC.

DO NOT DISTURB ARCHAEOLOGICALLY SENSITIVE AREA

GRAVEL PARKING AREA

PC Sta 11+01.09

PT Sta 11+68.62

ASSUMED 3-ROD R.O.W.

POB Sta 10+00.00

LEDGE

WOODS

N38°00'00.00"E TO WEYBRIDGE TH 7/11

10+00

11+00

12+00

13+00

14+00

BARRIER FENCE

WOODS

DO NOT DISTURB ARCHAEOLOGICALLY SENSITIVE AREA

LEGAL LOAD LIMIT 7,000 POUNDS

1
OMYA, INC.

BENCHMARK #1
CHISELED SQUARE
IN LEDGE EL. 238.045

BEGIN APPROACH
STA 11+50.00

#1 Sta 11+35.00 BK = Sta 11+24.00 AHD

LIMITS OF PAVEMENT

PC Sta 11+91.00

12" STUMP

PT Sta 12+17.61

CONST.(T)

3-6" BUTTERNUTS

WETLAND

2-48" WILLOWS

BEGIN PROJECT
STA 12+25.00

P.I. #2 Sta 12+04.32 BK = Sta 12+04.30 AHD

POB Sta 20+00.00

20+00

S59°48'52.17"E

CH (P)

TH 7/11 STA 12+25.00 = CHANNEL STA 20+50.00
Δ = 90°0'0"

CONST.(T)

MAGNETIC

TOWN LINE

OTTER CREEK FLOW

CURVE 2 DATA
Δ = 05°04'56" RT
D = 19°05'55"
R = 300.00'
T = 13.31'
L = 26.61'
E = 0.30
BANK = NORMAL

END R.O.W. PROJECT
BHO-BTN 2005 (1) STA. 12+49 58.00 RT.

BEGIN R.O.W. PROJECT
BHO-BTN 2005 (1) STA. 11+50 24.75' RT.

CH (P) ℄ OF PATH

SR (T)

POE Sta 21+00.00

TEMPORARY FLOATING DOCK FOR PORTAGE AROUND DAM

BENCHMARK #2
CHISELED SQUARE
NE CORNER BRIDGE
CURTAIN WALL EL 226.05

END BRIDGE
STA 13+79.18
FG = ~~226.64~~ 226.68

BEGIN BRIDGE
STA 12+26.93
FG = ~~228.77~~ 228.84

TELEPHONE LINE TO REMAIN IN PLACE DURING CONSTRUCTION

#31

8" BASSWOOD

N30°11'07.83"E

PC Sta 13+69.50

END PROJECT
STA 13+80.00

OMYA, INC.

LIMITS OF PAVEMENT

EXISTING BRIDGE DATA

BUILT IN 1908
152' STEEL THRU-TRUSS
TIMBER PLANK DECK
CONCRETE ABUTMENTS
15.1' ROADWAY WIDTH
15.1' VERTICAL CLEARANCE

NEW HAVEN
WEYBRIDGE

END APPROACH
STA 14+50.00

P.I. #3 Sta 14+43.45 BK = Sta 14+29.10 AHD

6" CEDAR

24" MAPLE

TRAV. PT #2

GRAVEL PULL OFF

#32

30" ELM (REMOVE)

12" ASH

12" CGMP

WOODS

RED LINE INDICATES TOWN OF NEW HAVEN INSTALLED GUARDRAIL THE "14+13" ANCHOR WAS INSTALLED AT 15+45

6" BASSWOOD

12" PINE

PT Sta 15+03.05

BRUSH

S88°36'00.00"E TO WALTHAM TH 7/11

TRAV. PT #3

POE Sta 16+80.00

15+00

16+00

CURVE 3 DATA
Δ = 61°12'52" RT
D = 45°50'12"
R = 125.00'
T = 73.95'
L = 133.55'
E = 20.23
BANK = NORMAL

MATCH LINE LAYOUT SHEET 2

# LAYOUT SHEET 2

SCALE 1" = 20'-0
20 0 20

DATUM
VERTICAL NGVD 1929
HORIZONTAL ASSUMED

PROJECT: NEW HAVEN-WEYBRIDGE
PROJECT NO.: BHO-BTN 2005(1)
DESIGN FILE NAME: /usr/str4/83j081/sj081bdr.dgn
IPARM FILE NAME: sj081la2.i
SURVEYED BY: R. MOREAU
SQUAD LEADER: C.P. WILLIAMS
R.O.W. SHEET 7 OF 7 SHEETS
PLOT DATE: 28-FEB-2007
SURVEY DATE: 7/90
DRAWN BY: W.R. SYMONDS
SHEET 33 OF 53

Metric

# STATE OF VERMONT
# AGENCY OF TRANSPORTATION
# RIGHT OF WAY PLANS
# DETAIL SHEET

## TABLE OF PROJECT PROPERTY ACQUISITION

ALL STATIONS ARE FROM THE REVISED ℄

| PARCEL NO. | GRANTOR | SHEET NO. | BEGINNING STATION | ENDING STATION | TAKING | REM. | RIGHTS | TITLE TAKEN | DATE | TOWN OR CITY RECORDED | BK. | PG. | REMARKS |
|---|---|---|---|---|---|---|---|---|---|---|---|---|---|
| 1 | OMYA, INC. | 7 | 11+50 RT. | 12+49 RT. | | | CONST. (T) | WDOE | 12-01-01 | WEYBRIDGE | 39 | 405-406 | 719 SF± |
| | | | 11+50 LT | 12+01 LT. | | | CONST. (T) | | | | | | 602 SF± |
| | | | 11+95 LT. | 12+17 LT. | | | CH. (P) | | | | | | 113 SF± |
| | | | 12+03 RT. | 12+45 RT. | | | SLOPE (T) | | | | | | 505 SF± |
| | | | 12+08 RT. | 12+41 RT. | | | CH. (P) | | | | | | 141 SF± |
| | | | 12+50 RT. | | | | INSTALL (T) | | | | | | OPTIONAL FLOATING CANOE LANDING |

| REVISION NO. | SHEET | DESCRIPTION OF REVISION | DATE | MADE BY | APPROVED BY |
|---|---|---|---|---|---|
| | | ELECTRONIC REPRODUCIBLES TO STRUCTURES | 04-23-03 | | |

ACCT.rdrown
M:\Projects\89J08I\RightOfWay\rJ08id.dgn
DATE PLOTTED 28-FEB-2007

DR. (P)- DRAINAGE RIGHT
DIT. (P)- DITCHING RIGHT
CH. (P)- CHANNEL RT.
DRIVE (T)- DRIVE RIGHT
CUL. (P)- CULVERT RIGHT
[W]- WATER SOURCES

PRESENT R.O.W.
TAKING WITHOUT ACCESS
TAKING WITHOUT ACCESS ALONG PROPERTY LINE
TAKING WITH ACCESS
(P) PERMANENT EASEMENT
(T) TEMPORARY EASEMENT

LEGEND
C&T (P) CLEARING & TRIMMING
CZ (P) CLEAR ZONE
CONSI. (T) CONSTRUCTION EASEMENT
SR SLOPE RIGHTS
P PROPERTY LINE
L TOP OF CUT
TOE OF SLOPE

APPROVED: ROGER P. DUMAS DATE: 3-31-00
AGENT D. PLANS & TITLES

R. O. W. PLANS
NEW HAVEN-WEYBRIDGE
BHO-BTN. 2005(1)
SHEET 34 OF 53

STATE OF VERMONT
AGENCY OF TRANSPORTATION


# REINFORCING STEEL SCHEDULE

| | EACH | SIZE | LENGTH | MARK | TYPE | A | B | C | D | E | F | G | H | J | K | R | O |
|---|---|---|---|---|---|---|---|---|---|---|---|---|---|---|---|---|---|
| | **ABUTMENT #1** | | | | | | | | | | | | | | | | |
| △ | 21 | 5 | 30'- 6" | 1A501 | STR | | | | | | | | | | | | |
| | 32 | 5 | 4'- 3" | 1A502 | STR | | | | | | | | | | | | |
| △ | 20 | 8 | 3'- 6" | 1A801 | STR | | | | | | | | | | | | |
| | 32 | 5 | 6'- 10" | 1A503 | 17 | | - - | 2'- 10" | 4'- 0" | | | | | | | | |
| | 32 | 5 | 8'- 0" | 1A504 | 17 | | 3'- 7" | 0'- 10" | 3'- 7" | | | | | | | | |
| | **ABUTMENT #2** | | | | | | | | | | | | | | | | |
| △ | 15 | 5 | 28'- 10" | 2A501 | STR | | | | | | | | | | | | |
| ▲ | 60 | 5 | 4'- 4" | 2A502 | STR | | | | | | | | | | | | |
| △ | 18 | 8 | 3'- 6" | 2A801 | STR | | | | | | | | | | | | |
| | 30 | 5 | 6'- 4" | 2A503 | 17 | | 1'- 11" | 2'- 6" | 1'- 11" | | | | | | | | |

| ITEM | EACH | SIZE | LENGTH | MARK | TYPE | A | B | C | D | E | F | G | H | J | K | R | O |
|---|---|---|---|---|---|---|---|---|---|---|---|---|---|---|---|---|---|

## ~ NOTES ~

1. UNLESS OTHERWISE DESIGNATED, ALL BAR REINFORCEMENT FOR CONCRETE IN SIZES UP TO AND INCLUDING NO. 18 SHALL CONFORM TO THE REQUIREMENTS OF THE "SPECIFICATIONS FOR DEFORMED BILLET-STEEL BARS FOR CONCRETE REINFORCEMENT", AASHTO M 31 (ASTM A 615-SI). ALL BARS SHALL BE GRADE 60, UNLESS OTHERWISE DESIGNATED.
2. FOR TYPICAL BENDING DETAILS, RECOMMENDED PIN DIAMETER "D" OF BENDS AND HOOKS, AND OTHER STANDARD PRACTICE, SEE CURRENT CONCRETE REINFORCING STEEL INSTITUTE "MANUAL OF STANDARD PRACTICE".
3. BARS WHICH REQUIRE MORE ACCURATE BENDING THAN STANDARD PRACTICES SHOULD HAVE LIMITS INDICATED.
4. ALL DIMENSIONS ARE OUT TO OUT OF BAR EXCEPT "A" AND "G" ON STANDARD 180 DEGREE AND 135 DEGREE HOOKS.
5. "J" DIMENSION ON 180 DEGREE HOOKS TO BE SHOWN ONLY WHERE NECESSARY TO RESTRICT HOOK SIZE. OTHERWISE, STANDARD HOOKS ARE TO BE USED.
6. "H" DIMENSION ON STIRRUPS TO BE SHOWN ONLY WHEN NECESSARY TO MAINTAIN CLEARANCES.
7. WHERE SLOPE DIFFERS FROM 45 DEGREES, DIMENSIONS "H" AND "K" MUST BE SHOWN.
8. ▲ DENOTES BARS TO BE CUT IN FIELD.
9. + DENOTES ONE EXTRA BAR ADDED FOR TESTING PURPOSES.
10. △ DENOTES TWO EXTRA BARS ADDED FOR TESTING PURPOSES.
11. "E" IN PREFIX DENOTES EPOXY COATED REINFORCING STEEL.

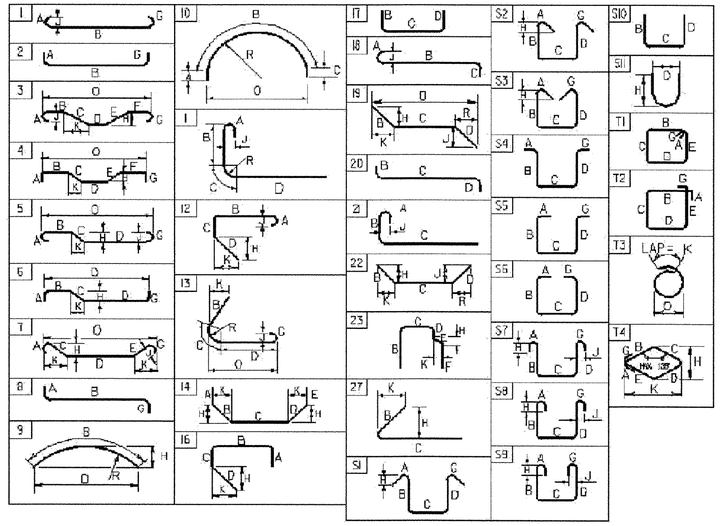



**ASTM STANDARD REINFORCING BARS**

| BAR SIZE DESIGNATION | WEIGHT POUNDS PER FOOT | NOMINAL DIMENSIONS ROUND SECTION | | |
|---|---|---|---|---|
| | | DIAMETER INCHES | AREA INCHES $^2$ | PERIMETER INCHES |
| #3 | 0.376 | 0.375 | 0.11 | 1.178 |
| #4 | 0.668 | 0.500 | 0.20 | 1.571 |
| #5 | 1.043 | 0.625 | 0.31 | 1.963 |
| #6 | 1.502 | 0.750 | 0.44 | 2.356 |
| #7 | 2.044 | 0.875 | 0.60 | 2.749 |
| #8 | 2.670 | 1.000 | 0.79 | 3.142 |
| #9 | 3.400 | 1.128 | 1.00 | 3.544 |
| #10 | 4.303 | 1.270 | 1.27 | 3.990 |
| #11 | 5.313 | 1.410 | 1.56 | 4.430 |
| #14 | 7.65 | 1.693 | 2.25 | 5.32 |
| #18 | 13.60 | 2.257 | 4.00 | 7.09 |

PROJECT NAME: NEW HAVEN - WEYBRIDGE
PROJECT NUMBER: BHO - BTN 2005 (1)


FILE NAME: sj081reinf.xls
PROJECT LEADER: C. P. WILLIAMS
DESIGNED BY: R. S. YOUNG
REINFORCING STEEL SCHEDULE SHEET #1

PLOT DATE: 3/17/2003
DRAWN BY: R. S. YOUNG
CHECKED BY: J. L. SCHULTZ
SHEET 35 OF 53

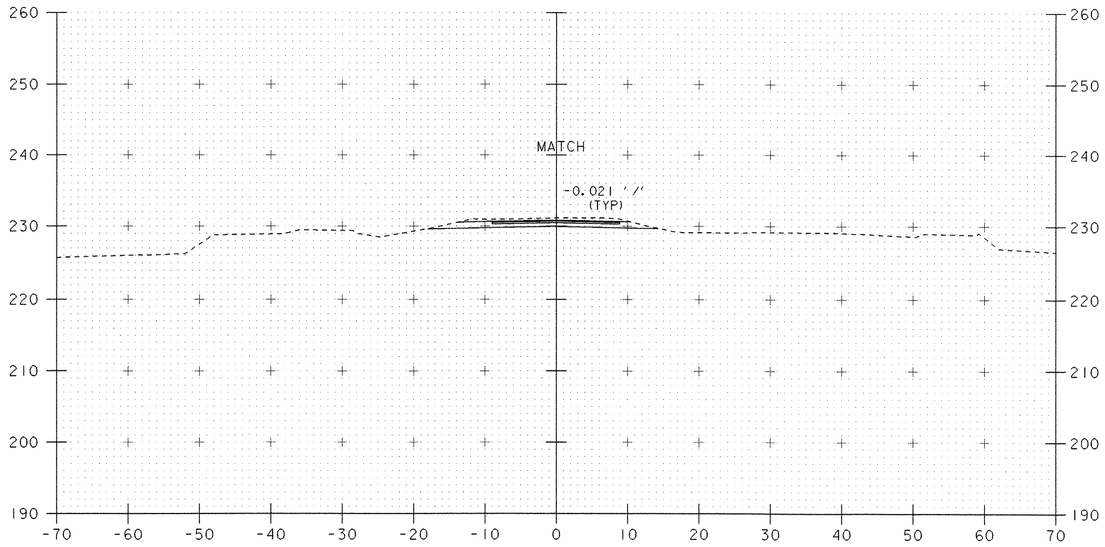



11+50


BEGIN APPROACH
STA 11+50.00

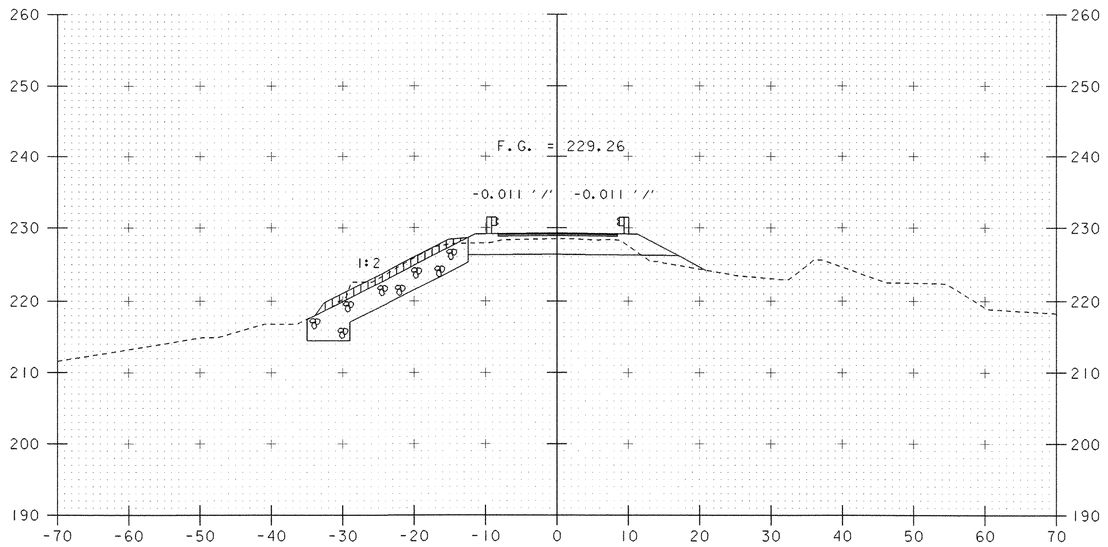


12+00

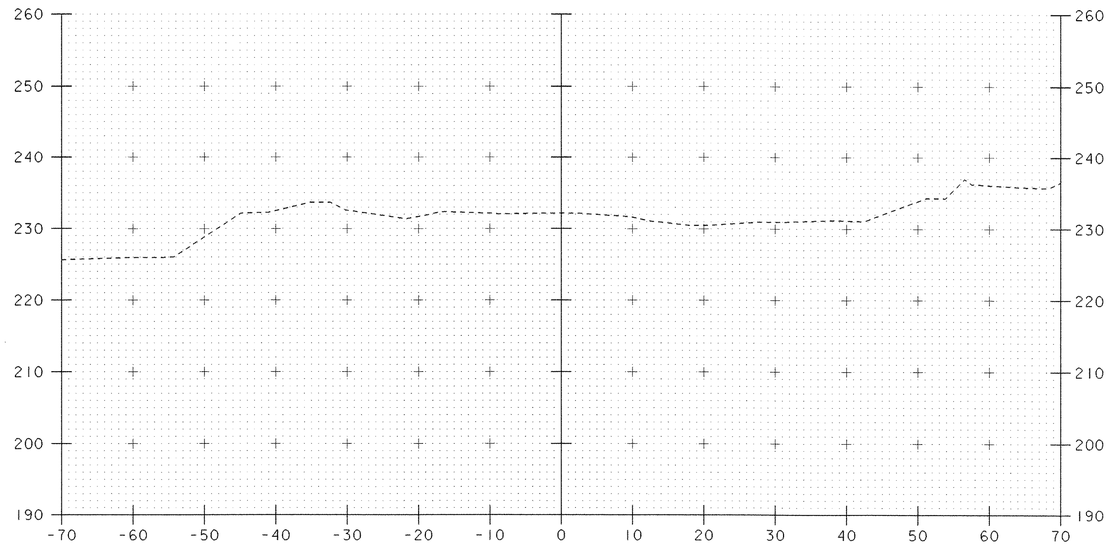

11+25

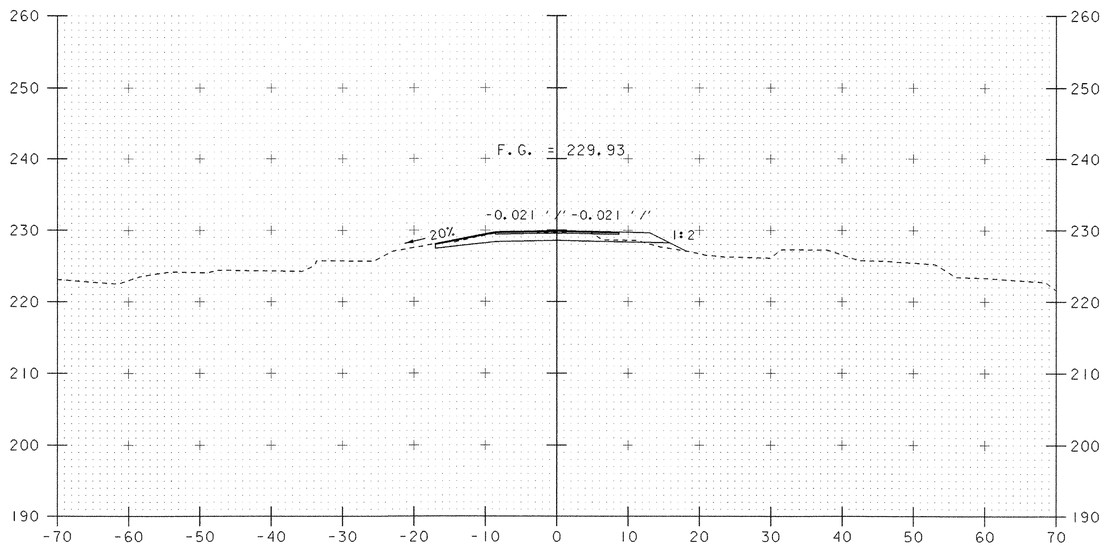



11+75

**DATUM**
VERTICAL NGVD
HORIZONTAL ASSUMED


SCALE 1" = 10'-0
10 0 10

PROJECT: NEW HAVEN - WEYBRIDGE
PROJECT NO.: BHO-BTN 2005 (1)
DESIGN FILE NAME: /str4/89j081/sj081xs1.dgn
IPARM FILE NAME: sj081m11.i
SURVEYED BY: R. MOREAU
SQUAD LEADER: C.P. WILLIAMS
MAINLINE SECTIONS STA. 11+25 - STA. 12+00
PLOT DATE: 28-FEB-2007
SURVEY DATE: 7/90
DRAWN BY: P.G. JARVIS
SHEET: 36 OF 53

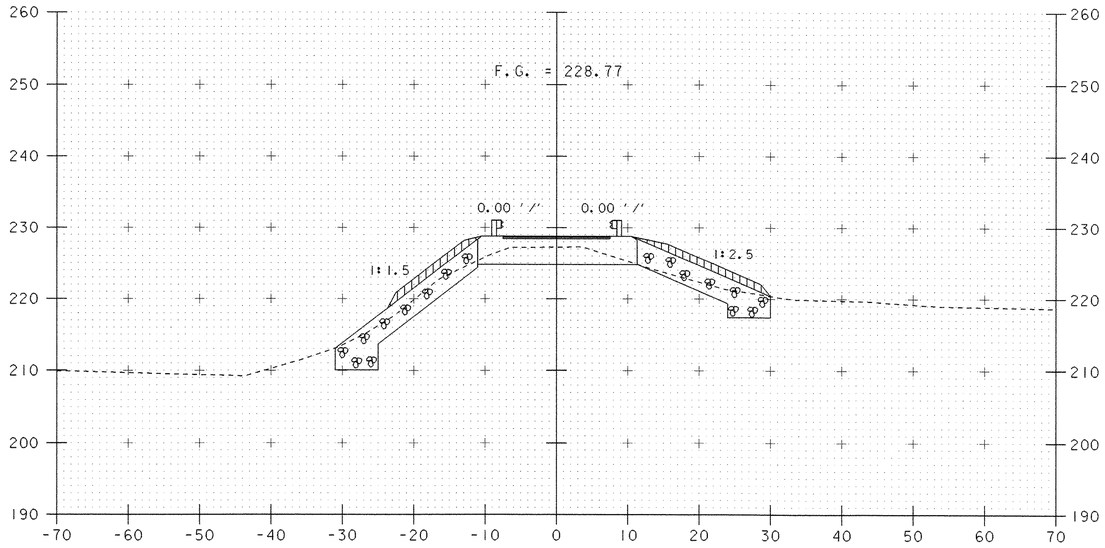



12+26.75

BEGIN BRIDGE
STA 12+26.75

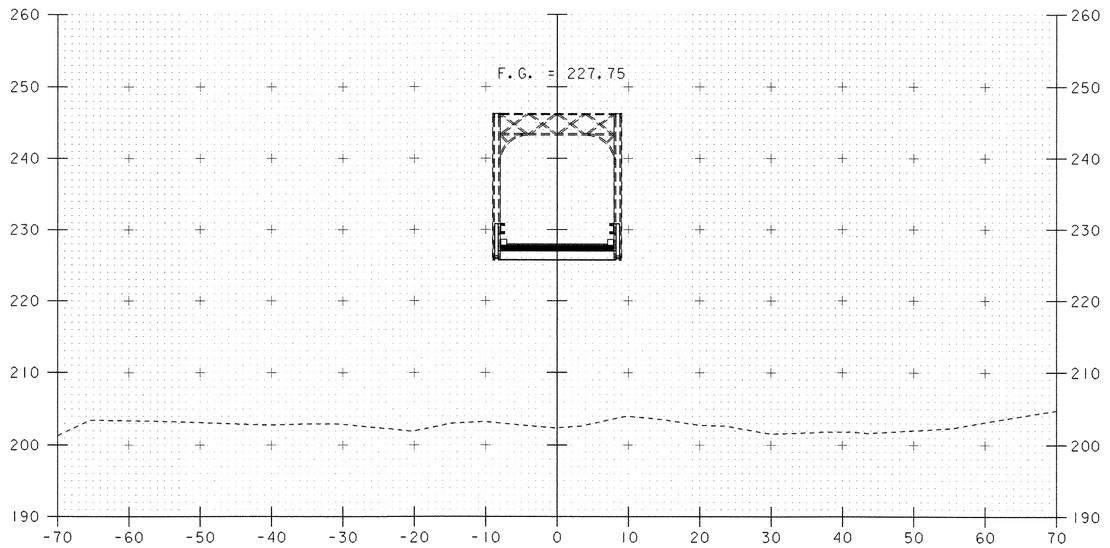



13+00

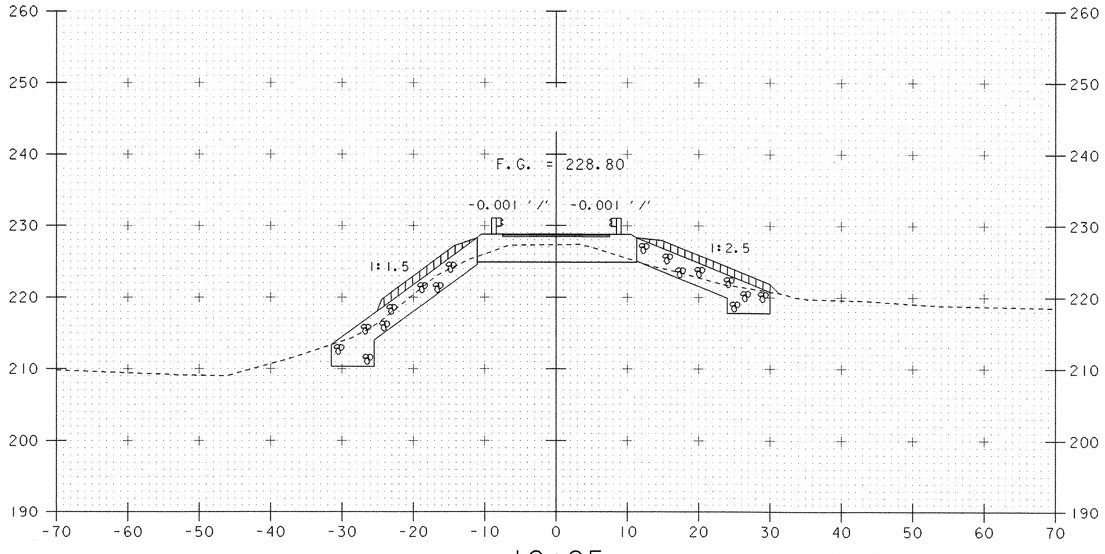


12+25

END APPROACH
BEGIN PROJECT
STA 12+25.00

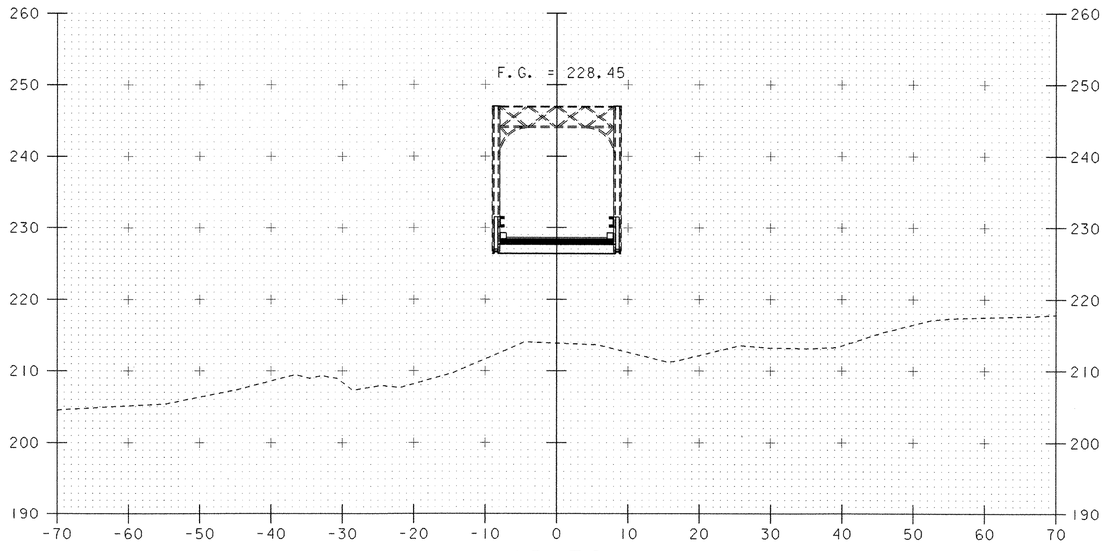



12+50

**DATUM**
VERTICAL NGVD
HORIZONTAL ASSUMED

SCALE 1" = 10'-0
10 0 10


PROJECT: NEW HAVEN - WEYBRIDGE
PROJECT NO.: BHO-BTN 2005 (1)

DESIGN FILE NAME: /str4/89j081/sj081xsl.dgn
IPARM FILE NAME: sj081m12.i
SURVEYED BY: R. MOREAU
SQUAD LEADER: C.P. WILLIAMS
MAINLINE SECTIONS STA. 12+25 - STA. 13+00
PLOT DATE: 28-FEB-2007
SURVEY DATE: 7/90
DRAWN BY: P.G. JARVIS
SHEET: 37 OF 53

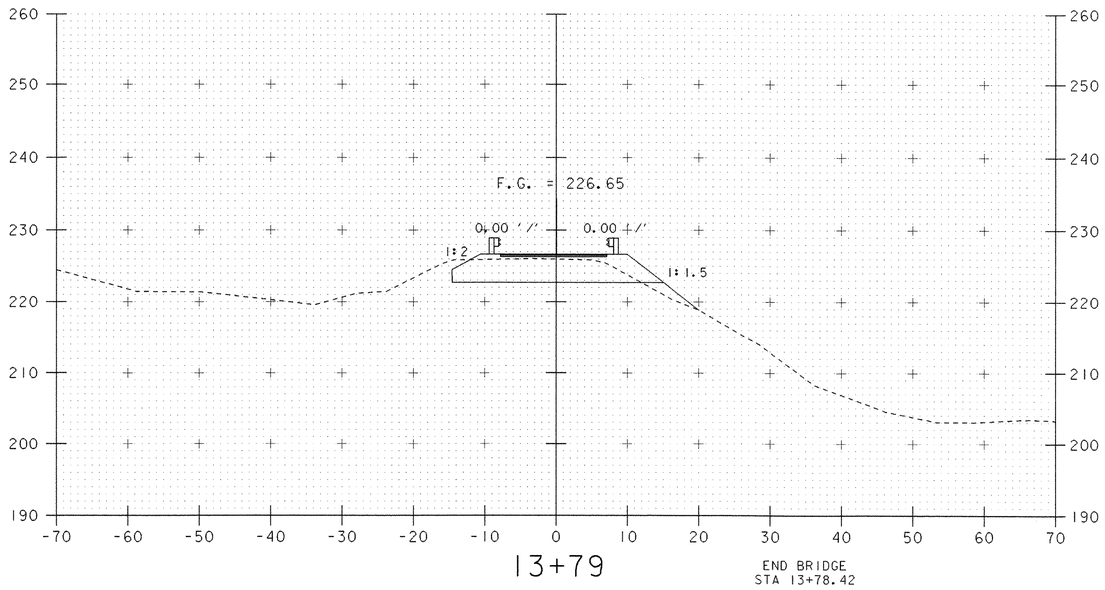



13+79

END BRIDGE
STA 13+78.42

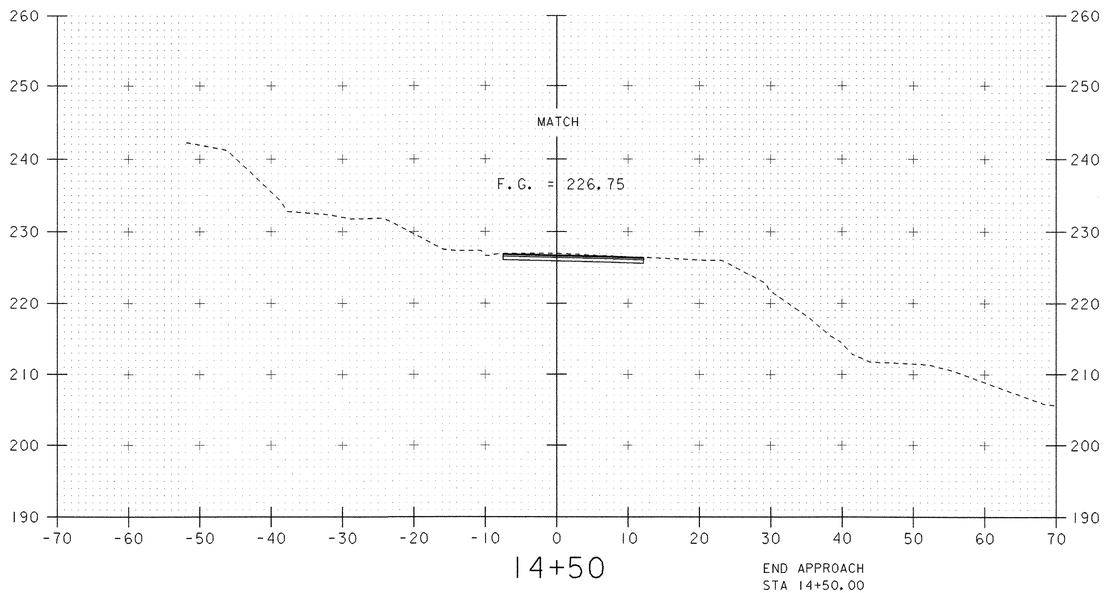



14+50

END APPROACH
STA 14+50.00

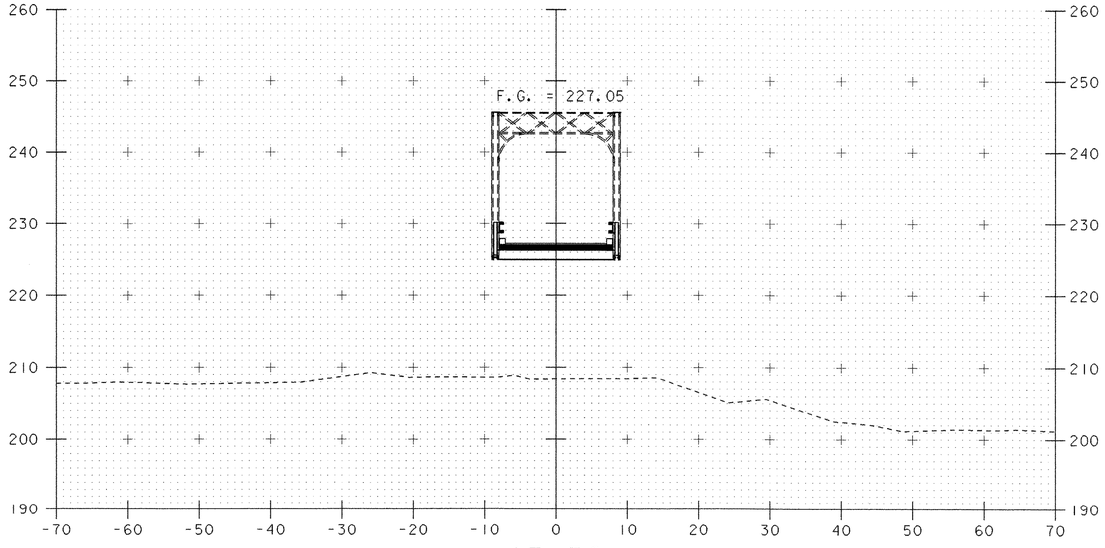


13+50

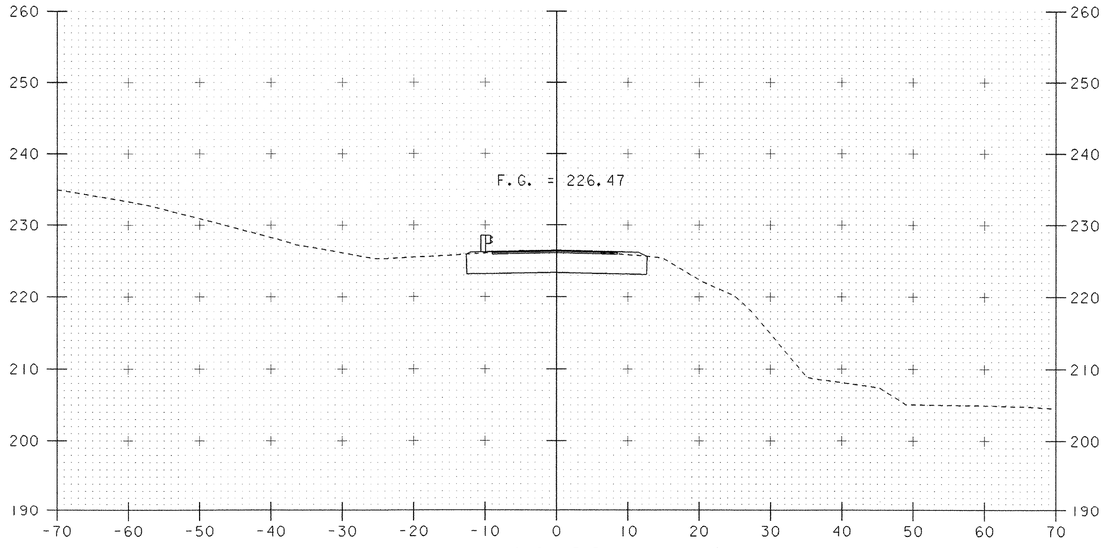


END PROJECT
BEGIN APPROACH
STA 13+80.00


14+00

**DATUM**
VERTICAL NGVD
HORIZONTAL ASSUMED

SCALE 1" = 10'-0
10 0 10


| PROJECT: | PROJECT NO.: |
|---|---|
| NEW HAVEN - WEYBRIDGE | BHO-BTN 2005(1) |

DESIGN FILE NAME: /str4/89j081/sj081xs1.dgn
IPARM FILE NAME: sj081m13.i
SURVEYED BY: R. MOREAU
SQUAD LEADER: C.P. WILLIAMS
MAINLINE SECTIONS STA. 13+50 - STA. 14+50
PLOT DATE: 28-FEB-2007
SURVEY DATE: 7/90
DRAWN BY: P.G. JARVIS
SHEET: 38 OF 53

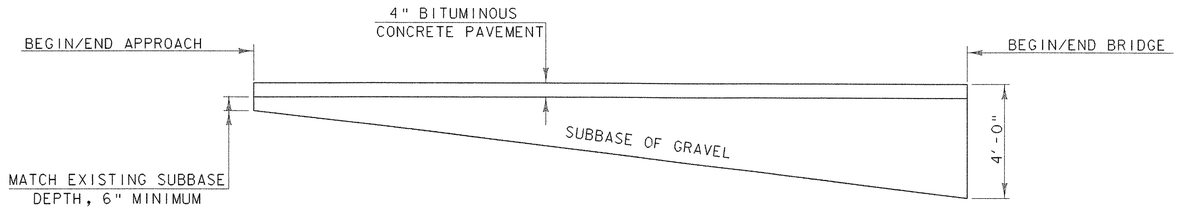



## TAPER SUBBASE DETAIL

NTS

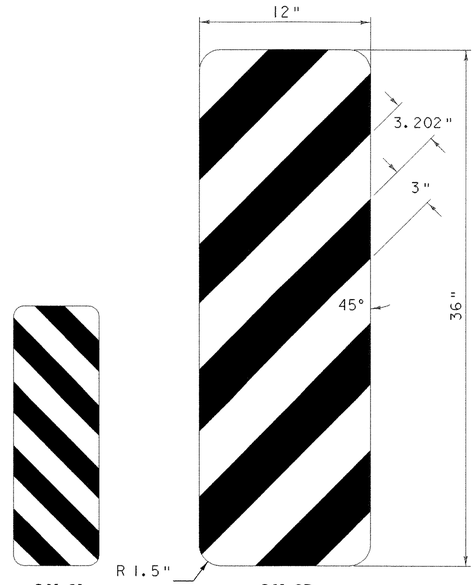



**OM-3L** **OM-3R**

COLORS
STRIPES-BLACK (NON - REFL)
BACKROUND - YELLOW (RETROREFLECTIVE)

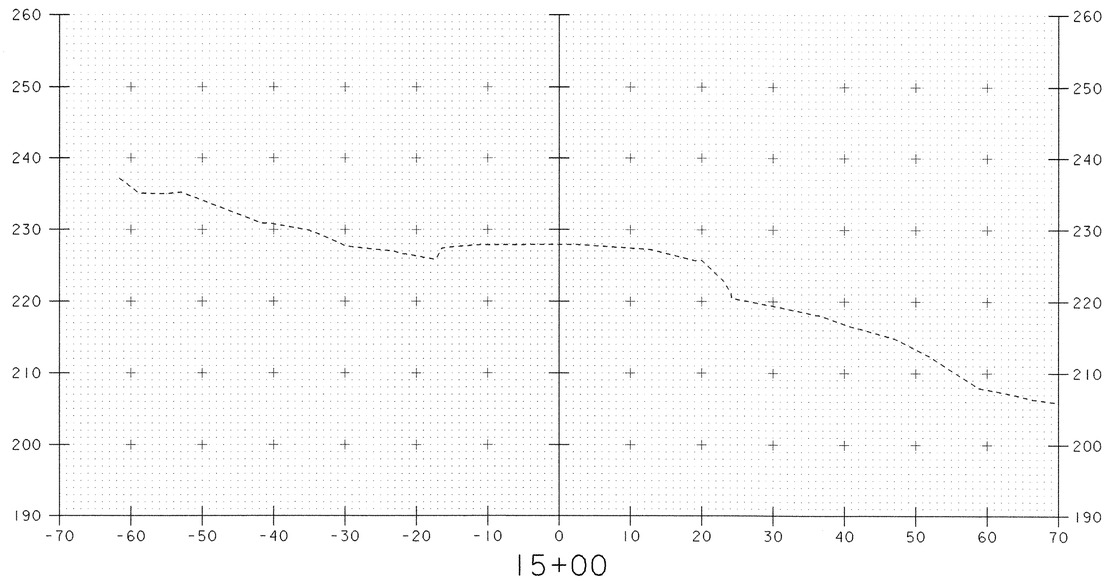


15+00

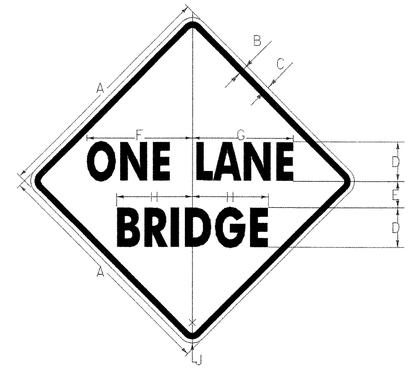


**W5-3**

| SIGN | DIMENSIONS(INCHES) | | | | | | | | |
|---|---|---|---|---|---|---|---|---|---|
| | A | B | C | D | E | F | G | H | J |
| MIN. | 30 | 1/2 | 3/4 | 5C | 3 1/4 | 13 5/16 | 12 11/16 | 9 1/8 | 1 7/8 |
| STD. | 36 | 5/8 | 7/8 | 6C | 4 | 16 | 15 1/4 | 11 1/2 | 2 1/4 |
| SPECIAL | 48 | 3/4 | 1 1/4 | 8C | 5 | 21 1/4 | 20 1/4 | 15 3/8 | 3 |


COLORS
LEGEND- BLACK (NON - REFL)
BACKROUND - YELLOW (RETROREFLECTIVE)

**DATUM**
VERTICAL NGVD
HORIZONTAL ASSUMED


SCALE 1" = 10'-0
10 0 10

| PROJECT: | PROJECT NO.: |
|---|---|
| NEW HAVEN - WEYBRIDGE | BHO-BTN 2005 (1) |

DESIGN FILE NAME: /str4/89j081/sj081xs1.dgn
IPARM FILE NAME: sj081m14.i
SURVEYED BY: R. MOREAU
SQUAD LEADER: C.P. WILLIAMS
MAINLINE SECTION STA. 15+00
PLOT DATE: 28-FEB-2007
SURVEY DATE: 7/90
DRAWN BY: P.G. JARVIS
SHEET: 39 OF 53

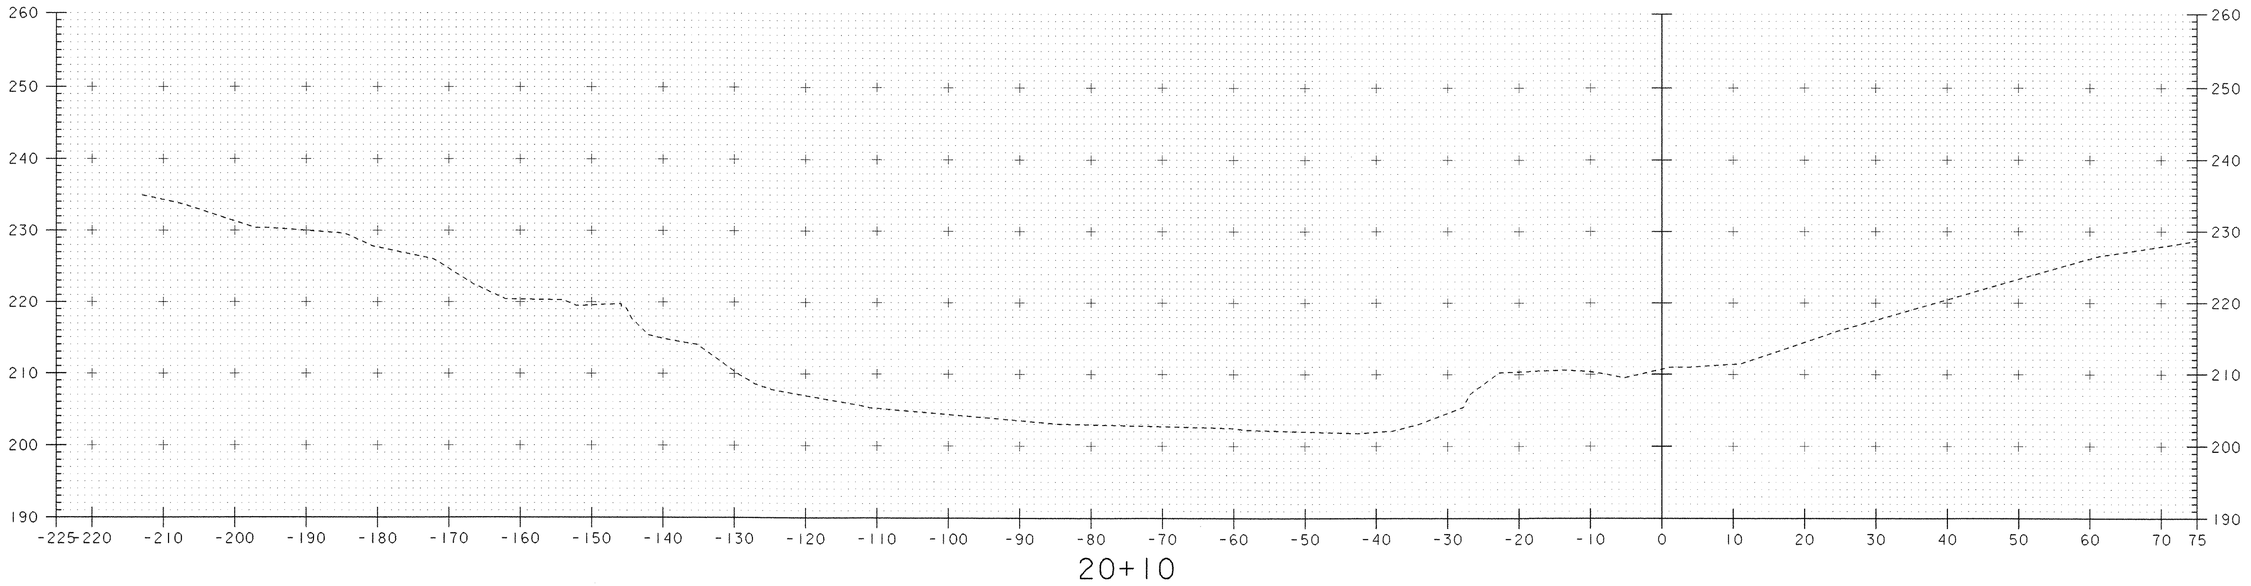


20+10

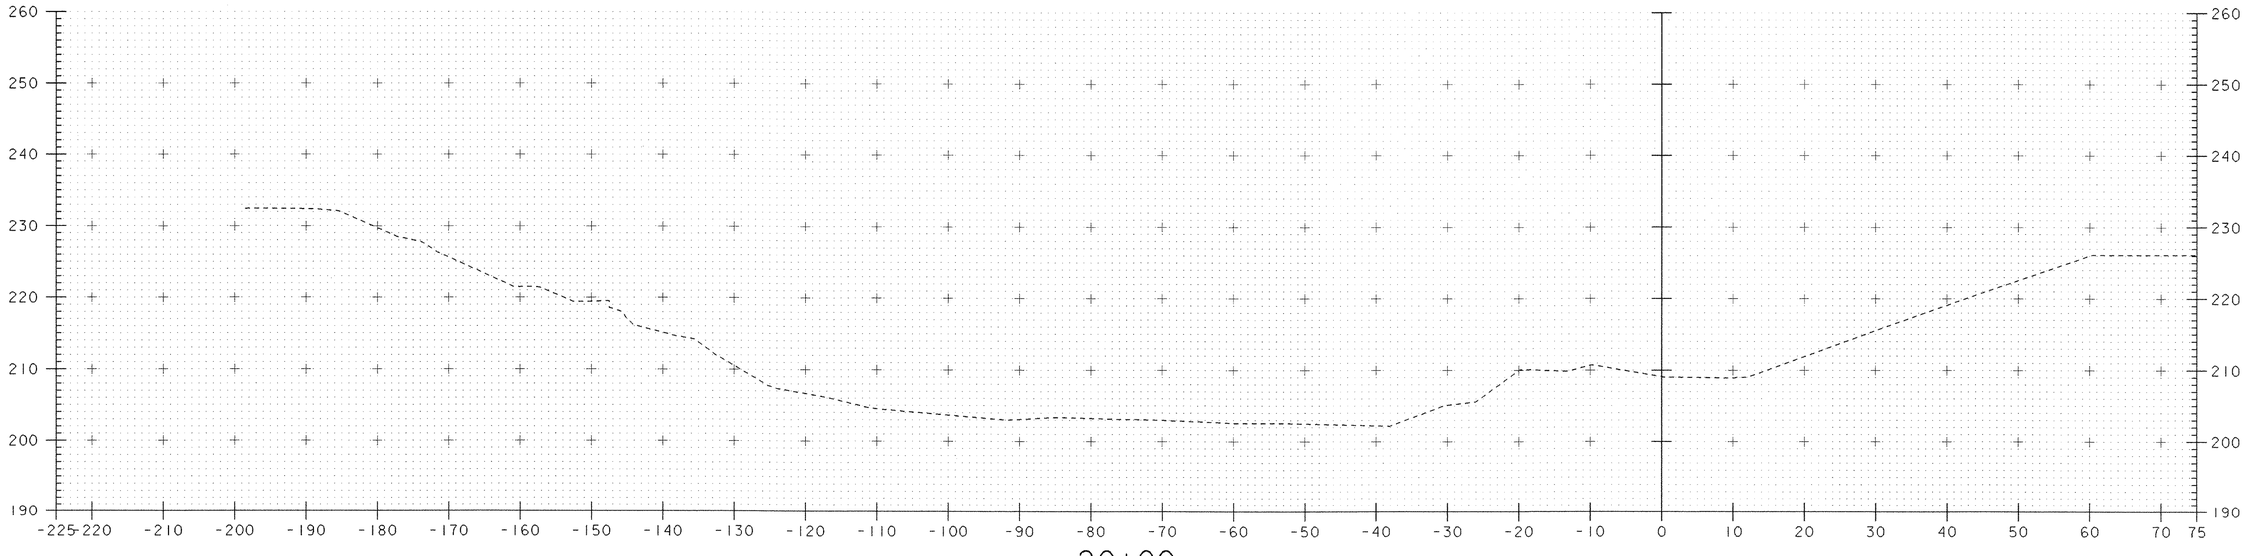



20+00


**DATUM**
VERTICAL NGVD
HORIZONTAL ASSUMED

SCALE 1" = 10'-0
10 0 10

| PROJECT: NEW HAVEN - WEYBRIDGE | PROJECT NO.: BHO-BTN 2005 (1) |
|---|---|
| DESIGN FILE NAME: /str4/89j081/sj081xs1.dgn | |
| IPARM FILE NAME: sj081c11.i | PLOT DATE: 28-FEB-2007 |
| SURVEYED BY: R. MOREAU | SURVEY DATE: 7/90 |
| SQUAD LEADER: C.P. WILLIAMS | DRAWN BY: P.G. JARVIS |
| CHANNEL SECTIONS STA. 20+00 - STA. 20+10 | SHEET: 40 OF 53 |

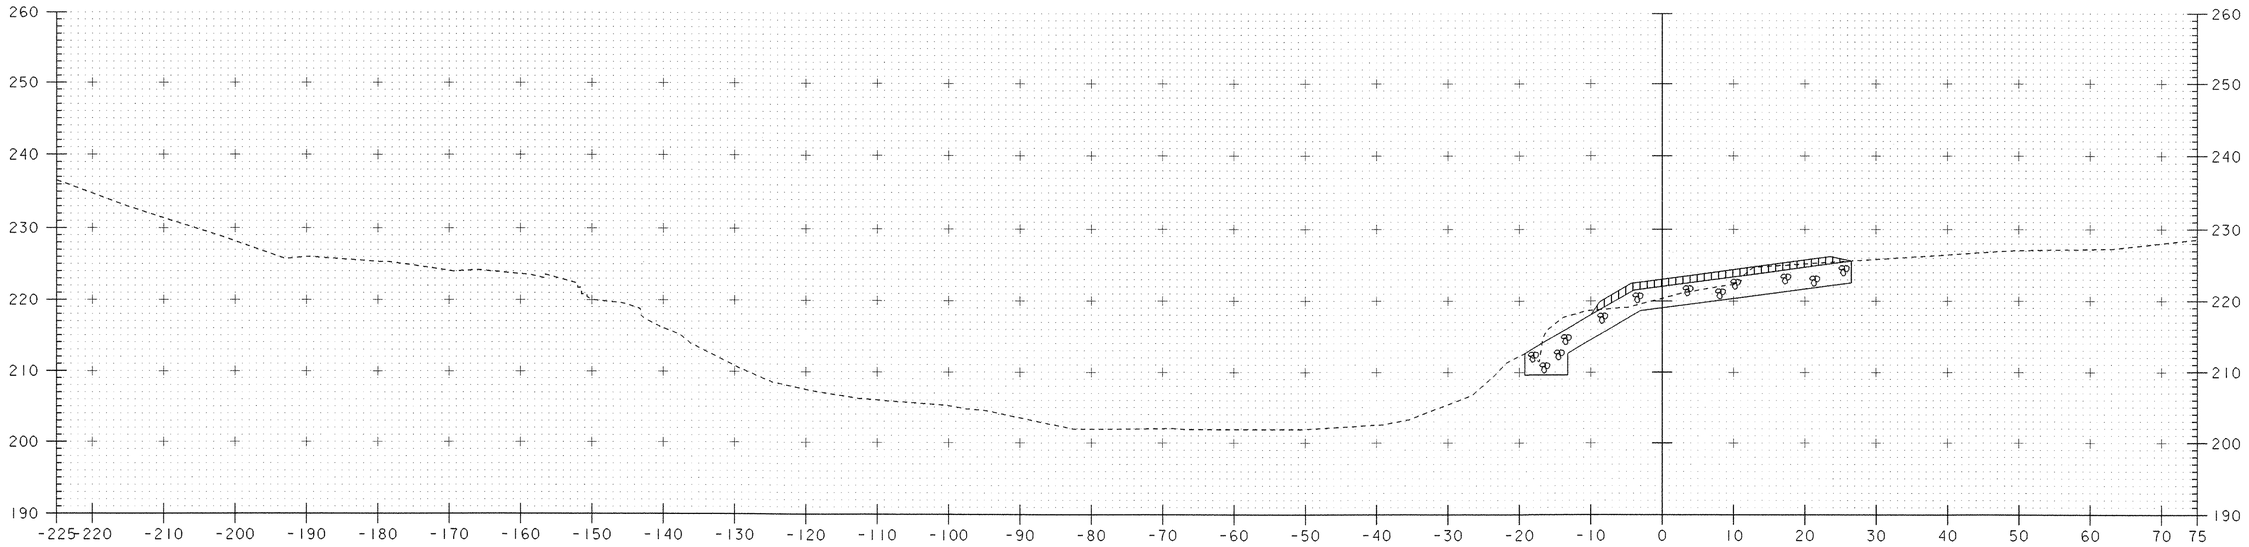


20+30

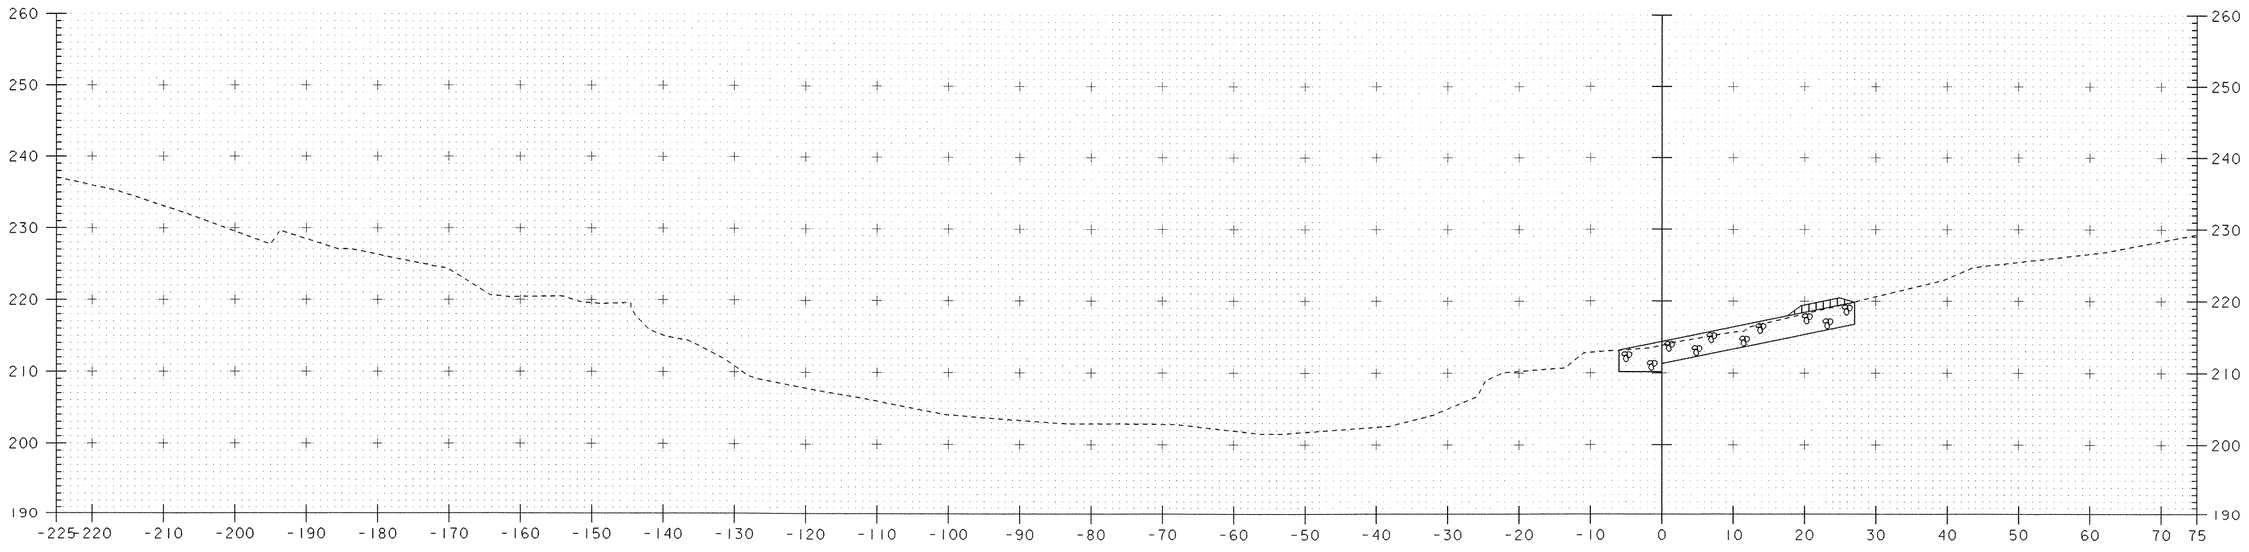


20+20


STA 20+15
(ABUTMENT No. 1)

BEGIN STONE FILL TYPE III
BEGIN GEOTEXTILE UNDER STONE FILL
BEGIN GRUBBING MATERIAL
BEGIN UNCLASSIFIED CHANNEL EXCAVATION


SCALE 1" = 10'-0
10 0 10

**DATUM**
VERTICAL NGVD
HORIZONTAL ASSUMED

| | |
|---|---|
| PROJECT: NEW HAVEN - WEYBRIDGE | PROJECT NO.: BHO-BTN 2005 (1) |
| DESIGN FILE NAME: /str4/89j081/sj081xs1.dgn | |
| IPARM FILE NAME: sj081c12.i | PLOT DATE: 28-FEB-2007 |
| SURVEYED BY: R. MOREAU | SURVEY DATE: 7/90 |
| SQUAD LEADER: C.P. WILLIAMS | DRAWN BY: P.G. JARVIS |
| CHANNEL SECTIONS STA. 20+20 - STA. 20+30 | SHEET: 41 OF 53 |

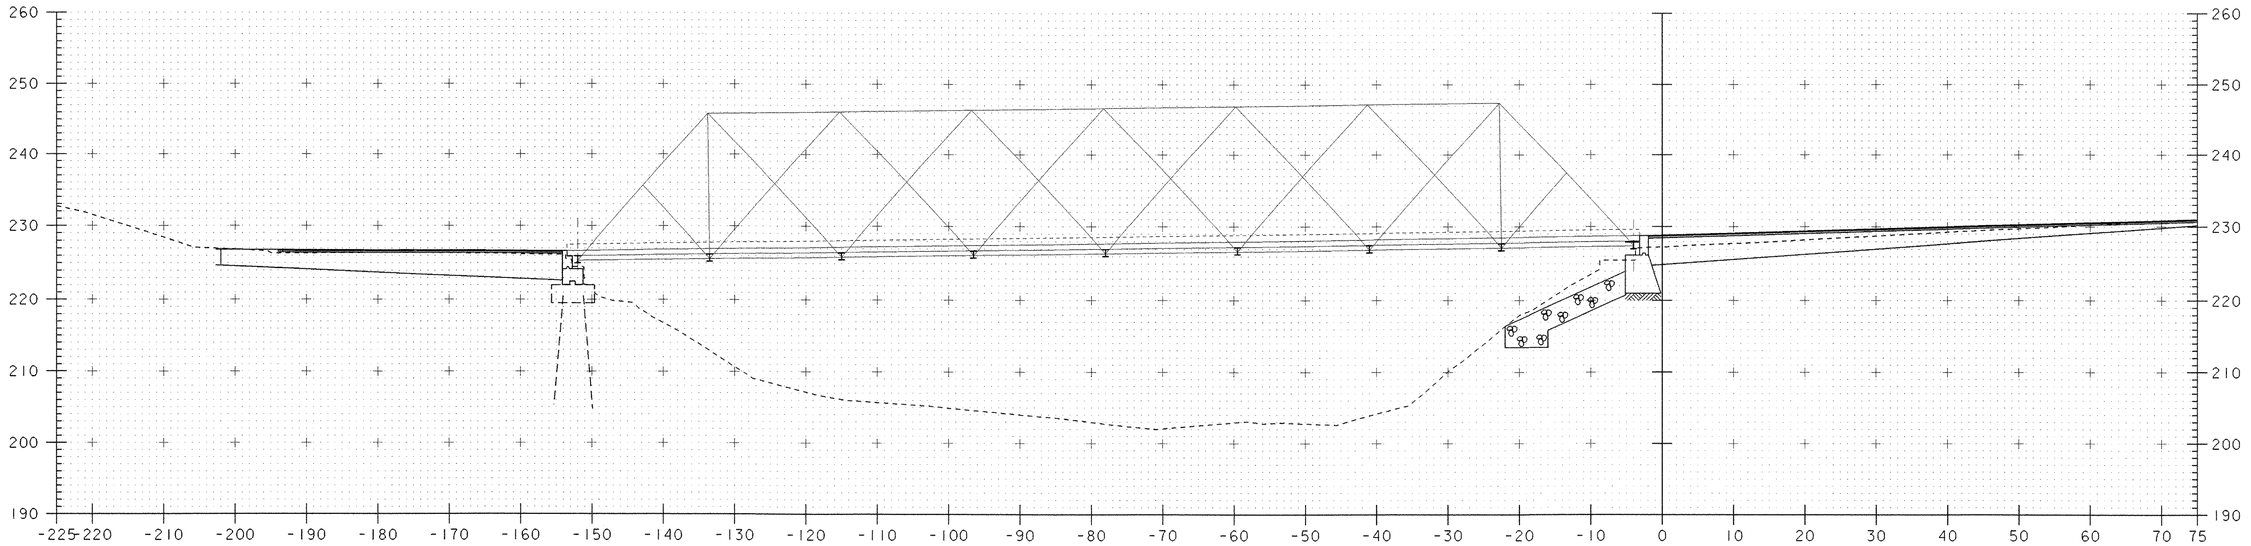


20+50

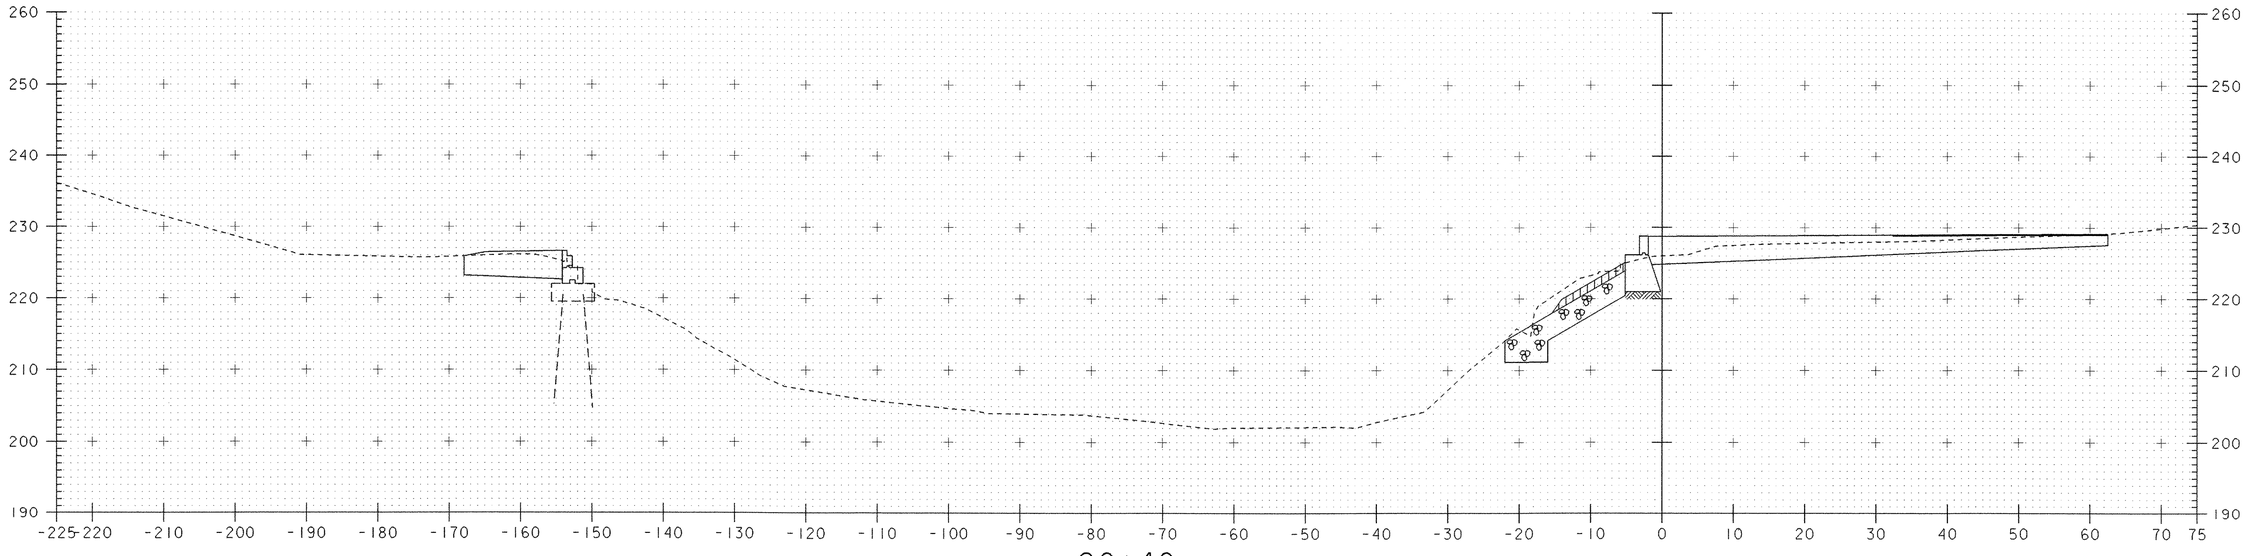



20+40


**DATUM**
VERTICAL NGVD
HORIZONTAL ASSUMED

SCALE 1" = 10'-0
10 0 10

| | |
|---|---|
| PROJECT: NEW HAVEN - WEYBRIDGE | PROJECT NO.: BHO-BTN 2005 (1) |
| DESIGN FILE NAME: /str4/89j081/sj081xs1.dgn | |
| IPARM FILE NAME: sj081c13.i | PLOT DATE: 28-FEB-2007 |
| SURVEYED BY: R. MOREAU | SURVEY DATE: 7/90 |
| SQUAD LEADER: C.P. WILLIAMS | DRAWN BY: P.G. JARVIS |
| CHANNEL SECTIONS STA. 20+40 - STA. 20+50 | SHEET: 42 OF 53 |

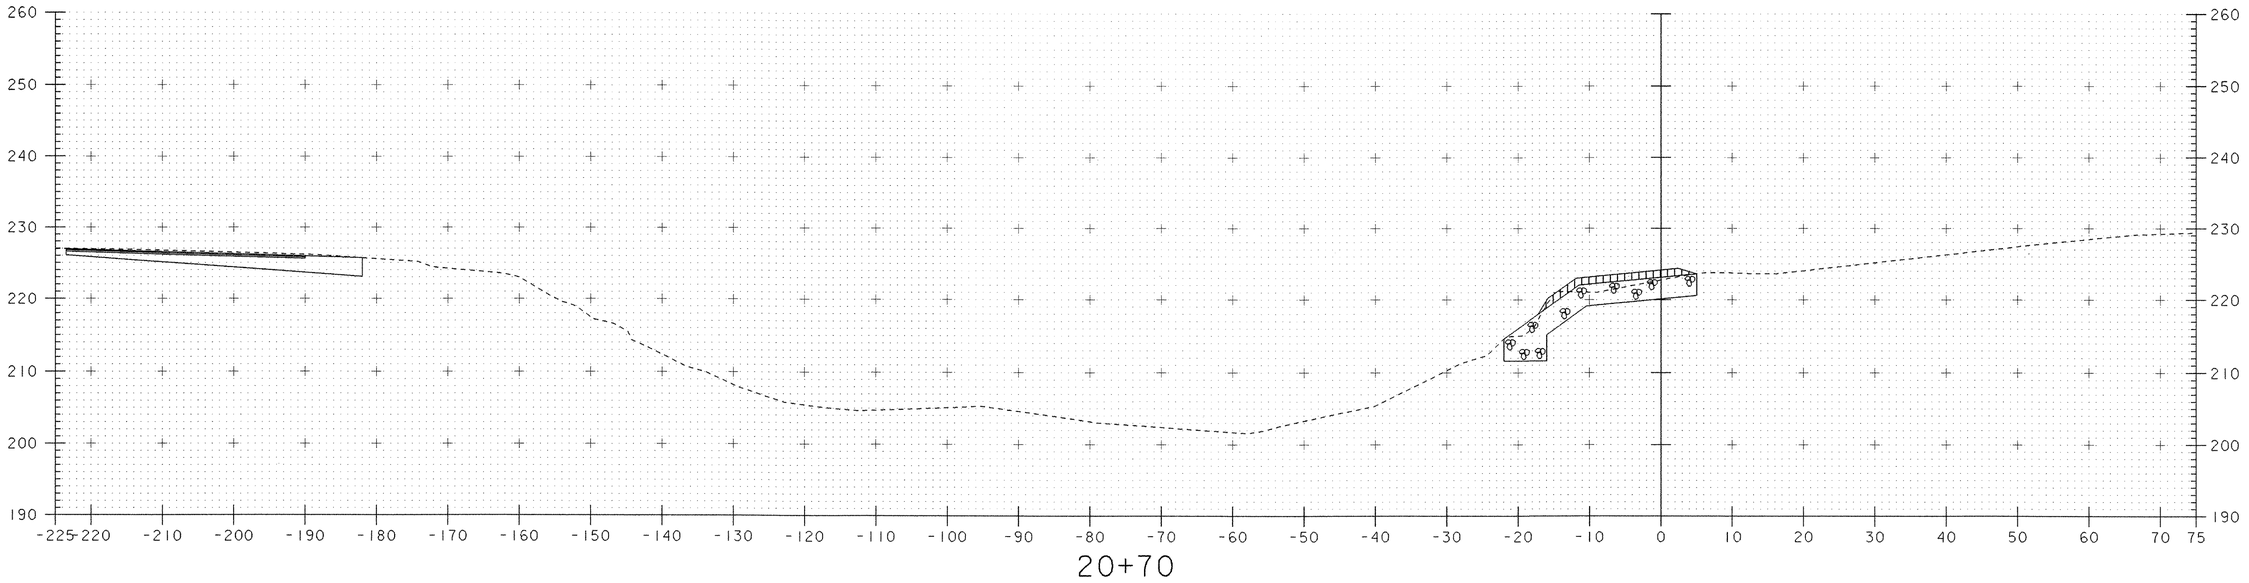


20+70

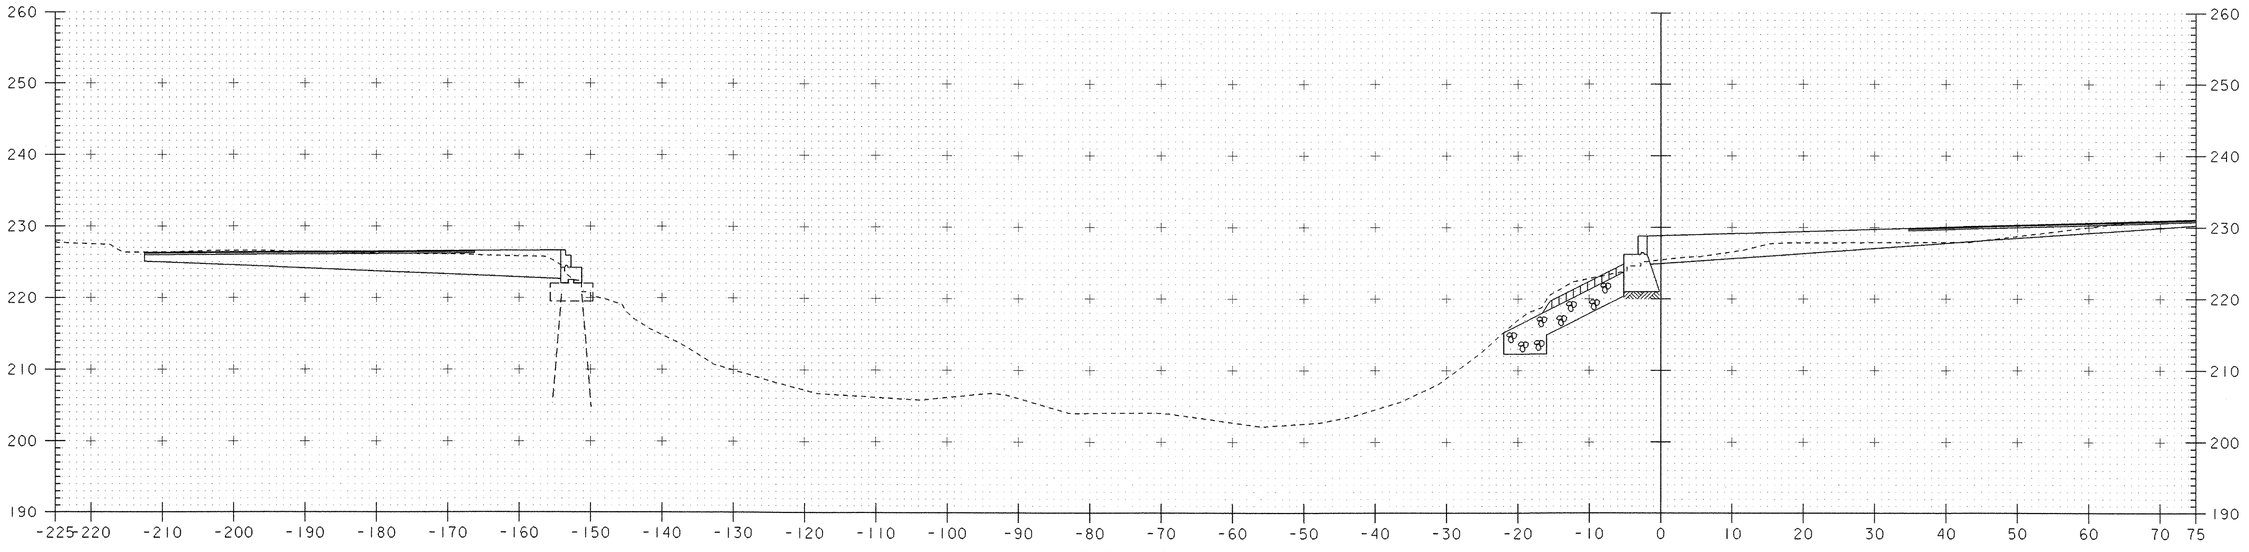



20+60


**DATUM**
VERTICAL NGVD
HORIZONTAL ASSUMED

SCALE 1" = 10'-0
10 0 10

| PROJECT: NEW HAVEN - WEYBRIDGE | PROJECT NO.: BHO-BTN 2005 (1) |
|---|---|
| DESIGN FILE NAME: /str4/89j081/sj081xs1.dgn | |
| IPARM FILE NAME: sj081c14.i | PLOT DATE: 28-FEB-2007 |
| SURVEYED BY: R. MOREAU | SURVEY DATE: 7/90 |
| SQUAD LEADER: C.P. WILLIAMS | DRAWN BY: P.G. JARVIS |
| CHANNEL SECTIONS STA. 20+60 - STA. 20+70 | SHEET: 43 OF 53 |

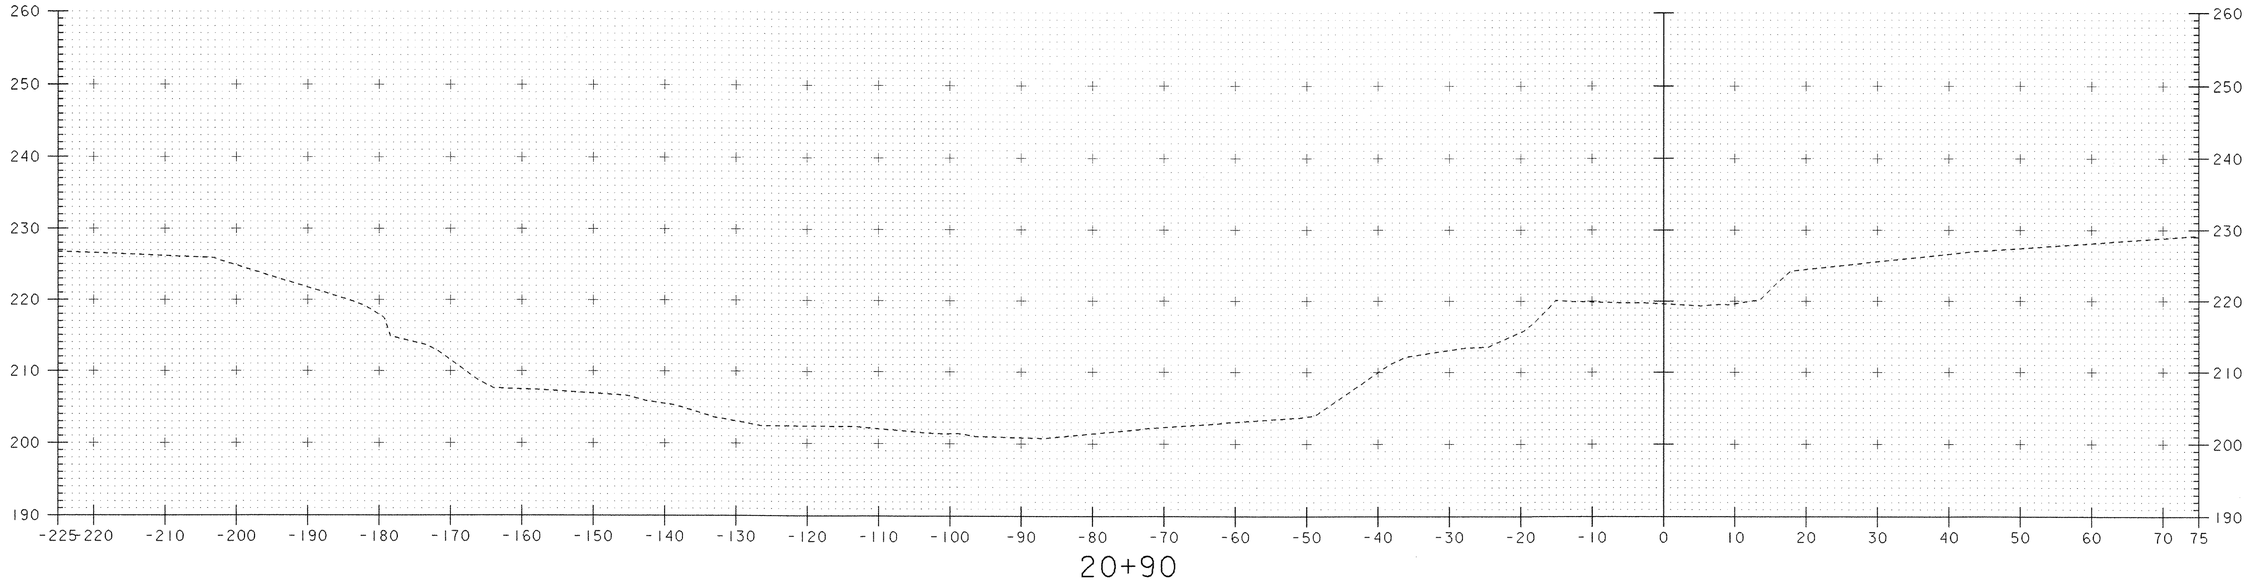


20+90

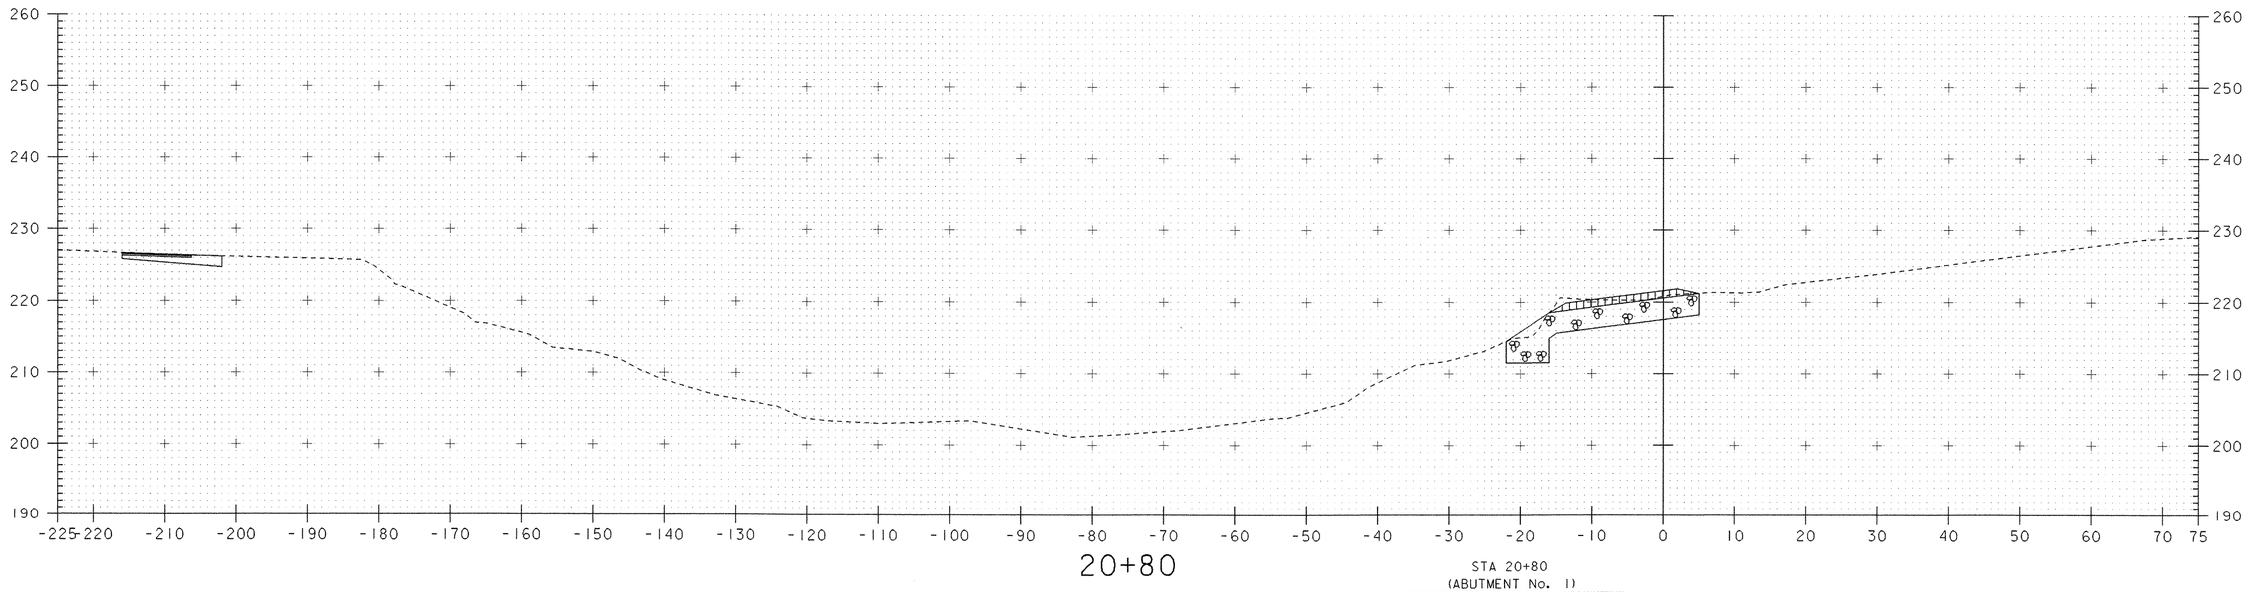


20+80


STA 20+80
(ABUTMENT No. 1)

END STONE FILL TYPE III
END GEOTEXTILE UNDER STONE FILL
END GRUBBING MATERIAL
END UNCLASSIFIED CHANNEL EXCAVATION

DATUM
VERTICAL NGVD
HORIZONTAL ASSUMED

SCALE 1" = 10'-0
10 0 10

| | |
|---|---|
| PROJECT: NEW HAVEN - WEYBRIDGE | PROJECT NO.: BHO-BTN 2005 (1) |
| DESIGN FILE NAME: /str4/89j081/sj081xs1.dgn | |
| IPARM FILE NAME: sj081c15.i | PLOT DATE: 28-FEB-2007 |
| SURVEYED BY: R. MOREAU | SURVEY DATE: 7/90 |
| SQUAD LEADER: C.P. WILLIAMS | DRAWN BY: P.G. JARVIS |
| CHANNEL SECTIONS STA. 20+80 - STA. 20+90 | SHEET: 44 OF 53 |

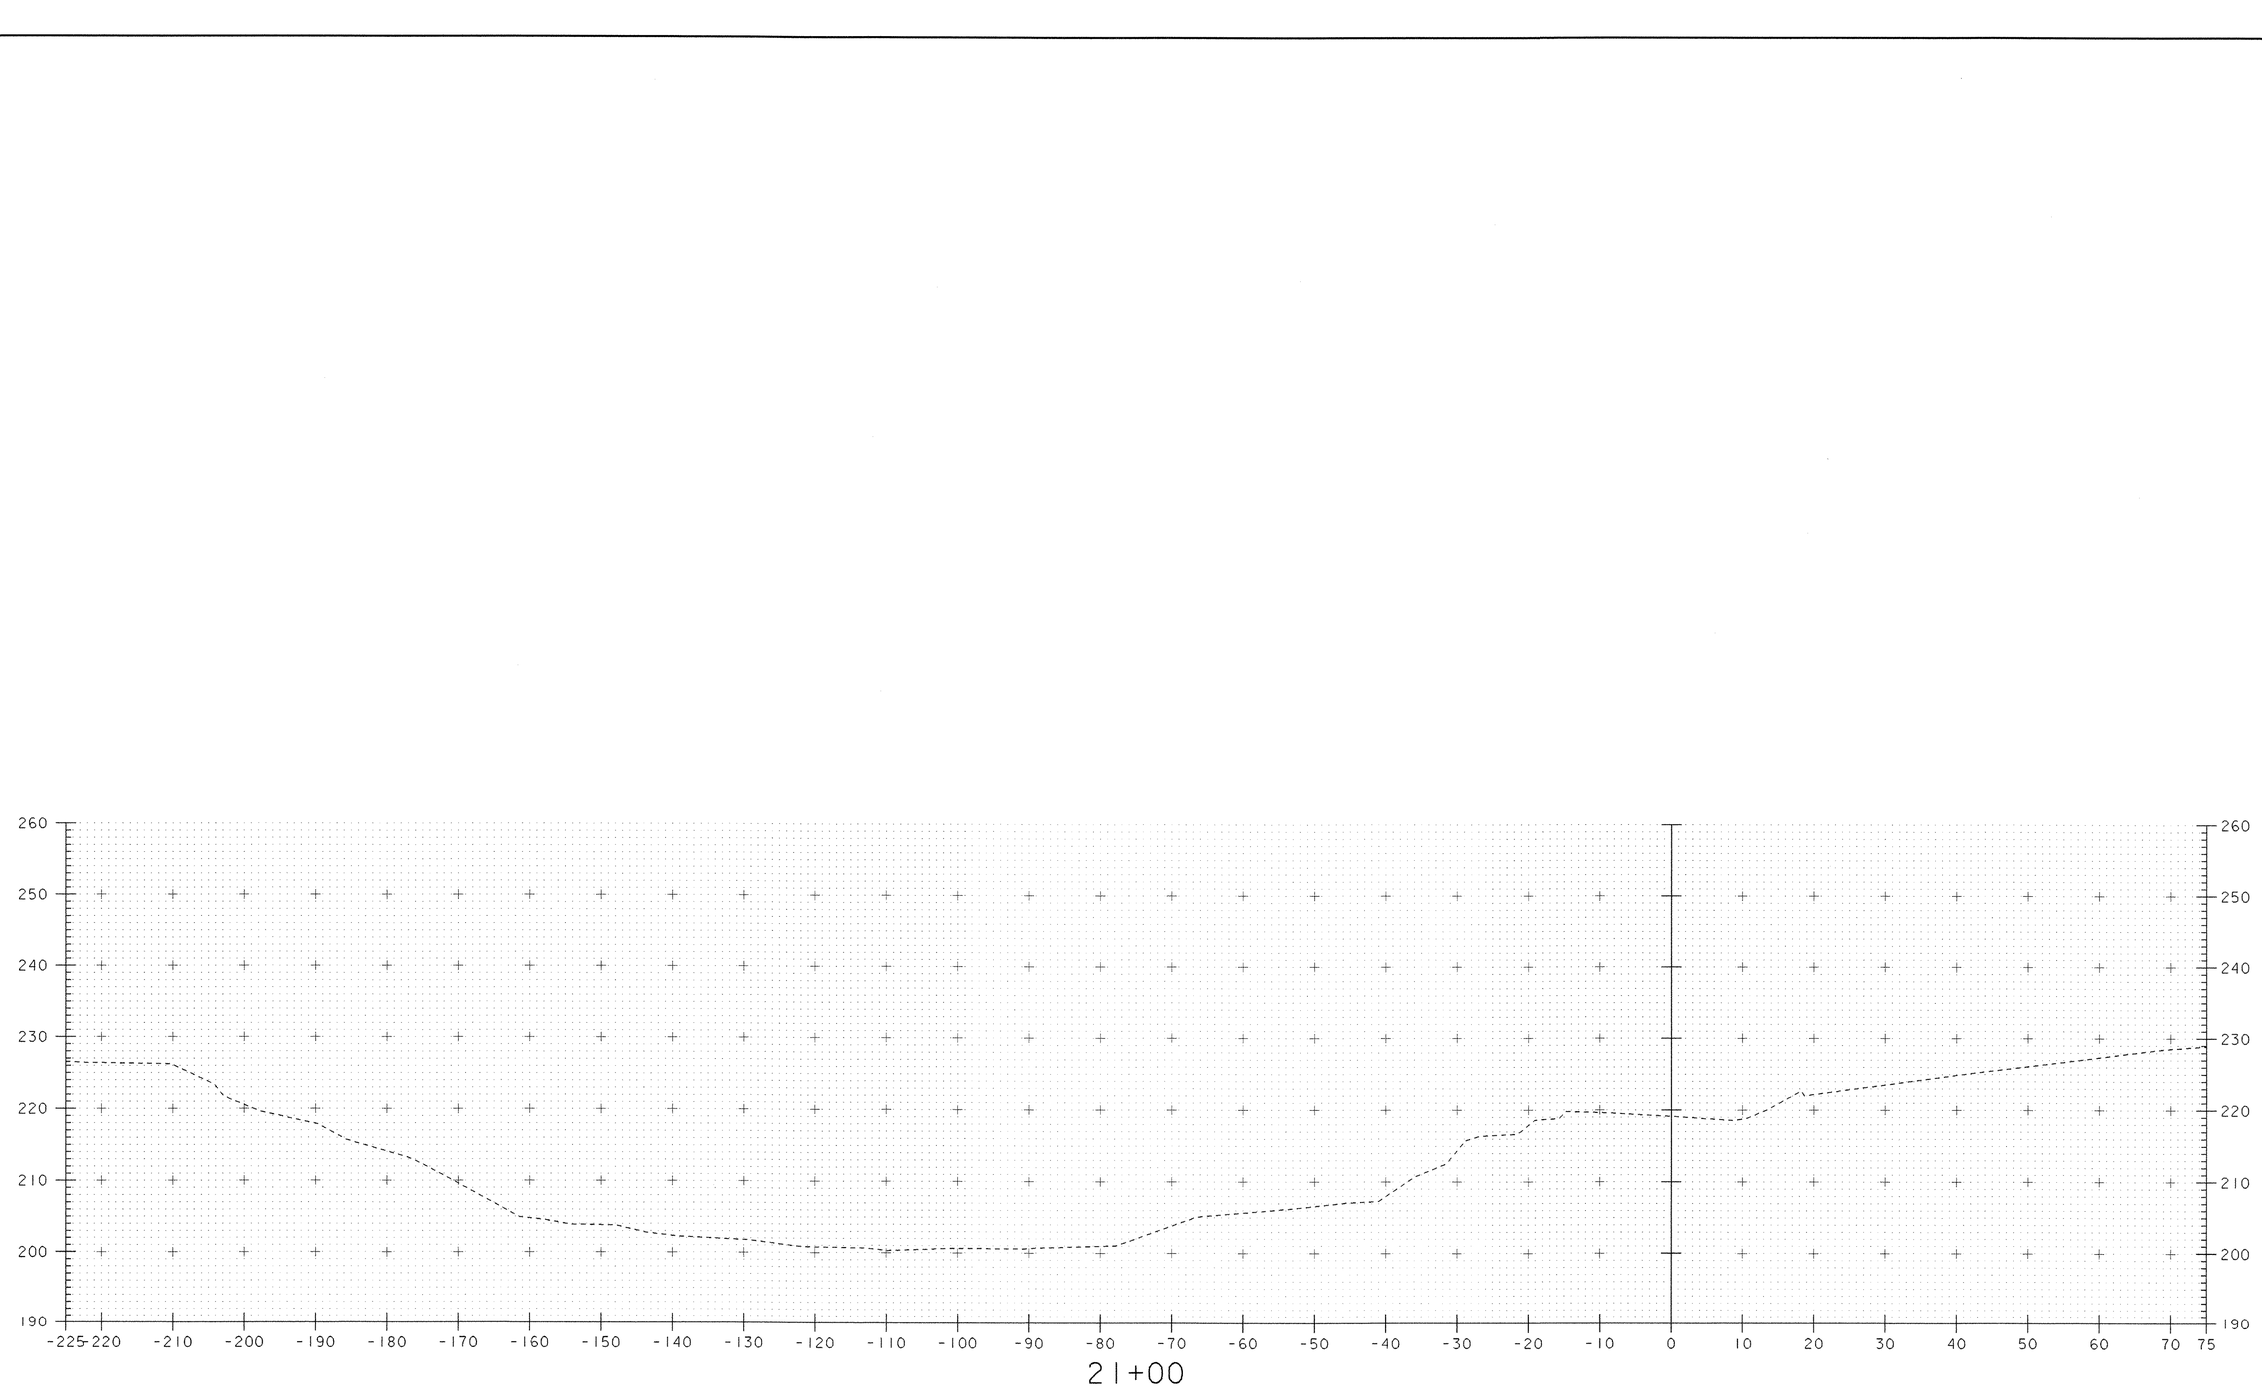


21+00

DATUM
VERTICAL NGVD
HORIZONTAL ASSUMED

SCALE 1" = 10'-0
10 0 10

PROJECT: NEW HAVEN - WEYBRIDGE
PROJECT NO.: BHO-BTN 2005 (1)

DESIGN FILE NAME: /str4/89j081/sj081xs1.dgn
IPARM FILE NAME: sj081c16.i
SURVEYED BY: R. MOREAU
SQUAD LEADER: C.P. WILLIAMS
CHANNEL SECTION STA. 21+00
PLOT DATE: 28-FEB-2007
SURVEY DATE: 7/90
DRAWN BY: P.G. JARVIS
SHEET: 45 OF 53

STATE OF VERMONT
AGENCY OF TRANSPORTATION

# EROSION CONTROL NARRATIVE

## DESCRIPTION OF PROJECT

This project involves the removal and replacement of both abutments and the rehabilitation of bridge number 26. Bridge 26 is a steel thru truss bridge spanning the Otter Creek from New Haven to Weybridge for a distance of 140 feet. The bridge is a single span, single lane bridge located in a rural area on TH 7/11. Because the project is a rehabilitation it will be located on the same alignment and require only minor approach work. Traffic will be maintained by using one of the two alternate routes that make it possible to bypass the bridge while it is closed for the rehabilitation project. The only utility is an overhead phone line that is remaining in place. The limits of construction do not approach any building or structure but there is a dam located 350 feet downstream of the bridge. A temporary floating canoe dock will be built for portage around the dam during construction. There are no 'Threatened & Endangered Species', or Historic Resources on site but there are two archeologically sensitive areas located on the Weybridge side of the project area near stations 10+00 - 11+40.

It is anticipated that this project will last one construction season.

The area of disturbance is .1719 Acres = 832 square yards

## SITE INVENTORY & ANALYSIS

**OFF SITE DRAINAGE CHARACTERISTICS:**
The property surrounding the project site consists of well established vegetation, mostly flat with slopes at the rivers edge ranging from moderate to steep. The surrounding properties are made up of fields and wooded areas. Due to the nature of the surrounding terrain, runoff water entering the project site will be primarily limited to that which is conveyed along roadway ditches.

**DRAINAGE, WATERWAYS, BODIES OF WATER:**
Otter Creek is the main water source in the area and a dam downstream has created a small pond. The river is classified as sinuous, semi-alluvial, probably incised, and not braided or anabranched. The river bed is sand, gravel, cobbles, and ledge. The contributing drainage area at the bridge crossing is about 749 sq. miles.

**TOPOGRAPHY, EXISTING ROADS, BUILDINGS, UTILITIES:**
The topography of the project site is moderate rolling wooded slopes with a steeply sloped wooded area in the northwest corner of the project area. Development along TH 7/11 consists of a few residents and a dam. There is also an overhead utility running along side of the bridge.

**VEGETATION:**
The vegetation in the area is open with some wooded areas and patches of brush. The impact to vegetation in the area will be limited to that which is effected by construction of the new abutments. After the project is completed the slopes will be stabilized with stone fill and vegetation will be reestablished with standard seed & mulch practices.

**SOILS:**
All soil data came from the U.S. Department of Agriculture Soil Conservation of Addison County. There are two types of soils found at the project site. On the northeast corner and the south end of the project site the soil is classified as Vergennes Clay with slopes of 12-25% and a K-value of 0.49. In the northwest part of the project area the soil is classified as Farmington soil. This is an extremely rocky silty loam with slopes ranging from 20-50% and a K-value of 0.32.

Note: Generally, K-values indicate the following: 0.0 - 0.23 = low erodibility; 0.24 - 0.36 = moderate erodibility; 0.37 and higher = higher erodibility.

**SENSITIVE RESOURCE AREAS:**
No 'Threatened & Endangered Species' have been identified within the project limits and there will be no adverse effect to Historic or Archeological features. However; Otter Creek, the dam, and two archeologically sensitive sites area all located in the general project area.

**PROXIMITY TO NATURAL OR MAN-MADE WATER FEATURES:**
Disturbance of soils near natural or made-made waterways consists of that which is necessary to the removal and replacement of the abutments and minor work to the roadway approaches. Stabilization of disturbance to the stream banks will be accomplished with Stone Fill, Type III.

## TEMPORARY EROSION PREVENTION & SEDIMENT CONTROL

**Temporary erosion prevention measures to be utilized include:**

"Project Demarcation Fencing," denoted -PDF- on the plans, to delineate the limits the contractor can access with construction equipment. This measure limits the area that can be disturbed and exposed to erosion.

Seeding, mulching, and biodegradable erosion control matting or an equivalent product shall be utilized on all slopes greater than 1:3 that are not lined with stone fill. These slopes shall be stabilized within 48 hours of reaching final grade or during intermittent phases of construction activity.

Tracking of all exposed slopes, combined with temporary mulching, will also be utilized on a regular basis. Any slopes to be exposed for several days prior to final grading shall be tracked and mulched. The forecast of rainfall events shall also trigger protection of exposed slopes.

**Temporary measures to control sediment transport include:**

Silt fence will be installed a distance of 5'-10' from the toe of slopes to prevent sediment transport to down gradient areas.
Each line of silt fence will be placed along the contour with ends turned slightly uphill to create a ponding effect should water try to run along the fencing and around the ends. The maximum slope length between separate runs of silt fence is 100'. Silt fence shall be installed prior to any upslope earthwork.

Measures such as temporary stone check dams, silt fence, and sand bags shall be checked regularly for accumulation of sediment. Sediment build-up shall be removed when the level of sediment reaches one-half the height of the control measure. Sediments shall be disposed of in an approved area such that they will not be subject to erosion.

Temporary sediment settling basins may or may not be utilized on this project. If a sediment settling basin is to be used for dewatering a cofferdam, it should be sized based upon the following criteria:
(See Sediment Settling Basin Sizing Criteria.)

## PERMANENT EROSION CONTROL MEASURES

**Several permanent erosion control measures will be utilized:**

Stone lining of the stream banks with Stone Fill, Type III as specified by VTrans Hydraulics personnel is specified. This stone will protect from stream bank erosion during design storm events.

Stone Fill, Type I will be utilized at culvert outlets to dissipate water velocities and reduce erosion potential.

Grass or other suitable ground cover will be established outside of the roadway limits where stone lining has not been specified. Slopes greater then 1 on 3 shall be seeded and mulched promptly upon achieving final grade.

## GENERAL EROSION & SEDIMENT CONTROL GUIDELINES

The Erosion Control Plans are meant as a guideline for preventing erosion and controlling sediment transport. The work outlined in this narrative consists of applying measures throughout the life of the project to control erosion and minimize the sedimentation of receiving waters. The measures include stabilization and structural practices, storm water controls and other pollution prevention controls.

Coordinate the installation, use, and removal of erosion and sediment control measures with construction activities to ensure economical, effective and continuous erosion and sediment control. Employ temporary stabilization practices in incremental stages as construction proceeds. The contractor will use additional erosion control measures as necessitated by the sequence of construction and as directed by the Engineer. See section 105.23 of the Vermont AOT Standard Specifications for Construction, dated 2006.

Install all erosion and sediment control measures as shown in the Erosion Control Plan or as directed by the Engineer. Do not modify the type, size or location of any control or practice without approval of the Engineer. Any changes shall be noted on the plans, in the weekly inspection report, and reported to the appropriate authority in a timely manner. Inspect all control measures weekly and after each rainfall event. Repair measures shall be taken as needed.

Preventing initial soil erosion is much more effective than treating eroded sediment. Therefore, stabilize all disturbed areas promptly after construction activity has temporarily or permanently ceased. Temporary vegetation shall be established if the area is to be without construction activity for a period of 14 days. Perimeter control measures shall be installed following clearing, but prior to the start of any grubbing or grading activity, install other temporary controls in incremental stages as construction proceeds.

Maintaining vegetated buffers along stream banks, wetlands or other sensitive areas is a crucial erosion and sediment control measure that should be established wherever possible.

Control only sediment-laden runoff generated by the project site. Collect and route clean offsite runoff around or through the project site using diversion berms, diversion channels, culverts and/or temporary pipes.

Do not allow construction equipment to operate on the down slope side of perimeter control measures.

## SEDIMENT SETTLING BASIN SIZING CRITERIA

| PUMP FLOW RATE | | REQUIRED SURFACE AREA | | LENGTH / WIDTH = 2:1 | | | |
|---|---|---|---|---|---|---|---|
| Q(gpm) | Q(m^3/s) | (ft^2) | (m^2) | L (ft) | W (ft) | L (m) | W (m) |
| 50 | 0.0032 | 595 | 55 | 35.0 | 17.0 | 10.6 | 5.3 |
| 100 | 0.0063 | 1200 | 111 | 49.0 | 24.5 | 15.0 | 7.5 |
| 150 | 0.0095 | 1776 | 165 | 59.6 | 29.8 | 18.2 | 9.1 |
| 200 | 0.0126 | 2368 | 220 | 68.8 | 34.4 | 21.0 | 10.5 |
| 250 | 0.0158 | 2970 | 276 | 77.0 | 38.5 | 23.4 | 11.7 |
| 300 | 0.0189 | 3560 | 330 | 84.4 | 42.2 | 25.8 | 12.9 |
| 350 | 0.0221 | 4155 | 386 | 91.2 | 45.6 | 27.8 | 13.9 |

| | | | |
|---|---|---|---|
| PROJECT NAME: | New Haven-Weybridge | | |
| PROJECT NUMBER: | 89j081 | | |
| FILE NAME: | 89j081/Str/s89j081ecnotes.dgn | PLOT DATE: | 1/23/2007 |
| PROJECT LEADER: | C.P. WILLIAMS | DRAWN BY: | H.I. SALLS |
| DESIGNED BY: | H.I. SALLS | CHECKED BY: | R.S. YOUNG |
| EROSION NARRATIVE | | SHEET | 46 OF 53 |

## EROSION AND SEDIMENT CONTROL NOTES:

1) THE AREA OF DISTURBANCE IS 0.171 ACRES.

2) AN UPGRADED TEMPORARY EROSION PREVENTION AND SEDIMENT CONTROL PLAN SHALL BE SUBMITTED BY THE CONTRACTOR FOR APPROVAL BY THE AGENCY OF TRANSPORTATION.

3) ANY CHANGES MADE TO THE EROSION PREVENTION AND SEDIMENT CONTROL PLAN DURING CONSTRUCTION SHALL BE APPROVED BY THE RESIDENT ENGINEER AND DOCUMENTED.

4) TIME ALL GRADING TO MINIMIZE SOIL EXPOSURE.

5) RETAIN EXISTING VEGETATION WHENEVER FEASIBLE.

6) AT THE END OF EACH DAY'S GRADING OPERATIONS, SHAPE EARTHWORK TO MINIMIZE THE EROSION FROM STORM RUNOFF.

7) TEMPORARILY MULCH AND SURFACE ROUGHEN ALL DISTURBED AREAS WHICH WILL NOT RECEIVE FURTHER DISTURBANCE FOR A PERIOD OF 7 DAYS OR MORE.

8) TEMPORARILY SEED AND MULCH ALL DISTURBED AREAS WHICH WILL NOT RECEIVE FURTHER DISTURBANCE FOR A PERIOD OF 30 DAYS OR MORE.

9) FINAL SEED AND COVER SHALL BE APPLIED WITHIN 48 HOURS OF FINAL GRADING.

10) ALL AREAS DISTURBED DURING CONSTRUCTION SHALL BE RETURNED TO THEIR ORIGINAL CONDITION INCLUDING SEEDING AND MULCHING.

11) KEEP RUNOFF VELOCITIES LOW. CONSTRUCT CHECK DAMS AS REQUIRED.

12) PREPARE TEMPORARY DRAINAGE WAYS TO HANDLE CONCENTRATED FLOW UNTIL PERMANENT DRAINAGE IS CONSTRUCTED AND STABILIZED.

13) ALL DISTURBED AREAS WITH SLOPES GREATER THAN 1:3 WILL REQUIRE EROSION MATTING (SEE EROSION AND SEDIMENT CONTROL DETAIL SHEET 52).

14) SPECIAL CONSIDERATION MUST BE GIVEN TO THE FIRST PUMP-DOWN OF THE COFFERDAMS. THIS WILL CONTAIN THE GREATEST VOLUME OF WATER WITH A HIGH SEDIMENT LOAD. THE CONTRACTOR MAY PROVIDE ADDITIONAL SEDIMENT TRAPS WITHIN THE RIGHT-OF-WAY IF REQUIRED OR CONTROL THE RATE OF DRAW-DOWN. ADDITIONAL SEDIMENT TRAPS MUST BE APPROVED BY THE RESIDENT ENGINEER.

15) CLEAN SEDIMENT CONTROL MEASURES (SEDIMENT TRAPS, SILT FENCE, ETC.) WHEN HALF FULL OF SEDIMENT.

16) AFTER COMPLETION OF THE SUBSTRUCTURE, THE SEDIMENT IN THE TRAPS SHALL BE REMOVED AND THE GROUND RESTORED TO ITS ORIGINAL SLOPES OR GRADED AS SHOWN ON THE CONSTRUCTION DRAWINGS.

17) THE CONTRACTOR WILL USE OTHER TEMPORARY OR PERMANENT EROSION CONTROL MEASURES AS NECESSITATED BY THE SEQUENCE OF CONSTRUCTION AND AS DIRECTED BY THE RESIDENT ENGINEER. SEE SECTION 105.23 OF THE VERMONT AGENCY OF TRANSPORTATION STANDARD SPECIFICATIONS FOR CONSTRUCTION DATED 2006.

18) MONITOR AND MAINTAIN ALL EROSION AND SEDIMENT CONTROL MEASURES DAILY AND AFTER EACH RAIN STORM.

19) SEE SHEETS 48 - 53 FOR EROSION AND SEDIMENT CONTROL DETAILS.

20) ASK FOR ASSISTANCE AND RECOMMENDATIONS AS NEEDED.

## GENERAL NOTES:

1) PRIOR TO CONSTRUCTION, THE CONTRACTOR SHALL PROVIDE THE FOLLOWING ADDITIONAL INFORMATION FOR APPROVAL AND INCLUSION IN THE COMPLETE EROSION AND SEDIMENT CONTROL PLANS:

   - LOCATION OF WASTE, BORROW AND STAGING AREAS, MATERIAL STOCKPILES, REFUELING AND MAINTENANCE AREAS AND CONCRETE TRUCK WASHOUT LOCATION (ATTACH MAP IF NECESSARY). A DISCUSSION AND ADDITIONAL DETAILS NEEDED FOR PROTECTION AND STABILIZATION OF THESE AREAS SHALL BE INCLUDED AS WELL.
   - MODIFICATIONS REQUIRED TO THESE EROSION AND SEDIMENT CONTROL PLANS.
   - GRADING PLAN / CONSTRUCTION SEQUENCE (INCLUDING PROPOSED DATES ASSOCIATED WITH JOB MILESTONES AS INDICATED ON THE SEQUENCE CONSISTENT WITH PROJECT CRITICAL PATH METHOD SCHEDULE.)
   - REVISED NARRATIVE MATCHING THE GRADING PLAN AND CONSTRUCTION SEQUENCE (RE: TEMPORARY SEEDING AND MULCHING / STABILIZATION).
   - NAME, ADDRESS, PHONE NUMBER AND BASIC QUALIFICATIONS OF "ON-SITE COORDINATOR".

2) WORK SHALL BE GENERALLY CONSISTENT WITH GUIDANCE PROVIDED IN THE LATEST REVISION OF THE VERMONT HANDBOOK FOR SOIL EROSION AND SEDIMENT CONTROL ON CONSTRUCTION SITES AND THE ASSOCIATED GENERAL CONTRACTORS OF VERMONT FIELD HANDBOOK.

## PERIMETER CONTROL NOTES:

1) IDENTIFY SENSITIVE AREAS AND AREAS PRONE TO EROSION BASED ON SITE EVALUATION.

2) CLEARLY DEMARCATE SENSITIVE AREAS TO AVOID DISTURBANCE USING BRIGHTLY COLORED SNOW FENCE, MIN 8" WIDE FLAGGING OR SIMILAR.

3) PROTECT ALL SENSITIVE AREAS AND WATER FEATURES FROM SEDIMENT.

4) DIVERT OR OTHERWISE KEEP ALL CONCENTRATED OFF-SITE "RUN-ON" FROM AREAS TO BE DISTURBED.

5) PERIMETER CONTROLS (SILT FENCE, FILTER CURTAIN, ETC.) TO BE INSTALLED PRIOR TO SOIL DISTURBANCE AND MAINTAINED UNTIL SITE IS PERMANENTLY STABILIZED TO THE SATISFACTION OF THE ENGINEER AND ON-SITE COORDINATOR.

6) SEED AND MULCH SHALL BE APPLIED IMMEDIATELY TO ALL LAWNS DISTURBED BEYOND THE WORK AREA DELINEATED ON THESE PLANS.

7) PREVENT SEDIMENT FROM LEAVING THE SITE BY MAINTAINING AND MODIFYING PERIMETER CONTROLS AS NEEDED.

## SEEDING FORMULA
## RURAL AREAS

| % WT. | LBS./A. | NAME | PUR % | GERM % |
|---|---|---|---|---|
| 37.5 | 22.5 | CREEPING RED FESCUE | 98 | 85 |
| 37.5 | 22.5 | TALL FESCUE | 95 | 90 |
| 5.0 | 3.0 | RED TOP | 95 | 90 |
| 15.0 | 9.0 | BIRDSFOOT TREFOIL | 98 | 85 |
| 5.0 | 3.0 | ANNUAL RYEGRASS | 95 | 85 |
| 100.0 | 60.0 | | | |

### GENERAL NOTES

SEED MIXTURE: SHALL NOT HAVE A WEED CONTENT EXCEEDING 0.40% BY WEIGHT AND SHALL BE FREE OF ALL NOXIOUS SEED.

SEED: TO BE APPLIED PER SEEDING FORMULAS OR AS DIRECTED BY THE ENGINEER.

FERTILIZER: FORMULA 10-20-10, TO BE USED WITH SEED, APPLIED AT THE RATE OF 500 LBS./ACRE. (HYDRO SEEDERS MAY USE 19-19-19 FORMULA).


AGRICULTURAL LIMESTONE: TO BE APPLIED AT THE RATE OF 2 TONS/ACRE, OR AS DIRECTED BY THE ENGINEER.

HAY MULCH: TO BE PLACED ON EARTH SLOPES AT THE RATE OF 2 TONS/ACRE, OR AS DIRECTED BY THE ENGINEER.

TOPSOIL: TO BE USED WITH SEED AS INDICATED ON THE PLANS, OR AS DIRECTED BY THE ENGINEER.

DATUM
VERTICAL NGVD 1929
HORIZONTAL ASSUMED

PROJECT: NEW HAVEN-WEYBRIDGE
PROJECT NO.: BHO-BTN2005(1)
DESIGN FILE NAME: pw89j081/s89j081ecnotes.dgn
IPARM FILE NAME: sj081ecnotes.i
PLOT DATE: 28-FEB-2007
SURVEYED BY: R. MOREAU
SURVEY DATE: 7/90
SQUAD LEADER: C.P. WILLIAMS
DRAWN BY: J. WHITE
EROSION CONTROL NOTE SHEET
SHEET: 47 OF 53

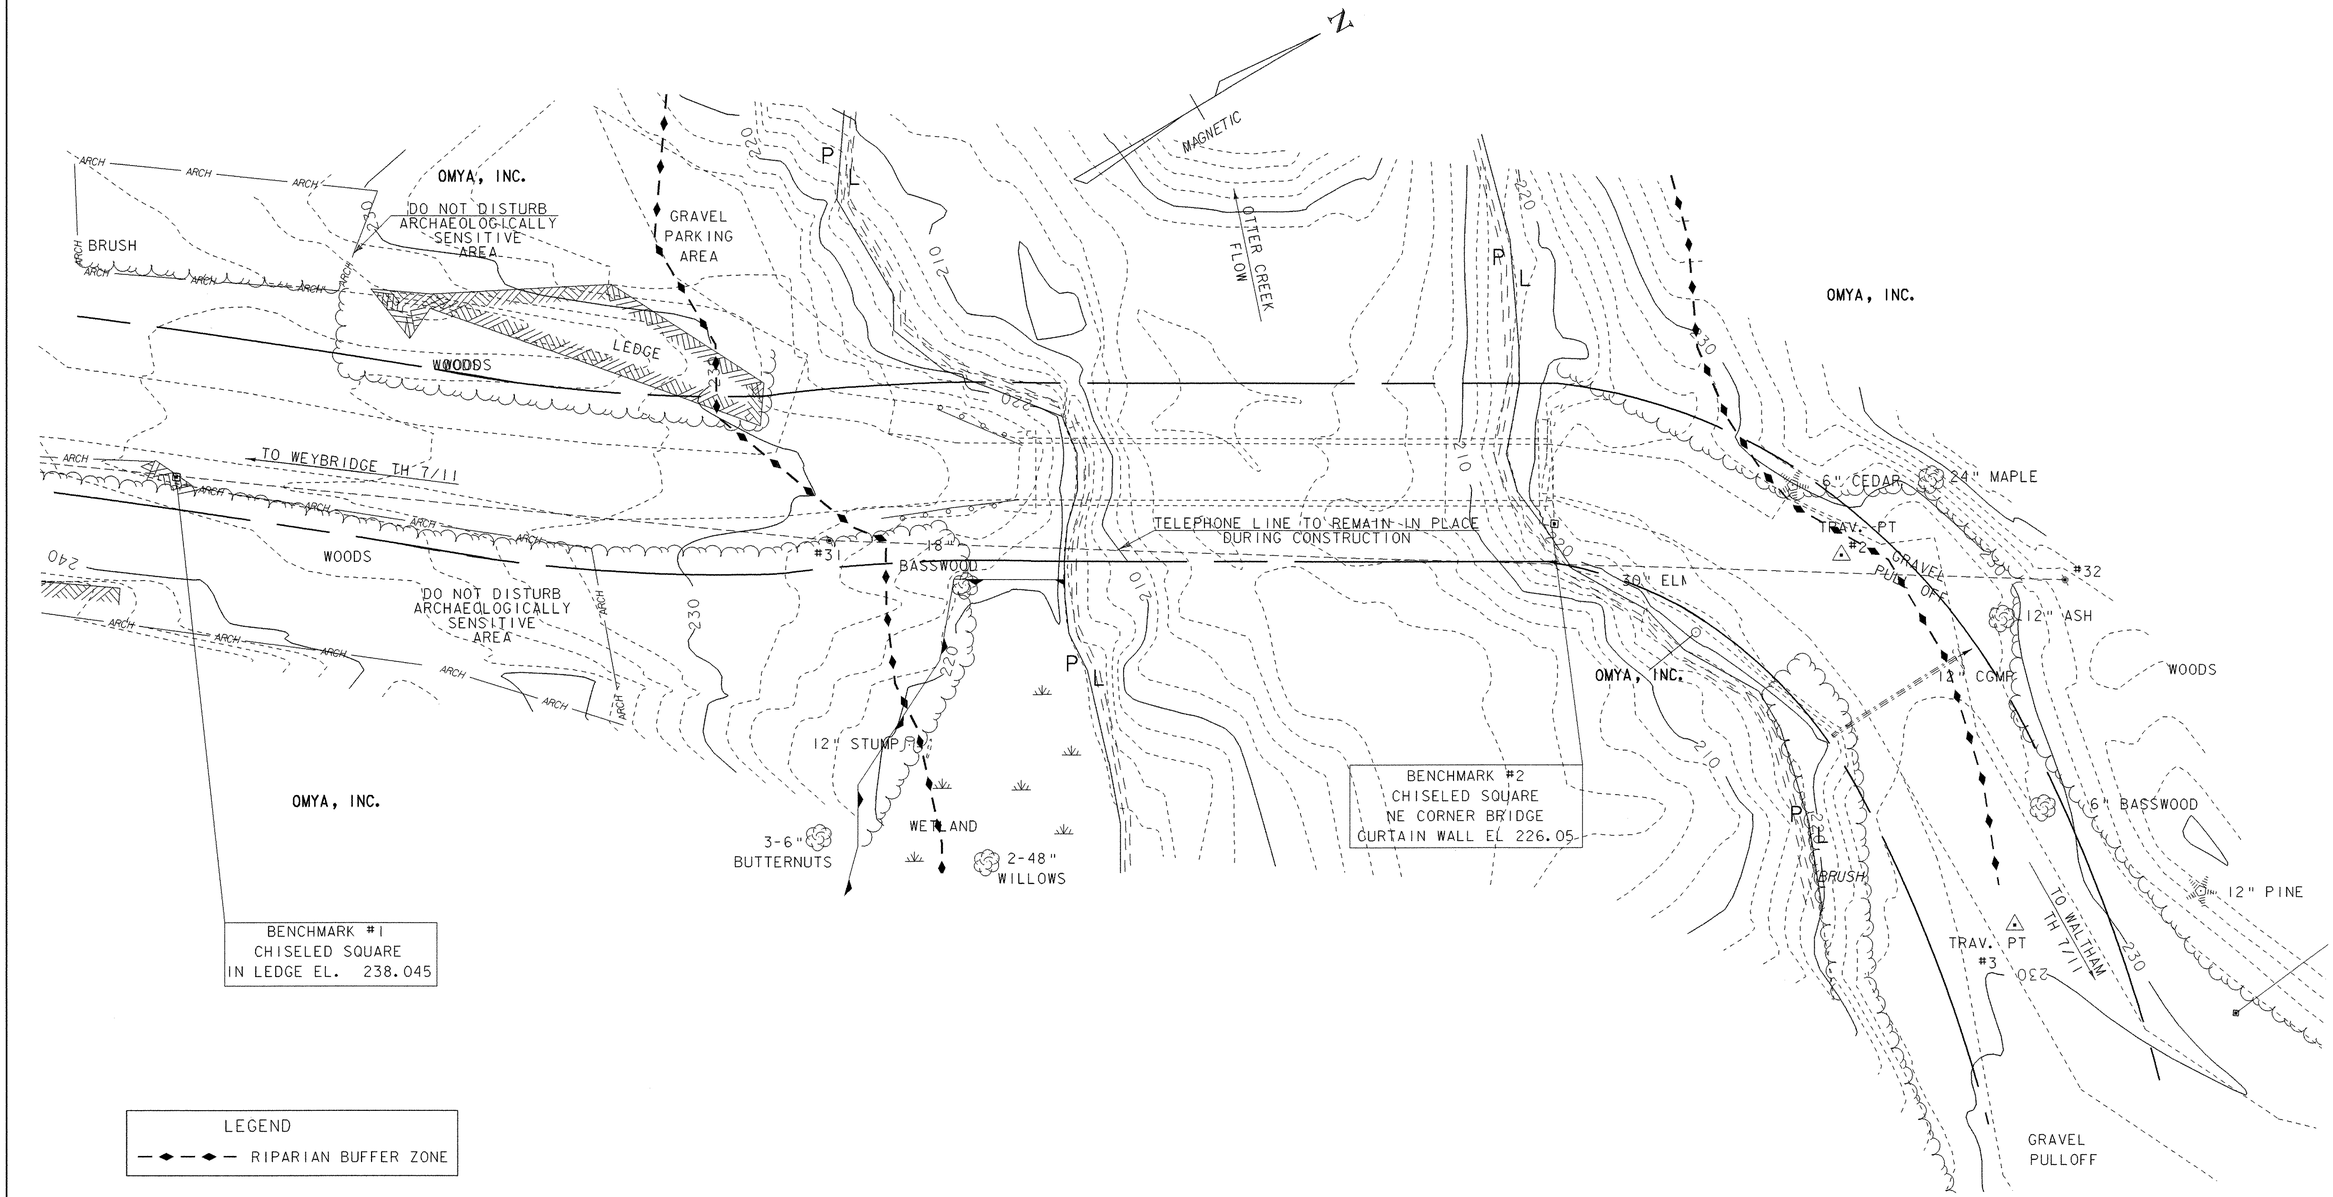


# EXISTING CONDITIONS

SCALE 1" = 20'-0
20 0 20

**DATUM**
VERTICAL NGVD 1929
HORIZONTAL ASSUMED

| | |
|---|---|
| PROJECT: NEW HAVEN-WEYBRIDGE | PROJECT NO.: BHO-BTN 2005(I) |
| DESIGN FILE NAME: /usr/str4/89j081/sj081bdr.dgn | |
| IPARM FILE NAME: sj081excond.i | PLOT DATE: 28-FEB-2007 |
| SURVEYED BY: R. MOREAU | SURVEY DATE: 7/90 |
| SQUAD LEADER: C.P. WILLIAMS | DRAWN BY: M.FESSEL |
| EXISTING CONDITIONS | SHEET: 48 OF 53 |

SOIL CLASSIFICATION

SOIL TYPE - FARMINGTON EXTREMELY ROCKY SILT LOAM
SLOPES - 20-50 %
"K FACTOR" 0.32
CLASSIFIED - HIGHLY ERODIBLE

SOIL CLASSIFICATION

SOIL TYPE - VERGENNES CLAY
SLOPES - 12-25 %
"K FACTOR" 0.49
CLASSIFIED - HIGHLY ERODIBLE

SOIL CLASSIFICATION

SOIL TYPE - VERGENNES CLAY
SLOPES - 12-25 %
"K FACTOR" 0.49
CLASSIFIED - HIGHLY ERODIBLE

BENCHMARK #1
CHISELED SQUARE
IN LEDGE EL. 238.045

IF NECESSARY - APPROXIMATE LOCATION TO CONSTRUCT SEDIMENT BASIN TO TRAP SEDIMENT PUMPED FROM STRUCTURE EXCAVATION.

BENCHMARK #2
CHISELED SQUARE
NE CORNER BRIDGE
CURTAIN WALL EL 226.05

SEE CROSS SECTIONS FOR PROPOSED CONTOURS.

NOTES:

1. THESE PLANS SHOW A CONCEPTUAL EROSION CONTROL PLAN, THE CONTRACTOR MUST SUBMIT A TEMPORARY EROSION CONTROL PLAN FOR APPROVAL.
2. TEMPORARY EROSION CONTROL MEASURES ARE CONCEPTUALLY SHOWN. THE CONTRACTOR MAY RELOCATE TEMPORARY MEASURES TO IMPROVE EROSION CONTROL WITH APPROVAL OF THE RESIDENT ENGINEER AND ON SITE COORDINATOR. SILT FENCE SHALL NOT BE INSTALLED ACROSS CONTOURS.
3. THE CONTRACTOR SHALL USE OTHER TEMPORARY EROSION CONTROL MEASURES AS NECESSITATED BY THE SEQUENCE OF CONSTRUCTION OR AS DIRECTED BY THE RESIDENT ENGINEER AND ON SITE COORDINATOR.
4. REFER TO TEMPORARY EROSION CONTROL DETAIL SHEETS FOR ADDITIONAL DETAILS.

LEGEND

- BARRIER FENCE
- FILTER CURTAIN
- SILT FENCE
- PDF PROJECT DEMARCATION FENCE
- RIPARIAN BUFFER ZONE
- EROSION MATTING
- SEED AND STRAW MULCH


DATUM
VERTICAL NGVD 1929
HORIZONTAL ASSUMED

# EROSION PREVENTION AND SEDIMENT CONTROL PLAN

20 0 20
SCALE 1" = 20'-0

| PROJECT: | PROJECT NO.: |
|---|---|
| NEW HAVEN-WEYBRIDGE | BHO-BTN 2005(I) |

DESIGN FILE NAME: /usr/str4/89j081/sj081bdr.dgn
IPARM FILE NAME: sj081leropian.i
PLOT DATE: 28-FEB-2007
SURVEYED BY: R. MOREAU
SURVEY DATE: 7/90
SQUAD LEADER: C.P. WILLIAMS
DRAWN BY: M.FESSEL
EROSION PREVENTION AND SEDIMENT CONTROL PLANS SHEET: 49 OF 53

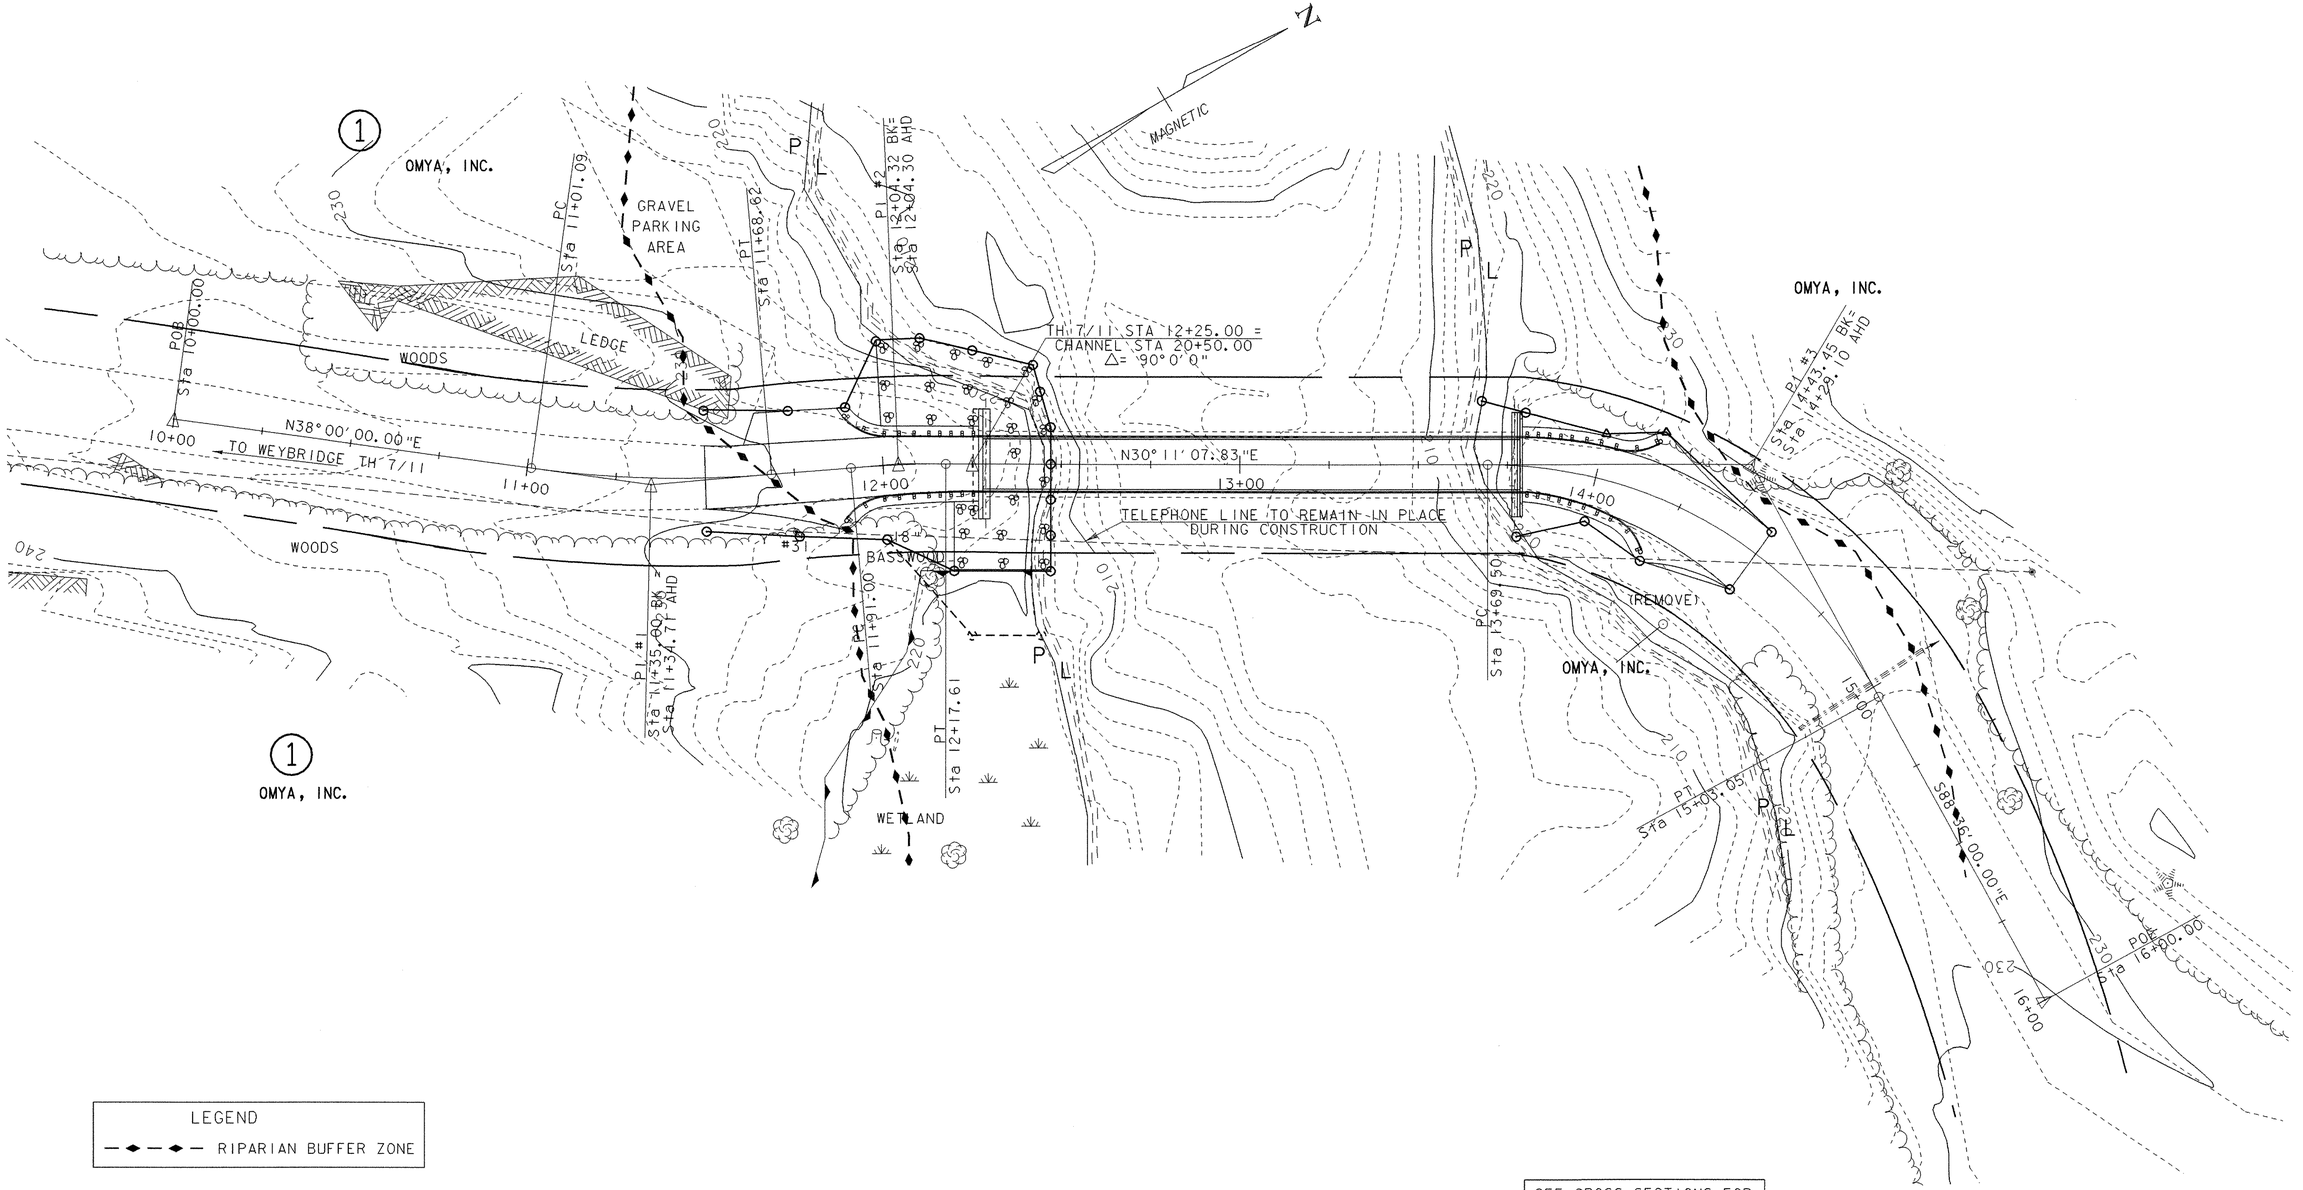


LEGEND

— ◆ — ◆ — RIPARIAN BUFFER ZONE

SEE CROSS SECTIONS FOR PROPOSED CONTOURS.

# FINAL CONDITIONS

SCALE 1" = 20'-0

20 0 20


**DATUM**

VERTICAL NGVD 1929


HORIZONTAL ASSUMED

| | | | |
|---|---|---|---|
| PROJECT: NEW HAVEN-WEYBRIDGE | | PROJECT NO.: BHO-BTN 2005(1) | |
| DESIGN FILE NAME: | /usr/str4/89j08l/sj08lbdr.dgn | | |
| IPARM FILE NAME: | sj08lfincond.i | PLOT DATE: | 28-FEB-2007 |
| SURVEYED BY: | R. MOREAU | SURVEY DATE: | 7/90 |
| SQUAD LEADER: | C.P. WILLIAMS | DRAWN BY: | H.I. SALLS |
| FINAL CONDITIONS | | SHEET: | 50 OF 53 |

# SILT FENCE

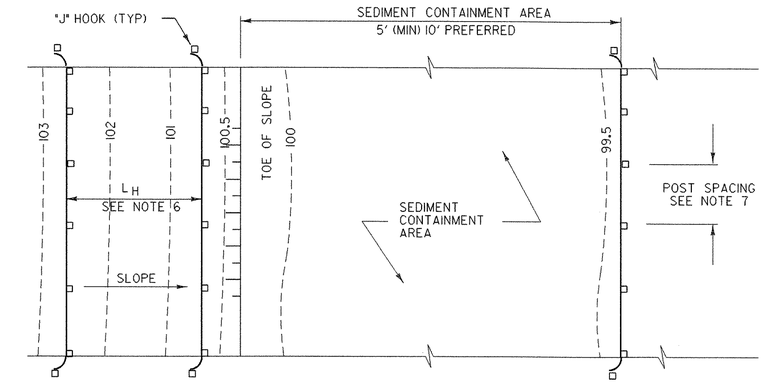


PLAN

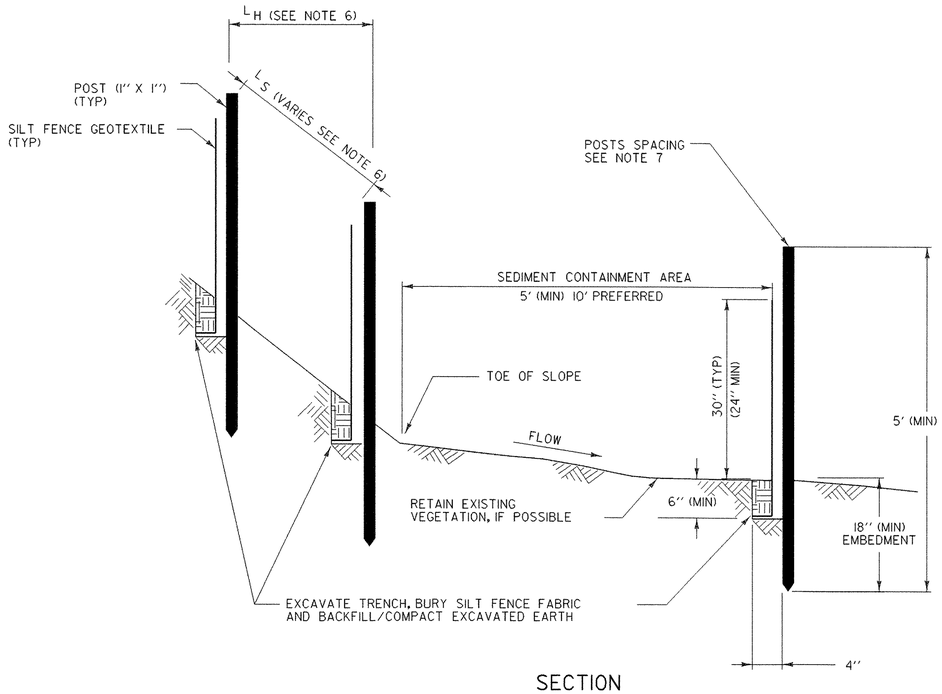


SECTION
SILT FENCE - TEMPORARY
NOT TO SCALE

## APPLICATION NOTES:

A. THE PRIMARY PURPOSE OF SILT FENCE IS TO REDUCE RUNOFF VELOCITY AND TRAP SEDIMENT. VELOCITY IS REDUCED, WATER IS IMPOUNDED BEHIND THE MEASURE, AND SEDIMENT FALLS OUT OF SUSPENSION.


B. SILT FENCE SHALL NOT BE USED ACROSS CONCENTRATED FLOW.

## GENERAL NOTES:

1. SILT FENCE SHALL GENERALLY BE PLACED A MINIMUM OF 5 FEET BEYOND TOE OF SLOPE, 10 FEET PREFERRED, TO PROVIDE ADEQUATE AREA FOR SEDIMENT STORAGE AND FACILITATE MAINTENANCE OF SEDIMENT CONTAINMENT AREA.
2. SILT FENCE SHALL BE INSTALLED ON A LINE OF EQUAL ELEVATION (CONTOUR). IT MAY BE INSTALLED AT INTERMEDIATE POINTS UP SLOPES AS WELL AS AT THE BOTTOM, AS SHOWN IN THE DETAIL.
3. ALL ENDS SHALL BE "J" HOOKED TO TRAP SEDIMENT.
4. IN AREAS WITH TWO SLOPES, SILT FENCE SHALL BE USED TO ERECT A DAM AND TRAP SEDIMENT AT THE BASE OF THE STEEPER SLOPE.
5. THE BOTTOM EDGE OF SILT FENCE SHALL BE BURIED A MINIMUM OF 6 INCHES BELOW GROUND, AND KEYED IN 4 INCHES. THE FENCE SHALL BE INSTALLED WITH THE POSTS ON THE DOWNSTREAM SIDE OF THE FABRIC.
6. MAXIMUM DRAINAGE AREA TRIBUTARY TO 100 FEET OF SILT FENCE SHALL BE 0.25 ACRES.
7. THE FOLLOWING ARE MAXIMUM LENGTHS FOR SILT FENCE INSTALATIONS:

| CONSTRUCTED SLOPE | SLOPE LENGTH (LS) FT | HORIZONTAL LENGTH (LH) FT |
|---|---|---|
| 3H : 1V | 80 | 75 |
| 4H : 1V | 130 | 125 |
| 5H : 1V | 200 | 200 |
| > 5H : 1V | 250 | 250 |

8. WHERE ELONGATION IS >50%, POST SPACING SHALL NOT EXCERED 4 FEET. WHERE ELONGATION IS <50%, POST SPACING SHALL NOT EXCEED 6 FEET.
9. SILT FENCE SHALL BE INSPECTED EVERY SEVEN (7) CALENDAR DAYS AND WITHIN 24 HOURS OF A STORM EVENT GREAT ENOUGH TO CAUSE WATER TO LEAVE THE CONSTRUCTION SITE.
10. SILT FENCE SHALL BE CLEANED AND REPAIRED AS NEEDED. SEDIMENT SHALL BE REMOVED WHEN ACCUMULATION REACHES ONE-HALF OF THE MEASURE HEIGHT. SEDIMENT SHALL BE DISPOSED OF AT AN APPROVED WASTE SITE.
11. SILT FENCE SHALL BE REMOVED WHEN THE AREA HAS BEEN STABILIZED. AT TIME OF REMOVAL OF THE SILT FENCE, THE DISTURBED AREA SHALL BE REPAIRED AND STABILIZED.

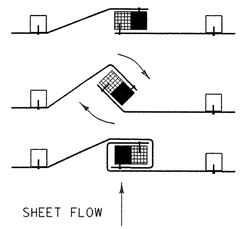



1. PLACE THE END POST OF ONE FENCE INSIDE THE END POST OF THE OTHER FENCE.
2. ROTATE BOTH POSTS AT LEAST 180 DEGREES IN A CLOCKWISE DIRECTION TO CREATE A TIGHT SEAL WITH THE FABRIC MATERIAL
3. DRIVE BOTH POSTS 18 INCHES INTO THE GROUND AND BURY THE FLAP IN THE TRENCH.

SPLICING DETAIL
NOT TO SCALE

# EROSION PREVENTION & SEDIMENT CONTROL DETAILS
# SILT FENCE

| | |
|---|---|
| PROJECT: NEW-HAVEN WEYBRIDGE | PROJECT NO.: BHO BTN2005 (1) |
| DESIGN FILE NAME: 89j081\structures\sJ081erodet.dgn | |
| IPARM FILE NAME: sj081epscl.i | PLOT DATE: 28-FEB-2007 |
| DESIGNED BY: CONST. ENV. SECTION | DRAWN BY: CONST. ENV. SECTION |
| SQUAD LEADER: C.P. WILLIAMS | CHECKED BY: A. CABRAL |
| SILT FENCE | SHEET: 51 OF 53 |

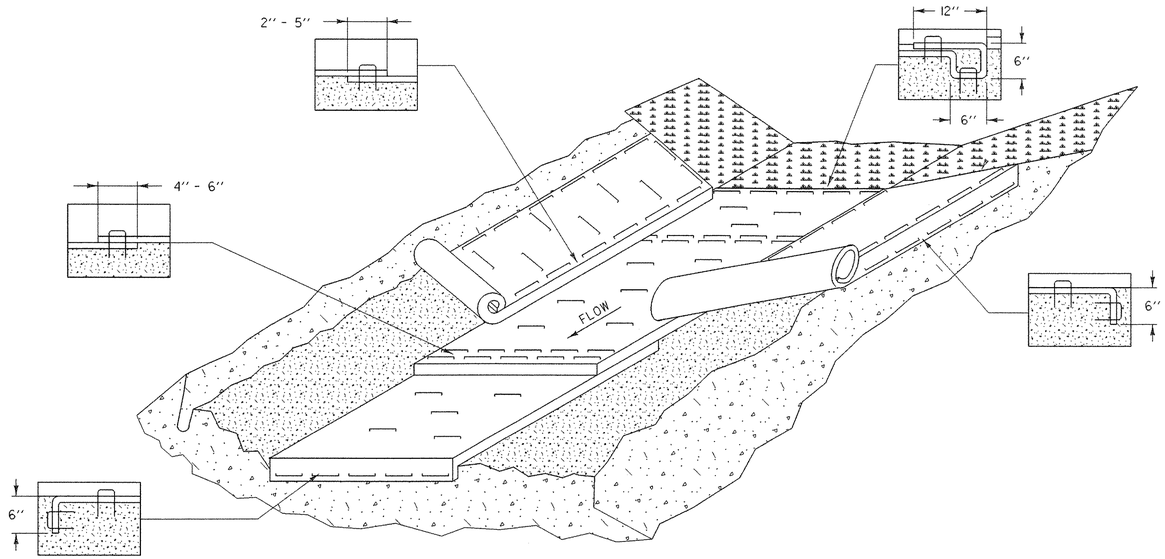


## EROSION MATTING FOR DITCHES


### APPLICATION NOTES:

A. THE PURPOSE OF LINING THE DITCH WITH EROSION MATTING IS TO REDUCE EROSION AND AID THE ESTABLISHMENT OF VEGETATION AT LOW VELOCITIES.

B. TYPE OF EROSION MATTING TO BE USED SHOULD BE BASED ON FACTORS SPECIFIC TO EACH APPLICATION. SEE SPECIFICATIONS AND PRODUCT RECOMMENDATIONS FOR SUITABILITY.

### GENERAL NOTES:

1. WATER MAY NEED TO BE DIVERTED TO ALLOW PROPER MATTING INSTALLATION.
2. GRADE AND SMOOTH CHANNEL TO PROVIDE GOOD MATTING TO SOIL SURFACE CONTACT.
3. APPLY FERTILIZER, LIME, AND SEED PRIOR TO PLACING MATTING.
4. INSTALL MATTING IN THE CENTER OF THE CHANNEL, IN THE DIRECTION OF THE WATER FLOW.
5. INSTALL MATTING ON THE SIDE SLOPES OF THE CHANNEL, OVERLAPPING THE CENTER MAT.
6. ANCHOR MATTING AS SHOWN, UTILIZING ANCHOR STAPLES. STAPLE PLACEMENT SHALL BE DETERMINED BY THE MANUFACTURER'S INTALLATION INSTRUCTIONS.
7. EROSION MATTING SHALL BE INSPECTED EVERY SEVEN (7) CALENDAR DAYS AND WITHIN 24 HOURS OF A STORM EVENT GREAT ENOUGH TO CAUSE WATER TO LEAVE THE CONSTRUCTION SITE.
8. EROSION MATTING SHALL BE REPAIRED AND RESTAPLED AS NECESSARY TO ENSURE PROPER FUNCTION.

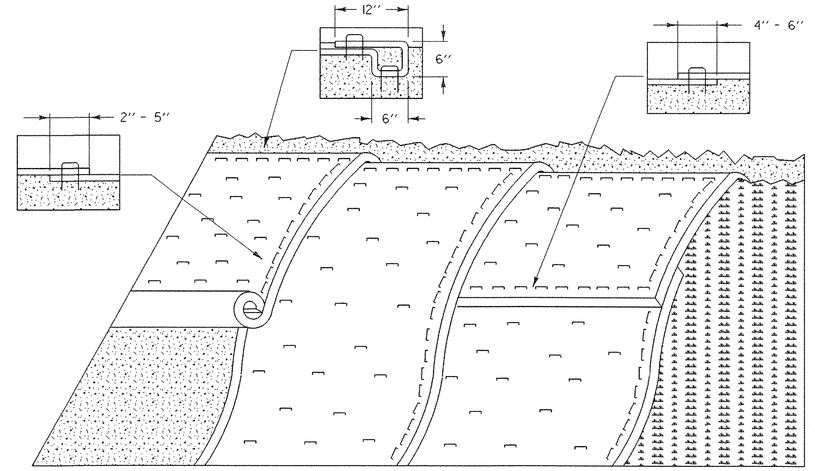


## EROSION MATTING FOR SLOPES

### APPLICATION NOTES:

A. THE PURPOSE OF EROSION MATTING ON SLOPES IS TO REDUCE EROSION AND AID THE ESTABLISHMENT OF VEGETATION

B. EROSION CONTROL MATTING SHALL BE USED FOR THE FOLLOWING REASONS:

- SLOPES > 3H:1V
- AREAS WHERE SEED AND MULCH WILL NOT STAY IN PLACE ALONE
- WHERE SEEDING IS OUTSIDE THE GROWING SEASON.


### GENERAL NOTES:

1. GRADE AND SMOOTH THE SLOPE TO PROVIDE GOOD MATTING TO SOIL SURFACE CONTACT.
2. APPLY FERTILIZER, LIME, AND SEED PRIOR TO PLACING MATTING.
3. ANCHOR MATTING AS SHOWN, UTILIZING ANCHOR STAPLES. STAPLE PLACEMENT SHALL BE DETERMINED BY THE MANUFACTURER'S INTALLATION INSTRUCTIONS.
4. UNROLL EROSION MATTING VERTICALLY DOWN SLOPE IN THE DIRECTION OF WATER FLOW.
5. OVERLAP UPPER MATTING OVER LOWER MATTING AS SHOWN.
6. OVERLAP ADJACENT MATTING AS SHOWN.
7. CUT EXCESS MATTING AT END OF SLOPE AND ANCHOR THE END.
8. EROSION MATTING SHALL BE INSPECTED EVERY SEVEN (7) CALENDAR DAYS AND WITHIN 24 HOURS OF A STORM EVENT GREAT ENOUGH TO CAUSE WATER TO LEAVE THE CONSTRUCTION SITE.
9. EROSION MATTING SHALL BE REPAIRED AND RESTAPLED AS NECESSARY TO ENSURE PROPER FUNCTION.

# EROSION PREVENTION & SEDIMENT CONTROL DETAILS


## EROSION MATTING FOR DITCHES & SLOPES

| | |
|---|---|
| PROJECT: NEW-HAVEN WEYBRIDGE | PROJECT NO.: BHO BTN2005(1) |
| DESIGN FILE NAME: 89j081\structures\sJ081erodet.dgn | |
| IPARM FILE NAME: sj081epsc5.i | PLOT DATE: 28-FEB-2007 |
| DESIGNED BY: CONST. ENV. SECTION | DRAWN BY: CONST. ENV. SECTION |
| SQUAD LEADER: C.P. WILLIAMS | CHECKED BY: A. CABRAL |
| EROSION MATTING FOR DITCHES & SLOPES | SHEET: 52 OF 53 |

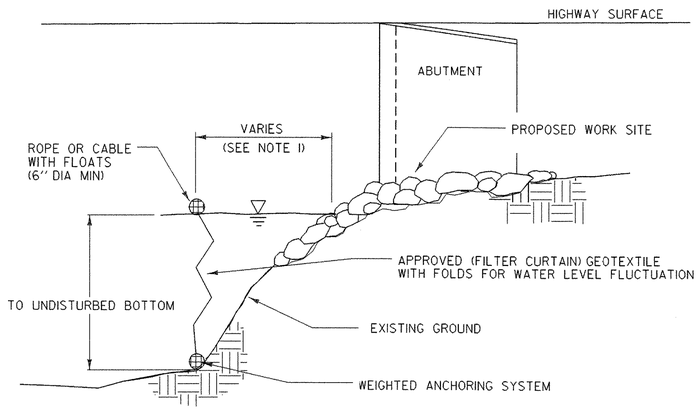


SECTION A-A

NOT TO SCALE

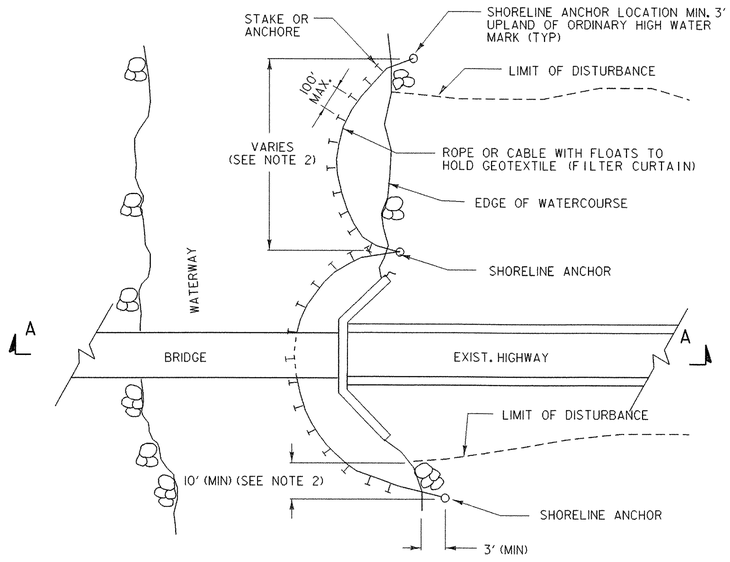


PLAN

FILTER CURTAIN

NOT TO SCALE

# FILTER CURTAIN

## APPLICATION NOTES:

A. THE PRIMARY PURPOSE OF A FILTER CURTAIN IS TO PROVIDE SEDIMENTATION PROTECTION FOR A WATERCOURSE FROM UP-SLOPE LAND DISTURBANCE OR FROM DREDGING OR FILLING WITHIN WATERCOURSE.

B. FILTER CURTAINS SHALL NOT BE PLACED ACROSS A FLOWING WATERWAY, OR IN A WATERWAY WITH VELOCITIES GREATER THAN MANUFACTURER'S RECOMMENDATIONS.

C. FILTER CURTAINS SHOULD NOT BE PLACED AT THE OUTLET OF A CULVERT OR DITCH UNLESS THE VELOCITY DOES NOT EXCEED 1.5 FT/SEC.

D. DETAILS DEPICT WORK AT A BRIDGE LOCATION, BUT FILTER CURTAINS MAY BE APPLIED AT OTHER LOCATIONS.

## GENERAL NOTES:

1. FILTER CURTAINS SHALL BE PLACED AS CLOSE TO THE WORK AS POSSIBLE WITHOUT INTERFERING WITH CONSTRUCTION OPERATIONS.

2. FILTER CURTAINS SHALL BE A MAXIMUM OF 100 FEET LONG BETWEEN SHORELINE ANCHORS. LAST SECTION SHALL TERMINATE A MINIMUM OF 10 FEET BEYOND THE LIMIT OF DISTURBANCE.

3. THE CONTRACTOR SHALL MONITOR THE FILTER CURTAIN, TAKING INTO ACCOUNT WEATHER PATTERNS AND PREVAILING WIND DIRECTIONS THAT MAY AFFECT WATER LEVELS, VELOCITY AND MOVEMENT OF THE FILTER CURTAIN.

4. SEAMS IN THE FILTER CURTAIN FABRIC SHALL BE EITHER VULCANIZED WELDED OR SEWN, AND SHALL DEVELOP THE FULL STRENGTH OF THE FABRIC.

5. SOIL PARTICLES TRAPPED BY THE FILTER CURTAIN SHOULD ONLY BE REMOVED IF THERE HAS BEEN A SIGNIFICANT CHANGE IN THE ORIGINAL CONTOURS OF THE AFFECTED AREA IN THE WATERCOURSE.

6. SOIL PARTICLES SHALL BE ALLOWED 6-12 HOURS TO SETTLE PRIOR TO THEIR REMOVAL OR THE REMOVAL OF THE FILTER CURTAIN.

7. FILTER CURTAINS SHALL BE REMOVED BY SLOWLY PULLING TOWARDS THE SHORE TO MINIMIZE ESCAPE OF SEDIMENTS INTO THE WATERWAY.

# EROSION PREVENTION & SEDIMENT CONTROL DETAILS
# FILTER CURTAIN

| PROJECT: NEW-HAVEN WEYBRIDGE | PROJECT NO.: BHO BTN2005(1) |
|---|---|
| DESIGN FILE NAME: 89j081\structures\sJ081erodet.dgn | |
| IPARM FILE NAME: sj081epsc7.i | PLOT DATE: 28-FEB-2007 |
| DESIGNED BY: CONST. ENV. SECTION | DRAWN BY: CONST. ENV. SECTION |
| SQUAD LEADER: C.P. WILLIAMS | CHECKED BY: A. CABRAL |
| FILTER CURTAIN | SHEET: 53 OF 53 |

STATE OF VERMONT
AGENCY OF TRANSPORTATION
PROJ. NO. BHS-BTN 2005(1)
TE. NO. TH7/11, CL3 BRIDGE NO.26
ELN: HAVEN & WEYBRIDGE
DOISON COUNTY

**CCS** Constructors LLC
138 Munson Avenue
Morrisville, VT 05661
Ph: 802-888-7701 f: 802-888-4746

COSMEC INC.

## WELDING PROCEDURE SPECIFICATION

RECEIVED
APR 24 2007
CONSTRUCTION DIV. INC.

SPECIFICATIONS AND CODE: D1.6
MATERIAL SPECIFICATION ASTM A240 TYPE 304 TO ASTM A709 GR 50W
WELDING PROCESS---------- GTAW
MANUAL OR MACHINE------- MANUAL
POSITION OF WELDING----- 1F & 2F
FILLER METAL SPECIFICATION ER309L CLASSIFICATION: A5.9
MANUFACTURER: HARRIS WELCO TRADENAME:
FLUX-------- INTERNAL
SHIELDING GAS---------- ARGON FLOW RATE 45 CFH
SINGLE OR MULTIPLE PAS S SINGLE
SINGLE OR MULTIPLE ARC SINGLE
WELDING CURRENT--------- DC
POLARITY : REVERSE (EN)
WELDING PROGRESSION----------
ROOT TREATMENT---------- CLEANED & PREPARED BRIGHT METAL
PREHEAT AND INTERPASS TEMPERATURE---------- SEE BELOW
POSTHEAT TEMPERATURE N/A
HEAT IMPUT MIN.---------- MAX.----

## WELDING PROCEDURE

| PASS NO. | ELECTRODE SIZE | WELDING CURRENT AMPERES | VOLTS | TRAVEL SPEED | JOINT DETAIL |
|---|---|---|---|---|---|
| ALL | 3/32" | 130--155<br>16 GA THRU 10 GA<br>BM THICKNESS | 14-17 | 6.75--8.5 | LAP JOINT |

**PREHEAT TEMPS.** ***PREHEAT UNTIL NO MOSITURE PRESENT

| THICKNESS | TTEMP. |
|---|---|
| UP TO 3/4" | 100 DEG. |
| OVER 3/4" TO 1 1/2" | 100 DEG. |
| OVER 1 1/2" TO 2 1/2" | 100 DEG. |
| OVER 2 1/2" | 100 DEG. |

THIS PROCEURE MAY VARY DUE TO FABRICATION SEQUENCE, FIT-UP, PASS SIZE, ETC.
WITHIN THE LIMITATION OF VARIABLES GIVEN IN SECTION 5.
SUPPORTING PQR: GTAW-WF-05
PROCEDURE NO. GTAW-WF
REVISION NO. 1

CONTRACTOR: COSMEC INC.
AUTHORIZED BY: DONALD VOSE
CWI#:01100651 Donald Vose

DATE:--- 2/1/2005

VTRANS
RECEIVED
OK'D BY _____ OK'D BY JWC
APR 25 2007
RESUBMIT _____ APPROVED ✓
BY DATE 5-3-07

AWS
QC 1
DONALD E VOSE
01100651
CWI

054-BBWP

STATE OF VERMONT
AGENCY OF TRANSPORTATION
PROJ. NO. BH0-BTW 2005(1)
TE. NO. TH7/11, ACL 3 BRIDGE NO. 26
ISH HAVEN & WEYBRIDGE
ADDISON COUNTY

VTRANS
RECEIVED
OK'D BY_____ OK'D BY JWK
APR 2 5 2007
RESUBMIT_____ APPROVED_____
BY DATE 5-3-07

EMS-QC-110

COSMEC, INC.
70 SOUTH STREET
WALPOLE, MA 02081
PH# 508-668-6600
FAX# 508-660-1022

CCS Constructors LLC
138 Munson Avenue
Morrisville, VT 05661
Ph: 802-888-7701 f: 802-888-4746

RECEIVED
APR 24 2007
CONSTRUCTION CRANE SERV. INC.
MORRISVILLE, VT

ENGINEERING AND MANUFACTURING STANDARD
PTFE FACING AND STEEL
OR PREFORMED FABRIC SUBSTRATE
SURFACE PREPARATION AND ADHESIVE PROCEDURE

The PTFE facing shall be prepared for bonding to a substrate material by chemically etching the face to be bonded using the sodium ammonia process.

The mating surface of the substrate shall be prepared for bonding using a three-step process as follows:

1. preliminary degrease using methyl ethyl ketone.
2. mechanically roughen to approx. 125 RMS and thoroughly brush and clean for final degreasing.
3. final degrease using methyl ethyl ketone

The PTFE and substrate mating surfaces shall be clean and dry with final degreasing performed within 30 minutes of bonding. Adhesive shall consist of a two-part epoxy adhesive system conforming to Military Specification MMM-A-134

The adhesive shall be applied to the full area of the contact surface in an even manner so as to establish a glue line not less than .002 inch nor more than .010 inch thick. Surfaces being bonded are to be assembled immediately with open assembly time not to exceed 20 minutes.

The PTFE material shall be greater in width and length than the substrate material by at least ½ inch when bonded. The PTFE shall be applied with contact starting at one edge and with contact progressing across entire bonded surface to eliminate air entrapment. The PTFE is to be in full contact with the steel or preformed fabric substrate. Curing of the bond shall be done under pressure of approx. 2-100 psi for 10-12 hours at approx. 70°F or other schedules as established by the manufacturer of the adhesive.

The PTFE shall be carefully trimmed to the same size as the substrate after bond curing and all bonds shall be visually inspected for bond retention.

055-BBWP

State of Vermont
Agency of Transportation
National Life Building
Drawer 33
Montpelier, VT
05633-5001

VTrans Working to Get You There

May 3, 2007

Cosmec, Inc.
70 South Street
Walpole, MA 02081

**Re: New Haven – Weybridge BRO BTN 2005(1) – TH 7/11, Bridge 26**

The following Bearing details [Item #531.10, Bearing Device Assembly] and weld procedures and bonding procedures for the above project (Vendor's Job #60734) that were received in this office on April 25, have been reviewed and are being returned herewith.

All sheets are approved as noted. Please see comments on attached sheets. Weld procedures and bonding procedures are approved.

You must provide written notice to this office as to the date fabrication represented by these drawings will begin. That notice must be received at least seven days prior to that date, as per Specification 506.03. Any material fabricated prior to the notification date is subject to rejection without further cause.

Sincerely,


Christopher P. Williams, P.E.
Structures Project Manager

Attachments


cc: [ X ] – Resident Engineer
[ X ] CCS Constructors - Contractor
[ X ] Steel Inspector – Jeff Clark
[ X ] Construction Section - letter only
[ X ] Materials & Research (C&IA Unit) - letter only
[ X ] Project Files



056-BB WP

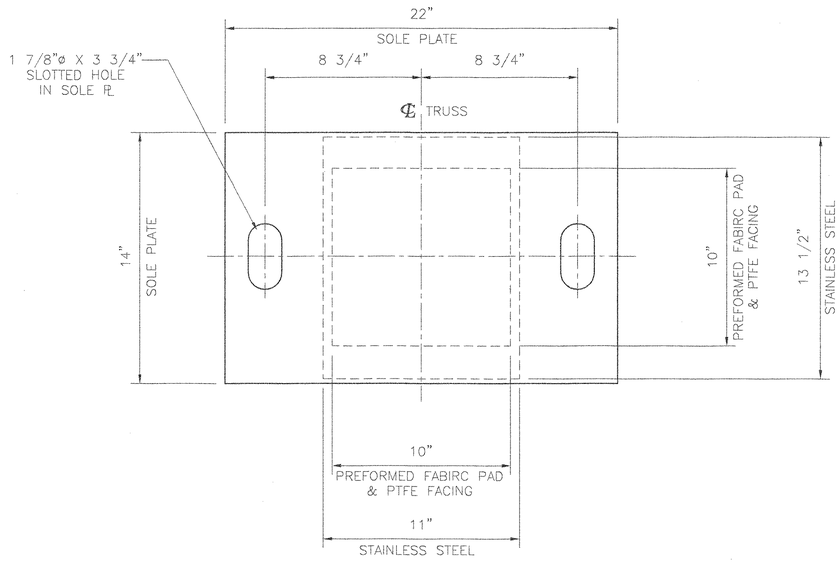



PLAN

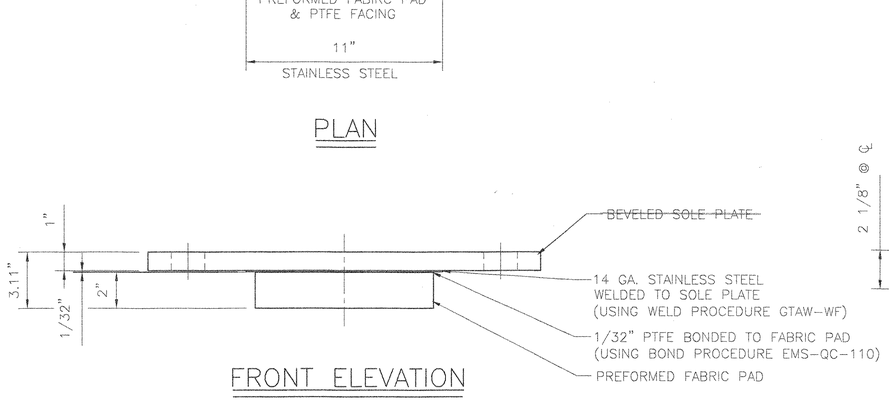


FRONT ELEVATION

# EXPANSION PREFORMED FABRIC PAD BEARING

LOCATION: ABUTMENT 1
QUANTITY: 2

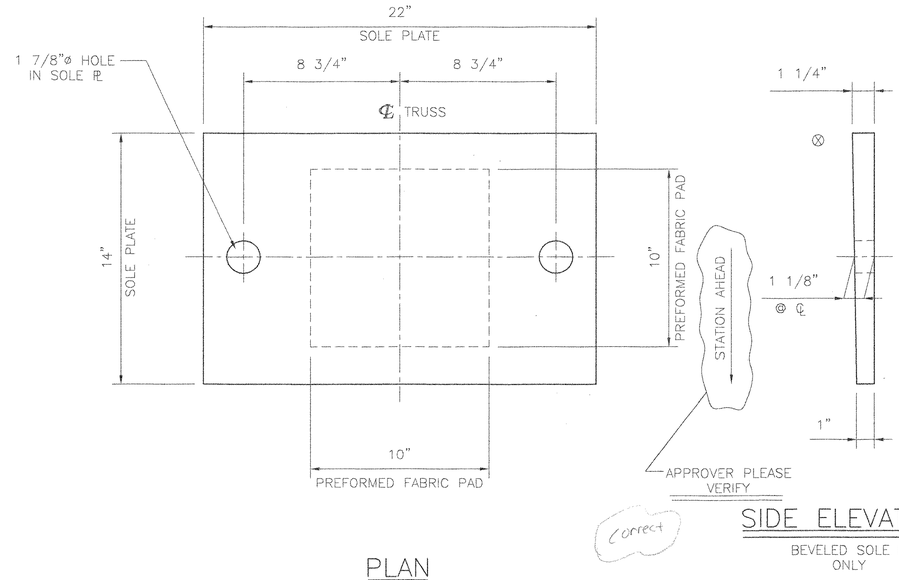



PLAN




SIDE ELEVATION


BEVELED SOLE PL
ONLY

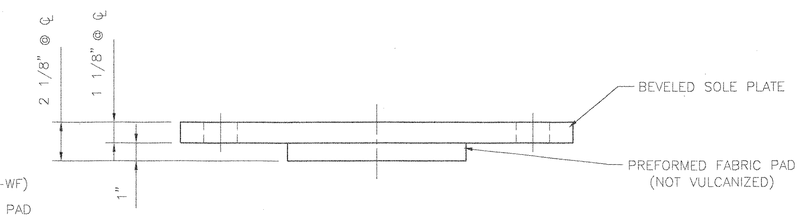


FRONT ELEVATION

# FIXED PREFORMED FABRIC PAD BEARING

LOCATION: ABUTMENT 2
QUANTITY: 2

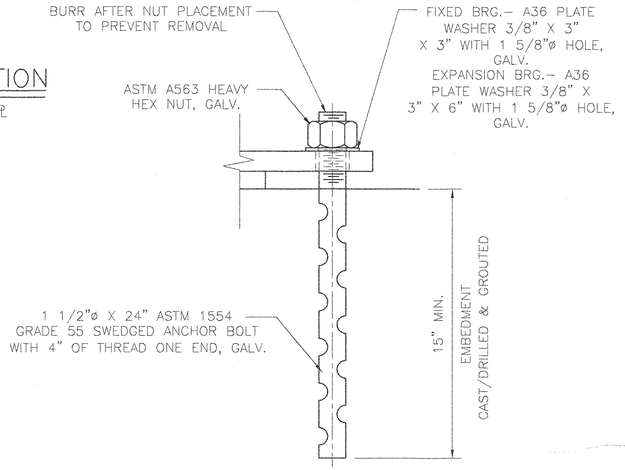


ANCHOR BOLT DETAIL

BEARING NOTES

1. ALL MATERIALS USED IN THE FABRICATION OF THESE BEARINGS SHALL BE MADE IN THE U.S.A.
2. BEARINGS ARE TO BE SHIPPED AS COMPLETE UNITS, STEEL BANDED, AND SHALL BE WRAPPED TO PROTECT FROM MOISTURE AND DIRT DURING TRANSIT AND STORAGE.
3. LOCATION OF FABRICATION PLANT – 70 SOUTH STREET WALPOLE, MA 02081
4. COSMEC, INC. REPRESENTATIVE – MR. MATT McANDREWS (508) 668-6600
5. BEARINGS SHALL BE STORED IN A CLEAN, DRY, LEVEL UPRIGHT POSITION.
6. ALL EDGES OF STEEL PLATES SHALL HAVE 1/16" MINIMUM RADIUS.
7. ⊗ MARKS THE THICK END OF BEVELED PLATE.
8. A. ALLOWABLE BEARING PRESSURE ON CONCRETE = 1,000 P.S.I.
   B. MINIMUM ALLOWABLE DESIGN ROTATION = 0.015 RADIANS.
   C. HORIZONTAL CAPACITY SHALL BE A MINIMUM OF 10% OF THE VERTICAL LOAD.
   D. DESIGN LOAD PER BEARING = 82 KIPS (DEAD LOAD + LIVE LOAD).

MATERIALS

STEEL – ASTM A709 GR. 50 ZINC METALLIZED AND SEALED.

STAINLESS STEEL – ASTM A.240 TYPE 304, WITH 10 RMS FINISH OR LESS ON SLIDING SURFACE

PREFORMED FABRIC PAD – AASHTO DIV. II SPEC. 18.4.9.1

PTFE – ASTM D4894 VIRGIN UNFILLED

ANCHOR BOLTS, NUTS & WASHERS – SEE DETAIL

ALL BEARINGS DEVICES SHALL BE METALIZED AS PER SUBSECTIONS 531.04(b) AND 506.15(b). BEARINGS SHALL BE SEALED WITH AN APPROVED SEALER AS SPECIFIED IN STANDARD SPEC. SUBSECTION 506.15(b). AREAS OF METALIZING DAMAGED BY FIELD WELDING OR HANDLING SHALL BE PAINTED WITH AN APPROVED SEALANT IN ACCORDANCE WITH STANDARD SPEC. SUBSECTION ~~708.02(d)~~.

531.06 (F)

RECEIVED
CK'D BY _____ OK'D BY _____
APR 2 5 2007
RESUBMIT _____ APPROVED AS Noted
BY GPW DATE 5/3/07

Structures Copy

RECEIVED
APR 24 2007
CONTRACTORS COPY, INC.
Morrisville, VT

CCS Constructors LLC
138 Munson Avenue
Morrisville, VT 05661
Ph: 802-888-7701 f: 802-888-4746

STATE OF VERMONT
AGENCY OF TRANSPORTATION
PROJECT NO. BHO-BTN 2005 (1)
RTE. NO. TH 7/11, CL 3 BRIDGE NO. 26
TOWNS OF NEW HAVEN & WEYBRIDGE
ADDISON COUNTY

COSMEC, INC. 70 SOUTH STREET WALPOLE, MA. 02081

| SCALE: 1/4"=1" | DRAWN BY: MRR | DATE: 4/19/07 | CHECKED BY: MCM | DATE 4/20/07 |
|---|---|---|---|---|

COSMEC FABRIC PAD BEARINGS

| REV. | | BY: | DATE | CK'D BY: | DATE |
|---|---|---|---|---|---|

| CUSTOMER | S.O. NUMBER | DRAWING NUMBER | REV. |
|---|---|---|---|
| CCS CONSTRUCTORS | 60734 | 5234 | |

057-BB

State of Vermont
Agency of Transportation
National Life Building
Drawer 33
Montpelier, VT
05633-5001

VTrans Working to Get You There

July 11, 2007

Casco Bay Steel Structures
75 Spring Hill road
Saco, Maine 04072

**Re: New Haven – Weybridge BHO BTN 2005(1) – TH 7, Bridge 26**

The following Structural Steel details (Sheet S1) [Item #506.50/60, Structural Steel] for the above project (Vendor's Job #329) that were received in this office on July 9, have been reviewed and are being returned herewith. The expansion joint details (Sheet J1) [Item 516.11 Bridge Expansion Joint, Vermont] that were received on June 11 have also been reviewed and are being returned.

Sheet S1 and J1 are both approved as noted. Please see comments in red on the attached sheet. Weld procedures are also approved.

You must provide written notice to this office as to the date fabrication represented by these drawings will begin. That notice must be received at least seven days prior to that date, as per Specification 506.03. Any material fabricated prior to the notification date is subject to rejection without further cause.

Sincerely,

Christopher P. Williams, P.E.
Structures Project Manager

Attachments

cc: [ X ] Dale Norton – Resident Engineer
[ X ] CCS Constructors - Contractor
[ X ] Steel Inspector – Jeff Clark
[ X ] Construction Section - letter only
[ X ] Materials & Research (C&IA Unit) - letter only
[ X ] Project Files



058-SSWP

**Casco Bay Steel Structures, Inc.**
5 Industry Road
South Portland, Maine 04106
Phone: (207) 772-2533 Fax: (207) 772-0580

## WELDING PROCEDURE SPECIFICATION

Material specification ASTM A709-Gr 36-50-50W (250-345-345W)
Welding process Shielded Metal Arc Welding (SMAW)
Manual or machine Manual
Position of welding Flat (F) Horizontal (H)
Filler metal specification AWS/AWS A5.1 - A5.5
Filler metal classification E7018 - E8018 C1/C2 - H4R
Flux N/A
Shielding gas N/A Flow rate N/A
Single or multiple pass Single and multiple
Single or multiple arc Single
Welding current AC / DC
Polarity Straight / Reverse
Welding progression
Root treatment Meet AWS specification
Preheat and interpass temperature To 3/4(19) 50°(10°) 3/4(19) To 1 1/4(38) 70°(20°) 1 1/4(38) To 2 1/2(63) 150°(65°) over 2 1/2(63) 225°(110°)
Postheat temperature N/A
Heat input Min N/A Max N/A

VTRANS
RECEIVED
JUN 11 2007
DR'D BY JWC
RESUBMIT
APPROVED ✓
BY
DATE 6/26/07

(METRIC)

WELDING PROCEDURE New Haven/Weybridge VT.
Proj. No. BHD-BTN-2005(4)
CBSS NO 329

| Pass no. | Electrode size | Welding current: Amperes | Welding current: Volts | Travel speed | AWS D1.5 Joint detail: Fillet |
|---|---|---|---|---|---|
| | 7018 | | | | 1F |
| | 1/8 (3.2) | 70-100 | 22-26 | | |
| | 5/32 (3.9) | 120-225 | 22-26 | AS | |
| AS. | 3/16 (4.80) | 170-300 | 24-27 | | |
| REQ. | E8018 | | | REQ. | 3/16 To 3/8 (5 To 10) / 3/8 To 1/2 (10 To 13) / 1/2 To 5/8 (13 To 16) |
| | 1/8 (3.2) | 90-160 | 22-26 | | |
| | 5/32 (3.9) | 120-225 | 22-26 | | 2F |
| | 3/16 (4.8) | 180-290 | 24-27 | | |
| | 7018R | | | | |
| | 5/32 (3.93) | 170-270 | 22-26 | | 3/16 To 5/16 (5 To 8) / 3/8 (10) / 7/16 To 5/8 (11 To 16) |
| | 3/16 (4.80) | 210-330 | 24-27 | | |

This procedure may vary due to fabrication sequence, fit-up, pass size, etc., within the limitation of variables given in applicable AWS codes or contract specifications

Procedure no. 401
Revision no. D
Form III-2

Contractor Casco Bay Steel
Authorized By Paul E. Hardale
Date 3/2/00

059 55 WP

**Casco Bay Steel Structures, Inc.**
75 Spring Hill Road
Saco, Maine 04072
hone: (207) 282-7360 Fax: (207) 282-1179

## WELDING PROCEDURE SPECIFICATION


Material specification ASTM-709-Gr36-50-50W/ A709M Gr 250-345-345W (PCMW)
Welding process Flux Cored Arc welding
Manual or machine Semi AUTO
Position of welding Flat - Horizontal
Filler metal specification AWS A5-29
Filler metal classification E81T1-Ni1-H4 ESAB
Flux NA
Shielding gas 75%AR-25%CO2 Flow rate 35 CFH +or- 4
Single or multiple pass Single / Multiple Elec EX 5/64" IN
Single-or multiple arc Single
Welding current DC
Polarity DCEP
Welding progression See detail
Root treatment wire brush - area To be Free of Loose Scale, Slag, rust & Moisture
Preheat and interpass temperature To 20°C (68) 10(50), 20°(36°) TO 40(104) 20(10), 40°(104) TO 60(140) 65°C(150) over 60(140) 110(225)
Postheat temperature NA
Heat Input Min 29.7 KJ/in Max 43.6 KJ/in PQR FCM#8 39.6 KJ/in
New Haven Weybridge VT.

## WELDING PROCEDURE

Proj No, BHO-BTN-2005(4)
AWS 5-17 CBSS NO 329

| Pass no. | Electrode Size | Welding current Amperes | Welding current Volts | Travel speed |
|---|---|---|---|---|
| | | 287 | 29 | 13 |
| | 1/16 | 258 TO .315 | 26.8 TO 31 | 11.4 TO 14 |

AWS D1-5 Joint detail Fillet

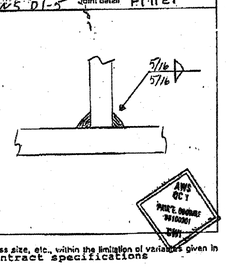


RECEIVED
JUN 1 1 2007


CK'D BY OK'D BY JMC
RESUBMIT APPROVED ✓
BY DATE 6/11/07

This procedure may vary due to fabrication sequence, fit-up, pass size, etc., within the limitation of variables given in applicable A.W.S. codes or contract specifications


Procedure no. 101
Revision no.
Form III-2

Contractor Casco Bay Steel
Authorized By Paul E. Goodell
Date 12-6-06


060-SSWP

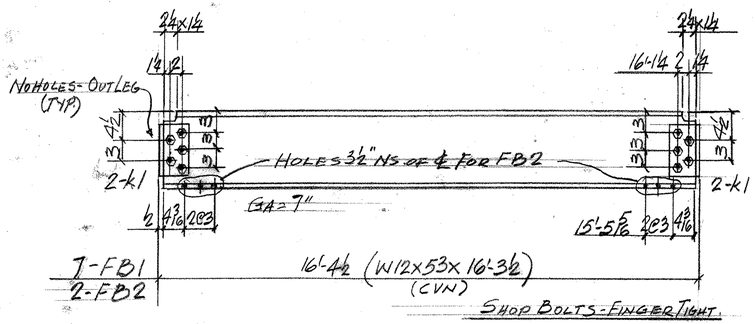


FLOOR BEAMS.

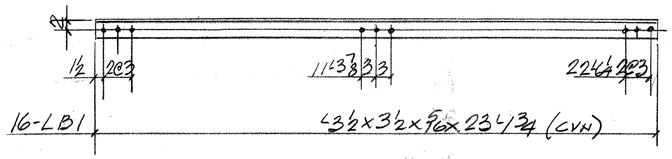


LATERAL BRACING

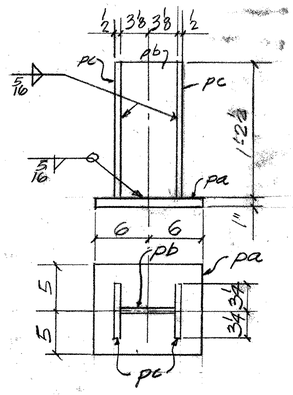


BC1 - 4 REQ'D.

BEARING COLUMN

| | |
|---|---|
| 2-L25 | L2½x2½x¼x 26'-6 (CVN) |
| 4-L29 | L3x2½x¼x 26'-6 |
| 2-L17 | L3½x2½x¼x 13'-6 |
| 4-L18 | L3x2½x¼x 19'-10 |
| 4-L31 | L3x2½x¼x 19'-10 |
| 8-L7 | L2½x2½x¼x 18'-6 |
| 4-L14 | L2½x2½x¼x 18'-6 (CVN) |
| 4-L20 | L3x2½x¼x 26'-6 |
| 8-L10 | L3½x3½x5/16x 18'-6 |
| 8-L11 | DO x 18'-6 |
| 4-L12 | DO x 18'-6 (CVN) |

Structures COPY

RECEIVED
JUL - 5 2007
CONTRACTORS CRANE SERV., INC.
MORRISVILLE, VT

RECEIVED
JUL 09 2007
BY CPW DATE 7/11/07

CCS Constructors LLC
138 Munson Avenue
Morrisville, VT 05661
Ph: 802-888-7701 f: 802-888-4746

# SHOP BILL

ABM INFO — JOB NO. 329 — DRG. NO. S1

| PAGE | LINE | NO. | DESCRIPTION | FT | IN | ASSEM. MARK | SHIPPING MARK | REMARKS | WEIGHT |
|---|---|---|---|---|---|---|---|---|---|
| | | 7 | W12x53 | 16 | 3½ | | FB1 | (CVN) | |
| | | 2 | DO | 16 | 3½ | | FB2 | DO | |
| | | 36 | L 5x3x⅜ | | 9 | k1 | | | |
| | | 90 | ¾" Ø BOLTS ROUND HEADS A325-GALV. | | 2½ | SHOP | | W/N=W | |
| | | 16 | L3½x3½x5/16 | 23 | 1¾ | | LB1 | (CVN) | |
| | | 4 | ASS'Y | 1 | 3½ | | BC1 | | — |
| | | 4 | PL ½x10 | 1 | 0 | pa | | 506.60 (EXTRA) | |
| | | 4 | PL ½x6¼ | 1 | 2½ | pb | | | |
| | | 8 | PL ½x6½ | 1 | 2½ | pc | | | |
| | | 2 | L2½x2½x¼ | 26 | 6 | | L25 | (CVN) | |
| | | 4 | L3x2½x¼ | 26 | 6 | | L29 | (CVN) | |
| | | 2 | L3½x2½x¼ | 13 | 6 | | L17 | (CVN) | |
| | | 4 | L3x2½x¼ | 19 | 10 | | L18 | (CVN) | |
| | | 4 | DO | 19 | 10 | | L31 | ↓ | |
| | | 8 | L2½x2½x¼ | 18 | 6 | | L7 | ↓ | |
| | | 4 | DO | 18 | 6 | | L14 | ↓ | |
| | | 4 | L3x2½x¼ | 26 | 6 | | L20 | (CVN) | |
| | | 8 | L3½x3½x5/16 | 18 | 6 | | L10 | ↓ | |
| | | 8 | DO | 18 | 6 | | L11 | ↓ | |
| | | 4 | DO | 18 | 6 | | L12 | | |

PAY ITEM 506.50 - L.N.

| REV. | REMARKS | DATE | DWN | CHK | APP | Q.A. | NO. | DIA. | LGT | TYPE | WASHER |
|---|---|---|---|---|---|---|---|---|---|---|---|
| | OUT FOR APPROVAL | 6-7-07 | | | | | | | | | |
| | OUT FOR APPROVAL | 7-13-07 | | | | | | | | | |
| | ISSUED TO SHOP | | | | | | | | | | |
| | FIELD & OFFICE | | | | | | | | | | |

PROJECT NO. BHO-BTN-2008(1) STATE PROJECT NO.

MATERIAL AASHTO M270-GR50 | ELECTRODES: SEE PROC. | HOLES: 13/16 Ø | SHOP BOLTS: ¾" Ø

SURFACE PREP. & PAINT: A325-GALV.

PRIMER ONLY

DESCRIPTION: STRUCTURAL DETAILS

JOB: BRIDGE IMPROVEMENTS NEW HAVEN & WEYBRIDGE, VT.

CUSTOMER: CCS


| | DRAWN BY | DATE |
|---|---|---|
| | JPF | 6-07 |
| | CHKD BY | |
| | EJ | ✓ |
| | APPROV BY | |
| | Q.A. | |

**CASCO BAY STEEL STRUCTURES, INC.**
75 SPRING HILL ROAD · SACO, MAINE 04072
PHONE (207) 282-7360 FAX. (207) 282-1179

JOB NO. 329 | DRG. NO. S1 | REV. △


1" = 1'-0

061-55

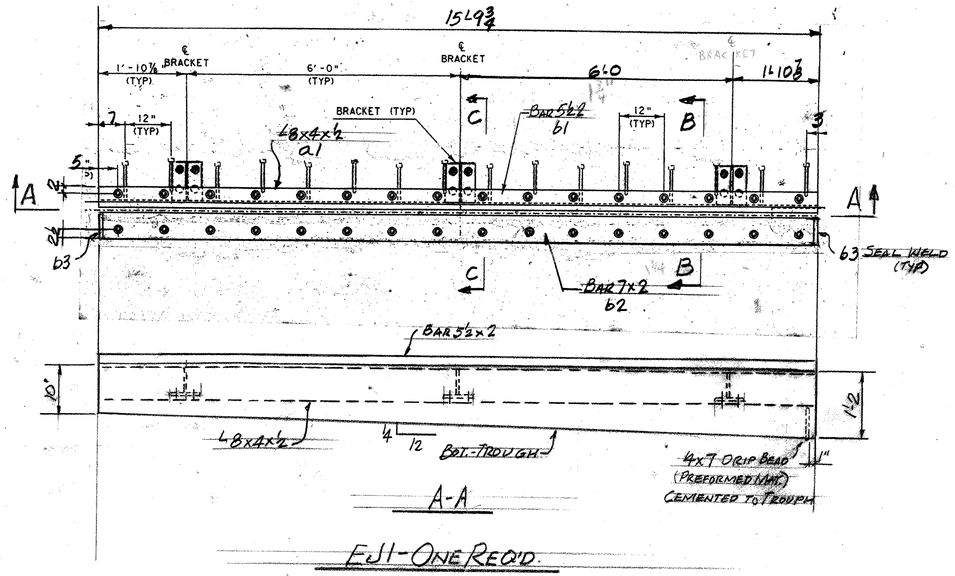



A-A


FJ1-ONE REQ'D.

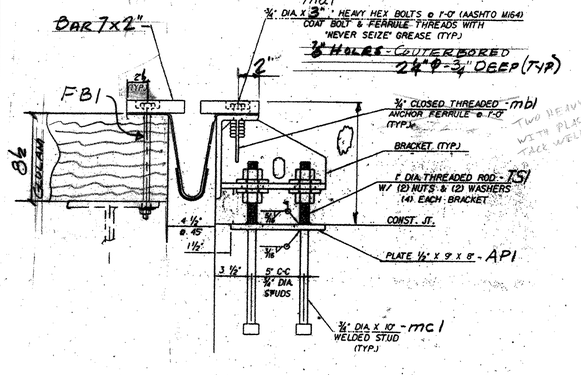



TYPICAL SECTION AT BEAMS C-C

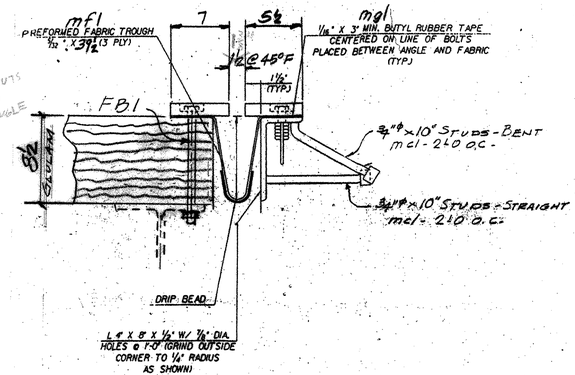



TYPICAL SECTION

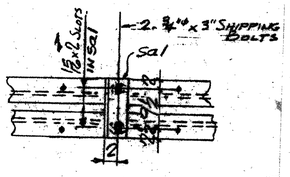



SHIPPING DEVICE SPACED 5'-0" O.C. MAX.

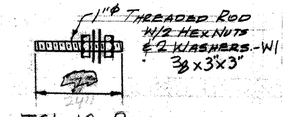


TS1-12-REQ'D

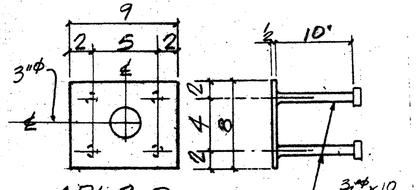


API-3-REQ'D

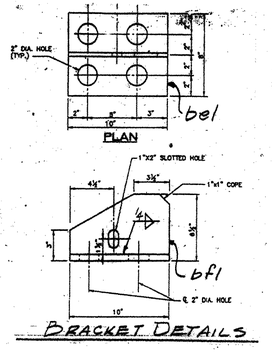


BRACKET DETAILS

RECEIVED
OK'D BY MJT OK'D BY RSV
JUN 1 1 2007
RESUBMIT ____ APPROVED AS Noted
BY CPW DATE 7/11/07

RECEIVED
JUN 8 2007
CONTRACTORS CRANE SERV., INC.
MORRISVILLE, VT

CCS Constructors LLC
138 Munson Avenue
Morrisville, VT 05661
Ph: 802-888-7701 f: 802-888-4746

| ABM INFO PAGE | LINE | NO. | DESCRIPTION | FT | IN | ASSEM. MARK | SHIPPING MARK | REMARKS | WEIGHT |
|---|---|---|---|---|---|---|---|---|---|
| | | 1 | EXP. JOINT | 15 | 10± | | EJ1 | | — |
| | | | L8x4x1/2 | 15 | 9 3/4 | a1 | | | |
| | | 1 | BAR 5/8 x 2 | 15 | 9 3/4 | b1 | | | |
| | | 1 | BAR 7x2 | 15 | 9 3/4 | b2 | | | |
| | | 2 | BAR 1x1 | | 7 | b3 | | | |
| | | 3 | PL 1/2 x 8 | | 10 | bc1 | | | |
| | | 3 | PL 1/2 x 6 | | 10 | bf1 | | | |
| | | 16 | 3/4" HEX BOLTS | | 3 | ma1 | | | |
| | | 16 | 3/4" CLOSED THREADED ANC. FERRULES | | | mb1 | | | |
| | 16 | 15 | 3/4" ANC STUDS | | 10 | mc1 | | | |
| | | 16 | 3/4" HEX BOLTS | 1 | 0 | | FB1 | W/ NUTS & WASHERS | |
| | | 1 | PREFORMED FABRIC TROUGH 1/2" x 39 1/2" | 16 | 0± | mf1 | | SPEC'D PER SUBSECTION 707 | |
| | | 2 | BUTYL RUBBER TAPE 1/16 x 3 | 16 | 0± | | | AASHTO NAME-TYPE II | |
| | | 12 | 1" Ø THREADED RODS | | | | TS1 | | |
| | | 24 | 1" HEX NUTS | | | | FIELD | | |
| | | 24 | PL 3/8 x 3 | | 3 | | W1 | PR WASH. | |
| | | 3 | PL 1/2 x 8 | | 9 | | API | | |
| | | 12 | 3/4" ANC STUDS | | 10 | mc1 | | | |
| | | 3 | L4x4x1/2 | 1 | 2 | sa1 | | | |
| | | 3 | 3/4" Ø BOLTS | | 3 1/2 | | | | |
| | | 3 | DO | | 3 | | | W/ NUTS & WASHERS | |

PAY ITEM 516.11

| REV. | REMARKS | DATE | DWN | CHK | APP | Q.A. | NO. | DIA. | LGT | TYPE | WASHER |
|---|---|---|---|---|---|---|---|---|---|---|---|
| | OUT FOR APPROVAL | 6/7 | | | | | | | | | |
| | OUT FOR APPROVAL | 7/07 | | | | | | | | | |
| | ISSUED TO SHOP | | | | | | | | | | |
| | FIELD & OFFICE | | | | | | | | | | |

PROJECT NO. BHO-BTN-2006(1) STATE PROJECT NO.

MATERIAL: AASHTO M270 Gr 36 ELECTRODES: SEE PROC. HOLES: AS NOTED SHOP BOLTS: 3/4"Ø A325 GALV.

SURFACE PREP. & PAINT:

GALV. AFTER FAB - (ASTM-A123)

DESCRIPTION: EXPANSION JOINT

JOB: BRIDGE IMPROVEMENTS NEW HAVEN & WEYBRIDGE, VT.

CUSTOMER: CCS

| | DRAWN BY | DATE |
|---|---|---|
| | JPF | 6-07 |
| CHKD BY | EJ | |
| APPROV BY | | |
| Q.A. | | |

**CASCO BAY STEEL STRUCTURES, INC.**
75 SPRING HILL ROAD SACO, MAINE 04072
PHONE (207) 282-7360 FAX. (207) 282-1179

| JOB NO. | DRG. NO. |
|---|---|
| 329 | J1 |
| REV. | △ |

Structures Copy

062-BJ

State of Vermont
Agency of Transportation
National Life Building
Drawer 33
Montpelier, VT
05633-5001

VTrans Working to Get You There

July 12, 2007

Casco Bay Steel Structures
75 Spring Hill road
Saco, Maine 04072

**Re: New Haven – Weybridge BHO BTN 2005(1) – TH 7, Bridge 26**

The following Downspout details (Sheet D1) [Item #506.60, Structural Steel] for the above project (Vendor's Job #329) that were received in this office on June 26, have been reviewed and are being returned herewith.

Sheet D1 is approved.

You must provide written notice to this office as to the date fabrication represented by these drawings will begin. That notice must be received at least seven days prior to that date, as per Specification 506.03. Any material fabricated prior to the notification date is subject to rejection without further cause.

Sincerely,

Christopher P. Williams, P.E.
Structures Project Manager

Attachments

cc: [ X ] Dale Norton – Resident Engineer
[ X ] CCS Constructors - Contractor
[ X ] Steel Inspector – Jeff Clark
[ X ] Construction Section - letter only
[ X ] Materials & Research (C&IA Unit) - letter only
[ X ] Project Files

| ABM INFO | | SHOP BILL | | | | | JOB NO. 329 | DRG. NO. D1 |
|---|---|---|---|---|---|---|---|---|
| PAGE | LINE | NO. | DESCRIPTION | FT | IN | ASSEM. MARK | SHIPPING MARK | REMARKS | WEIGHT |
| | | 1 | TS6x5x¼ | 9 | 6 | | DS1 | ASTM A500-B | |
| | | 2 | BAR 4x¼ | 1 | 10± | | BK | BEND. | |
| | | 4 | 1" DIA EXP. BOLTS | | 8 | | FIELD | | |
| | | | | | | | | | |
| | | | | | | | | | |
| | | | | | | |

State of Vermont
Agency of Transportation
National Life Building
Drawer 33
Montpelier, VT
05633-5001

VTrans Working to Get You There

August 1, 2007

Laminated Concepts, Inc.
P.O. Box 369
3310 State Rte. 352
Big Flats, NY 14814

**Re: New Haven – Weybridge BHO BTN 2005(1) – TH 7, Bridge 26**

The following Glulam Deck details [Item #522.40, Structural Glued Laminated Timber] for the above project (Vendor's Job #2107-150-LT) that were received in this office on July 27, have been reviewed and are being returned herewith.

**Please note that these plans reflect field-verified dimensions provided by the contractor. These plans supersede the previous plans that were approved and distributed in my letter of July 20.**

All sheets are approved.

There shall be no fabrication done until all drawings and welding procedures are approved. You must provide written notice to this office as to the date fabrication represented by these drawings will begin. That notice must be received at least seven days prior to that date. Any material fabricated prior to the notification date is subject to rejection without further cause.

Sincerely,


Christopher P. Williams, P.E.
Structures Project Manager

Attachments


cc: [ X ] Dale Norton – Resident Engineer
[ X ] CCS Constructors - Contractor
[ X ] Construction Section - letter only
[ X ] Materials & Research (C&IA Unit) - letter only
[ X ] Project Files




P65-GD

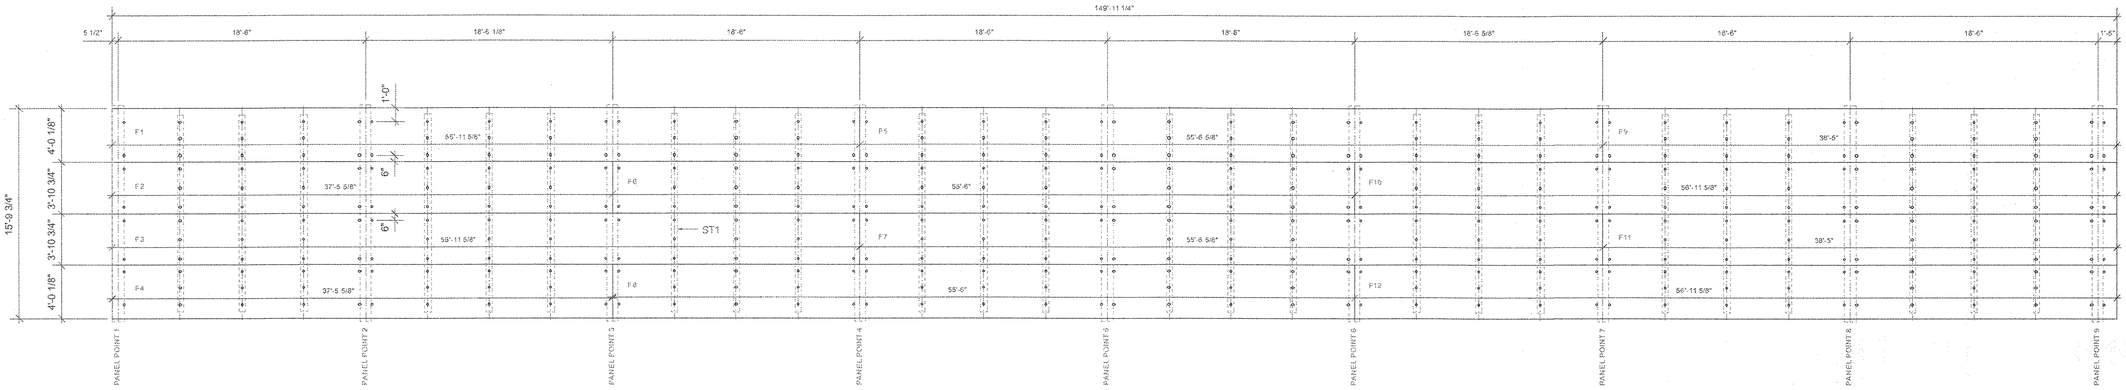


DECKING PLAN

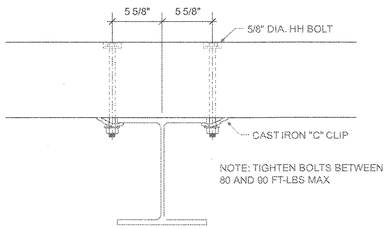


DECK TO STEEL DETAIL

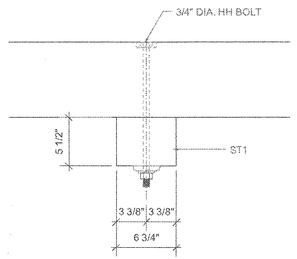


TYPICAL DECK TO STIFFENER DETAIL

**LAMINATED CONCEPTS INC. LIST OF HARDWARE MATERIALS**

21 07 150 LT VT AOT

| | description | qty | dia. | lgt | wh | wn | n | type |
|---|---|---|---|---|---|---|---|---|
| **bolts** | Deck to steel | 136 | 5/8" | 10" | F | F | 1 | Hex Head Bolts |
| | Deck to stiffener | 288 | 3/4" | 16" | F | T | 1 | Hex Head Bolts |
| | | 280 | 5/8" | | | | | Flat Washers |
| | | 290 | 3/4" | | | | | Flat Washers |
| | | 290 | 3/4" | | | | | Timber Washers |
| | | 140 | 5/8" | | | | | Hex Nuts |
| | | 290 | 3/4" | | | | | Hex Nuts |

NOTE:wh = washer type at bolt head, wn = washer type at nut, n = nuts ;washer type (T =Timber / F =Flat / P=Plate / D=Dock)

| | description | qty | thk | width | length | type |
|---|---|---|---|---|---|---|
| **steel** | | | | | | |

| | qty | type |
|---|---|---|
| **attachments** | 136 | CAST IRON "C" CLIPS |

| | qty | thk | width | length |
|---|---|---|---|---|
| **neo.** | | | | |

**LAMINATED CONCEPTS INC. LIST OF LAMINATED TIMBER MATERIALS**

21 07 150 LT VT AOT

| qty | mk# | width | depth | length ft | length in | grade | species | remarks | bf tot |
|---|---|---|---|---|---|---|---|---|---|
| 1 | F1 | 8.5 | 48.125 | 55 | 11.625 | COMB. 50 | SYP | FAB. REQ'D | 1907.89 |
| 1 | F2 | 8.5 | 46.75 | 37 | 5.625 | COMB. 50 | SYP | FAB. REQ'D | 1240.76 |
| 1 | F3 | 8.5 | 46.75 | 55 | 11.625 | COMB. 50 | SYP | FAB. REQ'D | 1853.38 |
| 1 | F4 | 8.5 | 48.125 | 37 | 5.625 | COMB. 50 | SYP | FAB. REQ'D | 1277.26 |
| 1 | F5 | 8.5 | 48.125 | 55 | 6.625 | COMB. 50 | SYP | FAB. REQ'D | 1893.69 |
| 1 | F6 | 8.5 | 46.75 | 55 | 6 | COMB. 50 | SYP | FAB. REQ'D | 1837.86 |
| 1 | F7 | 8.5 | 46.75 | 55 | 6.625 | COMB. 50 | SYP | FAB. REQ'D | 1839.58 |
| 1 | F8 | 8.5 | 48.125 | 55 | 6 | COMB. 50 | SYP | FAB. REQ'D | 1891.91 |
| 1 | F9 | 8.5 | 48.125 | 38 | 5 | COMB. 50 | SYP | FAB. REQ'D | 1309.57 |
| 1 | F10 | 8.5 | 46.75 | 56 | 11.625 | COMB. 50 | SYP | FAB. REQ'D | 1886.50 |
| 1 | F11 | 8.5 | 46.75 | 38 | 5 | COMB. 50 | SYP | FAB. REQ'D | 1272.15 |
| 1 | F12 | 8.5 | 48.125 | 56 | 11.625 | COMB. 50 | SYP | FAB. REQ'D | 1941.98 |
| 24 | ST1 | 6.75 | 5.5 | 14 | 9.75 | COMB. 50 | SYP | FAB. REQ'D | 1099.83 |

**. SCOPE**

This standard is intended to augment, or support, design requirements that may be issued by the owner.

**2. DEFINITIONS AND ABBREVIATIONS**

**AITC** American Institute of Timber Construction; **APA/EWS** American Wood Systems members, a related Corp. of the American Plywood Association; **AWPA** American Wood Preservers Association, **NDS** National Design Specifications. **TTE** tag this end **UNO** unless noted otherwise **DAC** Dimensions are cumulative **NIC** not in contract

**3. CODES AND STANDARDS**

In addition to complying with all pertinent codes and regulations, materials shall comply with the following:

3.1 American Association of State Highway and Transportation Officials (AASHTO)

3.2 American National Standard for Wood Products-Structural Glued Laminated Timber ANSI A190. 1-1992

3.3 Proof-loading system for laminated finger joints to be in accordance with ANSI A190.1

**4. CERTIFICATIONS**

4.1 Certifications required by the laminator:

4.1.1 The AITC or APA/EWS Certificate of Conformance with ANSI A190.1-1992

4.2 Preservative treatment certification required (if applicable)

4.2.1 Certificate of treatment furnished by a certified AWPA treating facility

**5. STRUCTURAL DESIGN**

The structure shall be designed to carry the following loads:

5.1 Dead Load

5.2 Live Load H-20

**6. MATERIALS**

6.1 Lumber-intended for structural use with design stress shall be graded in conformance with accepted standards for allowable unit stresses (See AASHTO Section 13)

6.2 Grade-Industrial Appearance Grade as per AITC 110.

6.3 All lumber to be Incised Southern Yellow Pine. Glulam as per AITC 117-98.

6.4 Adhesive: all members bonded with exterior "wet-use" conforming to ASTM D 2559

**7. PRESERVATIVE TREATMENT**

7.1 All GLU-lam material to be treated with the preservative Pentachlorophenol in Type A oil conforming to AWPA Standard C-28,C-14, P-8 and P-9. Retention level shall be 0.60 PCF. Final steaming and vacuuming shall be performed.

**8. HARDWARE**

8.1 All bolts and nuts shall galvanized (A-153) steel ASTM A307 , unless noted otherwise,

8.2 Timber Washers to be galvanized cast iron or malleable iron.

8.3 "C" Clips shall be galvanized cast iron Grade 30

**9. MISC**

9.1 LCI is not responsible for materials or manufacturing not shown on these drawings.

9.2 Contractor is responsible for verification of all sizes, quantities and dimensions shown on shop drawings

9.3 For wearing surface information, refer to the USDA Forest Service manual "Timber bridges -Design, Construction, Inspection and Maintenance" Chapter 11, for types and applications.

STRUCTURES COPY

RECEIVED
CK'D BY EJC OK'D BY RSY
JUL 2 7 2007
RESUBMIT ____ APPROVED ✓
BY CPW DATE 7/31/07

LAMINATED CONCEPTS INC.
P.O. BOX 369
3310 STATE RTE 352
BIG FLATS, NEW YORK 14814
PHONE: 607.562.8110
FAX. 607.562.8105

| DRAWN | DATE |
|---|---|
| MSS | 6/4/07 |
| CHK'D | DATE |
| APP'D | DATE |
| SCALE | |

REVISIONS

| NO. | DATE | BY | REVISIONS |
|---|---|---|---|
| 1 | 7/17/07 | ss | revise panels |
| 2 | 7/24/07 | ss | revise panels |


PROJECT NAME
BHO-BTN 2005 (1) BRIDGE NO. 26
TOWNS OF NEW HAVEN AMD WEYBRIDGE
COUNTY OF ADDISON, VERMONT

PROJECT JOB NO.
2107-150-LT


PREPARED FOR
CCS CONSTRUCTORS, LLC
MORRISVILLE, VT

SHEET NO.
1 OF 4


066-6D

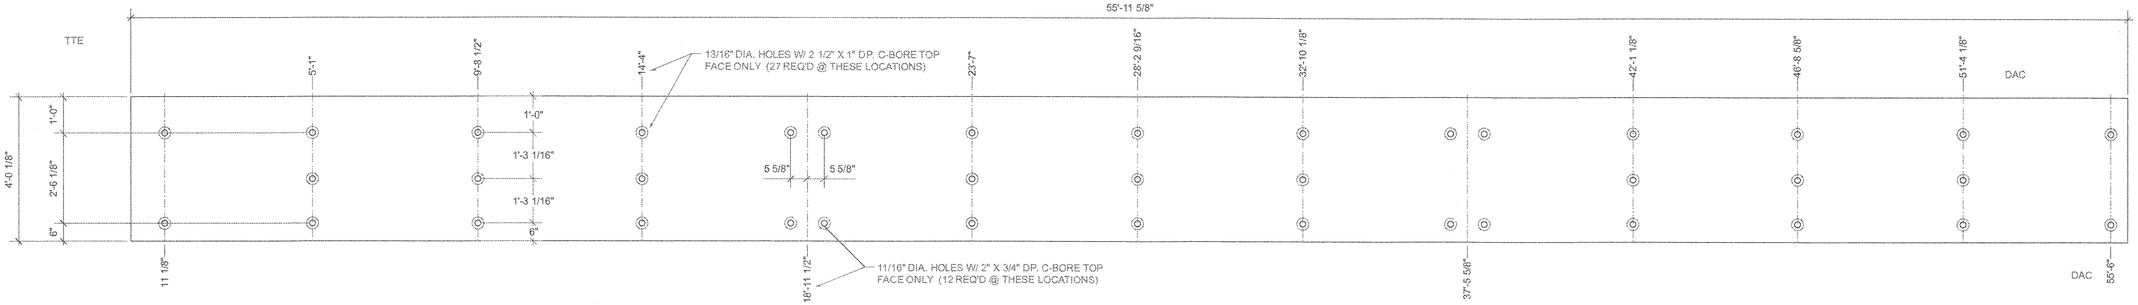



MK-F1 8 1/2" X 48 1/8" X 55'-11 5/8" 1 REQ'D COMB. 50 APPROX. WT. = 7210#

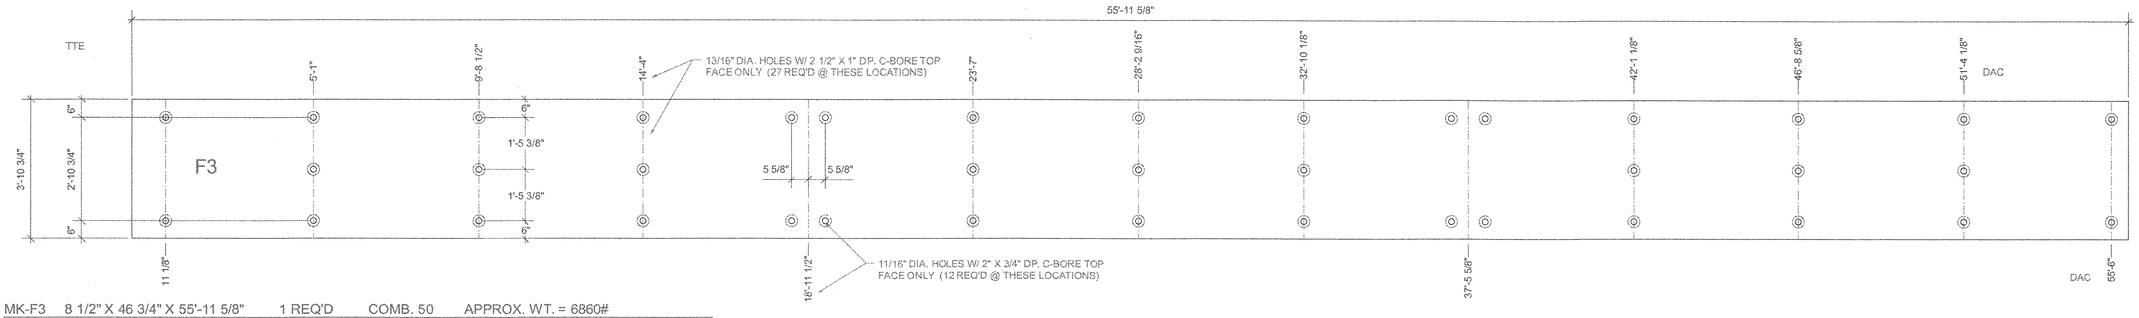


MK-F3 8 1/2" X 46 3/4" X 55'-11 5/8" 1 REQ'D COMB. 50 APPROX. WT. = 6860#

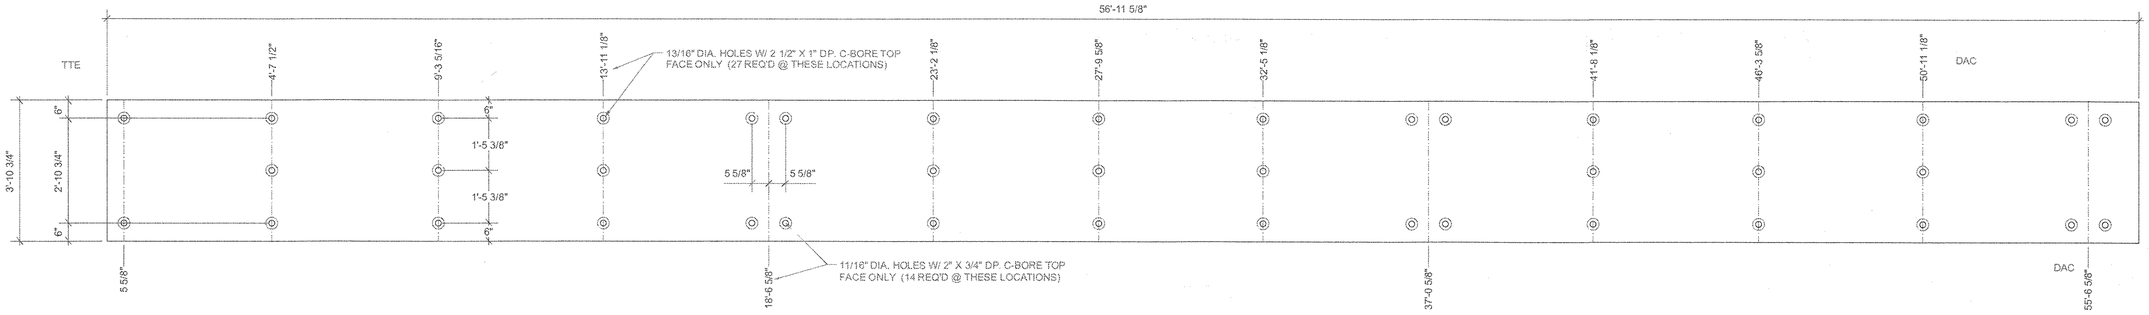


MK-F10 8 1/2" X 46 3/4" X 56'-11 5/8" 1 REQ'D COMB. 50 APPROX. WT. = 6970#

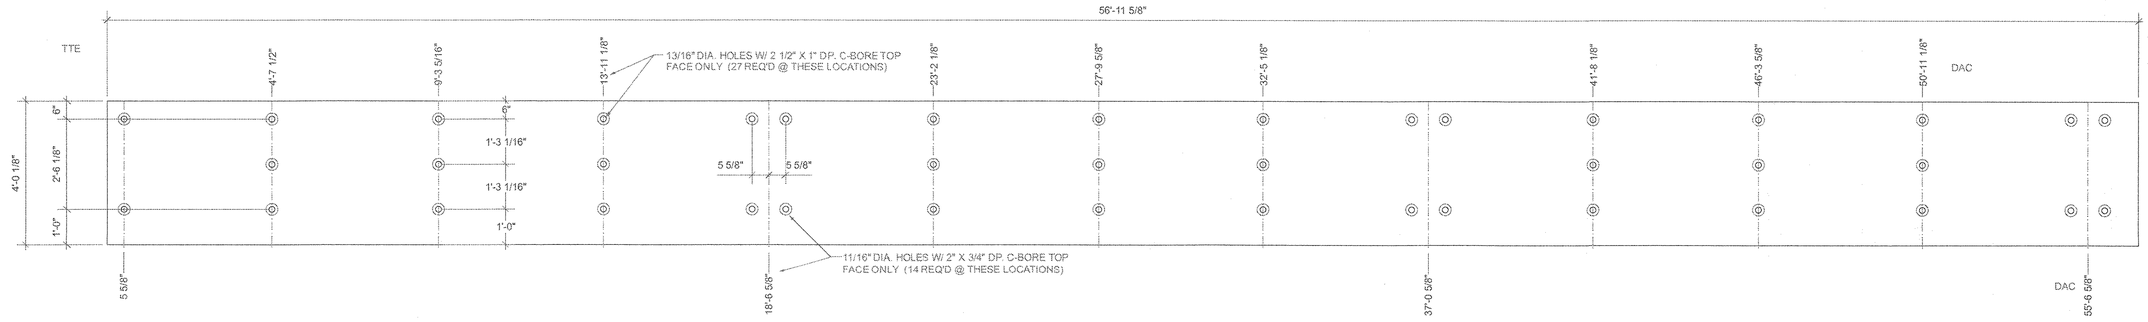


MK-F12 8 1/2" X 48 1/8" X 56-11 5/8" 1 REQ'D COMB. 50 APPROX. WT. = 7340#

RECEIVED
CK'D BY BK CK'D BY JRS
JUL 2 7 2007
RESUBMIT APPROVED
BY CPW DATE 7/31/07

LAMINATED CONCEPTS INC.
P.O. BOX 369
3310 STATE RTE 352
BIG FLATS, NEW YORK 14814
PHONE: 607.562.8110
FAX. 607.562.8105

| DRAWN | DATE |
|---|---|
| MSS | 6/4/07 |
| CHK'D | DATE |
| APP'D | DATE |
| SCALE | |

REVISIONS

| NO. | DATE | BY | REVISIONS |
|---|---|---|---|
| 1 | 7/17/07 | ss | revise panels |
| 2 | 7/24/07 | ss | revise panels |


PROJECT NAME
BHO-BTN 2005 (1) BRIDGE NO. 26
TOWNS OF NEW HAVEN AMD WEYBRIDGE
COUNTY OF ADDISON, VERMONT

PROJECT JOB NO.
2107-150-LT


PREPARED FOR
CCS CONSTRUCTORS, LLC
MORRISVILLE, VT

SHEET NO.
2 OF 4


067-GD

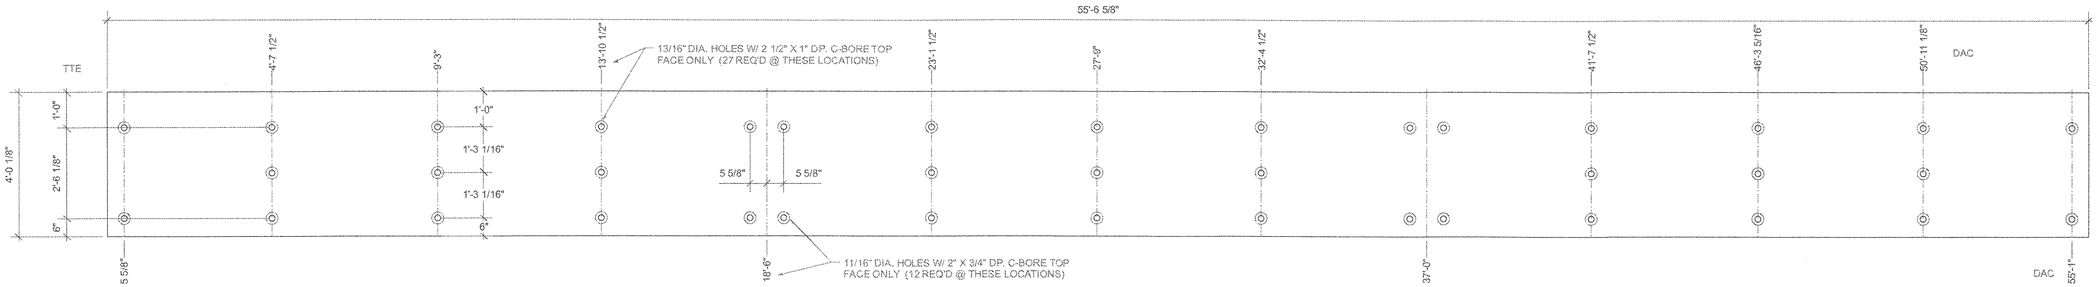



MK-F5 8 1/2" X 48 1/8" X 55'-6 5/8" 1 REQ'D COMB. 50 APPROX. WT. = 7150#

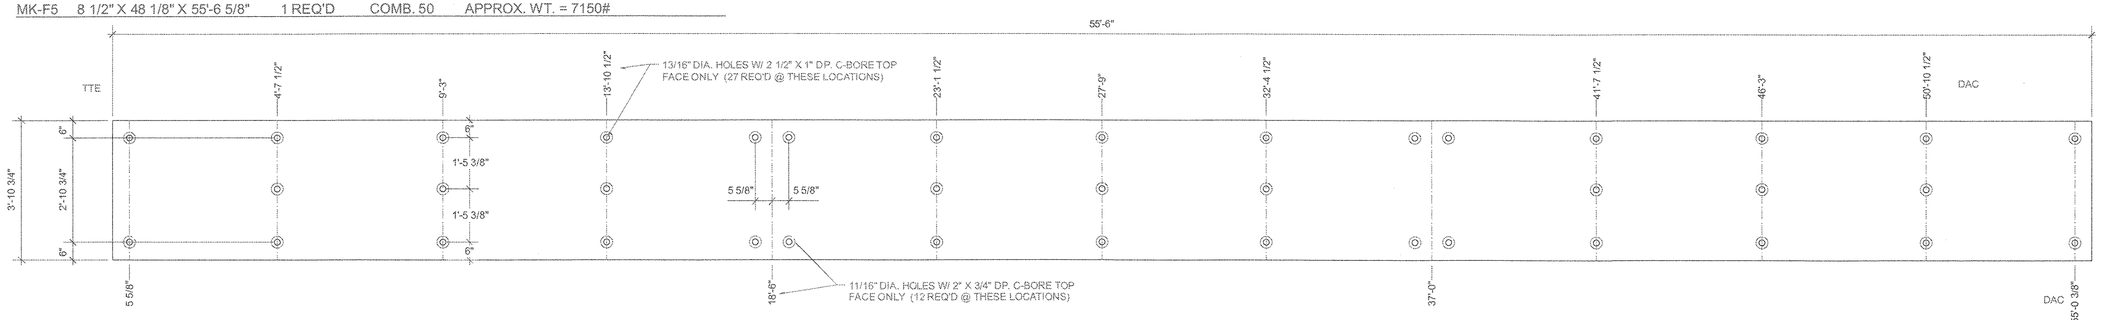


MK-F6 8 1/2" X 46 3/4" X 55'-6" 1 REQ'D COMB. 50 APPROX. WT. = 6800#

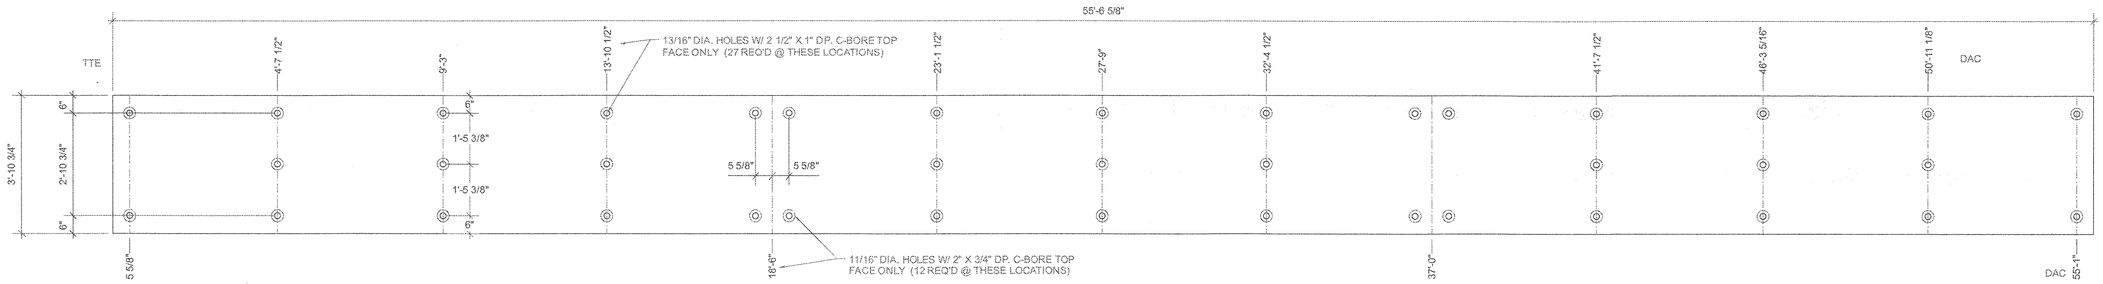


MK-F7 8 1/2" X 46 3/4" X 55'-6 5/8" 1 REQ'D COMB. 50 APPROX. WT. = 6800#

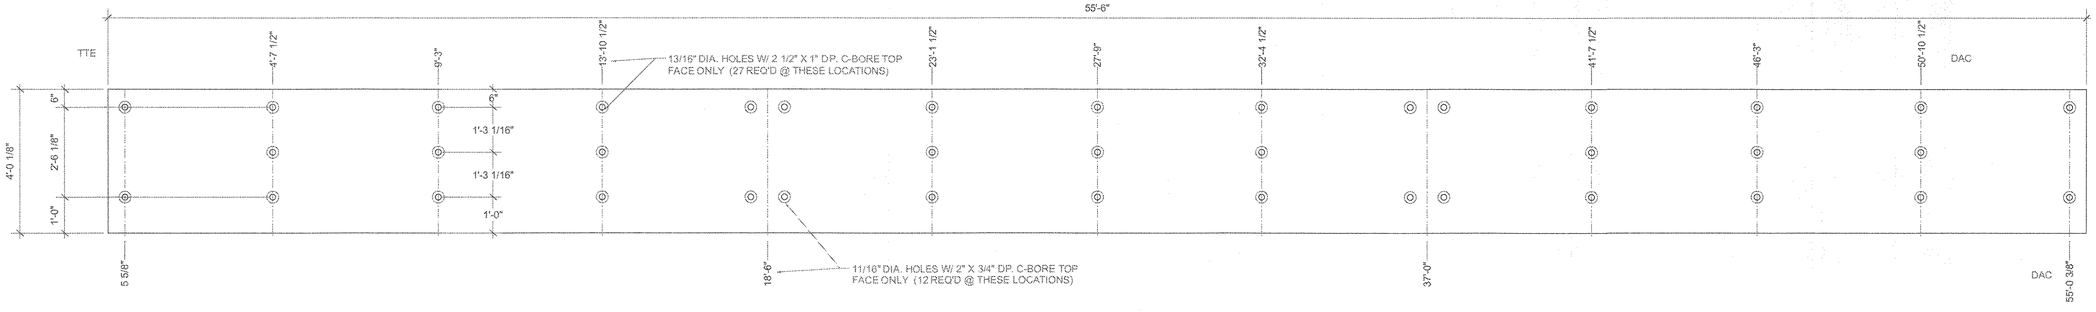


MK-F8 8 1/2" X 48 1/8" X 55'-6" 1 REQ'D COMB. 50 APPROX. WT. = 7150#

RECEIVED
CK'D BY EJK OK'D BY DCS
JUL 2 7 2007
RESUBMIT APPROVED
BY GPW DATE 7/31/07

LAMINATED CONCEPTS INC.
P.O. BOX 369
3310 STATE RTE 352
BIG FLATS, NEW YORK 14814
PHONE: 607.562.8110
FAX. 607.562.8105

| DRAWN | DATE |
|---|---|
| MSS | 6/4/07 |
| CHK'D | DATE |
| APP'D | DATE |
| SCALE | |

REVISIONS

| NO. | DATE | BY | REVISIONS |
|---|---|---|---|
| 1 | 7/17/07 | ss | revise panels |
| 2 | 7/24/07 | ss | revise panels |


PROJECT NAME
BHO-BTN 2005 (1) BRIDGE NO. 26
TOWNS OF NEW HAVEN AMD WEYBRIDGE
COUNTY OF ADDISON, VERMONT

PROJECT JOB NO.
2107-150-LT


PREPARED FOR
CCS CONSTRUCTORS, LLC
MORRISVILLE, VT

SHEET NO.
3 OF 4


068-GD

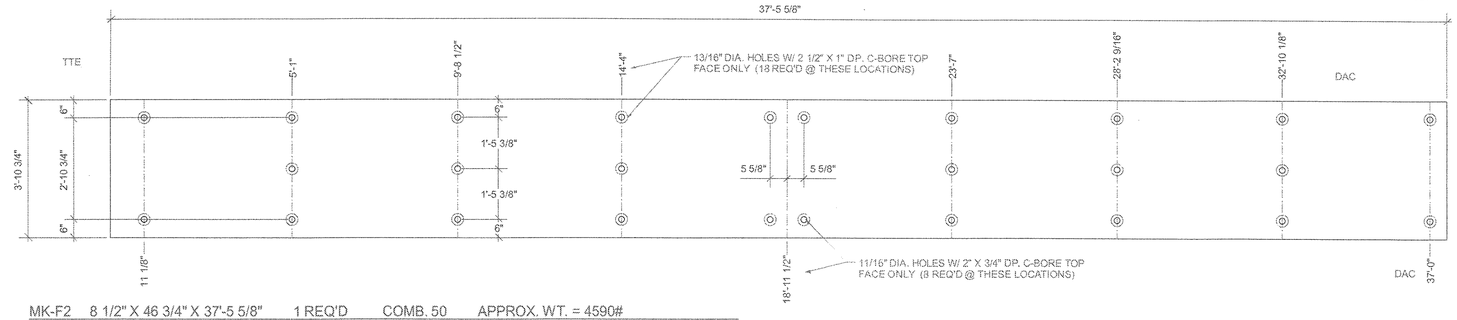



MK-F2 8 1/2" X 46 3/4" X 37'-5 5/8" 1 REQ'D COMB. 50 APPROX. WT. = 4590#

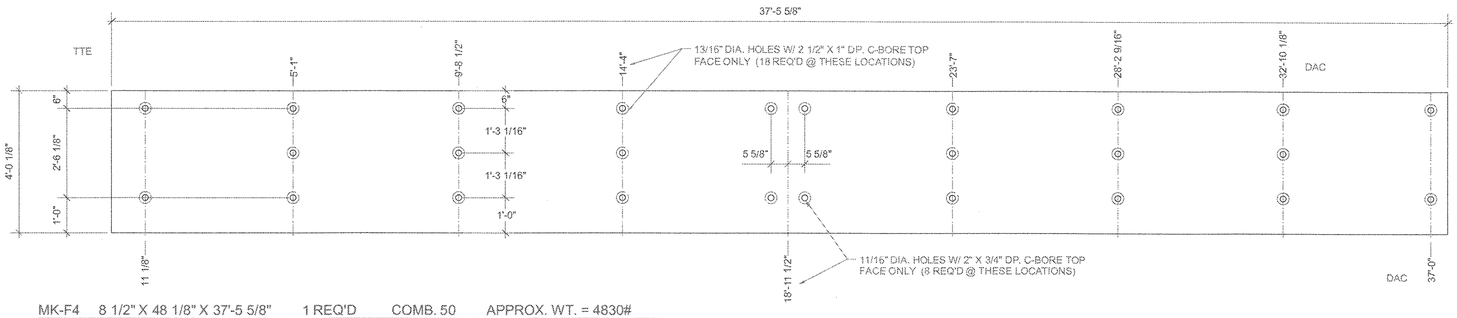



MK-F4 8 1/2" X 48 1/8" X 37'-5 5/8" 1 REQ'D COMB. 50 APPROX. WT. = 4830#

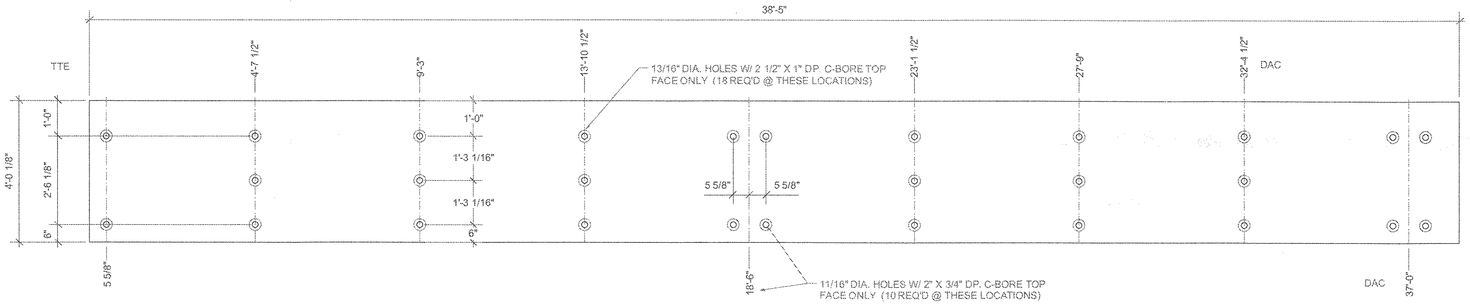


MK-F9 8 1/2" X 49 1/8" X 38'-5" 1 REQ'D COMB. 50 APPROX. WT. = 4830#

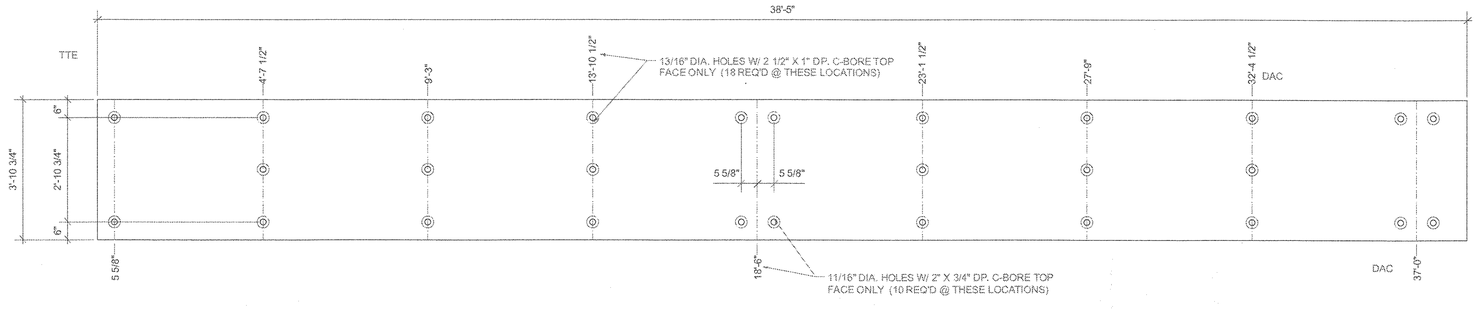


MK-F11 8 1/2" X 46 3/4" X 38'-5" 1 REQ'D COMB. 50 APPROX. WT. = 4600#

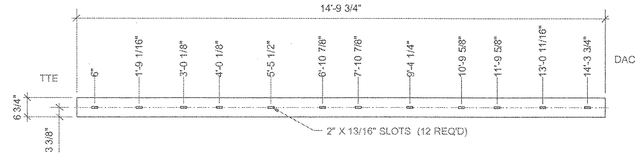


MK-ST1 6 3/4" X 5 1/2" X 14'-9 3/4" 24 REQ'D COMB. 50 APPROX. WT. = 172#

RECEIVED
CK'D BY EK OK'D BY KSY
JUL 2 7 2007
RESUBMIT ____ APPROVED ____
BY CPW DATE 7/31/07

LAMINATED CONCEPTS INC.
P.O. BOX 369
3310 STATE RTE 352
BIG FLATS, NEW YORK 14814
PHONE: 607.562.8110
FAX. 607.562.8105

| DRAWN | DATE |
|---|---|
| MSS | 6/4/07 |
| CHK'D | DATE |
| APP'D | DATE |
| SCALE | |

REVISIONS

| NO. | DATE | BY | REVISIONS |
|---|---|---|---|
| 1 | 7/17/07 | ss | revise panels |
| 2 | 7/24/07 | ss | revise panels |

PROJECT NAME
BHO-BTN 2005 (1) BRIDGE NO. 26
TOWNS OF NEW HAVEN AMD WEYBRIDGE
COUNTY OF ADDISON, VERMONT

PROJECT JOB NO.
2107-150-LT

PREPARED FOR
CCS CONSTRUCTORS, LLC
MORRISVILLE, VT

SHEET NO.
4 OF 4

069-GD

D.S. BROWN
*The D.S. Brown Company* • 300 East Cherry Street • North Baltimore, Ohio 45872-0158
Phone: (419) 257-3561 • General Fax: (419) 257-2200 • Engineering Fax: (419) 257-0332

# RFI

DATE: 10/19/07
**RFI #:** NCR-04

**FROM:** John Bettin
DS Brown Co
300 East Cherry Street
North Baltimore, Ohio 45872
jbettin@dsbrown.com

**TO:** Andy White
CCS Constructors
138 Munson Ave
Morrisville, VT 05661
awhite@contractorscraneservc.com

**Direct Dial:** 952-693-1099
**FAX:** 419-257-0332

**PHONE:**
**FAX:**

**REFERENCE:** New Haven-Weybridge
Non-Conformance to Post Base Plate

**DSB JOB #:** 20388-1206

**INFORMATION REQUESTED:**
**Ref. Attached sketch SK-NC04-01 & DSB shop drawing sheet 01**
A mistake was made to the length of the ¼" thick anchor plates 1a1 on assembly 1B shown on DSB shop drawing sheet 01. The length of these plates were inadvertently changed in BOM after the initial approval and we fabricated them to 1'-3" in lieu of the 1'-4" shown on the detail. Since the rods and holes were dimensionally worked off the center of the plate, unfortunately this error was not discovered until after they were fabricated and set to ship. Since the timing of this project has become critical we are asking for acceptance of the anchors as shown on attached sketch SK-NC04-01.

Please call if you have any questions.

- Thank You

**REPLY:** _____

**FROM:** _____

**The D.S. Brown Company**
300 E. Cherry Street
North Baltimore, Ohio 45872
419.257.3561
Fax: 419.257.2200
Engineering Fax: 419.257.0332
E-mail: dsb@dsbrown.com
www.dsbrown.com


**Chaska Operations**
4201 Norex Drive
Chaska, Minnesota 55318
952.368.3000
Fax: 952.448.7000

**International Division**
7 Temasek Boulevard
#16-03 Suntec Tower One
Singapore 038987
+65.333.0911
Fax: +65.333.0922
E-mail:
dsbrown@mbox2.singnet.com.sg

PDF created with pdfFactory trial version www.pdffactory.com

Approved
CPW
10/19/07

070-BR

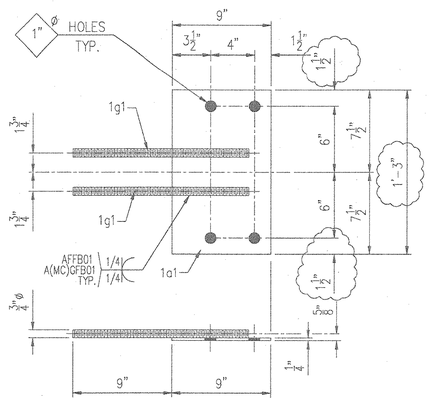



32 – ANCHORS – 1B

SHEET: SK–NC04–01

PDF created with pdfFactory trial version www.pdffactory.com

071-BR

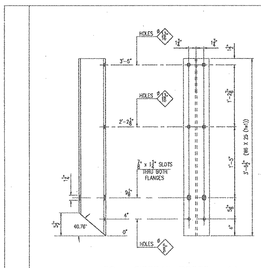
HOLES
5"
5"
5"

VERMONT

**State of Vermont**
**PDD/Structures Design Section**
One National Life Drive
Montpelier, VT 05633-5001
**www.aot.state.vt.us**

*Agency of Transportation*

[phone] 802-828-2621
[fax] 802-828-3566
[ttd] 800-253-0191

August 17, 2007

D. S. Brown Co.
300 E. Cherry Street
North Baltimore, OH 45872

**Re: New Haven – Weybridge BHO BTN 2005(1) – TH 7, Bridge 26**

The following Railing details (2 Tube and Lattice Railing) [Item #525.31, Bridge Railing, Galvanized 2 Rail Box Beam] for the above project (Vendor's Job #20388) that were received in this office on August 7, have been reviewed and are being returned herewith.

Sheets 2 and 3 for the 2 Tube Railing are approved as noted. Please see comments in red on these sheets. All other sheets and the weld procedures are approved.

There shall be no fabrication done until all drawings and welding procedures are approved. You must provide written notice to this office as to the date fabrication represented by these drawings will begin. That notice must be received at least seven days prior to that date, as per Specification 506.03. Any material fabricated prior to the notification date is subject to rejection without further cause.

Sincerely,

Christopher P. Williams, P.E.
Structures Project Manager

Attachments

cc: [ X ] Dale Norton – Resident Engineer
[ X ] CCS Constructors - Contractor
[ X ] Steel Inspector – Jeff Clark
[ X ] Construction Section - letter only
[ X ] Materials & Research (C&IA Unit) - letter only
[ X ] Project Files

073-BR

VTrans Working to Get You There

DSBROWN

# Production Joint Welding Procedure Specification (D1.5-02)

Procedure No: A-(MC)GB--122 Date Issued: 11-30-04 Revision No: 0 Rev. Date: ____

Contractor (Fabricator) D. S. Brown Company Prepared by: James R. Connor, Quality Assurance Manager

2. Qualified in accordance with: AWS D1.5- 2002 (5.12.1)
   Referenced PQR No(s). PQR-(MC)GMAW-01(04) __ , __ , ____
   Referenced FWST No(s). N/A , N/A , __ , __
3. Material specification(s) ASTM A709 Gr. 36, 50, 50W, A500B Tube
4. Material Thickness (es) Unlimited
5. Welding process GMAW
6. Manual [ ] , machine [ ] , or semiautomatic [X]
7. Position(s) of welding 1G
8. Filler metal specification AWS A5.18
9. Filler metal class and brand name E70C-6M Corex Metal-Core Maxim
10. Flux class & brand N/A , Type N/A
11. Shielding gas 75% Ar / 25% CO2 Flow rate 45 CFH
12. Single pass [X] Or multiple pass [X]
13. Single arc [X] Or multiple arc [ ]
14. Welding Current DCEP
15. Polarity Reverse
16. Welding progression stringers
17. Root treatment Clean to bright sound metal or per AWS D1.5 (3.2.1 & 3.11)
18. Postheat treatment N/A
19. Calculated Heat Input (KJ/In) Min 30.6 Kj/in Max 51.1 Kj/in
20. Electrode extension (electrical stickout) 3/4"

For DOT Approval


VTRANS RECEIVED
OK'D BY ____ OK'D BY JWC
JUN 2 1 2007
RESUBMIT ____ APPROVED ✓
BY DATE 7-23-07

| Weld size (In) | Pass No(s). | Electrode Size (In) | Welding Process Variables AMPS/WFS* | VOLTS | Travel Speed (IPM) |
|---|---|---|---|---|---|
| CJP | ALL | .052" | 265-320 | 31-34.5 | 13-16 |

**DO NOT REMOVE BACKING FROM TUBE SPLICES**

CCS Constructors LLC
138 Munson Avenue
Morrisville, VT 05661
Ph: 802-888-7701 f: 802-888-4746

Joint Detail (Groove)
Show all dimensions, weld sizes, passes, and AWS symbols

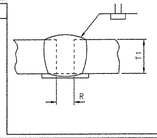


**Notes:**
**$T_1$ = 3/8"(10mm) MAX**
**R = 1/8" (3mm) MIN T1 MAX**

* Wire feed speed may be used along with amperage (include chart)

Prepared By: James R. Connor DSB QA Manager

Project: Route No. TH 7/11, CL3

DSB Job: 20388-1206

| Preheat and Interpass Temperature Chart | | |
|---|---|---|
| Base Metal Thickness range | Minimum Preheat (°F) | Max Preheat & Interpass (°F) |
| ≤ 3/4" | 50°F | 450°F |
| >3/4" to ≤1.5" | 70°F | 450°F |
| >1.5" to ≤2.5" | 150°F | 450°F |
| >2.5" | 225°F | 450°F |

Note: When this procedure is used for A709Gr50W materials, it shall be limited to 5/16" single pass or material be coated.

074-BRWP

DSBROWN

# Production Joint Welding Procedure Specification (D1.5-02)

Procedure No: **A-(MC)GFB-01** Date Issued: 8-14-06 Revision No: 0 Rev. Date: _____

Contractor (Fabricator) D. S. Brown Company Prepared by: James R. Connor, Quality Assurance Manager


1. Non-Fracture Critical [X] Fracture Critical [ ] WPS Expiration Date: _____
2. Qualified in accordance with: AWS D1.5- 2002 (5.12.1)
   Referenced PQR No(s). PQR-(MC)GMAW-01(04) __ , __ , ____
   Referenced FWST No(s). PQR-(MC)GMAW-FWST-01A(04) , PQR-(MC)GMAW-FWST-01B(04) , __ , __
3. Material specification(s) ASTM A709 Gr. 36, 50, 50W, CF1018, CF1040, A615
4. Material Thickness (es) Unlimited
5. Welding process GMAW
6. Manual [ ] , machine [ ] , or semiautomatic [X]
7. Position(s) of welding 1G, 2G
8. Filler metal specification AWS A5.18
9. Filler metal class and brand name E70C-6M Corex Metal-Core Maxim
10. Flux class & brand N/A , Type N/A
11. Shielding gas 75% Ar / 25% CO2 Flow rate 45 CFH
12. Single pass [X] Or multiple pass [X]
13. Single arc [X] Or multiple arc [ ]
14. Welding Current DCEP
15. Polarity Reverse
16. Welding progression stringers
17. Root treatment Clean to bright sound metal or per AWS D1.5 (3.2.1 & 3.11)
18. Postheat treatment N/A
19. Calculated Heat Input (KJ/In) Min 30.6 Kj/in Max 51.1 Kj/in
20. Electrode extension (electrical stickout) 3/4"

For DOT Approval

VTRANS
RECEIVED
CK'D BY _____ OK'D BY JH
JUN 2 1 2007
RESUBMIT _____ APPROVED V
BY _____ DATE 7-23-07

| Weld Size (in) | Pass No(s). | Electrode Size (in) | Welding Process Variables AMPS/WFS* | VOLTS | Travel Speed (IPM) |
|---|---|---|---|---|---|
| **1/4" | 1 | .052" | 265-320 | 31-34.5 | 13-16 |
| 5/16" | 1 | .052" | 265-320 | 31-34.5 | 13-16 |
| 3/8" | 1-3 | .052" | 265-320 | 31-34.5 | 13-16 |
| 7/16" | 2-4 | .052" | 265-320 | 31-34.5 | 13-16 |
| 1/2" | 4-6 | .052" | 265-320 | 31-34.5 | 13-16 |
| 5/8" | 5-7 | .052" | 265-320 | 31-34.5 | 13-16 |
| 3/4" | 6-8 | .052" | 265-320 | 31-34.5 | 13-16 |

Joint Detail (Flare Bevel)
Show all dimensions, weld sizes, passes, and AWS symbols

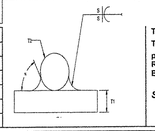


$T_1$ = UNLIMITED
$T_2$ = RB (Type and Dia. per dwg.)
R = 0
Bevel = NATURAL

*S = WELD SIZE*

* Wire feed speed may be used along with amperage (include chart)

Prepared By: James R Connor DSB QA Manager

Project: Route No. TH 7/11, CL3

DSB Job: 20388-1206

Preheat and Interpass Temperature Chart

| Base Metal Thickness range | Minimum Preheat (°F) | Max Preheat & Interpass (°F) |
|---|---|---|
| ≤ 3/4" | 50°F | 450°F |
| >3/4" to ≤1.5" | 70°F | 450°F |
| >1.5" to ≤2.5" | 150°F | 450°F |
| >2.5" | 225°F | 450°F |

Note: When this procedure is used for A709Gr50W materials, it shall be limited to 5/16" single pass or material be coated.

075-BRWP

DSBROWN

# Production Joint Welding Procedure Specification (D1.1-04)

Procedure No: **A-(MC)GSB-11(AK)** Date Issued: 12-7-04 Revision No: 0 Rev. Date: _____

Contractor (Fabricator) D. S. Brown Company Prepared by: James R. Connor, Quality Assurance Manager


1. Non-Fracture Critical [X] Fracture Critical [ ] WPS Expiration Date: _____
2. Qualified in accordance with: AWS D1.1- 2004
   Referenced PQR No(s). PQR-(MC)GMAW-01(04) __ , __ , ____
   Referenced FWST No(s). PQR-(MC)GMAW-FWST-01A(04) , PQR-(MC)GMAW-FWST-01B(04) , __ , __
3. Material specification(s) ASTM A709 Gr. 36, 50, 50W, ASTM A500B,A53 pipe
4. Material Thickness (es) Unlimited
5. Welding process GMAW
6. Manual [ ] , machine [ ] , or semiautomatic [X]
7. Position(s) of welding 1G, 2G, 1F, 2F
8. Filler metal specification AWS A5.18
9. Filler metal class and brand name E70C-6M Corex Metal-Core Maxim
10. Flux class & brand N/A , Type N/A
11. Shielding gas 75% Ar / 25% CO2 Flow rate 45 CFH
12. Single pass [X] Or multiple pass [X]
13. Single arc [X] Or multiple arc [ ]
14. Welding Current DCEP
15. Polarity Reverse
16. Welding progression stringers
17. Root treatment Clean to bright sound metal or per AWS D1.1
18. Postheat treatment N/A
19. Calculated Heat Input (KJ/In) Min 30.6 Kj/in Max 51.1 Kj/in
20. Electrode extension (electrical stickout) 3/4"

For DOT Approval

RECEIVED
JUN 2 1 2007
CK'D BY _____ CK'D BY _____
RESUBMIT _____ APPROVED
BY DATE 7-23-07

| Leg Size (S) (In) | Weld Pass No(s). | Electrod e Size (In) | Welding Process Variables AMPS/WFS* | VOLTS | Travel Speed (IPM) |
|---|---|---|---|---|---|
| 1/4" | 1 | .052" | 265-320 | 31-34.5 | 13-16 |
| 5/16" | 1 | .052" | 265-320 | 31-34.5 | 13-16 |
| 3/8" | 1-2 | .052" | 265-320 | 31-34.5 | 13-16 |
| 1/2" | 3-4 | .052" | 265-320 | 31-34.5 | 13-16 |
| 5/8" | 4-6 | .052" | 265-320 | 31-34.5 | 13-16 |
| 3/4" | 5-7 | .052" | 265-320 | 31-34.5 | 13-16 |
| 7/8" | 6-9 | .052" | 265-320 | 31-34.5 | 13-16 |
| 1" | 7-10 | .052" | 265-320 | 31-34.5 | 13-16 |

Joint Detail (TC-P4-GF)
Show all dimensions, weld sizes, passes, and AWS symbols

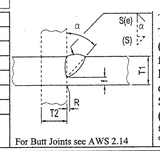


T1 = ¼" min.
T2 = Varies
(E) = S-1/8"
f = 1/8" min.
R = 0
α = 45°
S = size groove
(S) = size of reinforcing fillet(if required) not to exceed ¼" in corner & T jts.

For Butt Joints see AWS 2.14

* Wire feed speed may be used along with amperage (include chart)

Prepared By: James R. Connor DSB QA Manager

Project: Route No. TH 7/11, CL3

DSB Job: 20388-1206

Preheat and Interpass Temperature Chart

| Base Metal Thickness range | Minimum Preheat (°F) | Max Preheat & Interpass (°F) |
|---|---|---|
| ≤ 3/4" | 50°F | 450°F |
| >3/4" to ≤1.5" | 70°F | 450°F |
| >1.5" to ≤2.5" | 150°F | 450°F |
| >2.5" | 225°F | 450°F |

Note: When this procedure is used for A709Gr50W materials, it shall be limited to 5/16" single pass or material be coated.

076-BRWP

DSBROWN

# Production Joint Welding Procedure Specification (D1.5-02)

Procedure No: **A-FB-122** Date Issued: 11-24-03 Revision No: 0 Rev. Date: _____

Contractor (Fabricator) D. S. Brown Company Prepared by: James R. Connor, Quality Assurance Manager

1. Non-Fracture Critical [X] Fracture Critical [ ] WPS Expiration Date: _____
2. Qualified in accordance with: AWS D1.5- 2002 (5.12.1)
   Referenced PQR No(s). PQR-FCAW-01-03 __ , __ , _____
   Referenced FWST No(s). N/A , N/A , __ , _____
3. Material specification(s) ASTM A709 Gr. 36, 50, 50W, 500 B Tube
4. Material Thickness (es) Unlimited
5. Welding process FCAW
6. Manual [ ] , machine [ ] , or semiautomatic [X]
7. Position(s) of welding 1G
8. Filler metal specification AWS A5.20
9. Filler metal class and brand name E71T-1, Lincoln Outershield Elite)
10. Flux class & brand N/A , Type N/A
11. Shielding gas 100% CO2 Flow rate 45 CFH
12. Single pass [X] Or multiple pass [ ]
13. Single arc [X] Or multiple arc [ ]
14. Welding Current DCEP
15. Polarity Reverse
16. Welding progression Stringers
17. Root treatment Clean to bright sound metal or per AWS D1.5 (3.2.1 & 3.11)
18. Postheat treatment N/A
19. Calculated Heat Input (KJ/In) Min 31.20 Kj/in Max 50.72 Kj/in
20. Electrode extension (electrical stickout) 3/4"

For DOT Approval


VTRANS RECEIVED
CK'D BY _____ OK'D BY JW
JUN 2 1 2007
RESUBMIT _____ APPROVED ✓
BY _____ DATE 7-23-07

| Weld size (in) | Pass No(s). | Electrode Size (in) | Welding Process Variables: AMPS/WFS* | Welding Process Variables: VOLTS | Travel Speed (IPM) |
|---|---|---|---|---|---|
| CJP | All | 1/16" | 260-310 | 26-30 | 11-13 |

**DO NOT REMOVE BACKING FROM TUBE SPLICES**

Joint Detail (B-L1a-GF)

Show all dimensions, weld sizes, passes, and AWS symbols

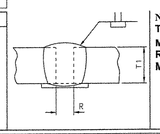


**Notes:**
**$T_1$ = 3/8"(10mm) MAX**
**R = 1/8" (3mm) MIN T1 MAX**

* Wire feed speed may be used along with amperage (include chart)

Prepared By: James R Connor DSB QA Manager

Project: Route No. TH 7/11, CL3

DSB Job: 20388-1206

Preheat and Interpass Temperature Chart

| Base Metal Thickness range | Minimum Preheat (°F) | Max Preheat & Interpass (°F) |
|---|---|---|
| ≤ 3/4" | 50°F | 450 °F |
| >3/4" to ≤1.5" | 70°F | 450 °F |
| >1.5" to ≤2.5" | 150°F | 450 °F |
| >2.5" | 225°F | 450 °F |

DSB BRWP

DSBROWN

# Production Joint Welding Procedure Specification (D1.5-02)

Procedure No: **A-FFB-01** Date Issued: 8-14-06 Revision No: 0 Rev. Date: _____

Contractor (Fabricator) D.S. Brown Company Prepared by: James R. Connor, Quality Assurance Manager

1. Non-Fracture Critical [X] Fracture Critical [ ] WPS Expiration Date: _____
2. Qualified in accordance with: AWS D1.5- 2002 (5.12.1)
   Referenced PQR No(s). PQR-FCAW-01-03 __ , __ , ____
   Referenced FWST No(s). PQR-FCAW-FWST-01(03) , PQR-FCAW-FWST-01A(03) , __ , ____
3. Material specification(s) ASTM A709 Gr. 36, 50, 50W, A500b to CF1018, CF1040, A615 (Rebar)
4. Material Thickness (es) Unlimited
5. Welding process FCAW
6. Manual [ ] , machine [ ] , or semiautomatic [X]
7. Position(s) of welding 1G,2G,1F, 2F
8. Filler metal specification AWS A5.20
9. Filler metal class and brand name E71T-1 Lincoln Outershield Elite)
10. Flux class & brand N/A , Type N/A
11. Shielding gas 100% CO2 Flow rate 45 CFH
12. Single pass [X] Or multiple pass [X]
13. Single arc [X] Or multiple arc [ ]
14. Welding Current DCEP
15. Polarity Reverse
16. Welding progression stringers
17. Root treatment Clean to bright sound metal or per AWS D1.5 (3.2.1 & 3.11)
18. Postheat treatment N/A
19. Calculated Heat Input (KJ/In) Min 31.20 Kj/in Max 50.72 Kj/in
20. Electrode extension (electrical stickout) 3/4"


For DOT Approval

VTRANS
RECEIVED
JUN 2 1 2007

CK'D BY _____ OK'D BY Steve
RESUBMIT _____ APPROVED _____
BY _____ DATE 7-23-07

| Weld size (In) | Pass No(s). | Electrode Size (In) | Welding Process Variables AMPS/WFS* | Welding Process Variables VOLTS | Travel Speed (IPM) |
|---|---|---|---|---|---|
| **1/4" | 1 | 1/16" | 260-310 | 26-30 | 11-13 |
| 5/16" | 1 | 1/16" | 260-310 | 26-30 | 11-13 |
| 3/8" | 2-3 | 1/16" | 260-310 | 26-30 | 11-13 |
| 7/16" | 3-5 | 1/16" | 260-310 | 26-30 | 11-13 |
| 1/2" | 4-6 | 1/16" | 260-310 | 26-30 | 11-13 |
| 5/8" | 5-7 | 1/16" | 260-310 | 26-30 | 11-13 |
| 3/4" | 6-8 | 1/16" | 260-310 | 26-30 | 11-13 |

Joint Detail (Flare Bevel)
Show all dimensions, weld sizes, passes, and AWS symbols

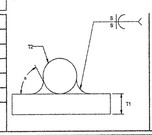


$T_1$ = UNLIMITED
$T_2$ = RB (Type and Dia. per dwg.)
R = 0 = NATURAL
*S = WELD SIZE*

* Wire feed speed may be used along with amperage (include chart)

Prepared By: James R. Connor DSB QA Manager

Project: Route No. TH 7/11, CL3

DSB Job: 20388-1206

Preheat and Interpass Temperature Chart

| Base Metal Thickness range | Minimum Preheat (°F) | Max Preheat & Interpass (°F) |
|---|---|---|
| ≤ 3/4" | 50°F | 450 °F |
| >3/4" to ≤1.5" | 70°F | 450 °F |
| >1.5" to ≤2.5" | 150°F | 450 °F |
| >2.5" | 225°F | 450 °F |

Note: When this procedure is used for A709Gr50W materials, it shall be limited to 5/16" single pass or material be coated.

078-BRWP

DSBROWN

# Production Joint Welding Procedure Specification (D1.5-02)

Procedure No: **A-FSB-13** Date Issued: 12-11-03 Revision No: 0 Rev. Date: _____

Contractor (Fabricator) D. S. Brown Company Prepared by: James R. Connor, Quality Assurance Manager

1. Non-Fracture Critical [X] Fracture Critical [ ] WPS Expiration Date: _____
2. Qualified in accordance with: AWS D1.5- 2002 (5.12.1)
   Referenced PQR No(s). PQR-FCAW-01-03 __ , __ , ____
   Referenced FWST No(s). PQR-FCAW-FWST-01(03) , PQR-FCAW-FWST-01A(03) , __ , __
3. Material specification(s) Gr. 36, 50, 50W, ASTM A500B
4. Material Thickness (es) Unlimited
5. Welding process FCAW
6. Manual [ ] , machine [ ] , or semiautomatic [X]
7. Position(s) of welding 1G, 2G,(1F,2F)
8. Filler metal specification AWS A5.20
9. Filler metal class and brand name E71T-1 (Lincoln Outershield Elite)
10. Flux class & brand N/A , Type N/A
11. Shielding gas 100% CO2 Flow rate 45 CFH
12. Single pass [X] Or multiple pass [X]
13. Single arc [X] Or multiple arc [ ]
14. Welding Current DCEP
15. Polarity Reverse
16. Welding progression Stringers
17. Root treatment Clean to bright sound metal or per AWS D1.5 (3.2.1 & 3.11)
18. Postheat treatment N/A
19. Calculated Heat Input (KJ/In) Min 31.20 Kj/in Max 50.72 Kj/in
20. Electrode extension (electrical stickout) 3/4"

For DOT Approval

VTRANS RECEIVED JUN 21 2007

GK'D BY _____ CK'D BY JWK


RESUBMIT _____ APPROVED ✓

BY _____ DATE 7-23-07

| Weld size (E)(Ac(S) | Pass No(s). | Electrode Size (In) | Welding Process Variables AMPS/WFS* | VOLTS | Travel Speed (IPM) |
|---|---|---|---|---|---|
| 1/4" | 1 | 1/16" | 260-310 | 26-30 | 11-13 |
| 5/16" | 1 | 1/16" | 260-310 | 26-30 | 11-13 |
| 3/8" | 2-3 | 1/16" | 260-310 | 26-30 | 11-13 |
| 1/2" | 3-4 | 1/16" | 260-310 | 26-30 | 11-13 |
| 5/8" | 4-6 | 1/16" | 260-310 | 26-30 | 11-13 |
| 3/4" | 5-7 | 1/16" | 260-310 | 26-30 | 11-13 |
| 7/8" | 6-8 | 1/16" | 260-310 | 26-30 | 11-13 |
| 1" | 7-9 | 1/16" | 260-310 | 26-30 | 11-13 |

Joint Detail (TC-P4-GF)

Show all dimensions, weld sizes, passes, and AWS symbols

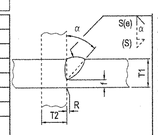


T1 = ¼" min.
T2 = Varies
(E) = S-1/8"
f = 1/8" min.
R = 0
α = 45°
S = size groove
(S) = size of reinforcing fillet(if required) not to exceed ¼" in corner & T jts.

For Butt Joints see AWS 2.14

* Wire feed speed may be used along with amperage (include chart)

Prepared By: James R. Connor DSB QA Manager

Project: Route No. TH 7/11, CL3

DSB Job: 20388-1206

Preheat and Interpass Temperature Chart

| Base Metal Thickness range | Minimum Preheat (°F) | Max Preheat & Interpass (°F) |
|---|---|---|
| ≤ 3/4" | 50°F | 450 °F |
| >3/4" to ≤1.5" | 70°F | 450 °F |
| >1.5" to ≤2.5" | 150°F | 450 °F |
| >2.5" | 225°F | 450 °F |

Note: When this procedure is used for A709Gr50W materials, it shall be limited to 5/16" single pass or material be coated.

079-BRWP

DSBROWN

# Production Joint Welding Procedure Specification (D1.5-02)

Procedure No: A-(MC)GSB-01 Date Issued: 9-28-04 Revition No: 0 Rev. Date: _____

Contractor (Fabricator) D. S. Brown Company Prepared by: James R. Connor, Quality Assurance Manager

1. Non-Fracture Critical [X] Fracture Critical [ ] WPS Expiration Date: _____
2. Qualified in accordance with: AWS D1.5- 2002 (5.12.1)
   Referenced PQR No(s). PQR-(MC)GMAW-01(04) __ , __ , ____
   Referenced FWST No(s). PQR-(MC)GMAW-FWST-01A(04) , PQR-(MC)GMAW-FWST-01B(04) , __ , __
3. Material specification(s) ASTM A709 Gr. 36, 50, 50W
4. Material Thickness (es) Unlimited
5. Welding process GMAW
6. Manual [ ] , machine [ ] , or semiautomatic [X]
7. Position(s) of welding 1G, 2G, 1F, 2F
8. Filler metal specification AWS A5.18
9. Filler metal class and brand name E70C-6M Corex Metal-Core Maxim
10. Flux class & brand N/A , Type N/A
11. Shielding gas 75% Ar / 25% CO2 Flow rate 45 CFH
12. Single pass [X] Or multiple pass [X]
13. Single arc [X] Or multiple arc [ ]
14. Welding Current DCEP
15. Polarity Reverse
16. Welding progression stringers
17. Root treatment Clean to bright sound metal or per AWS D1.5 (3.2.1 & 3.11)
18. Postheat treatment N/A
19. Calculated Heat Input (KJ/In) Min 30.6 Kj/in Max 51.1 Kj/in
20. Electrode extension (electrical stickout) 3/4"

For DOT Approval

VTRANS RECEIVED

CK'D BY _____ OK'D BY JSC


AUG 1 4 2007

RESUBMIT _____ APPROVED ✓

BY DATE 8-15-07

| Base Metal Thickness (inches) | Weld Pass No(s). | Electrode Size (in) | Welding Process Variables AMPS/WFS* | VOLTS | Travel Speed (IPM) |
|---|---|---|---|---|---|
| 1/4" | 1 | .052" | 265-320 | 31-34.5 | 13-16 |
| 5/16" | 1 | .052" | 265-320 | 31-34.5 | 13-16 |
| 3/8" | 1-2 | .052" | 265-320 | 31-34.5 | 13-16 |
| 1/2" | 3-4 | .052" | 265-320 | 31-34.5 | 13-16 |
| 5/8" | 4-6 | .052" | 265-320 | 31-34.5 | 13-16 |
| 3/4" | 5-7 | .052" | 265-320 | 31-34.5 | 13-16 |
| 7/8" | 6-9 | .052" | 265-320 | 31-34.5 | 13-16 |
| 1" | 7-10 | .052" | 265-320 | 31-34.5 | 13-16 |

Joint Detail (TC-P4-GF)
Show all dimensions, weld sizes, passes, and AWS symbols

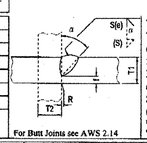


T1 = ¼" min.
T2 = Varies
(E) = S-1/8"
f = 1/8" min.
R = 0
α = 45°
S = size groove
(S) = size of reinforcing fillet(if required) not to exceed ⅛" in corner & T jts.

For Butt Joints see AWS 2.14

* Wire feed speed may be used along with amperage (include chart)

Prepared By: James R. Connor DSB QA Manager

Project: _____

DSB Job: 20388-1206

Preheat and Interpass Temperature Chart

| Base Metal Thickness range | Minimum Preheat (°F) | Max Preheat & Interpass (°F) |
|---|---|---|
| ≤ 3/4" | 50°F | 450°F |
| >3/4" to ≤1.5" | 70°F | 450°F |
| >1.5" to ≤2.5" | 150°F | 450°F |
| >2.5" | 225°F | 450°F |

Note: When this procedure is used for A709Gr50W materials, it shall be limited to 5/16" single pass or material be coated.

D80-BRWP

DSBROWN

# Production Joint Welding Procedure Specification (D1.5-02)

Procedure No: **A-FSB-01** Date Issued: 8-12-03 Revision No: 0 Rev. Date: ____

Contractor (Fabricator) D. S. Brown Company Prepared by: James R. Connor, Quality Assurance Manager


1. Non-Fracture Critical [X] Fracture Critical [ ] WPS Expiration Date: ____
2. Qualified in accordance with: AWS D1.5- 2002 (5.12.1)
   Referenced PQR No(s). PQR-FCAW-01-03 , __ , __
   Referenced FWST No(s). PQR-FCAW-FWST-01(03) , PQR-FCAW-FWST-01A(03) , __ , __
3. Material specification(s) ASTM A709 Gr. 36, 50, 50W
4. Material Thickness (es) Unlimited
5. Welding process FCAW
6. Manual [ ] , machine [ ] , or semiautomatic [X]
7. Position(s) of welding 1G, 2G,(1F,2F)
8. Filler metal specification AWS A5.20
9. Filler metal class and brand name E71T-1, E71T-9 Lincoln Outershield Elite)
10. Flux class & brand N/A , Type N/A
11. Shielding gas 100% CO2 Flow rate 45 CFH
12. Single pass [X] Or multiple pass [X]
13. Single arc [X] Or multiple arc [ ]
14. Welding Current DCEP
15. Polarity Reverse
16. Welding progression Stringers
17. Root treatment Clean to bright sound metal or per AWS D1.5 (3.2.1 & 3.11)
18. Postheat treatment N/A
19. Calculated Heat Input (KJ/In) Min 31.20 Kj/in Max 50.72 Kj/in
20. Electrode extension (electrical stickout) 3/4"

**For DOT Approval**

VTRANS RECEIVED
CK'D BY ____ OK'D BY ____
AUG 14 2007
RESUBMIT ____ APPROVED ____
BY ____ DATE 8-15-07

| Weld Size (in) (S)(a) | Pass (No) | Electrode Size (in) | Welding Process Variables AMPS/WFS* | VOLTS | Travel Speed (IPM) |
|---|---|---|---|---|---|
| 1/4" | 1 | 1/16" | 260-310 | 26-30 | 11-13 |
| 5/16" | 1 | 1/16" | 260-310 | 26-30 | 11-13 |
| 3/8" | 2-3 | 1/16" | 260-310 | 26-30 | 11-13 |
| 1/2" | 3-4 | 1/16" | 260-310 | 26-30 | 11-13 |
| 5/8" | 4-6 | 1/16" | 260-310 | 26-30 | 11-13 |
| 3/4" | 5-7 | 1/16" | 260-310 | 26-30 | 11-13 |
| 7/8" | 6-8 | 1/16" | 260-310 | 26-30 | 11-13 |
| 1" | 7-9 | 1/16" | 260-310 | 26-30 | 11-13 |

Joint Detail (TC-P4-GF)
Show all dimensions, weld sizes, passes, and AWS symbols

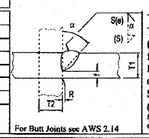


T1 = ¼" min.
T2 = Varies
(E) = S-1/8"
f = 1/8" min.
R = 0
α = 45°
S = size groove
(S) = size of reinforcing fillet(if required) not to exceed ¼" in corner & T jts.

For Butt Joints see AWS 2.14

* Wire feed speed may be used along with amperage (include chart)

Prepared By: James R Connor DSB QA Manager

Project: ____

DSB Job: 20388-1206

| Preheat and Interpass Temperature Chart | | |
|---|---|---|
| Base Metal Thickness range | Minimum Preheat (°F) | Max Preheat & Interpass (°F) |
| ≤ 3/4" | 50°F | 450°F |
| >3/4" to <1.5" | 70°F | 450°F |
| >1.5" to ≤2.5" | 150°F | 450°F |
| >2.5" | 225°F | 450°F |

Note: When this procedure is used for A709Gr50W materials, it shall be limited to 5/16" single pass or material be coated.

OSY-BRWP

## GENERAL NOTES:

1.) MATERIALS AND WORKMANSHIP SHALL IN ACCORDANCE WITH THE STATE OF VERMONT AGENCY OF TRANSPORTATION "STANDARD SPECIFICATIONS FOR CONSTRUCTION, DATED 2006" AS AMMENDED BY THE LATEST REVISIONS, THE AASHTO STANDARD SPECIFICATIONS FOR HIGHWAY CONSTRUCTION, SEVENTEENTH EDITION.

2.) FABRICATION SHALL BE PERFORMED IN ACCORDANCE WITH AASHTO STANDARD SPECIFICATIONS FOR HIGHWAY CONSTRUCTION, ANSI/AASHTO/AWS D1.5 AND THE CURRENT INTERIM SPECIFICATIONS AS MODIFIED BY VTRANS SPEC. 506.03.

3.) RAILING MATERIALS SHALL BE ASTM A709 GR 50, UNLESS NOTED OTHERWISE.
PER VTRANS SPECIFICATION 732.02(a), (W6 X 25 POSTS SHALL BE CVN TESTED PER 25 FT. LBS. @ 40°F). ⚠
- HOLLOW STRUCTURAL SHAPES TO CONFORM WITH ASTM A500, GRADE B IN ACCORDANCE WITH VTRANS SPECIFICATION 732.03(a), (HSS SHALL BE CVN TESTED PER 15 FT. LBS. @ 40°F). ⚠
- PIPE SHALL BE ASTM A53, GRADE B.
- HARDWARE TO BE IN ACCORDANCE WITH ASTM F568M, CLASS 4.6 (ASTM A307), U.N.O.
- HIGH STRENGTH HARDWARE SHALL BE IN ACCORDANCE WITH AASHTO M164 TYPE 1 (ASTM A325) OR (ASTM 449) AND SHALL BE SUPPLIED IN ACCORDANCE TO VTRANS SPEC. 714.05. WHICH INCLUDES ROCAP, PROOF AND WEDGE TESTING.
- THREADED ROD FOR POST ANCHORAGE SHALL SHALL CONFORM TO ASTM F 1554 GRADE 55 "WELDABLE STEEL".

4.) ALL HARDWARE SHALL BE GALVANIZED IN ACCORDANCE WITH AASHTO M-232 (ASTM A-153)..

5.) RAILING COMPONENTS SHALL BE GALVANIZED IN ACCORDANCE WITH AASHTO M-111 (ASTM A123), UNLESS NOTED OTHERWISE. RADIUS ALL EDGES 1/16" AND BLAST CLEAN PER SSPC-SP 6 PRIOR TO GALVANIZING AND REPAIR GALVANIZING PER ASTM A780.

6.) FABRICATION SHALL TAKE PLACE IN A FACILITY WITH A MINIMUM AISC CATEGORY III CERTIFICATION OR BE APPROVED BY VTRANS. NON-CERTIFIED FACILITIES MUST SATISFY THE REQUIREMENTS OF VTRANS SPEC. 506.03

THE CONTRACTOR SHALL VERIFY ALL DIMENSIONS PRIOR TO FABRICATION TO ENSURE ACCURACY OF DESIGN PLANS. STAMPED APPROVED DRAWINGS ASSUME DIMENSIONS HAVE BEEN VERIFIED BY CONTRACTOR.




32 – SIDERAIL POSTS – 1A




32 – ANCHORS – 1B




36 – INSERTS – 1H




32 – PLATE WASHERS – 1C




OPTIONAL TUBE SHOP SPLICE

| MK | QTY. | DESCRIPTION | MATERIAL | LENGTH | REMARKS | PART NO. |
|---|---|---|---|---|---|---|
| ⚠ 1A | 32 | SIDERAIL POSTS | | | 3'-6 1/2" | |
| 1w1 | 32 | W6X25 | A709 GR 50 OR A992 | 5'-6 1/2 | SHAPE CUT, A123-HDG, CVN | |
| 1B | 32 | ANCHORS | | | | |
| 1g1 | 32 | 1/4 X 9 | A709 GR 50 | 1'-3 | A123-HDG | |
| 1a1 | 64 | 1¼ X 1 1/8 THREADED ROD | F1554 GR 55 | | WELDABLE STEEL, A153-HDG | |
| 1C | 32 | PLATE WASHERS | | | 0'-6" | |
| 1c1 | 32 | 1/4 X 2 | A709 GR 50 | 0'-6 | A123-HDG | |
| 1H | 36 | INSERTS | | | 1'-8" | |
| 1h1 | 72 | 5/8ø HEX NUT | A563 GR A | | TAPPED OVERSIZED, PLAIN, NONE | |
| 1s1 | 36 | HSS 3 X 2 X 5/16 | A500 GR B | 1'-8 | (1E) CRIMP, WELD TO TUBE 1H2, A123-HDG | |
| 1B1 | 135 | HEX NUTS | | | | |
| 1b1 | 135 | 1¼ø HEX NUT | A563 GR A | | (1B), FOR POST ANCHORAGE, A153-HDG | |
| 1b2 | 70 | 1¼ø FLAT WASHER | F844 | | (1B4), FOR POST ANCHORAGE, A153-HDG | |
| 1F1 | 140 | HEX BOLTS | | | | |
| 1f1 | 140 | 5/8ø X 11 HEX HEAD CAP SCREW | A325 OR A449 | | (1D), 3.5" THREAD MIN., A153-HDG, ROCAP | |
| 1F2 | 140 | FLAT WASHERS | | | | |
| 1f2 | 140 | 5/8ø FLAT WASHER | F436 | | (1D2), A153-HDG, ROCAP | |
| 1F3 | 140 | MALLEABLE IRON WASHERS | | | | |
| 1f3 | 140 | 7/8 X 3 SQ WASHER PLATE | - | | (1E) WELD TO 1S1, 1H1 AND 1H2, A153-HDG | |
| 1F4 | 140 | HEX NUTS | | | | |
| 1f4 | 140 | 7/8ø HEX NUT | A563 DH | | (1D2), A153-HDG, ROCAP | |
| 1h2 | 80 | HEX BOLTS | | | | |
| 1h2 | 80 | 5/8ø X 11 1/4 HEX HEAD CAP SCREW | A307 GR A | | (2), INSERT HARDWARE, A153-HDG | |
| 1h3 | 80 | HEX BOLTS | | | | |
| 1h3 | 80 | 5/8ø X 11 1/4 HEX HEAD CAP SCREW | A307 GR A | | (2), INSERT HARDWARE, A153-HDG | |
| 1H4 | 1500 | FLAT WASHERS | | | | |
| 1h4 | 1500 | 5/8ø FLAT WASHER | F844 | | (1A2) INSERT HARDWARE, A153-HDG | |
| ⚠ 1H5 | 36 | PIPE SPACERS | | | | |
| 1h5 | 36 | 3/4" X 3/4 | A53 SCH 40 | 0'-0 1/2 | (1A) INSERT HARDWARE, A123-HDG | |
| 1W1 | 1140 | PEAL BOLTS | | | | |
| 1w1 | 1140 | 3/4 X 2 1/2 SLOTTED ROUND HEAD BOLT | A307 GR A | | (1B), 1 3/4" THREAD, A153-HDG, NONE | |
| 1W2 | 1140 | FLAT WASHERS | | | | |
| 1w2 | 1140 | 7/16ø FLAT WASHER | F844 | | (1B5), A153-HDG, NONE | |
| 1W3 | 1140 | LOCK NUT | | | | |
| 1w3 | 1140 | 5/16ø HEX NUT | A563-A LOCK NUT | | (1B6) LOCK NUT, A153-HDG, NONE | |
| 1P1 | 70 | FLAG SCREWS | | | | |
| 1p1 | 70 | 3/8 X 1 HEX HEAD CAP SCREW | A307 GR A | | (1B2), USE SAME PER WASHER (1B2), A153-HDG | |
| 1P2 | 70 | LOCK WASHERS | | | | |
| 1p2 | 70 | 11/2ø LOCK WASHER | F844 | | (1B) USE UNDER PER WASHER (1B2), A153-HDG | |
| ⚠ 1T1 | 2350 | LATHE BOLTS | | | | |
| 1t1 | 2350 | 3/8 X 1 1/2 SLOTTED ROUND HEAD BOLT | A307 GR A | | (2W) FULL THREAD, A153-HDG, NONE | |
| ⚠ 1T2 | 2350 | FLAT WASHERS | | | | |
| 1t2 | 2350 | 3/8ø FLAT WASHER | F844 | | (2TA), A153-HDG | |

NOTE: ALL MATERIAL SPECIFICATION DESIGNATIONS ARE ASTM, UNLESS OTHERWISE NOTED.

RECEIVED
CK'D BY ELK CK'D BY RSH
AUG 07 2007
RESUBMIT ____ APPROVED ✓
BY CPW DATE 8/17/07

STRUCTURE COPY

| REV | DESCRIPTION | DATE | DET | CKD |
|---|---|---|---|---|
| ⚠ | PER APPROVAL | 7/20/07 | JEB | TSF |

| ITEM | QUANTITY |
|---|---|
| – | – |
| – | – |
| – | – |
| – | – |
| – | – |
| – | – |
| – | – |
| – | – |

THE D.S. BROWN COMPANY
300 E. SHERRY STREET
NORTH BALTIMORE, OHIO 45872
419.257.3306
FAX: 419.257.3332
WWW.DSBROWN.COM


LOCATION – TOWNS OF NEW HAVEN & WEYBRIDGE
BRIDGE – 28
PROJECT – ROUTE NO. 17-1/11, CL3
F.A.P. NO. – BHO-BTN 2005(1)
P.O. NO. – –
DESIGNER – VERMONT DEPARTMENT OF TRANSPORTATION
CUSTOMER – CONTRACTORS CRANE SERVICE, LLC


DESCRIPTION: POST DETAILS & GENERAL NOTES
ADDISON COUNTY, VT


| SCALE | DRAWN BY | DESIGNED BY | DATE |
|---|---|---|---|
| N.T.S. | JEB | TSF | 6/15/07 |


| PROJECT NUMBER | PROJECT NO. | PHASE | SHEET |
|---|---|---|---|
| 20388 | 1206 | 1 | 01 |

082-BR

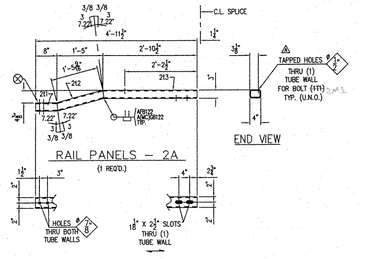

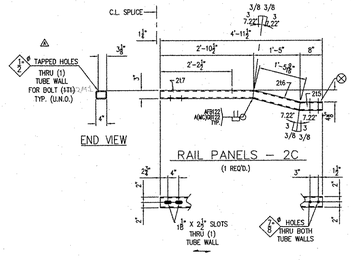
| MK | QTY | DESCRIPTION | MATERIAL | LENGTH | REMARKS | PART NO. |
|---|---|---|---|---|---|---|
| 2A | 1 | RAIL PANEL | | | 4'-11 1/2" | |
| 211 | 1 | HSS 4 X 3 X 5/16 | A500 GR B | 8'-8 3/8 | SHAPE CUT; A123-HDG, CWN | |
| 212 | 1 | HSS 4 X 3 X 5/16 | A500 GR B | 1'-3 15/16 | SHAPE CUT; A123-HDG, CWN | |
| 213 | 1 | HSS 4 X 3 X 5/16 | A500 GR B | 2'-10 1/2 | SHAPE CUT; A123-HDG, CWN | |
| 2B | 1 | RAIL PANEL | | | 4'-11 1/2" | |
| 214 | 1 | HSS 4 X 3 X 5/16 | A500 GR B | 4'-11 1/2 | A123-HDG, CWN | |
| 2C | 1 | RAIL PANEL | | | 4'-11 1/2" | |
| 215 | 1 | HSS 4 X 3 X 5/16 | A500 GR B | 8'-8 3/8 | SHAPE CUT; A123-HDG, CWN | |
| 216 | 1 | HSS 4 X 3 X 5/16 | A500 GR B | 1'-3 15/16 | SHAPE CUT; A123-HDG, CWN | |
| 217 | 1 | HSS 4 X 3 X 5/16 | A500 GR B | 2'-10 1/2 | SHAPE CUT; A123-HDG, CWN | |
| 2D | 1 | RAIL PANEL | | | 4'-11 1/2" | |
| 218 | 1 | HSS 4 X 3 X 5/16 | A500 GR B | 4'-11 1/2 | A123-HDG, CWN | |
| ⚠2 | 211 | 16 PLATE WASHERS | | | SEE ⑧ | |
| 2H | 16 | 1/4 X 3 | A709 GR 50 | 8"-8 | A123-HDG | |
| ⚠2 | 201 | 8 PLATE WASHERS | | | SEE ⑧ | |
| 2H1 | 8 | 3/8 X 3 | A709 GR 50 | 8"-3 | A123-HDG | |
| 2H1 | 10 | FIELD BOLT | | | | |
| 2H1 | 10 | M13 X 50 | A307 GR A | | (8), A153-HDG | |
| 2H1 | 10 | FIELD BOLT | | | | |
| 2H1 | 10 | 1"Ø FLAT WASHER | F844 | | (8), A153-HDG | |
| 2H1 | 10 | FIELD BOLT | | | | |
| 2H1 | 10 | 1"Ø | MASS GR B SCH 40 | 8'-0 1/2 | (8), A123-HDG | |

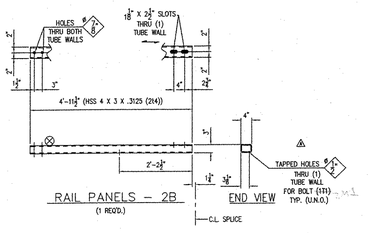NOTE: ALL MATERIAL SPECIFICATION DESIGNATIONS ARE ASTM, UNLESS OTHERWISE NOTED.

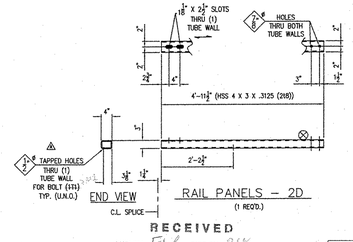


⚠ 16 – PLATE WASHERS – 2F1




8 – PLATE WASHERS – 2G1

– SEE SHEET NO. 1 FOR GENERAL NOTES

| REV. | DESCRIPTION | DATE | DET. | CKD. |
|---|---|---|---|---|
| ⚠2 | PER APPROVAL | 7/20/07 | KJB | TSF |

RECEIVED
CK'D BY EEK OK'D BY RSW
AUG 07 2007
RESUBMIT ____ APPROVED ____
BY CPW DATE 8/17/07

SHOP NOTE:
⊗ – INDICATES LOCATION OF SHIPPING PIECE MARK


THE D.S. BROWN COMPANY
300 E. SUPERIOR STREET
NORTH BALTIMORE, OHIO 45872
419.257.3561
FAX: 419.257.3332
WWW.DSBROWN.COM



| | ITEM | QUANTITY |
|---|---|---|
| LOCATION – TOWNS OF NEW HAVEN & WEYBRIDGE | – | – |
| BRIDGE – 26 | – | – |
| PROJECT – ROUTE NO. 7A17/11, CL3 | – | – |
| F.A.P. NO. – BHO-BTN 2005(1) | – | – |
| P.O. NO. – – | – | – |
| DESIGNER – VERMONT DEPARTMENT OF TRANSPORTATION | – | – |
| CUSTOMER – CONTRACTORS CRANE SERVICE, LLC | – | – |
| | – | – |

DESCRIPTION: RAIL PANEL DETAILS
ADDISON COUNTY, VT

| SCALE | DRAWN BY | CHECKED BY | DATE |
|---|---|---|---|
| N.T.S. | KJB | TSF | 6/15/07 |


| PROJECT NUMBER | SHEET NO. | REVISION |
|---|---|---|
| 20388 | 1206 | 1 | 02 |


0873-BR

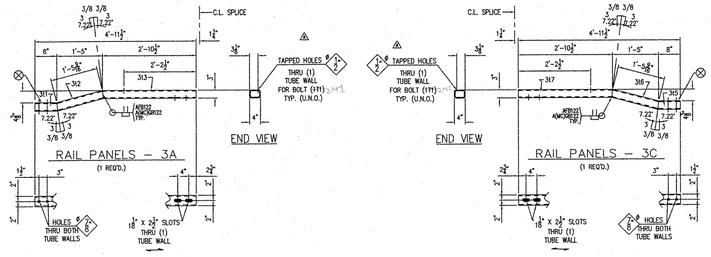





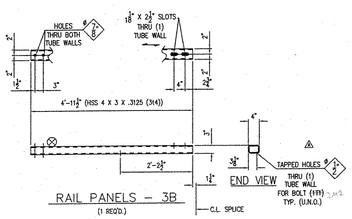

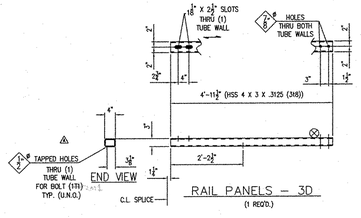
SHOP NOTE :-
⊗ – INDICATES LOCATION OF SHIPPING PIECE MARK

| MK | QTY. | DESCRIPTION | MATERIAL | LENGTH | REMARKS | PART NO. |
|---|---|---|---|---|---|---|
| 3A | 1 | RAIL PANEL | | | 4'-11 1/2" | |
| 301 | 1 | HSS 4 X 3 X 5/16 | A500 GR B | 6'-8 3/8 | SHAPE CUT; A123-HDG, CWN | |
| 302 | 1 | HSS 4 X 3 X 5/16 | A500 GR B | 1'-5 15/16 | SHAPE CUT; A123-HDG, CWN | |
| 303 | 1 | HSS 4 X 3 X 5/16 | A500 GR B | 7'-10 1/2 | SHAPE CUT; A123-HDG, CWN | |
| 3B | 1 | RAIL PANEL | | | 4'-11 1/2" | |
| 304 | 1 | HSS 4 X 3 X 5/16 | A500 GR B | 4'-11 1/2 | A123-HDG, CWN | |
| 3C | 1 | RAIL PANEL | | | 4'-11 1/2" | |
| 305 | 1 | HSS 4 X 3 X 5/16 | A500 GR B | 6'-8 3/8 | SHAPE CUT; A123-HDG, CWN | |
| 306 | 1 | HSS 4 X 3 X 5/16 | A500 GR B | 1'-5 15/16 | SHAPE CUT; A123-HDG, CWN | |
| 307 | 1 | HSS 4 X 3 X 5/16 | A500 GR B | 7'-10 1/2 | SHAPE CUT; A123-HDG, CWN | |
| 3D | 1 | RAIL PANEL | | | 4'-11 1/2" | |
| 308 | 1 | HSS 4 X 3 X 5/16 | A500 GR B | 4'-11 1/2 | A123-HDG, CWN | |

NOTE: ALL MATERIAL SPECIFICATION DESIGNATIONS ARE ASTM, UNLESS OTHERWISE NOTED.

RECEIVED
CK'D BY EJC OK'D BY RSY
AUG 07 2007
RESUBMIT ____ APPROVED AS NOTED
BY CPW DATE 8/17/07

– SEE SHEET NO. 1 FOR GENERAL NOTES

| REV | DESCRIPTION | DATE | DET | CHD |
|---|---|---|---|---|
| 1 | PER APPROVAL | 7/20/07 | JEB | TSF |

| ITEM | QUANTITY |
|---|---|
| – | – |
| – | – |
| – | – |
| – | – |
| – | – |
| – | – |
| – | – |
| – | – |

LOCATION – TOWNS OF NEW HAVEN & MIDDLEBURY
BRIDGE – 26
PROJECT – ROUTE NO. 7A17/11, CL3
F.A.P. NO. – BHO-BTN 2005(1)
P.O. NO. – –
DESIGNER – VERMONT DEPARTMENT OF TRANSPORTATION
CUSTOMER – CONTRACTORS CRANE SERVICE, LLC

THE D.S. BROWN COMPANY
300 E. CHERRY STREET
NORTH BALTIMORE, OHIO 45872
419.257.3561
FAX: 419.257.6322
WWW.DSBROWN.COM

DESCRIPTION: RAIL PANEL DETAILS
ADDISON COUNTY, VT

| SCALE | DRAWN BY | APPROVED BY | DATE |
|---|---|---|---|
| N.T.S. | JEB | TSF | 8/15/07 |

| PROJECT NUMBER | PROJECT DES. | PIECE | SHEET |
|---|---|---|---|
| 20388 | 1206 | 1 | 03 |

084-B2

| MK. | QTY. | DESCRIPTION | MATERIAL | LENGTH | REMARKS | PART NO. |
|---|---|---|---|---|---|---|
| ⚠ 4A | 2 | RAIL PANEL | | | 16'-0 5/8" | |
| 4A1 | 2 | HSS 4 X 3 X 5/16 | A500 GR B | 16'-0 5/8 | A123-HDG, CVN | |
| ⚠ 4B | 2 | RAIL PANEL | | | 16'-0 5/8" | |
| 4B1 | 2 | HSS 4 X 3 X 5/16 | A500 GR B | 16'-0 5/8 | A123-HDG, CVN | |

NOTE: ALL MATERIAL SPECIFICATION DESCRIPTIONS ARE ASTM, UNLESS OTHERWISE NOTED.




QTY. – RAIL PANELS – MK.

| QTY. | MK. | "A1" | "B1" | "C1" | "D1" | "E1" | "F1" | "G1" |
|---|---|---|---|---|---|---|---|---|
| ⚠ 2 | 4A | 1'-9 5/8" | 3'-9 5/8" | 6'-9 5/8" | 9'-9 5/8" | 12'-9 5/8" | 14'-9 5/8" | |




QTY. – RAIL PANELS – MK.

| QTY. | MK. | "A2" | "B2" | "C2" | "D2" | "E2" | "F2" | "G2" |
|---|---|---|---|---|---|---|---|---|
| ⚠ 2 | 4B | 1'-9 5/8" | 3'-9 5/8" | 6'-9 5/8" | 9'-9 5/8" | 12'-9 5/8" | 14'-9 5/8" | |

– SHOP NOTE –
@ – INDICATES LOCATION OF SHIPPING PIECE MARK

RECEIVED
CK'D BY ELR OK'D BY RKW
AUG 07 2007
RESUBMIT _____ APPROVED ✓
BY CPW DATE 8/17/07

– SEE SHEET NO. 1 FOR GENERAL NOTES

| REV. | DESCRIPTION | DATE | DET. | CKD. |
|---|---|---|---|---|
| ⚠ | PER APPROVAL | 7/20/07 | JEB | TSF |

D.S. BROWN

THE D.S. BROWN COMPANY
300 E. CHERRY STREET
NORTH BALTIMORE, OHIO 45872
419.257.3561
FAX: 419.257.3232
WWW.DSBROWN.COM

| | |
|---|---|
| LOCATION — TOWNS OF NEW HAVEN & MIDDLEBURY | |
| BRIDGE — 26 | |
| PROJECT — ROUTE NO. 7A7/11, CL3 | |
| F.A.P. NO. — BHG-BTN 2005(1) | |
| P.O. NO. — – | |
| DESIGNER — VERMONT DEPARTMENT OF TRANSPORTATION | |
| CUSTOMER — CONTRACTORS CRANE SERVICE, LLC | |

| ITEM | QUANTITY |
|---|---|
| – | – |
| – | – |
| – | – |
| – | – |
| – | – |
| – | – |
| – | – |
| – | – |

RAIL PANEL DETAILS
ADDISON COUNTY, VT

| SCALE | DRAWN BY | CHECKED BY | DATE |
|---|---|---|---|
| N.T.S. | JEB | TSF | 6/15/07 |
| PROJECT NUMBER | PROJECT FILE | VALUE | SHEET |
| 20388 | 1206 | 1 | 04 |

085-BR


| MK. | QTY. | DESCRIPTION | MATERIAL | LENGTH | REMARKS | PART NO. |
|---|---|---|---|---|---|---|
| ⚠ 5A | 2 | RAIL PANEL | | | 16'-0 5/8" | |
| 5A1 | 2 | HSS 4 X 3 X 5/16 | A500 GR B | 16'-0 5/8 | A123-HDG, CVN | |
| ⚠ 5B | 2 | RAIL PANEL | | | 16'-0 5/8" | |
| 5B1 | 2 | HSS 4 X 3 X 5/16 | A500 GR B | 16'-0 5/8 | A123-HDG, CVN | |

NOTE: ALL MATERIAL SPECIFICATION DESIGNATIONS ARE ASTM, UNLESS OTHERWISE NOTED.




QTY. – RAIL PANELS – MK.

| ⚠ QTY. | MK. | "A1" | "B1" | "C1" | "D1" | "F1" | "G1" |
|---|---|---|---|---|---|---|---|
| 2 | 5A | 1'-3" | 3'-3" | 6'-3" | 9'-3" | 12'-3" | 14'-3" |

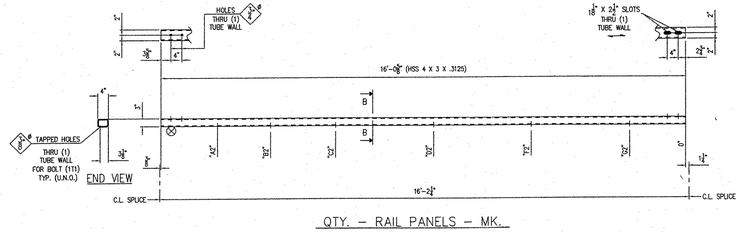


QTY. – RAIL PANELS – MK.

| ⚠ QTY. | MK. | "A2" | "B2" | "C2" | "D2" | "F2" | "G2" |
|---|---|---|---|---|---|---|---|
| 2 | 5B | 1'-3" | 3'-3" | 6'-3" | 9'-3" | 12'-3" | 14'-3" |

SHOP NOTE :-
⊗ – INDICATES LOCATION OF SHIPPING PIECE MARK

RECEIVED
CK'D BY FLC OK'D BY RKY
AUG 07,2007
RESUBMIT ____ APPROVED ✓
BY GPW DATE 8/17/07

– SEE SHEET NO. 1 FOR GENERAL NOTES

| REV | DESCRIPTION | DATE | DET. | CKD. |
|---|---|---|---|---|
| ⚠ | PER APPROVAL | 7/20/07 | JEB | TSF |

D.S. BROWN

THE D.S. BROWN COMPANY
300 E. CHERRY STREET
NORTH BALTIMORE, OHIO 45872
419.257.3561
FAX: 419.257.6332
WWW.DSBROWN.COM

LOCATION – TOWNS OF NEW HAVEN & WEYBRIDGE
BRIDGE – 26
PROJECT – ROUTE NO. 7A1/11, CL3
F.A.P. NO. – BHO-BTN 2005(1)
P.O. NO. – –
DESIGNER – VERMONT DEPARTMENT OF TRANSPORTATION
CUSTOMER – CONTRACTORS CRANE SERVICE, LLC

| ITEM | QUANTITY |
|---|---|
| – | – |
| – | – |
| – | – |
| – | – |
| – | – |
| – | – |
| – | – |
| – | – |


DESCRIPTION: RAIL PANEL DETAILS
ADDISON COUNTY, VT

| SCALE | DRAWN BY | CHECKED BY | DATE |
|---|---|---|---|
| N.T.S. | JEB | TSF | 6/15/07 |

| PROJECT NUMBER | PROJECT DWG. | REVISE | SHEET |
|---|---|---|---|
| 20388 | 1206 | 1 | 05 |

D86-BR

| MK | QTY. | DESCRIPTION | MATERIAL | LENGTH | REMARKS | PART NO. |
|---|---|---|---|---|---|---|
| 6A | 12 | RAIL PANEL | | | 18'-5 1/4" | |
| 6d1 | 12 | HSS 4 X 3 X 5/16 | A500 GR B | 18'-5 1/4 | A123-HDG, CVN | |
| 6B | 12 | RAIL PANEL | | | 18'-5 1/4" | |
| 6b1 | 12 | HSS 4 X 3 X 5/16 | A500 GR B | 18'-5 1/4 | A123-HDG, CVN | |

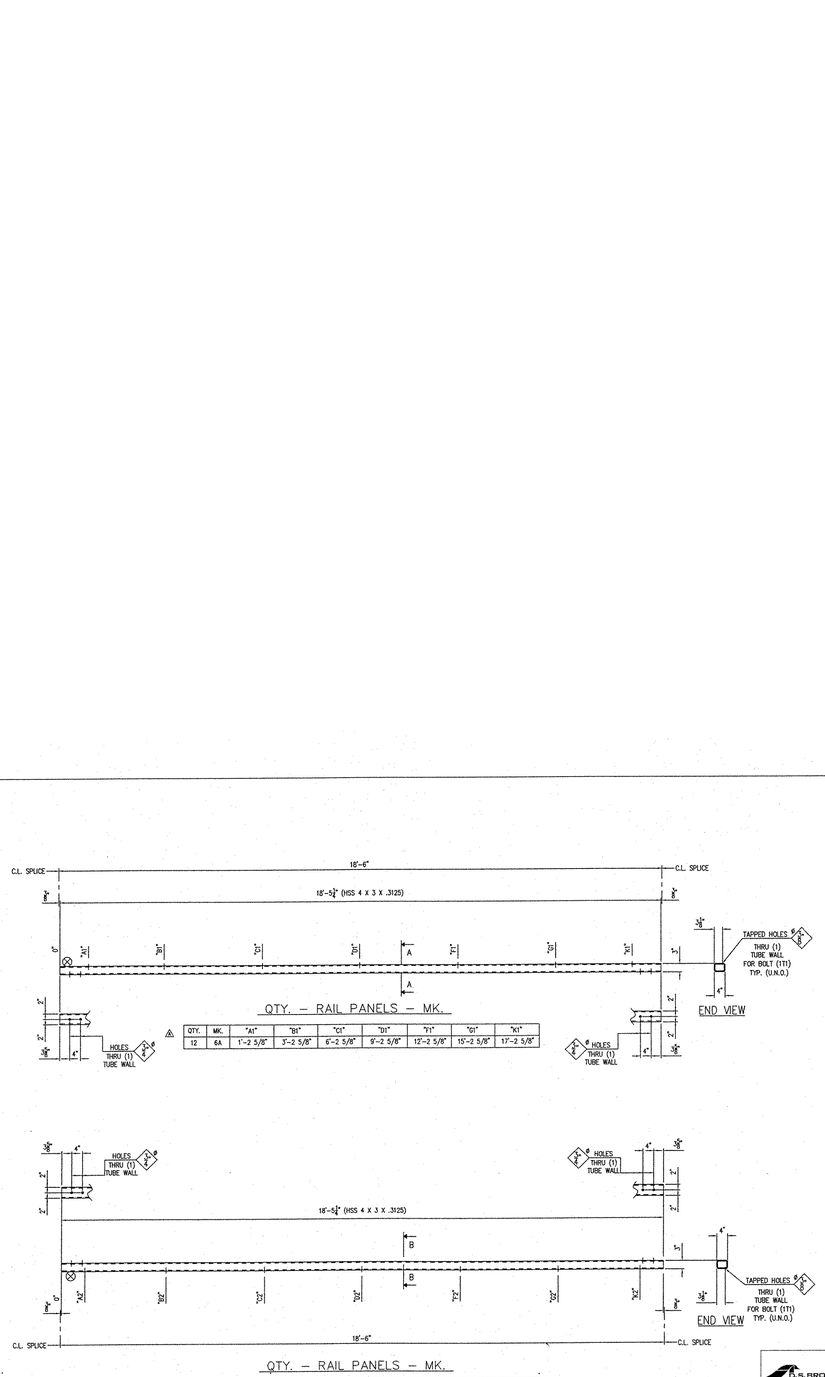


QTY. – RAIL PANELS – MK. 6A

| QTY. | MK. | "A1" | "B1" | "C1" | "D1" | "F1" | "G1" | "H1" |
|---|---|---|---|---|---|---|---|---|
| 12 | 6A | 1'-2 5/8" | 3'-2 5/8" | 6'-2 5/8" | 9'-2 5/8" | 12'-2 5/8" | 15'-2 5/8" | 17'-2 5/8" |

QTY. – RAIL PANELS – MK. 6B

| QTY. | MK. | "A2" | "B2" | "C2" | "D2" | "F2" | "G2" | "H2" |
|---|---|---|---|---|---|---|---|---|
| 12 | 6B | 1'-2 5/8" | 3'-2 5/8" | 6'-2 5/8" | 9'-2 5/8" | 12'-2 5/8" | 15'-2 5/8" | 17'-2 5/8" |

SHOP NOTE –
⊗ – INDICATES LOCATION OF SHIPPING PIECE MARK

RECEIVED
OK'D BY EK OK'D BY RM
AUG 07 2007
RESUBMIT ____ APPROVED ✓
BY CPW DATE 8/17/07

– SEE SHEET NO. 1 FOR GENERAL NOTES

| REV | DESCRIPTION | DATE | DET | CHD. |
|---|---|---|---|---|
| 1 | PER APPROVAL | 7/20/07 | JEB | TSF |

| | ITEM | QUANTITY |
|---|---|---|
| LOCATION – TOWNS OF NEW HAVEN & WEYBRIDGE | – | – |
| BRIDGE – 26 | – | – |
| PROJECT – ROUTE NO. 7A7/11, CL3 | – | – |
| F.A.P. NO. – BHO-BTN 2000(1) | – | – |
| P.O. NO. – – | – | – |
| DESIGNER – VERMONT DEPARTMENT OF TRANSPORTATION | – | – |
| CUSTOMER – CONTRACTORS CRANE SERVICE, LLC | – | – |
| | – | – |
| | – | – |


THE D.S. BROWN COMPANY
300 E. CHERRY STREET
NORTH BALTIMORE, OHIO 45872
419.257.3351
FAX 419.257.3352
www.dsbrown.com


RAIL PANEL DETAILS
ADDISON COUNTY, VT

| SCALE | DRAWN BY | CHKD BY | DATE |
|---|---|---|---|
| N.T.S. | JEB | TSF | 6/15/07 |

| PROJECT NUMBER | PRINT CODE | SHEET NO. | REV. |
|---|---|---|---|
| 20388 | 1206 | 1 | 06 |

087-RA

ANCHORAGE CONNECTOR PLATES – 7A
(4 REQ'D)




ANCHORAGE PLATES – 7B
(4 REQ'D)




DETAIL (7ac1)




DETAIL (7ac2)

| MK | QTY. | DESCRIPTION | MATERIAL | LENGTH | REMARKS | PART NO. |
|---|---|---|---|---|---|---|
| 7A | 4 | ANCHORAGE CONNECTOR PLATES | | | | |
| 7ac1 | 4 | 3/8 X 18 | A36 | 2'-1 3/16 | BEND; A123-HDG | |
| 7ac2 | 4 | 3/8 X 13 1/2 | A36 | 1'-6 | A123-HDG | |
| | | | | | | |
| 7B | 4 | ANCHORAGE PLATES | | | | |
| 7b1 | 4 | 3/4 X 6 | A36 | 1'-1 1/4 | A123-HDG | |
| | | | | | | |
| 7M | 25 | FIELD BOLTS | | | | |
| 7M1 | 25 | 3/4# HEX HEAD CAP SCREW | A325 | | (16); A153-HDG, ROCAP | |
| | | | | | | |
| 7N | 25 | FIELD BOLTS | | | | |
| 7N1 | 25 | 3/4# HEX NUT | A563-DH OR A194-2H | | (16); A153-HDG, ROCAP | |
| | | | | | | |
| 7P | 25 | FIELD BOLTS | | | | |
| 7P1 | 25 | 3/4# FLAT WASHER | F436 | | (16); A153-HDG, ROCAP | |
| | | | | | | |
| 7R | 25 | FIELD BOLTS | | | | |
| 7R1 | 25 | 13/4# LOCK WASHER | F844 | | (16) ASME B18.21.1; A153-HDG, ROK | |

NOTE: ALL MATERIAL SPECIFICATION DESCRIPTIONS ARE ASTM, UNLESS OTHERWISE NOTED.

RECEIVED
CK'D BY. ELR OK'D BY RCY
AUG 07 2007
RESUBMIT ____ APPROVED ✓
BY GPW DATE 8/17/07

– SEE SHEET NO. 1 FOR GENERAL NOTES

| REV | DESCRIPTION | DATE | DET. | CKD. |
|---|---|---|---|---|
| A | PER APPROVAL | 7/20/07 | JCB | TSF |

THE D.S. BROWN COMPANY
300 E. CHERRY STREET
NORTH BALTIMORE, OHIO 45872
419.257.3561
FAX: 419.257.3332
WWW.DSBROWN.COM

LOCATION — TOWNS OF NEW HAVEN & WEYBRIDGE
BRIDGE — 26
PROJECT — ROUTE NO. 17/7, CLS
F.A.P. NO. — BHO-BTH 2005(1)
P.O. NO. — –
DESIGNER — VERMONT DEPARTMENT OF TRANSPORTATION
CUSTOMER — CONTRACTORS CRANE SERVICE, LLC

| ITEM | QUANTITY |
|---|---|
| – | – |
| – | – |
| – | – |
| – | – |
| – | – |
| – | – |
| – | – |

DESCRIPTION: RAIL PANEL DETAILS
ADDISON COUNTY, VT

| DRAWN BY | CHECKED BY | DATE | SHEET |
|---|---|---|---|
| N.T.S. | JCB | TSF | 8/15/07 | – |
| PROJECT NUMBER | | PROJECT NO. | REVISION | SHEET |
| 20388 | | 1206 | 1 | 07 |

088-BR

PLAN VIEW

DIMENSIONS SHOWN ARE TYPICAL FOR BOTH SIDES OF BRIDGE




RAIL PANEL PIECE MARK KEY

REFER TO CONTRACT DRAWING 29 OF 53 FOR MORE INFORMATION ON EXISTING LATTICE

SHOP NOTE –
⊗ – INDICATES LOCATION OF SHIPPING PIECE MARK

RECEIVED
CK'D BY FLK CK'D BY RAS
AUG 07 2007
RESUBMIT ____ APPROVED ✓
BY QPW DATE 8/17/07

– SEE SHEET NO. E2 FOR TYPICAL DETAILS & SECTIONS

| REV. | DESCRIPTION | DATE | DET. | CKD. |
|---|---|---|---|---|
| A | PER APPROVAL | 7/20/07 | JEB | TSF |

THE D.S. BROWN COMPANY
300 E. CHERRY STREET
NORTH BALTIMORE, OHIO 45872
419.257.3521
FAX: 419.257.6333
WWW.DSBROWN.COM

| | |
|---|---|
| LOCATION — TOWNS OF NEW HAVEN & WEYBRIDGE | |
| BRIDGE — 26 | |
| PROJECT — ROUTE NO. 7A7/11, CL3 | |
| F.A.P. NO. — BHO-BTN 2005(1) | |
| P.O. NO. — - | |
| DESIGNER — VERMONT DEPARTMENT OF TRANSPORTATION | |
| CUSTOMER — CONTRACTORS CRANE SERVICE, LLC | |


| ITEM | QUANTITY |
|---|---|
| – | – |
| – | – |
| – | – |
| – | – |
| – | – |
| – | – |
| – | – |
| – | – |

DRAWING: ERECTION DETAILS
ADDISON COUNTY, VT


| SCALE | DRAWN BY | CHECKED BY | DATE | REV. |
|---|---|---|---|---|
| N.T.S. | JEB | TSF | 6/15/07 | – |

| PROJECT NAME | PROJECT NO. | VOLUME | SHEET |
|---|---|---|---|
| 20388 | 1206 | 1 | E1 |


089-BR

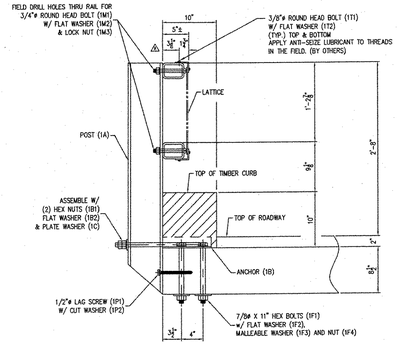



TYP. SECTION @ RAIL POST

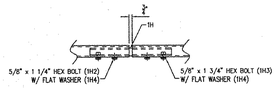


TYP. SPLICE DETAIL

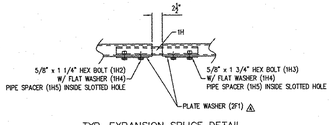


TYP. EXPANSION SPLICE DETAIL

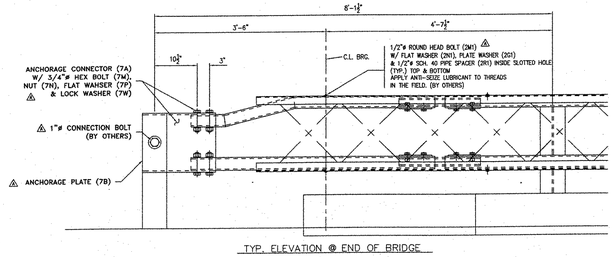


TYP. ELEVATION @ END OF BRIDGE

RECEIVED
OK'D BY ELR OK'D BY RSY
AUG 07 2007
RESUBMIT _____ APPROVED ✓
BY CPW DATE 8/17/07

RECEIVED
AUG - 6 2007
CONTRACTORS CRANE SERV, INC.
MORRISVILLE, VT

CCS Constructors LLC
138 Munson Avenue
Morrisville, VT 05661
Ph: 802-888-7701 f: 802-888-4746

| REV | DESCRIPTION | DATE | DET. | CKD. |
|---|---|---|---|---|
| ⚠ | PER APPROVAL | 7/20/07 | JEB | TSF |

THE D.S. BROWN COMPANY
300 E. CHERRY STREET
NORTH BALTIMORE, OHIO 45872
419.257.3351
FAX 419.257.3333
www.dsbrown.com


| | |
|---|---|
| LOCATION — TOWNS OF NEW HAVEN & WEYBRIDGE | |
| BRIDGE — 26 | |
| PROJECT — ROUTE NO. TH7/11, CL3 | |
| F.A.P. NO. — BHO-BTN 2005(1) | |
| P.O. NO. — — | |
| DESIGNER — VERMONT DEPARTMENT OF TRANSPORTATION | |
| CUSTOMER — CONTRACTORS CRANE SERVICE, LLC | |

| ITEM | QUANTITY |
|---|---|
| – | – |
| – | – |
| – | – |
| – | – |
| – | – |
| – | – |
| – | – |
| – | – |

EXECTION DETAILS
ADDISON COUNTY, VT

| SCALE | DRAWN BY | CHKD. BY | DATE |
|---|---|---|---|
| N.T.S. | JEB | TSF | 6/15/07 |
| PROJECT NUMBER | PROJECT SIZE | REVISION | SHEET |
| 20388 | 1206 | 1 | E2 |

090-BR

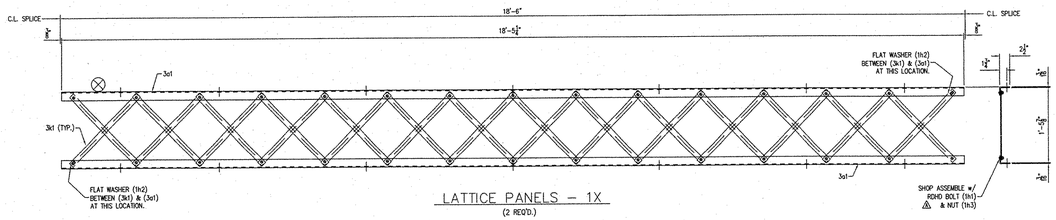


LATTICE PANELS – 1X

(2 REQ'D.)

## GENERAL NOTES:

1.) MATERIALS AND WORKMANSHIP SHALL IN ACCORDANCE WITH THE STATE OF VERMONT AGENCY OF TRANSPORTATION "STANDARD SPECIFICATIONS FOR CONSTRUCTION, DATED 2006" AS AMENDED BY THE LATEST REVISIONS, THE AASHTO STANDARD SPECIFICATIONS FOR HIGHWAY CONSTRUCTION, SEVENTEENTH EDITION.

2.) FABRICATION SHALL BE PERFORMED IN ACCORDANCE WITH AASHTO STANDARD SPECIFICATIONS FOR HIGHWAY CONSTRUCTION, ANSI/AASHTO/AWS D1.5 AND THE CURRENT INTERIM SPECIFICATIONS AS MODIFIED BY VIRANS SPEC. 506.03.

3.) RAILING MATERIALS SHALL BE ASTM A709 GR 50, UNLESS NOTED OTHERWISE. PER VIRANS SPECIFICATION 732.03(a), (W6 X 25 POSTS SHALL BE CVN TESTED PER 25 FT. LBS. @ 40°F).⚠

- HOLLOW STRUCTURAL SHAPES TO CONFORM WITH ASTM A500, GRADE B IN ACCORDANCE WITH VIRANS SPECIFICATION 732.03(a), (HSS SHALL BE CVN TESTED PER 15 FT. LBS. @ 40°F).⚠
- PIPE SHALL BE ASTM A53, GRADE B.
- HARDWARE TO BE IN ACCORDANCE WITH ASTM F568M, CLASS 4.6 (ASTM A307), U.N.O.
- HIGH STRENGTH HARDWARE SHALL BE IN ACCORDANCE WITH AASHTO M164 TYPE 1 (ASTM A325) OR (ASTM A449) AND SHALL BE SUPPLIED IN ACCORDANCE TO VIRANS SPEC. 714.05. WHICH INCLUDES ROCAP, PROOF AND WEDGE TESTING.
- THREADED ROD FOR POST ANCHORAGE SHALL SHALL CONFORM TO ASTM F 1554 GRADE 55 "WELDABLE STEEL".

4.) ALL HARDWARE SHALL BE GALVANIZED IN ACCORDANCE WITH AASHTO M-232 (ASTM A-153).

5.) RAILING COMPONENTS SHALL BE GALVANIZED IN ACCORDANCE WITH AASHTO M-111 (ASTM A123), UNLESS NOTED OTHERWISE. RADIUS ALL EDGES 1/16" AND BLAST CLEAN PER SSPC-SP 8 PRIOR TO GALVANIZING AND REPAIR GALVANIZING PER ASTM A780.

6.) FABRICATION SHALL TAKE PLACE IN A FACILITY WITH A MINIMUM AISC CATEGORY III CERTIFICATION OR BE APPROVED BY VIRANS. NON-CERTIFIED FACILITIES MUST SATISFY THE REQUIREMENTS OF VIRANS SPEC. 506.03

THE CONTRACTOR SHALL VERIFY ALL DIMENSIONS PRIOR TO FABRICATION TO ENSURE ACCURACY OF DESIGN PLANS. STAMPED APPROVED DRAWINGS ASSUME DIMENSIONS HAVE BEEN VERIFIED BY CONTRACTOR.

| MK | QTY. | DESCRIPTION | MATERIAL | LENGTH | REMARKS | PART NO. |
|---|---|---|---|---|---|---|
| 1X | 2 | LATTICE PANELS | | | 18'-5 1/4" | |
| 1h1 | 65 | 3/8 DIA. SLOTTED ROUND HEAD BOLT | A307 GR. A | | (60D) A153-HDG, NONE | |
| 1h2 | 10 | 1-5/8" FLAT WASHER | F844 | | (4D) A153-HDG | |
| 1h3 | 65 | 3/8" HEX NUT | A563 GR. A | | (60D) A153-HDG | |
| 3o1 | 4 | 3" X 2" X 3/16" | A709 GR 50 OR A992 | 18'-1 1/4 | (4D)A123-HDG, NONE | |
| 3k1 | 56 | 1 1/2" X 1 1/2" X 3/16" | A709 GR 50 | 1'-11 5/16 | SEE SHEET 3 FOR PIECE DETAILS | |

NOTE: ALL MATERIAL SPECIFICATION DESCRIPTIONS ARE ASTM, UNLESS OTHERWISE NOTED.

RECEIVED

CK'D BY E.L.P. OK'D BY RSY

AUG 07 2007

RESUBMIT _____ APPROVED ✓

BY CPW DATE 8/17/07

– SEE SHEET 3 FOR PIECE DETAILS.

– SEE DS BROWN PROJECT 20388–1206 SHEET E1 & E2 FOR FIELD LOCATION AND DETAILS

SHOP NOTE :
⊕ – INDICATES LOCATION OF SHIPPING PIECE MARK

| REV. | DESCRIPTION | DATE | DET. | CKD. |
|---|---|---|---|---|
| | | | | |
| | | | | |
| | | | | |
| ⚠1 | PER APPROVAL | 7/20/07 | JEB | TSF |


D.S. BROWN

THE D.S. BROWN COMPANY
300 E. CHERRY STREET
NORTH BALTIMORE, OHIO 45872
419.257.3602
FAX: 419.257.3232
WWW.DSBROWN.COM



| | ITEM | QUANTITY |
|---|---|---|
| LOCATION — TOWNS OF NEW HAVEN & WEYBRIDGE | – | – |
| BRIDGE — 28 | – | – |
| PROJECT — ROUTE NO. TH7/F1, CL3 | – | – |
| F.A.P. NO. — BHO-BTN 2005(1) | – | – |
| P.O. NO. — – | – | – |
| DESIGNER — VERMONT DEPARTMENT OF TRANSPORTATION | – | – |
| CUSTOMER — CONTRACTORS CRANE SERVICE, LLC | – | – |

DESCRIPTION: LATTICE DETAILS
ADDISON COUNTY, VT

SCALE: N.T.S. | DRAWN BY: JEB | CHECKED BY: TSF | DATE: 6/15/07 | –

PROJECT NUMBER: 20388 | PROJECT NAME: 1209 | RELEASE: 1 | SHEET: 01

091-B2

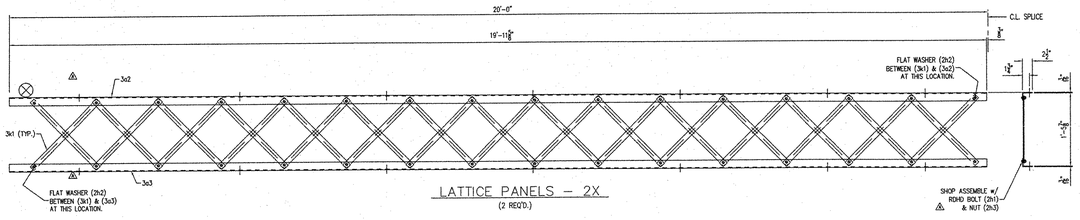


LATTICE PANELS – 2X

(2 REQ'D.)

| MK. | QTY. | DESCRIPTION | MATERIAL | LENGTH | REMARKS | PART NO. |
|---|---|---|---|---|---|---|
| 2X | 2 | LATTICE PANELS | | | 19'-11 5/8" | |
| 2k1 | 70 | 3/8W-1 1/8 SLOTTED ROUND HEAD BOLT | A307 GR A | | (64); A153-HDG, NONE | |
| 2k2 | 10 | 3/8W FLAT WASHER | F844 | | (4); A153-HDG | |
| 2k3 | 70 | 3/8W HEX NUT | A563 GR A | | (64); A153-HDG | |
| 3x2 | 2 | 2 1/2 X 2 X 3/16 | A709 GR 50 OR A992 | 19'-11 5/8 | A123-HDG, NONE | |
| 3x3 | 2 | 2 1/2 X 2 X 3/16 | A709 GR 50 OR A992 | 19'-11 5/8 | A123-HDG, NONE | |
| 3k1 | 60 | 3/16 X 2 | A572 GR 50 | 1'-11 5/16 | (CAN ALSO BE 1 ¼ ALL NOT IS SPECIFIED) A123-HDG | |

NOTE: ALL MATERIAL SPECIFICATION DESCRIPTIONS ARE ASTM, UNLESS OTHERWISE NOTED.

RECEIVED

CK'D BY EVP OK'D BY KSV

AUG 07 2007

RESUBMIT____ APPROVED ✓

BY CPW DATE 8/17/07

– SEE SHEET 3 FOR PIECE DETAILS.

– SEE DS BROWN PROJECT 20388-1206
SHEET E1 & E2 FOR FIELD LOCATION AND DETAILS

SHOP NOTE
⊗ – INDICATES LOCATION OF SHIPPING PIECE MARK

| REV. | DESCRIPTION | DATE | DET. | CKD. |
|---|---|---|---|---|
| 1 | PER APPROVAL | 7/26/07 | JEB | TSF |

D.S. BROWN
THE D.S. BROWN COMPANY
300 E. CHERRY STREET
NORTH BALTIMORE, OHIO 45872
419.257.3561
FAX: 419.257.3333
WWW.DSBROWN.COM


LOCATION – TOWNS OF NEW HAVEN & WEYBRIDGE
BRIDGE – 26
PROJECT – ROUTE NO. TH7/11, CL3
F.A.P. NO. – BHG-BTN 2005(1)
P.O. NO. – –
DESIGNER – VERMONT DEPARTMENT OF TRANSPORTATION
CUSTOMER – CONTRACTORS CRANE SERVICE, LLC

| ITEM | QUANTITY |
|---|---|
| – | – |
| – | – |
| – | – |
| – | – |
| – | – |
| – | – |
| – | – |
| – | – |

DESCRIPTION: LATTICE DETAILS, ADDISON COUNTY, VT

| SCALE | DRAWN BY | CHECKED BY | DATE | |
|---|---|---|---|---|
| N.T.S. | JEB | TSF | 6/15/07 | – |
| PROJECT NAME | | PROJECT NO. | PIECE | SHEET |
| 20388 | | 1209 | 1 | 02 |

092-PR

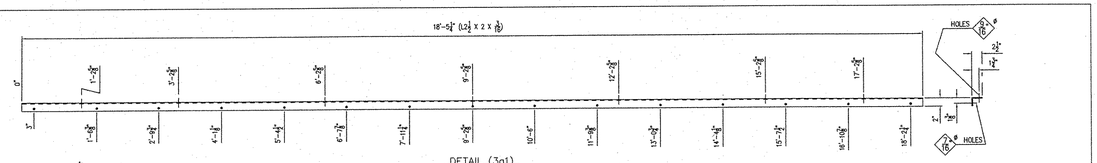


RECEIVED
AUG 07 2007

CK'D BY EK CK'D BY RSH

RESUBMIT ____ APPROVED ✓

BY CPW DATE 8/17/07

SHOP NOTE
⊗ – INDICATES LOCATION OF SHIPPING PIECE MARK

| REV. | DESCRIPTION | DATE | DET. | CKD. |
|---|---|---|---|---|
| 1 | PER APPROVAL | 7/26/07 | JEB | TSF |

| ITEM | QUANTITY |
|---|---|
| – | – |
| – | – |
| – | – |
| – | – |
| – | – |
| – | – |
| – | – |
| – | – |

LOCATION — TOWNS OF NEW HAVEN & WEYBRIDGE
BRIDGE — 26
PROJECT — ROUTE NO. 7A7/11, CL3
F.A.P. NO. — BHO-BTN 2005(1)
P.O. NO. — –
DESIGNER — VERMONT DEPARTMENT OF TRANSPORTATION
CUSTOMER — CONTRACTORS CRANE SERVICE, LLC


THE D.S. BROWN COMPANY
300 E. CHERRY STREET
NORTH BALTIMORE, OHIO 45872
419.257.3561
FAX: 419.257.6332
WWW.DSBROWN.COM


DESCRIPTION: LATTICE DETAILS
ADDISON COUNTY, VT

| SCALE | DRAWN BY | CHECKED BY | DATE | – |
|---|---|---|---|---|
| N.T.S. | JEB | TSF | 8/15/07 | – |
| PROJECT NUMBER | PROJECT NO. | REVISION | SHEET | |
| 20388 | 1209 | 1 | 03 | |

093-BR