WORK ORDER NO.	DRAWING NO.	REV.
15873	12-7	2

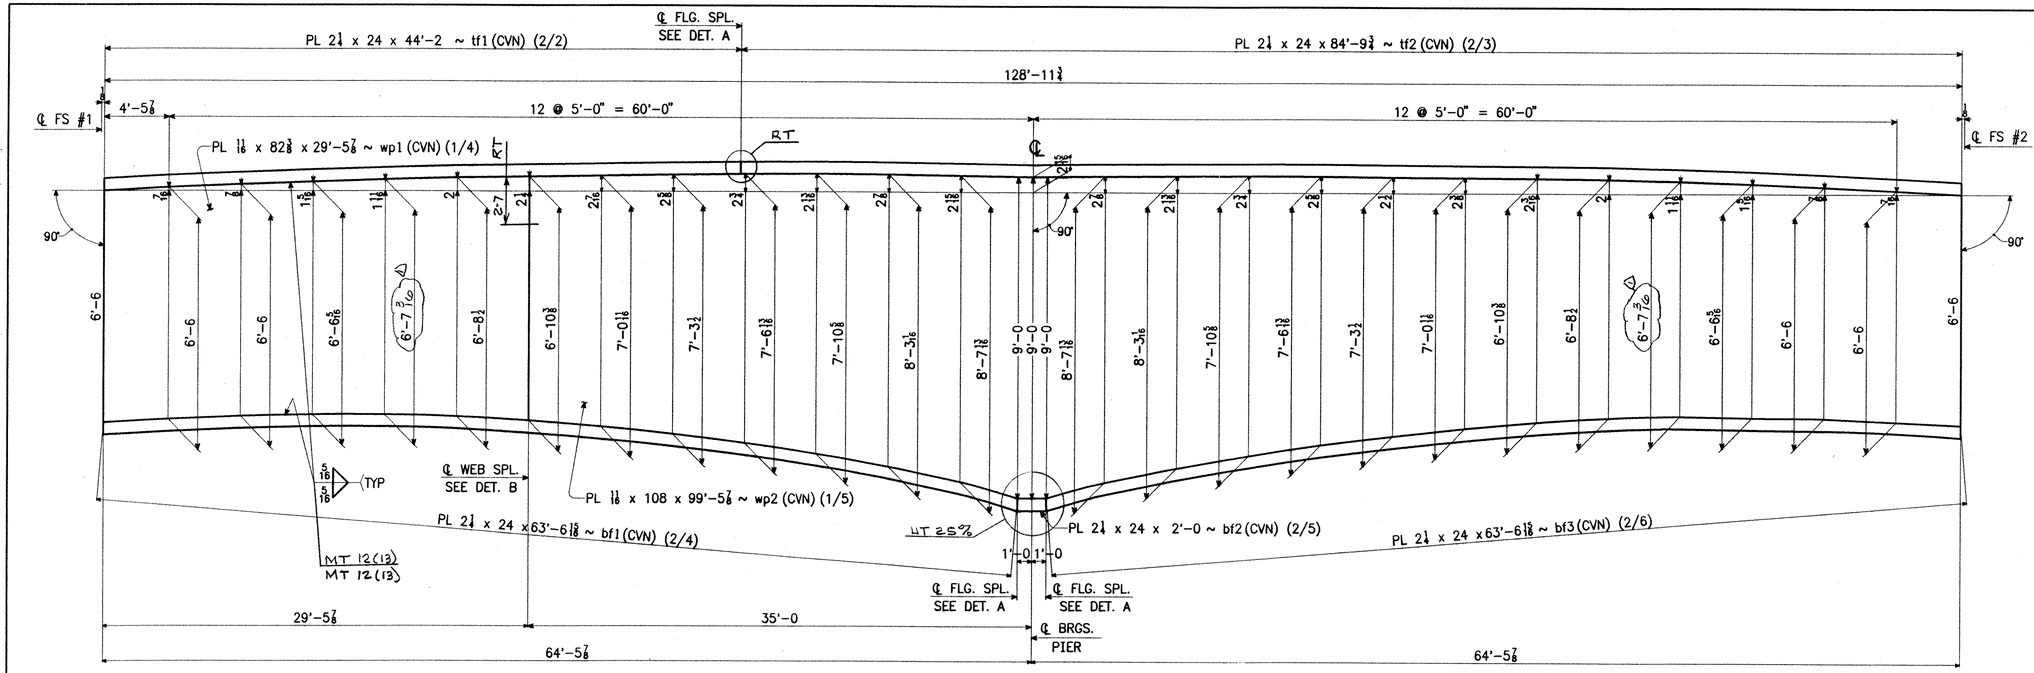

CAMBER DIAGRAM FOR GIRDER ~ G3B

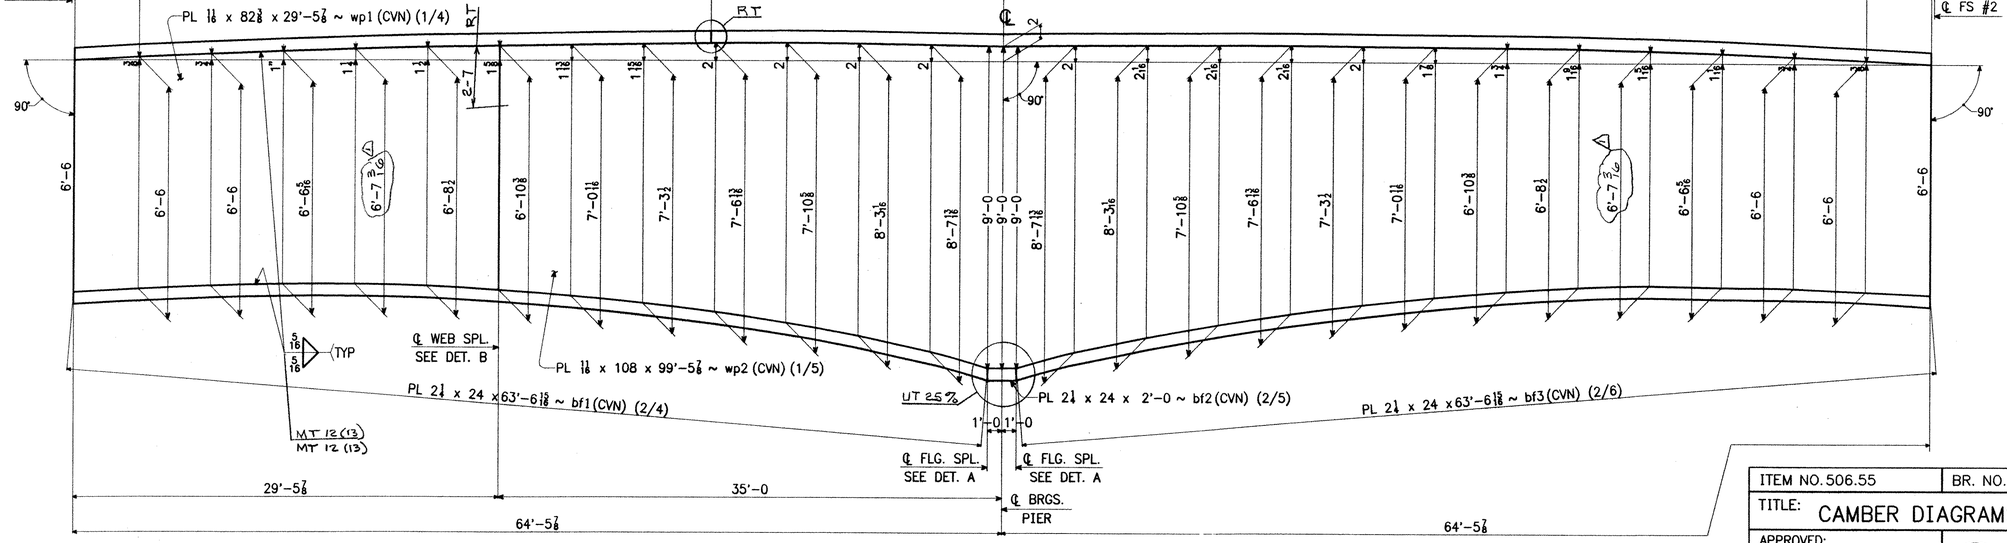

CAMBER DIAGRAM FOR GIRDER ~ G4B

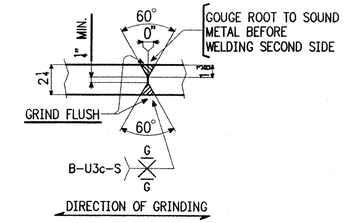

FLANGE SPLICE DETAIL A

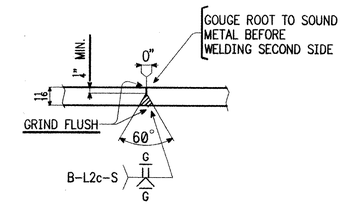

WEB SPLICE DETAIL B

NOTES:

1. MATERIAL: ASTM A709-50W
2. CVN DENOTES CHARPY V-NOTCH TESTING REQUIRED.

RECEIVED
CK'D BY LWB? OK'D BY
AUG 2 7 2001
RESUBMIT APPROVED ✓
BY CPW DATE 8/30/01

△ NDT 8-23-01 JCM
△ WEB DEPTH 6-25-01 JCM
△ APPL COMMENTS (GEN REV) 6-21-01 AV

ITEM NO. 506.55	BR. NO. 3	PROJ. NO. BRZ 1444(22)

TITLE: CAMBER DIAGRAMS — FOR APPROVAL

APPROVED:		
PRINT DIST.		
5	4-7-01	APPR.
ORIG.	6-21-01	FAB.
11	6-25-01	FAB
5	7-13-01	APP
5	8-24-01	APP
12	8-24-01	FAB
CHECKED	TS	3/01
DRAWN	AV	3/01

National Eastern Corporation
Plainville, Connecticut

JOB: T.H. 1 OVER THE WHITE RIVER
ROYALTON, VERMONT

CUSTOMER: BECK & BELLUCCI, INC.

DESIGNER: VERMONT AGENCY OF TRANSPORTATION

WORK ORDER NO.	DRAWING NO.	REV.
15873	12-7	2