


34 - UTILITY SUPPORTS - S1


34 - UTILITY SUPPORTS - S1T

UTSPPT

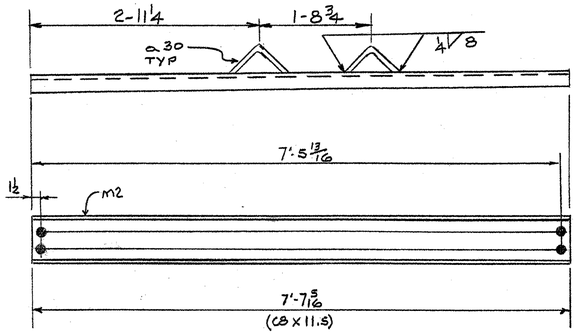


34 - UTILITY SUPPORTS - S1W

UTSPPT

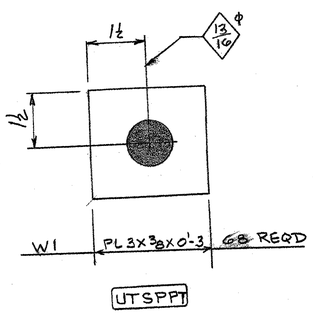


UTSPPT

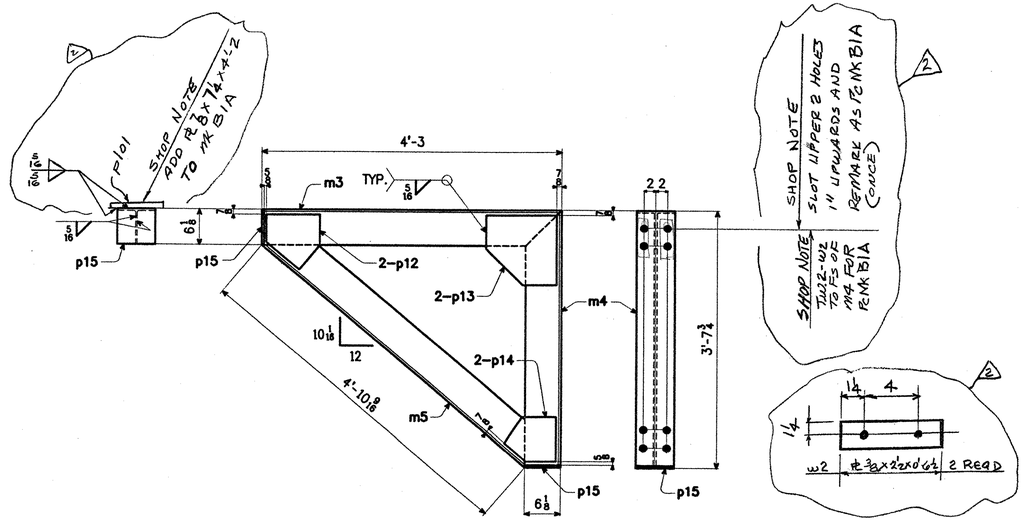

26 - SIDEWALK BRACKETS - B1

BKSPPT

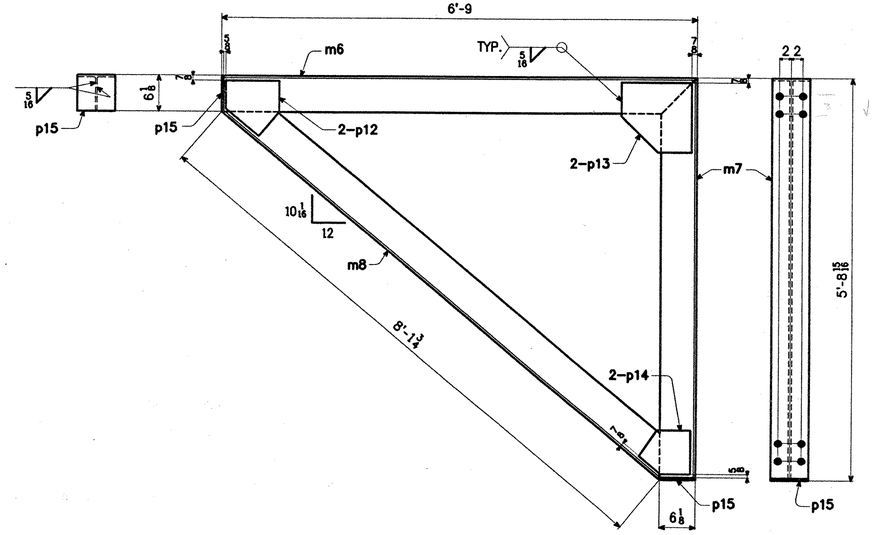

4 - SIDEWALK BRACKETS - B2

BKSPPT

RECEIVED
CK'D BY GPW OK'D BY
JAN 30 2002
RESUBMIT APPROVED
BY GPW DATE 2/11/02

2 NK BIA 1-28-02 JCM
1 UTILITY SUPPORTS 11-15-01 JCM

BILL OF MATERIAL

WORK ORDER NO. 15873 | DRAWING NO. 20-7 | REV. 2

SHIP MARK	NO.	MARK	SHAPE	LENGTH		ITEM NO.	WT.	REMARKS
S1	34		UTIL. SUPP.		1			2975 Sewer
	34	m2	C8 x 11.5	7'-7 5/16	1	S4/11 6/11	2975	
BIA	1		BRACKET		2			330 (237)
B1	25		BRACKETS		2			5918
	26	m3	WT6 x 13	4'-2 3/8		S4/5 4/9	1426	
	26	m4	WT6 x 13	3'-7 3/8		4/7	1222	
	26	m5	WT6 x 13	4'-10 9/16		4/6	1650	
	52	p12	PL 3/8 x 9 1/8	0'-9 7/16		S4/9 4/10	476	
	52	p13	PL 3/8 x 12	1'-0		4/8	796	
	52	p14	PL 3/8 x 7 1/2	0'-8 13/16		S3/6 4/9	365	
	52	p15	PL 3/8 x 6 1/8	0'-6 1/2		S3/8 4/11	220	
	1	P101	PL 3/8 x 7 1/4	4'-2	2		90	BIA
	2	W2	PL 3/8 x 2 1/2	0'-6 1/2	2		3	BIA
B2	4		BRACKETS					1356
	4	m6	WT6 x 13	6'-8 5/8		S4/5 4/3	349	
	4	m7	WT6 x 13	5'-8 9/16		4/4	297	
	4	m8	WT6 x 13	8'-1 3/4		4/5	424	
	8	p12	PL 3/8 x 9 1/8	0'-9 7/16		S2/9 4/10	73	
	8	p13	PL 3/8 x 12	1'-0		4/8	123	
	8	p14	PL 3/8 x 7 1/2	0'-8 13/16		S3/6 4/9	56	
	8	p15	PL 3/8 x 6 1/8	0'-6 1/2		S3/8 4/11	34	
SIT	34		UTIL SUPP		1			2975
	34	m2a	C8 x 11.5	7-7 5/16	1	S-9/11	2975	Telephone
SIW	34		UTIL SUPP		1			3161 Water
	34	m2	C8 x 11.5	7-7 5/16	1	S4/11 6/11	2975	
	68	a30	L2 1/2 x 2 1/2 x 1/4	0-8	1	S4/15 6/10	186	
W1	68		PL WASHER		1			65
Water-line only	68	p50	PL 3 x 3/8	0-3	1	S4/17 6/10	65	
					1 2		16780	#

2-14-02

STEEL: ASTM	A709-36	A709-50	X A709-50W
WELDING ELECTRODE:	X E70	See Welding Proc.	None
HOLES:	13/16	X 15/16	Unless Noted
PAINT:	X None	Galv. After Fab.	As Noted
SPECIAL PAINT:			
SPECIAL CLEANING:	X Blast Clean SSPC SP10	None	

ITEM NO. 506.55 | BR. NO. 3 | PROJ. NO. BRZ 1444(22)

TITLE: UTILITY SUPPORT DETAILS

APPROVED: 9-5-01		
PRINT DIST.		
5	4-7-01	APPR.
ORIG.	9-5-01	FAB.
5	7-13-01	APP
5	8-28-01	APP
5	11-19-01	APP
11	11-19-01	FAB
5	1-28-02	APP
11	1-28-02	FAB
DRAWN	TS	3/01
CHECKED	AV	3/01

REVISED

National Eastern Corporation
Plainville, Connecticut

JOB: T.H. 1 OVER THE WHITE RIVER
ROYALTON, VERMONT

FOR APPROVAL

CUSTOMER: BECK & BELLUCCI, INC.

DESIGNER: VERMONT AGENCY OF TRANSPORTATION

WORK ORDER NO.	DRAWING NO.	REV.
15873	20-7	2