
Guilford BRD 1442(24)
Old Bonnyvale Road Cross Sections
project sheet # 12 of 28

10 9 8 7 6 5 4 3 2 1 ℄ 1 2 3 4 5 6 7 8 9 10


174
172

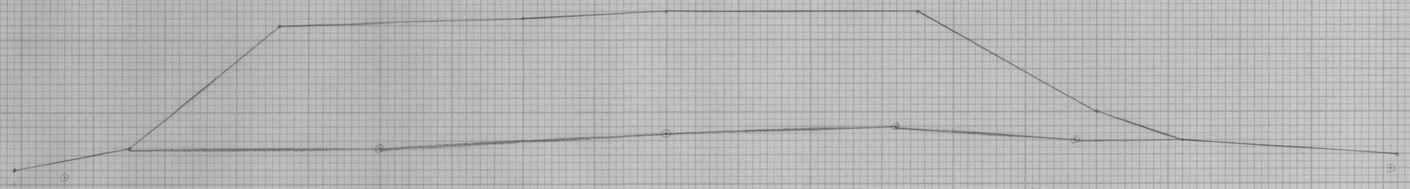

Unclassified Exc = 19.6 m²

0+055


174
172

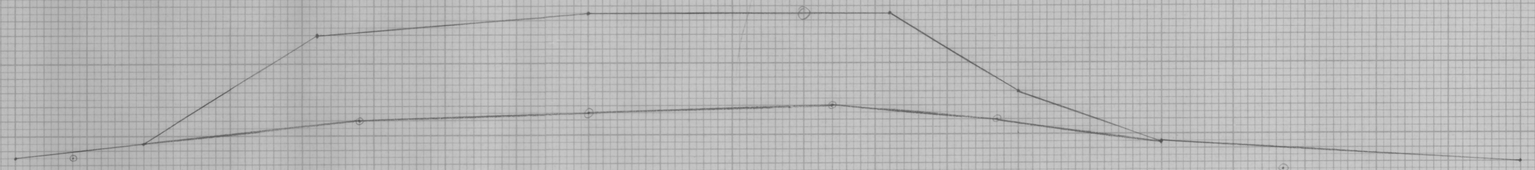

Unclassified Exc = 14.1 m²

0+060

174
172

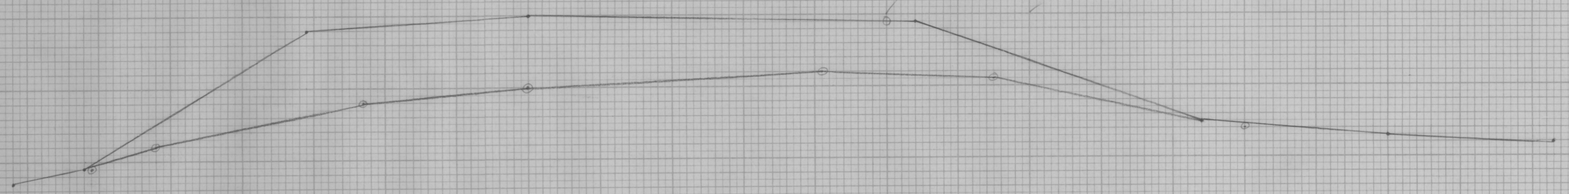

Unclassified Exc = 11.0 m²

0+065

I = 65

713

4 = 2.61
E = 5.19
4 = 2.60

for 6/4/08
M.W.H. 1/26/10

FINAL SURVEY — SURVEYED, PLOTTED, TEMPLATE, NOTE BOOK, AREAS CHECKED, BY, DATE, NO

ORIGINAL SURVEY — SURVEYED, PLOTTED, TEMPLATE, NOTE BOOK, AREAS CHECKED, BY, DATE, NO

NATIONAL FILMCHART
PRINTED IN U.S.A.