ABM INFO		SHOP BILL					JOB NO. 208	DRG. NO. 54
PAGE	LINE	NO.	DESCRIPTION	mm	ASSEM. MARK	SHIPPING MARK	REMARKS	WEIGHT
		1	TS152A x 152.4 x 6.4	2550		D1	ASTM A500 OR A501	
		2	L 102 x 76 x 9.5	76	K1			
		2	M20 EXP BOLTS GALV.	230		FIELD	V/NEW.	
		PAY ITEM 506.60						

VAOT- STRUCTURES
RECEIVED
OK'D BY G. Ray OK'D BY rgh
2-12-04 2-12-04
JAN 29 2004
RESUBMIT ____ APPROVED X
BY DATE

PLANS DRAWN USING
METRIC
DIMENSIONS

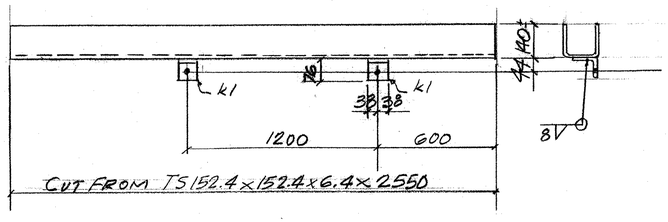

DOWNSPOUT - D1 - ONE REQ'D.

REV.	REMARKS	DATE	DWN	CHK	APP	Q.A.	NO.	DIA.	LGT	TYPE	WASHER
	OUT FOR APPROVAL	1-26-04									
	OUT FOR APPROVAL										
	ISSUED TO SHOP										
	FIELD & OFFICE										

PROJECT NO. BHO-1442 (25) STATE BRIDGE NO. 19 (BROOKLINE)
MATERIAL: AASHTO M270-GR250 ELECTRODES: PER PROC. HOLES: 23 ø SHOP BOLTS: —
SURFACE PREP. & PAINT:
GALVANIZED AFTER FAB (ASTM-A123)

DESCRIPTION: DOWNSPOUT-ABUT. 1
JOB: BRIDGE REHAB. BROOKLINE-NEWFANE, VT.
CUSTOMER: RENAUD BROTHERS

	DRAWN BY	DATE
	JPF	1-04
	CHKD BY	
	EJ	
	APPROV BY	
	Q.A.	

CASCO BAY STEEL STRUCTURES, INC.
75 SPRING HILL ROAD SACO, MAINE 04072
PHONE (207) 282-7360 FAX. (207) 282-1179

JOB NO.	DRG. NO.
208	54
	REV. △

105 55