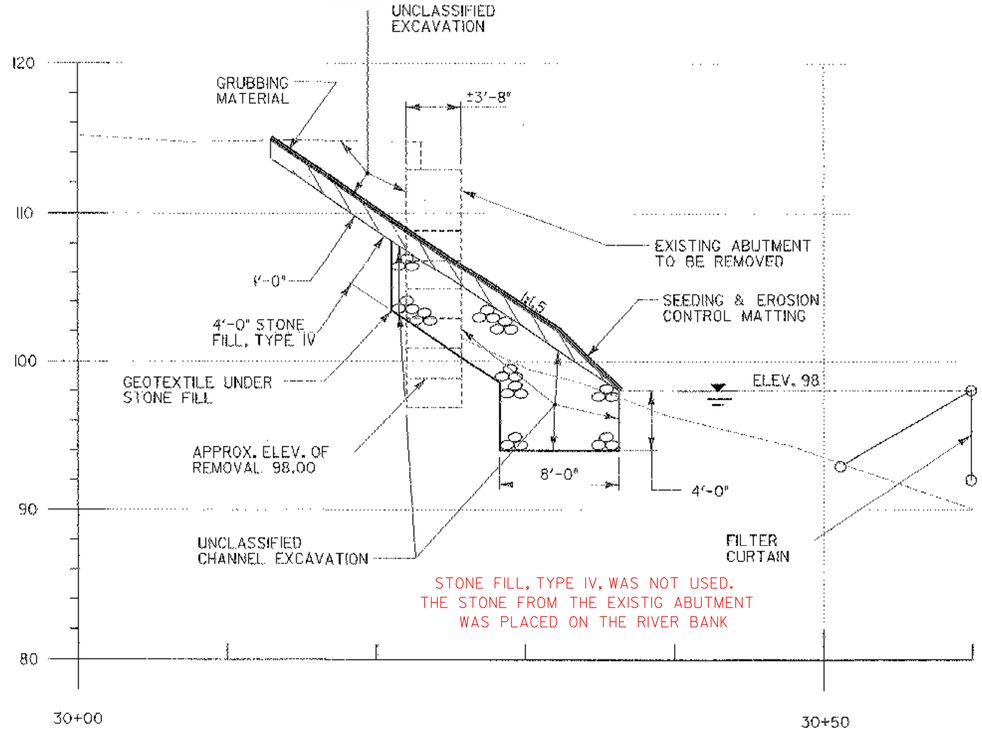

WEST ABUTMENT SECTION

SCALE: 1"=5'

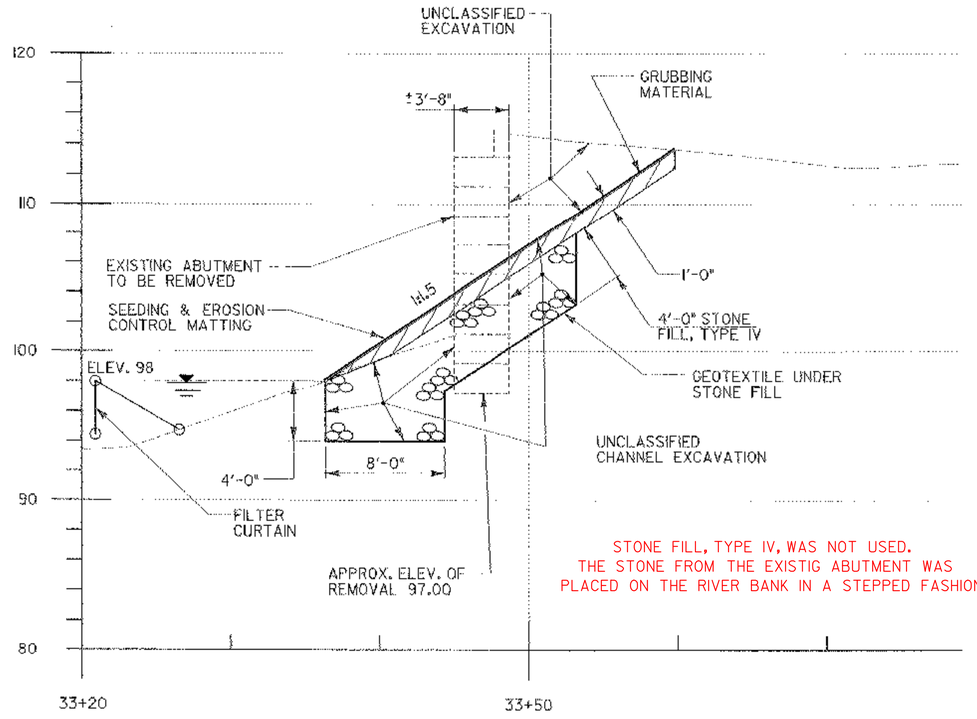

EAST ABUTMENT SECTION

SCALE: 1"=5'

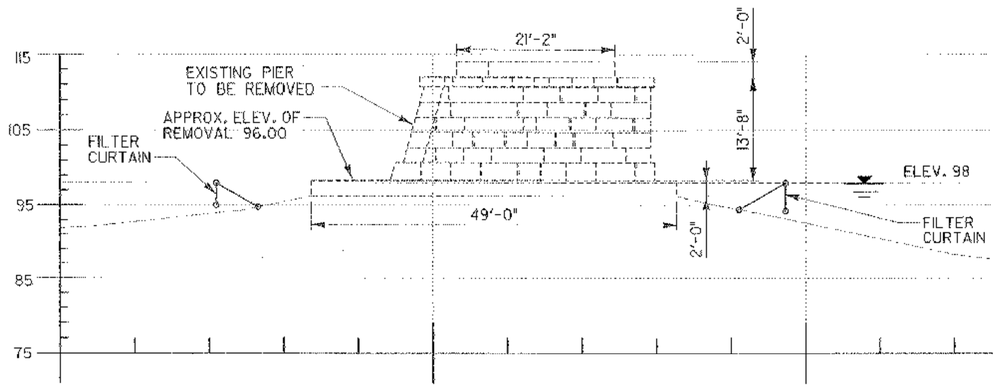

PIER ELEVATION

SCALE: 1"=10'

PIER SECTION

SCALE: 1"=10'

NOTES

1. DIMENSIONS OF SUBSTRUCTURES ARE APPROXIMATE AND BASED ON FIELD MEASUREMENTS TAKEN IN 1990.
2. THE PIER IS TO BE REMOVED TO THE BOTTOM OF STREAM BED (ELEV. 95).
3. THE ABUTMENTS ARE TO BE REMOVED TO AN ELEVATION UNDER THE PLACEMENT THICKNESS OF THE STONE FILL.
4. FILTER CURTAIN TO BE INSTALLED PRIOR TO REMOVAL OPERATIONS.
5. IN THE EVENT THAT ABUTMENT & PIER REMOVAL OPERATIONS ARE NOT CONTINUOUS, THE CONTRACTOR WILL NEED TO PLACE TEMPORARY EROSION CONTROL MEASURES.

STATE OF VERMONT
AGENCY OF TRANSPORTATION

Town Of MILTON	Bridge No. 18
Highway No.	Log Sta.
	Surv. Sta.

SUBSTRUCTURE REMOVAL DETAILS

Designed By BRUCE ERNST	Drawn By RICH ROSS
Checked By CHUCK GREGORY Date 08-08-03	Bridge Design Supervisor DAVE STAHNKE Date 08-08-03
PROJECT HISTORIC BRIDGE NO. 18 DISMANTLING	PROJECT NO. MILTON STP 1448 (28)
I.G.C. Info.	
Bridge Sheet No.	Sheet 11 of 11